


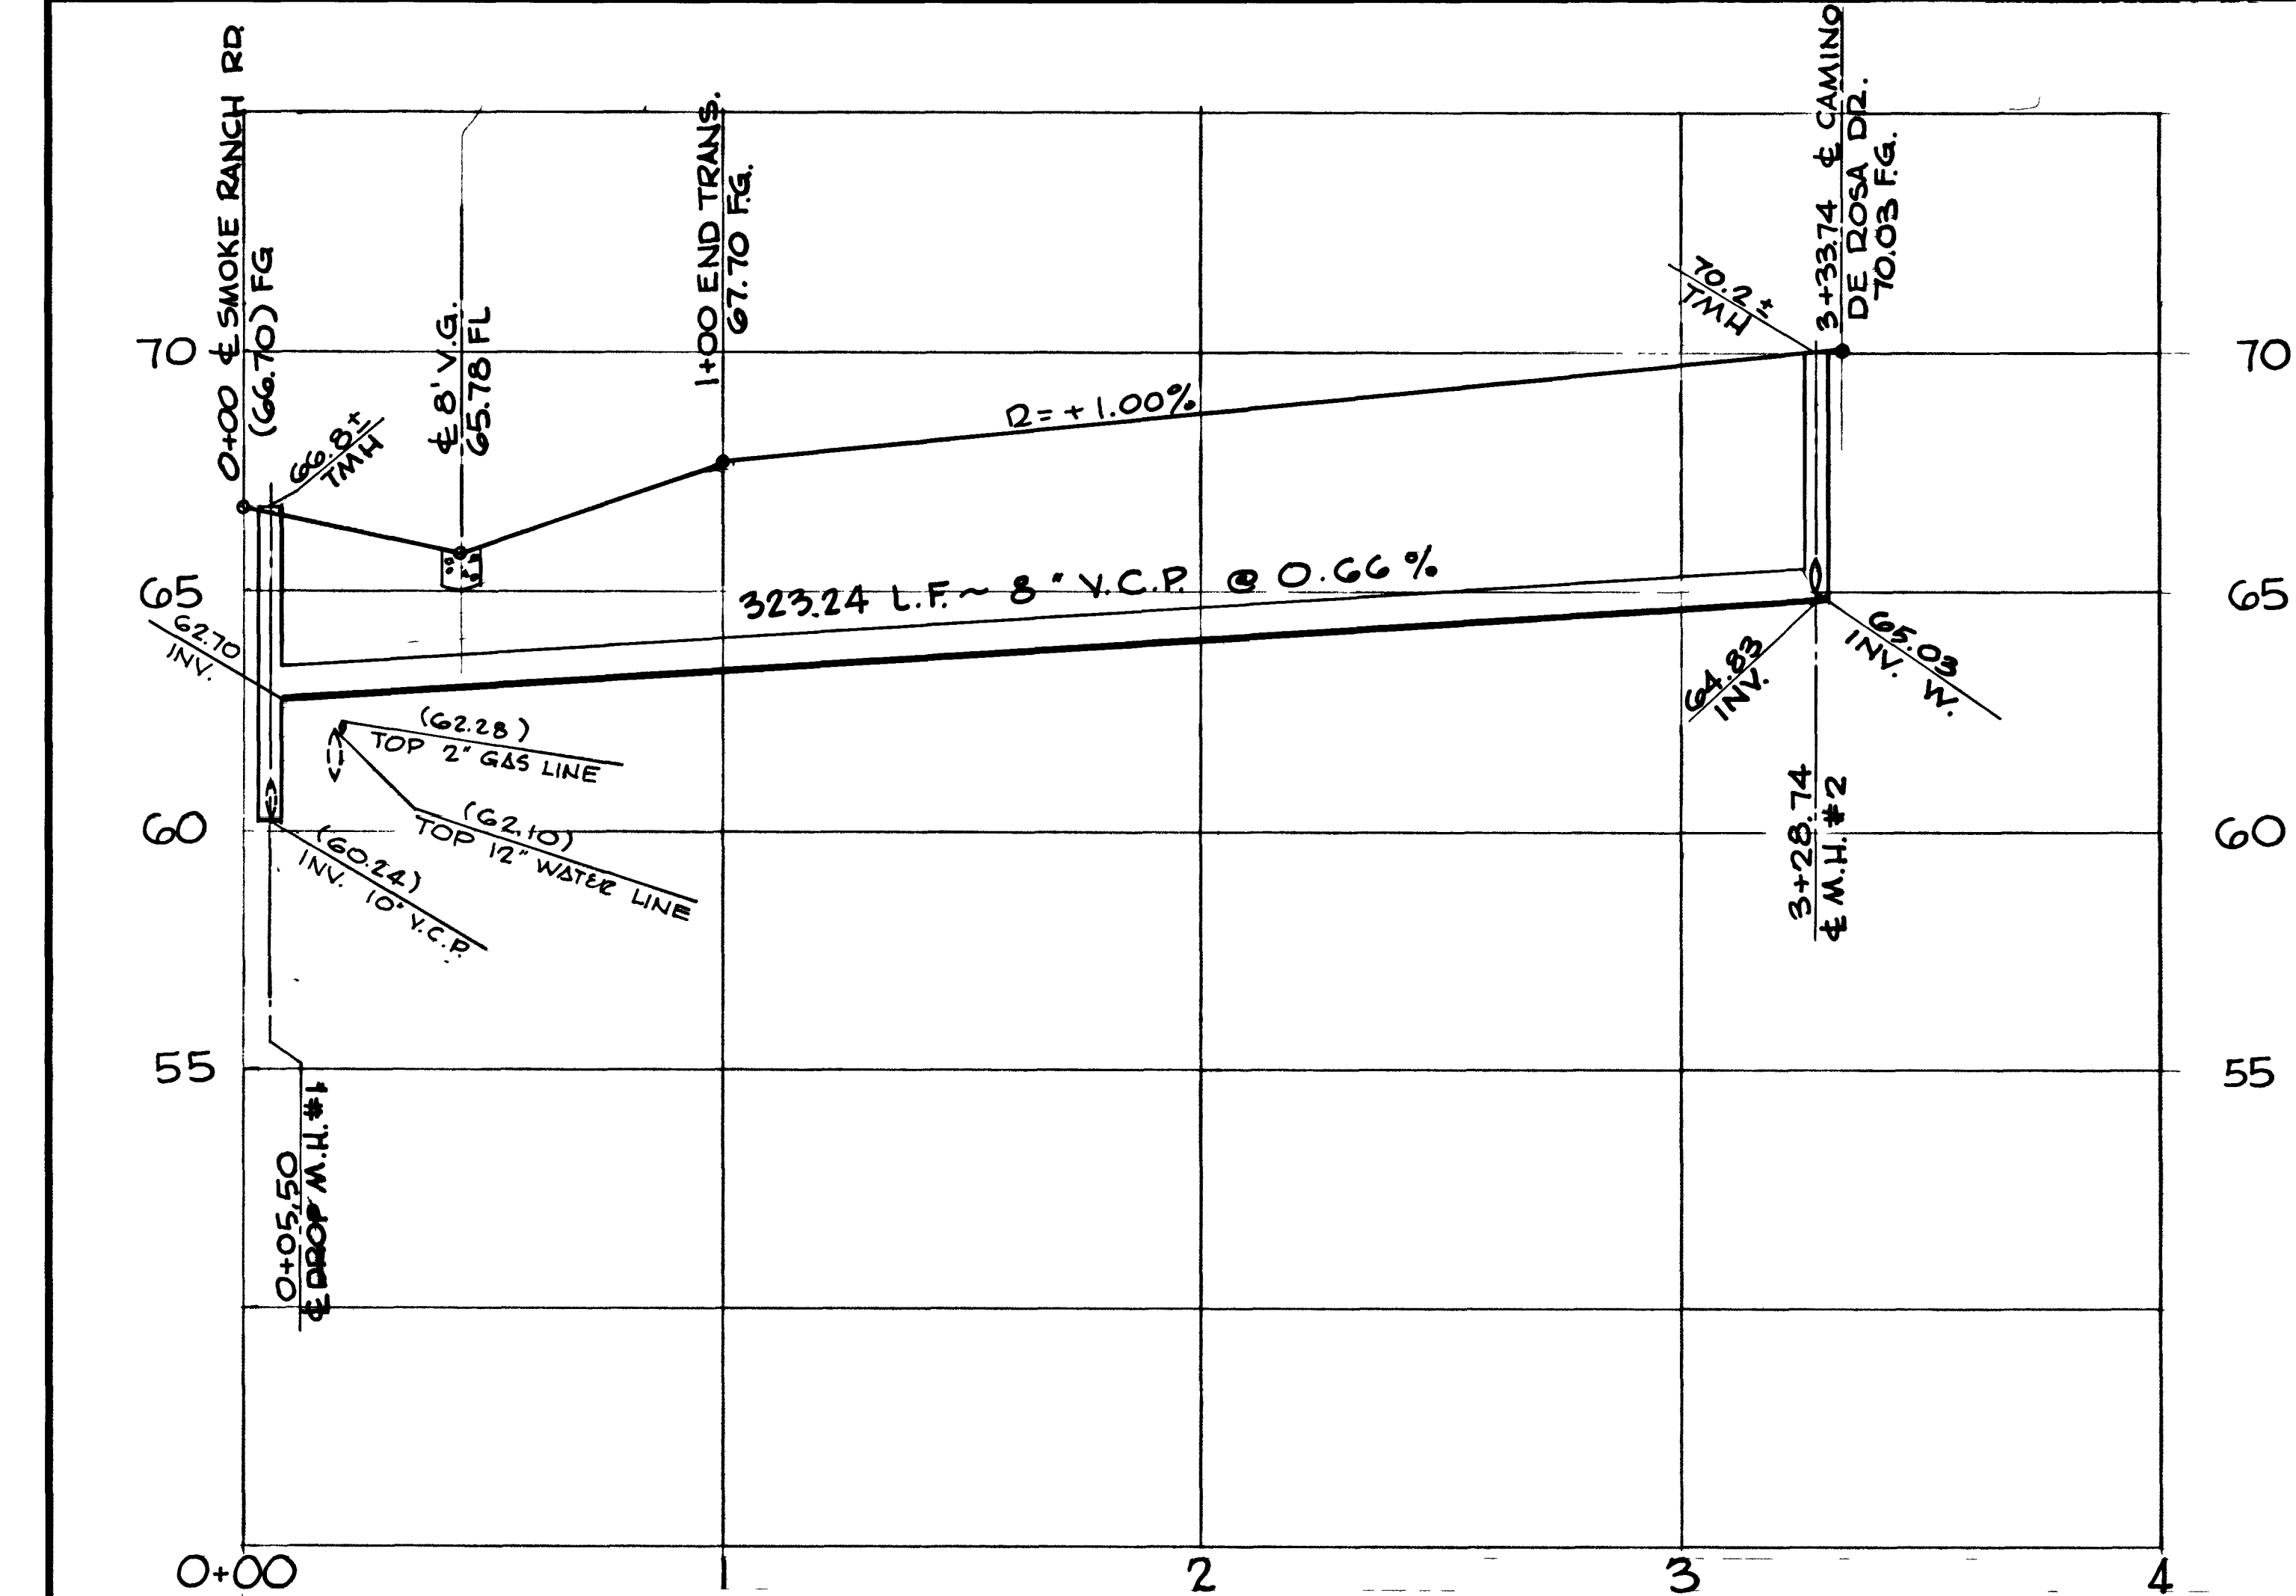


PROFILE

SCALE: HORIZ: 1"=30'
VERT: 1"=3'

CURVE DATA

Nº	Δ	IZ	L	T
A	90° 00' 00"	3.00'	4.71'	3.00'

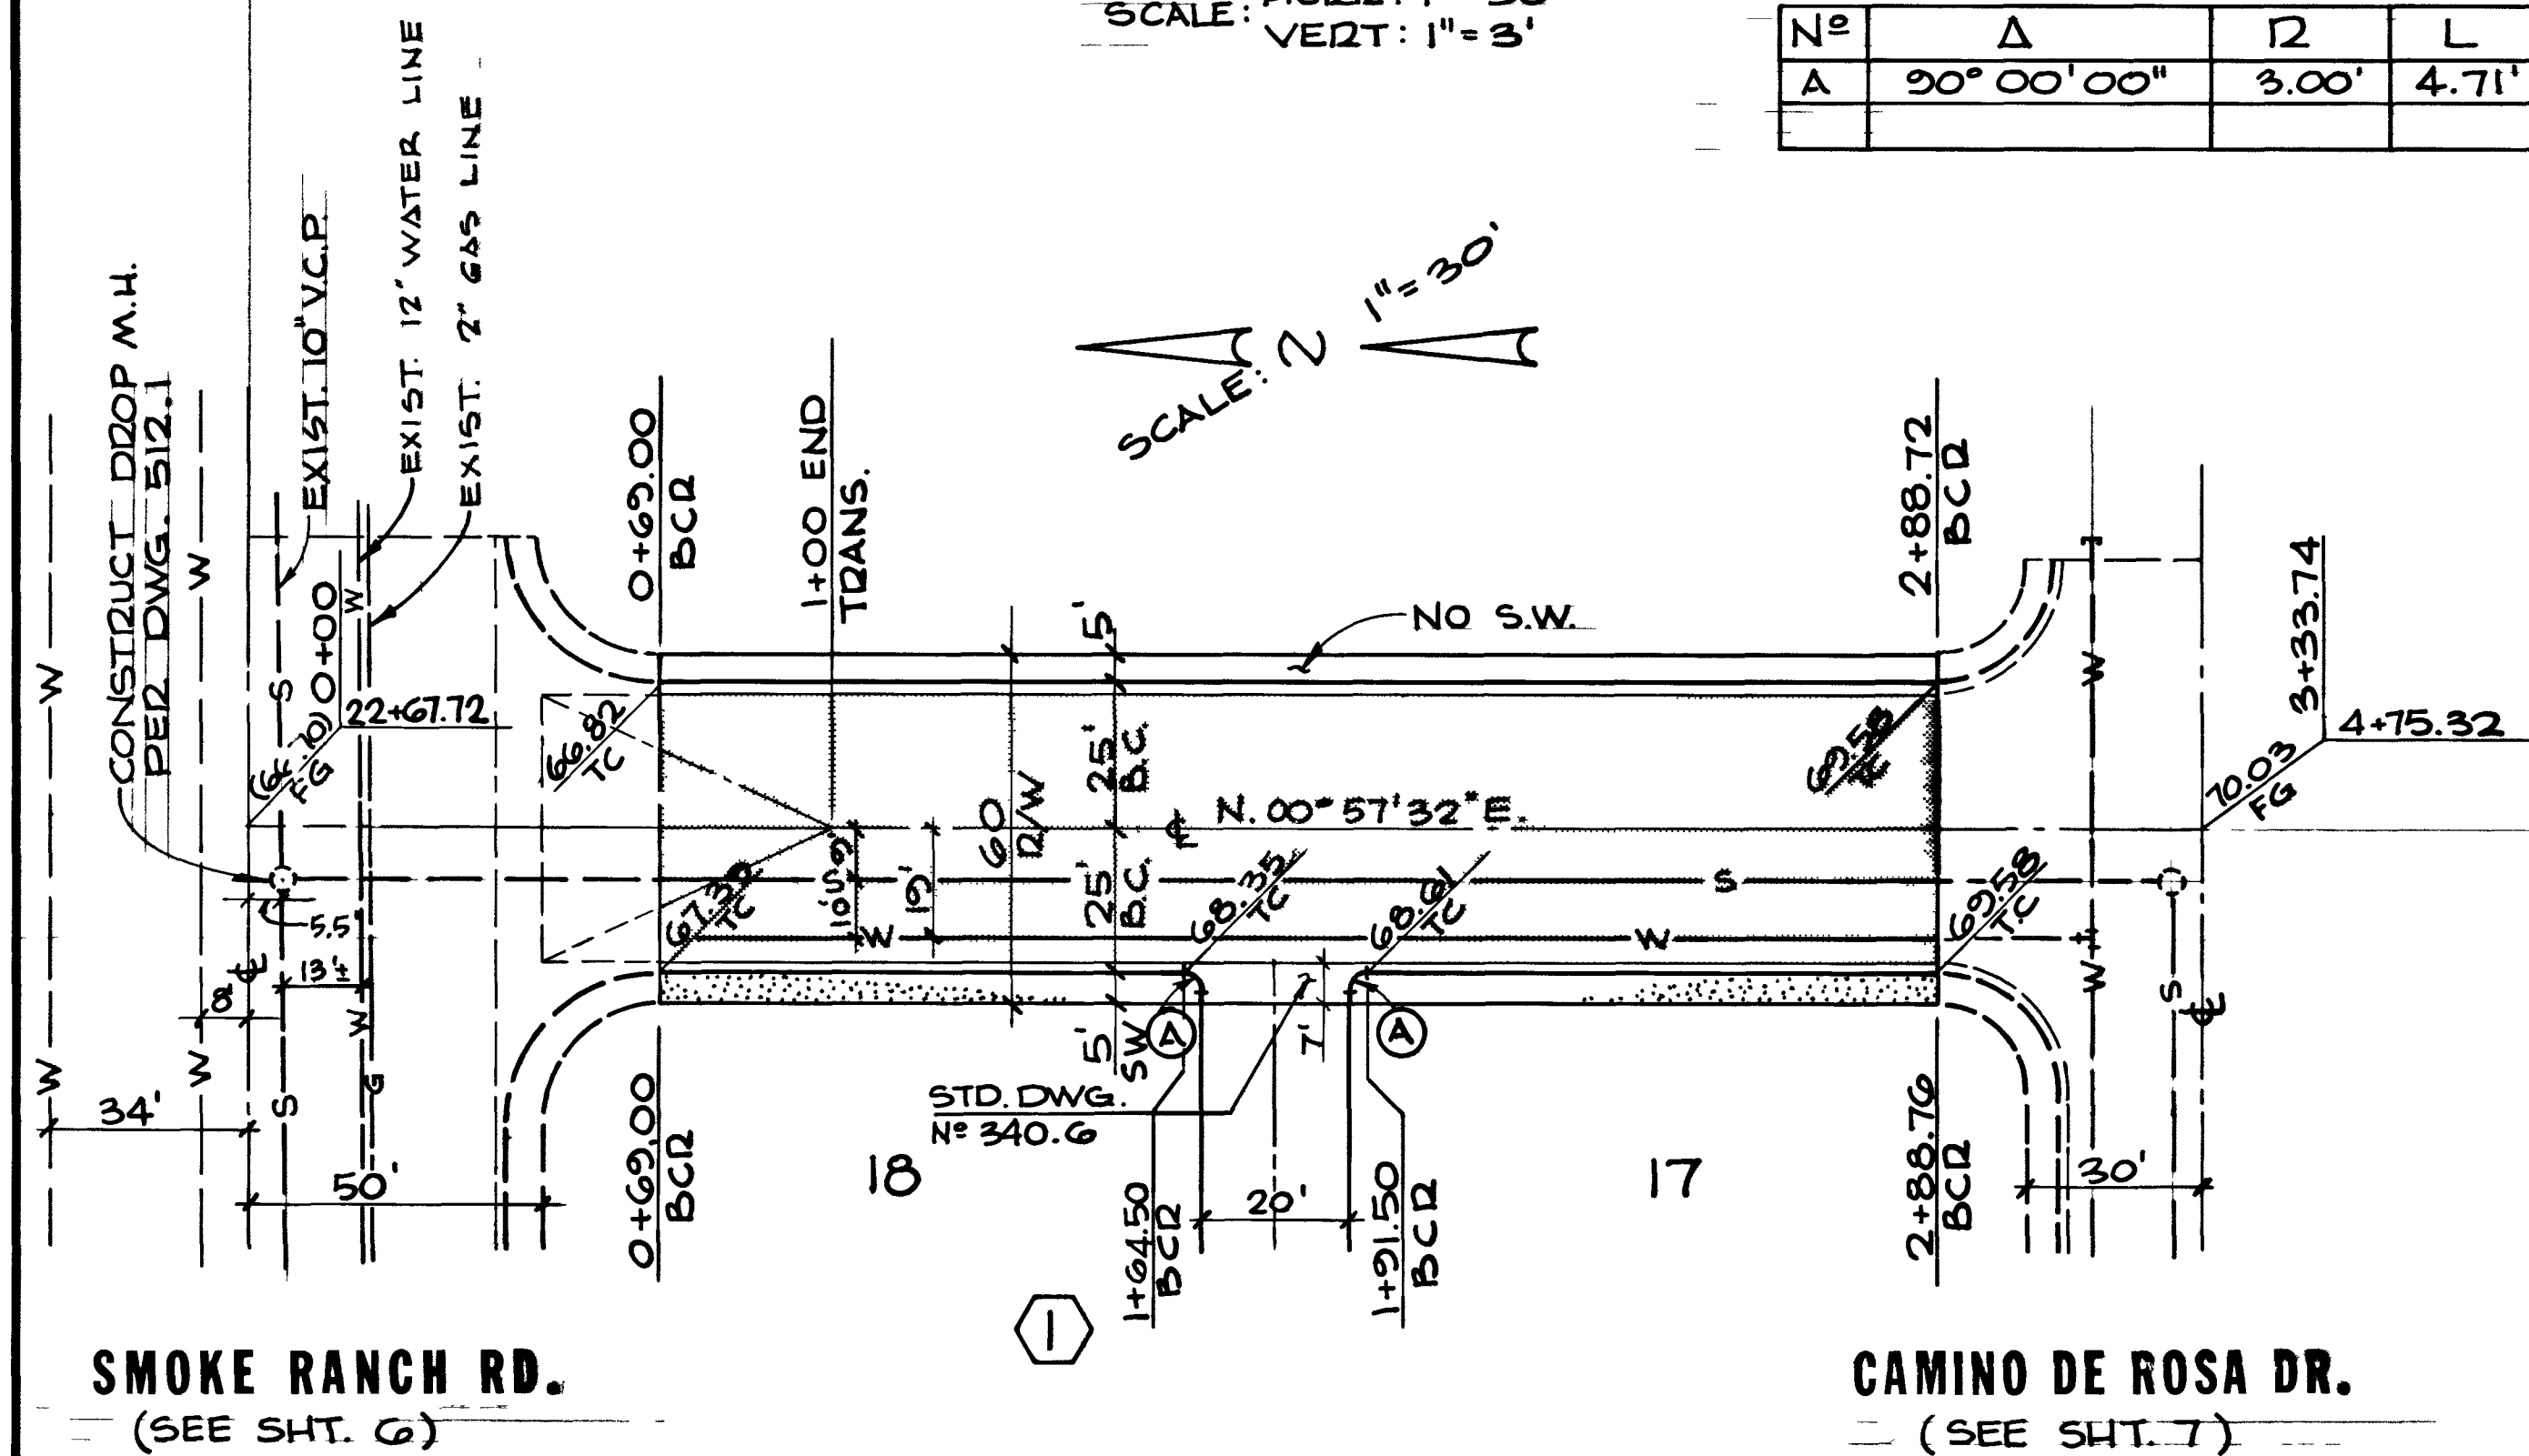

TUCUMCARI DRIVE

APPROVALS:


William Hurnio 10/26/77
CITY ENGINEER DATE

Robert J. Weber 10-25-77
FIELD ENGINEER DATE

Ray P.
QUALITY CONTROL ENGINEER DATE

RECOMMENDED BY: <i>G.C. Wallace</i>	DATE: 9/9/77	DESCRIPTION: REV. ALLEY WIDTH AND SEWER GRADE
G.C. WALLACE Consulting Engineers, Inc. 1100 East Sahara Ave. • Las Vegas, Nevada 89104 • 732-3330		
BECKER & SONS CHARLESTON HEIGHTS — TRACT NO. 51-FI TUCUMCARI DRIVE		
SHEET 8 OF 10 SHEETS		

287.610

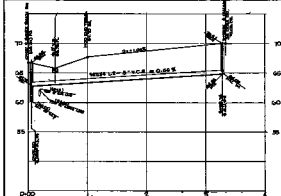


PROFILE




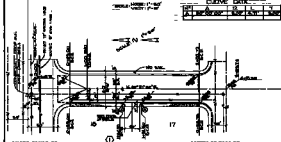



TUCUMCARI DRIVE

APPROVALS

DATE

DATE

DATE

