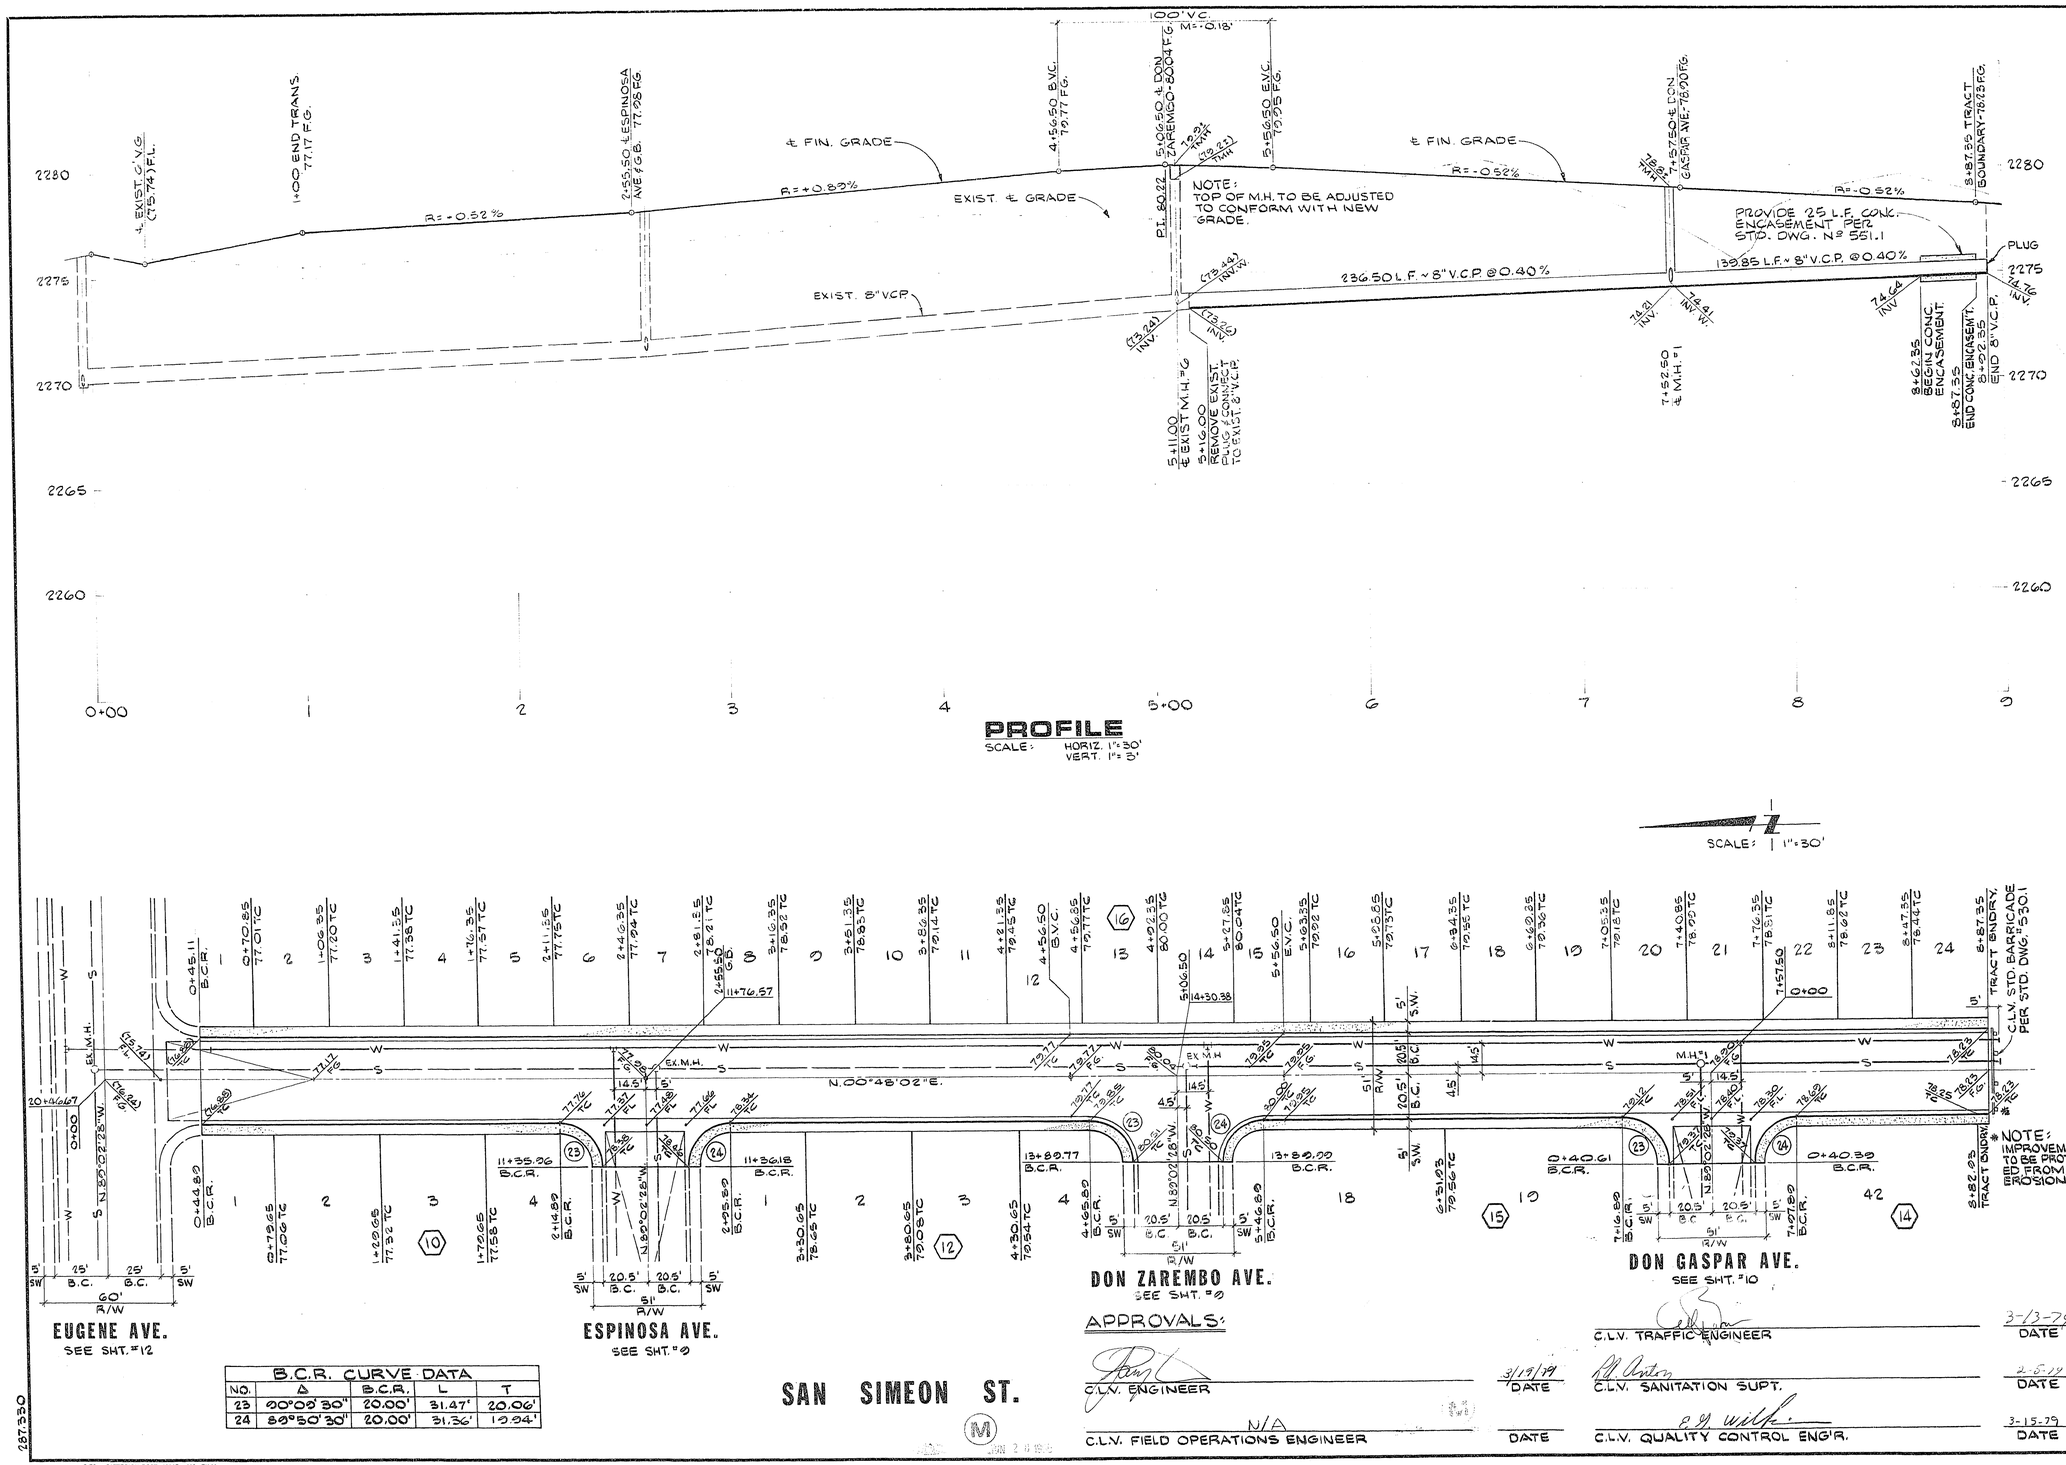

REV	DATE	DESCRIPTION
1	9/26/79	RESTATIONED LOT LINES FOR LOTS 3 THRU 24, BLK. 16 & CHGED. ST. NAME FM. RIO HONDO AVE. TO DON GASPAR AVE. PER C.L.V. FIRE DEPT.

RECOMMENDED: G. C. WALLACE — 3/1/79 DATE
APPROVED: R.E. NO. 3174 — 1/21/79 DATE

G. C. WALLACE
Consulting Engineers, Inc.
1100 East Sahara Ave. • Las Vegas, Nevada 89104 • 732-3330

BECKER & SONS
CHARLESTON HEIGHTS — TRACT NO. 51-A3
SAN SIMEON ST.

SHEET 11 OF 16 SHEETS

107 y - 1040-51 A·3