
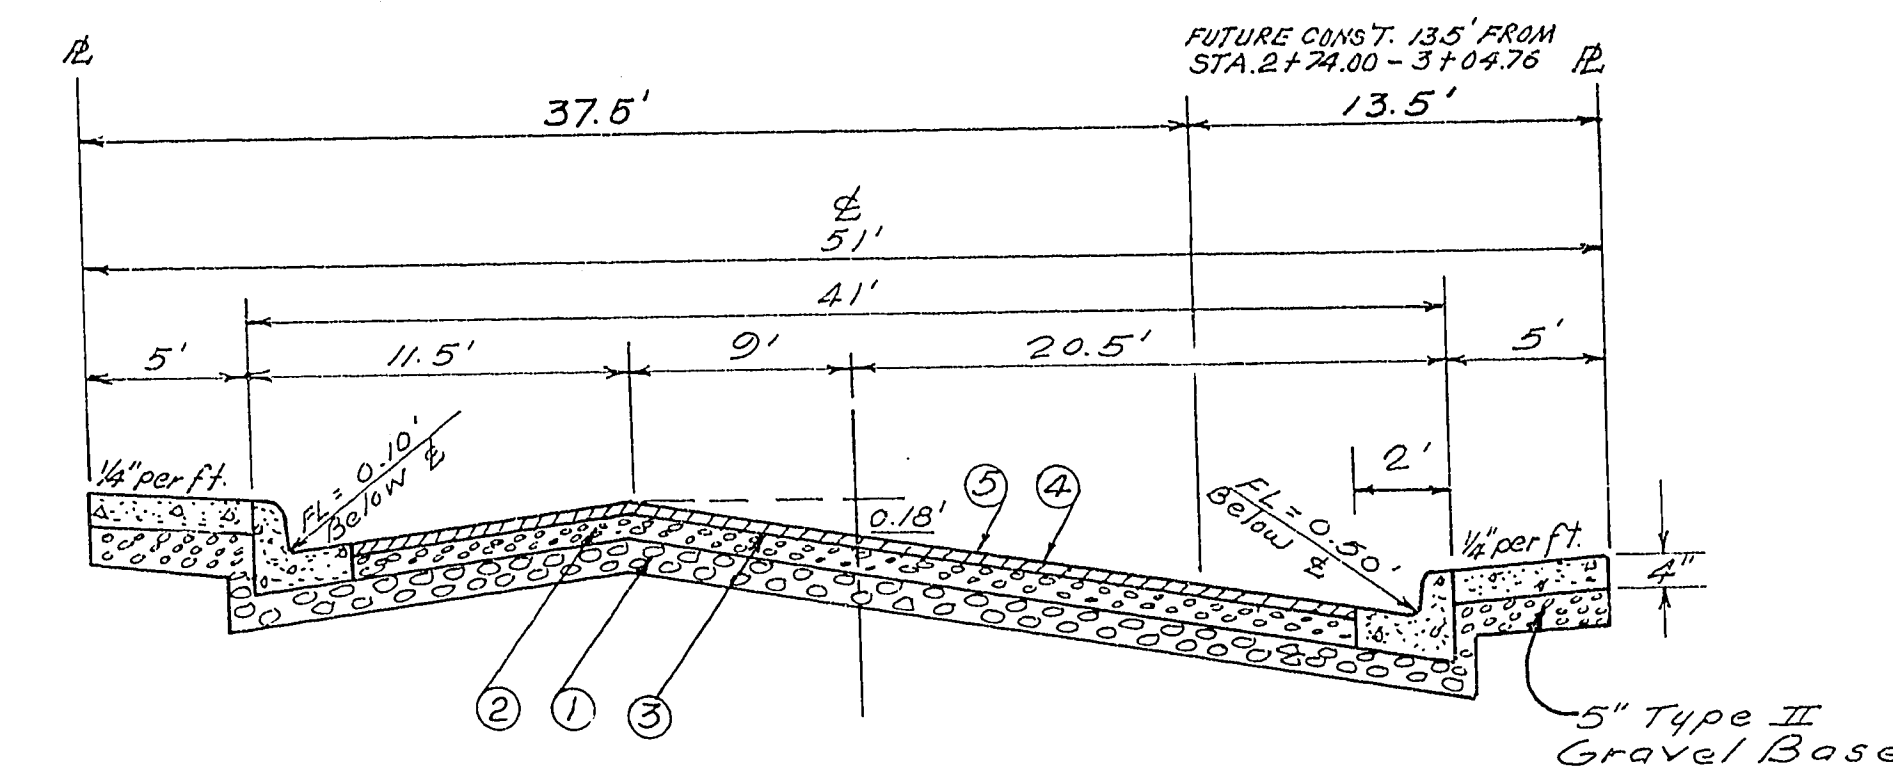
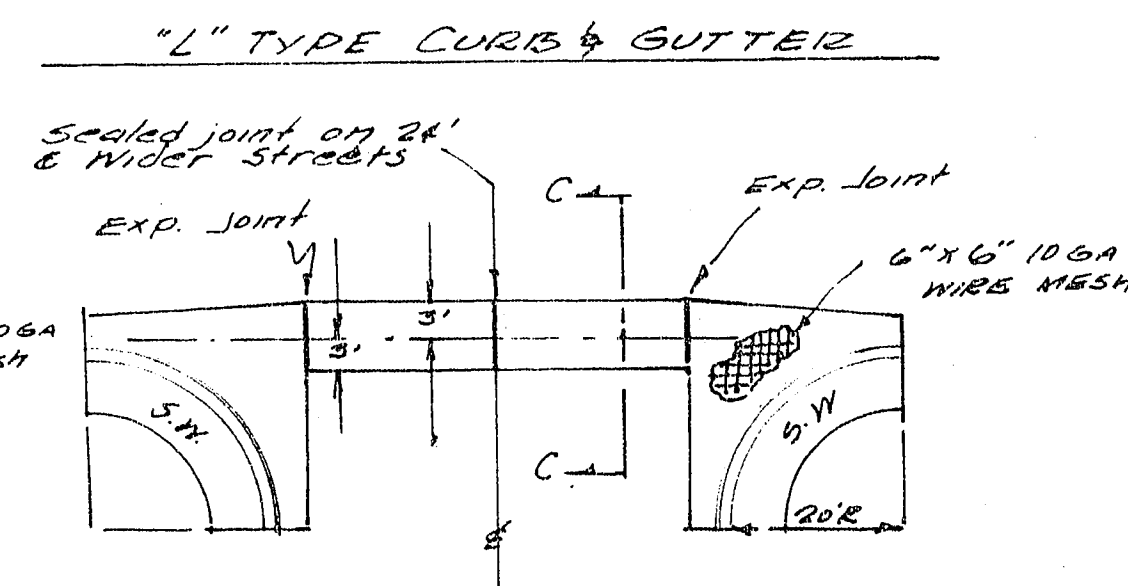
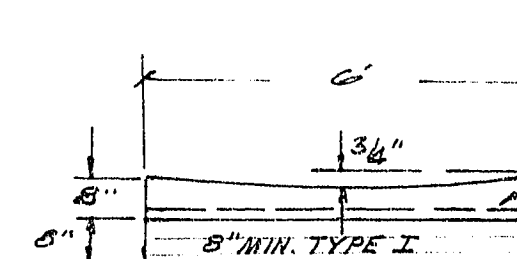
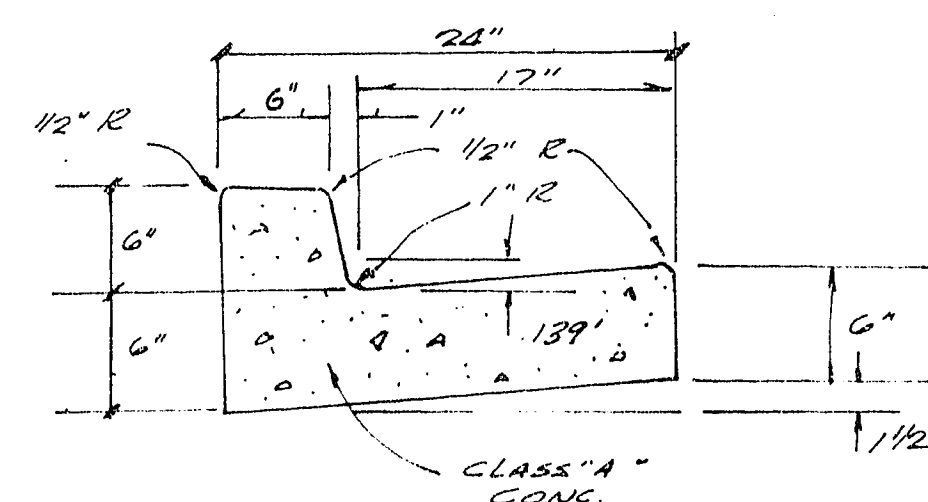
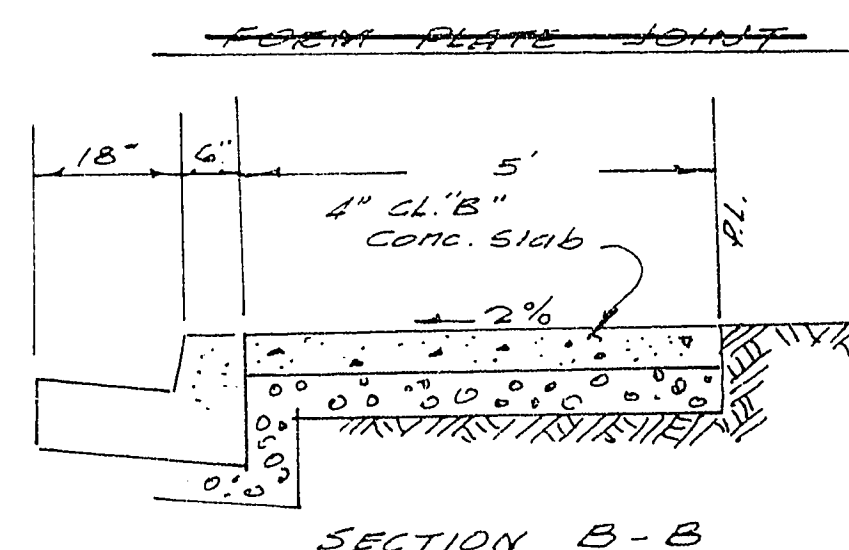
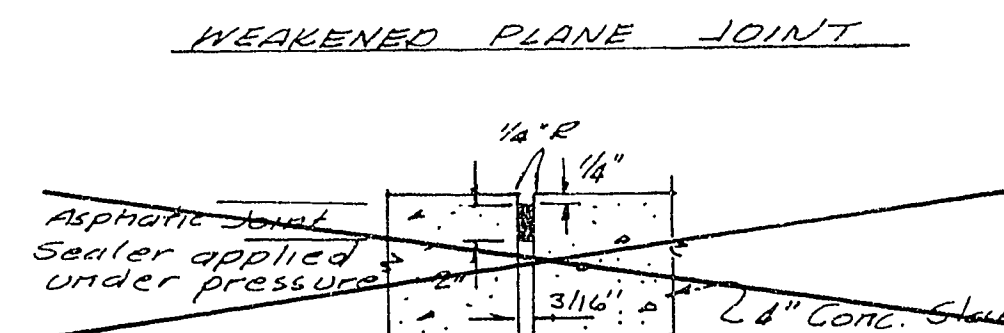
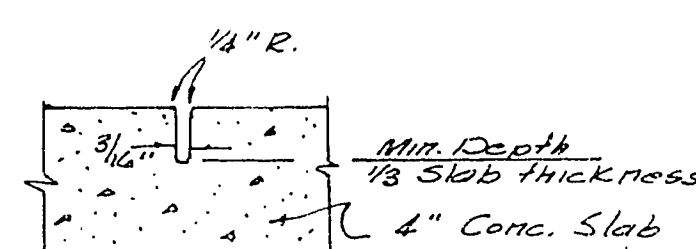
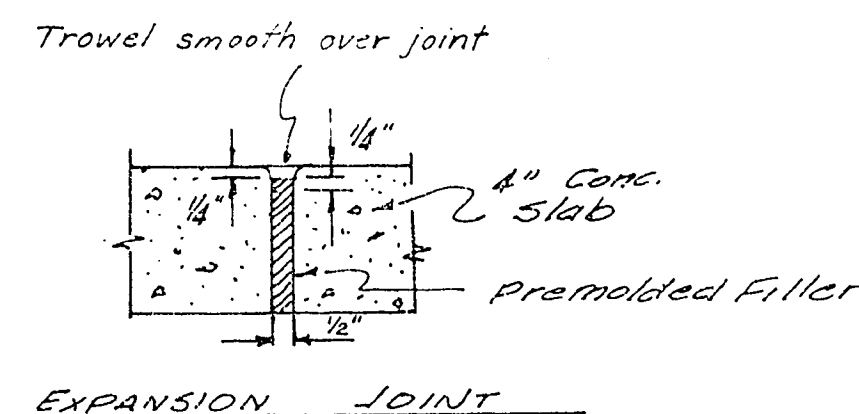
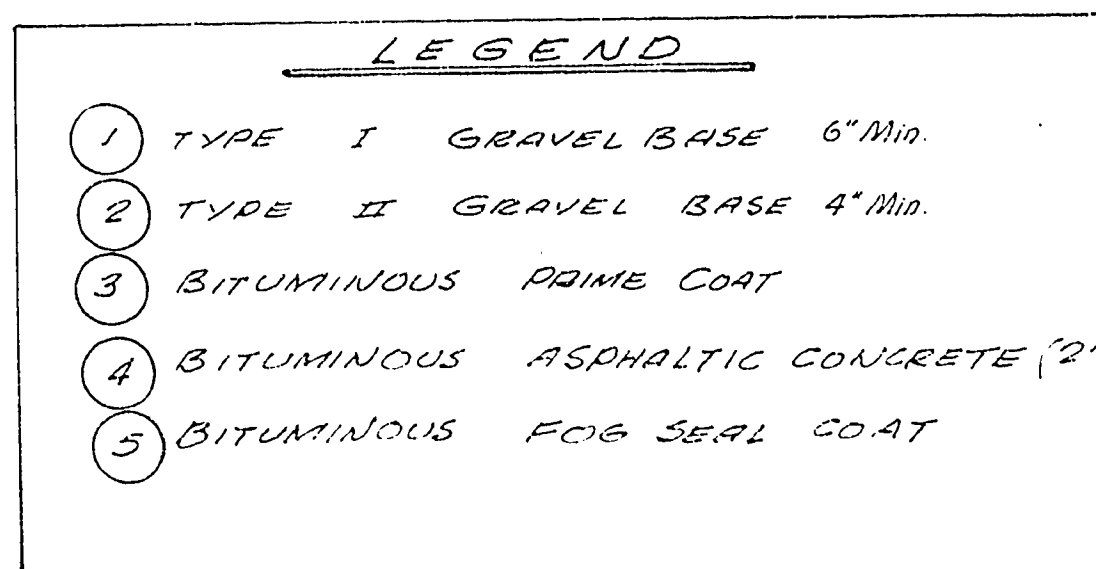
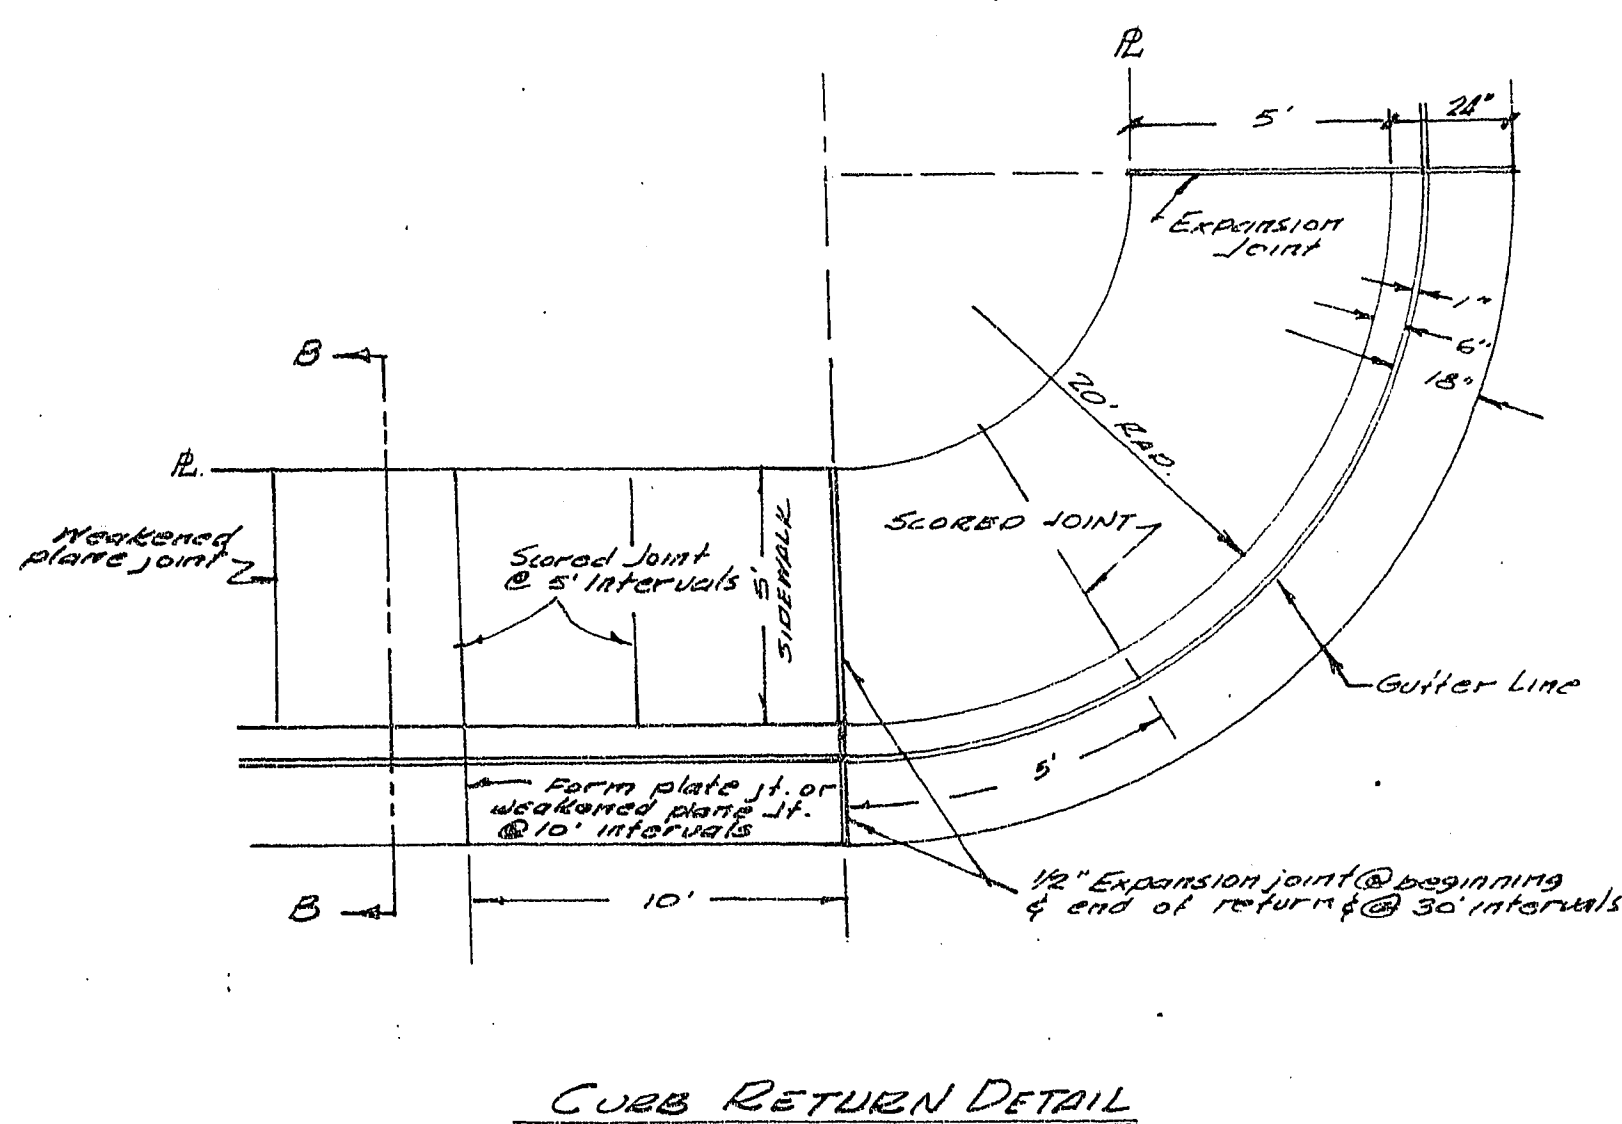
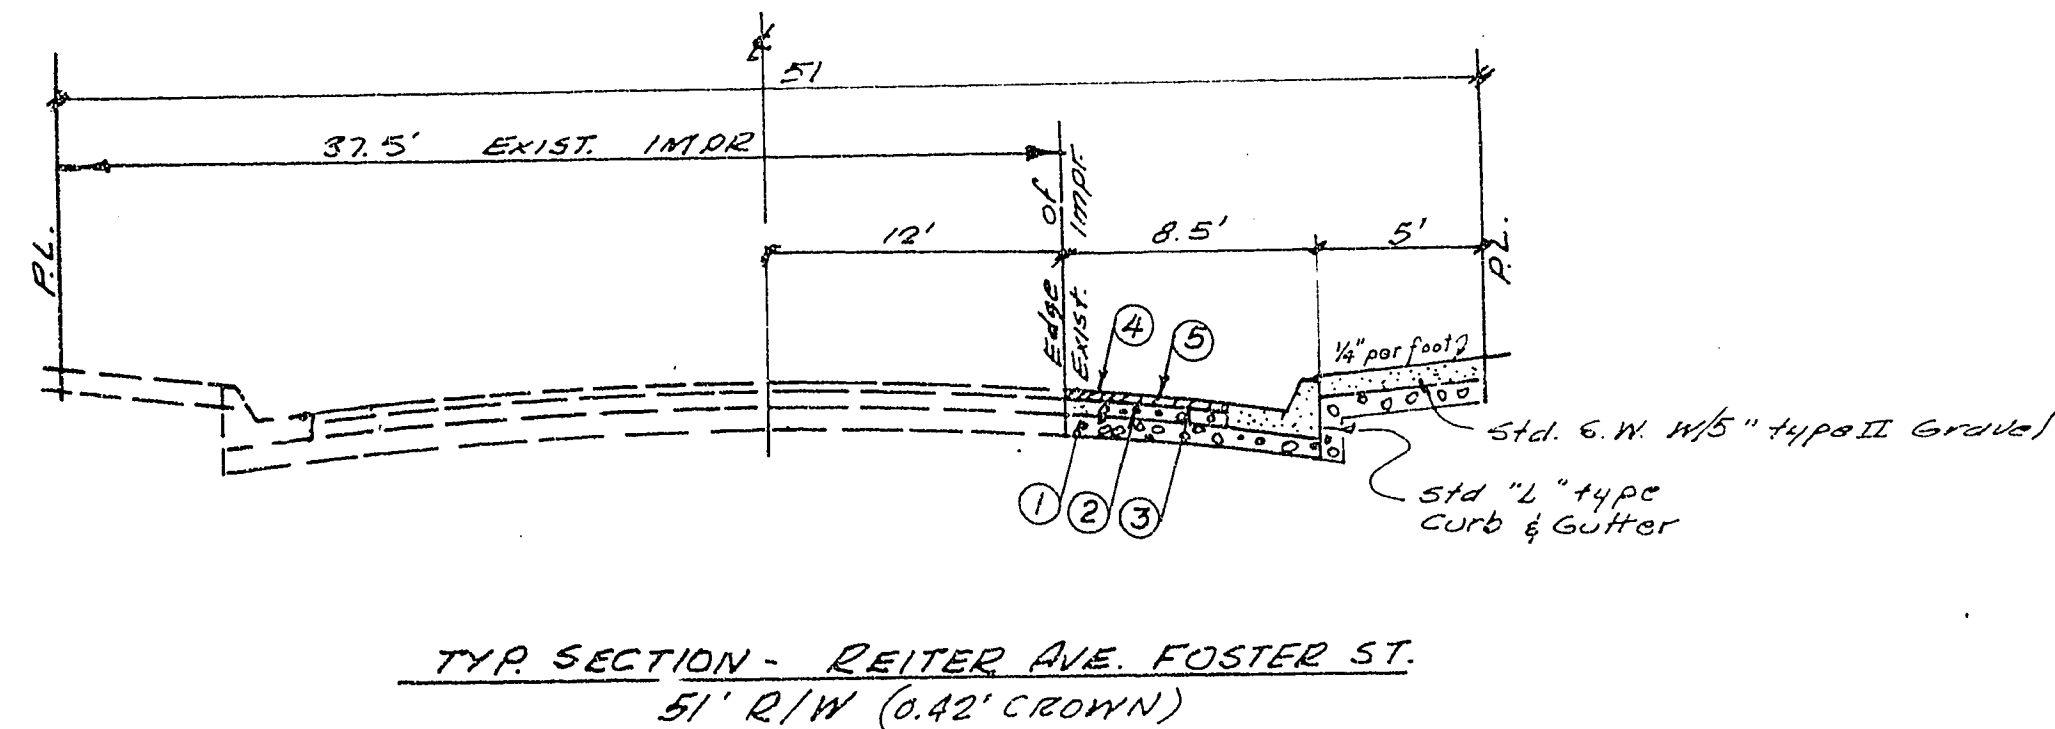
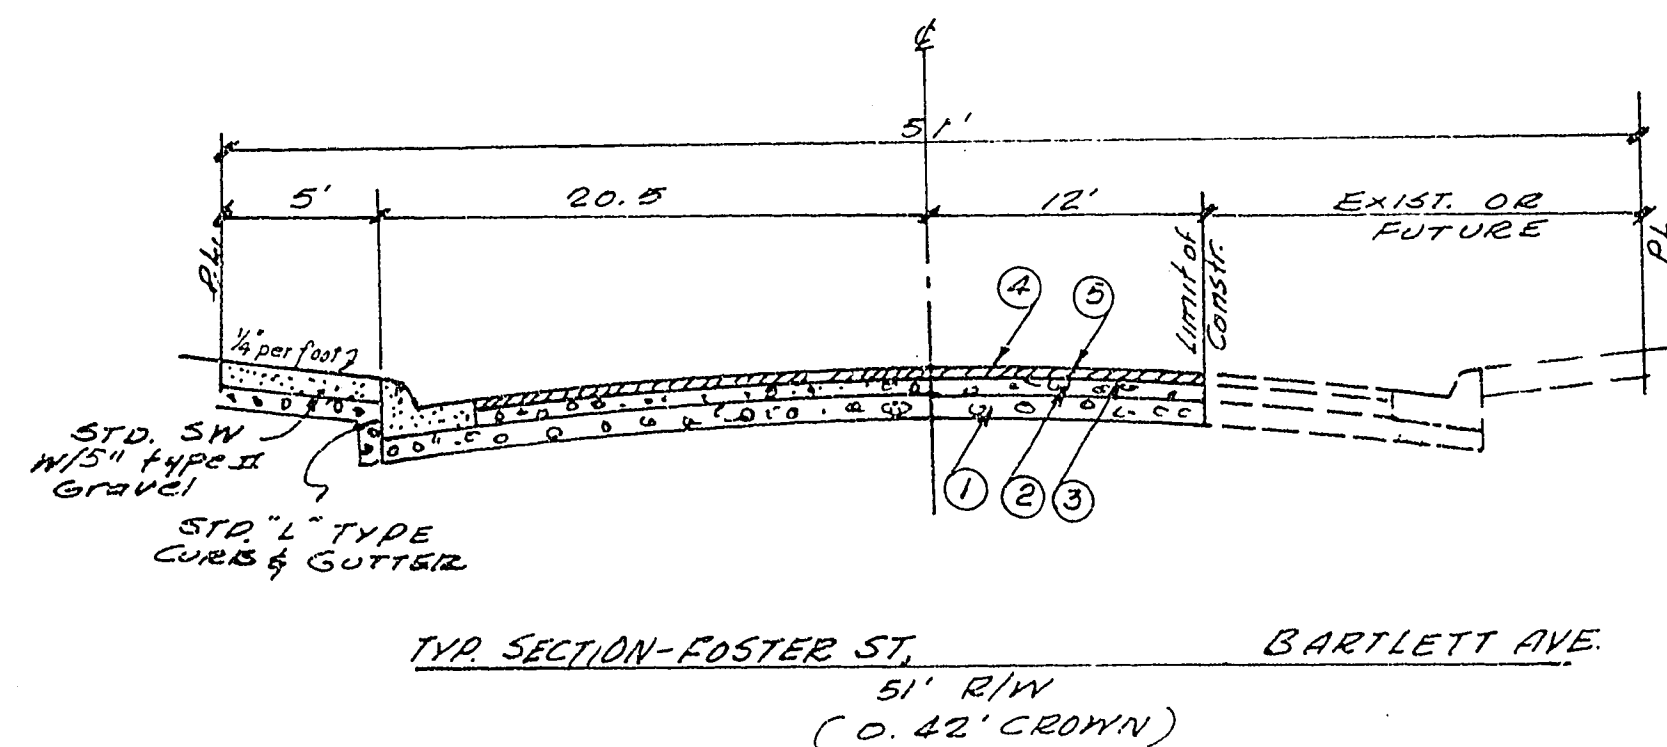


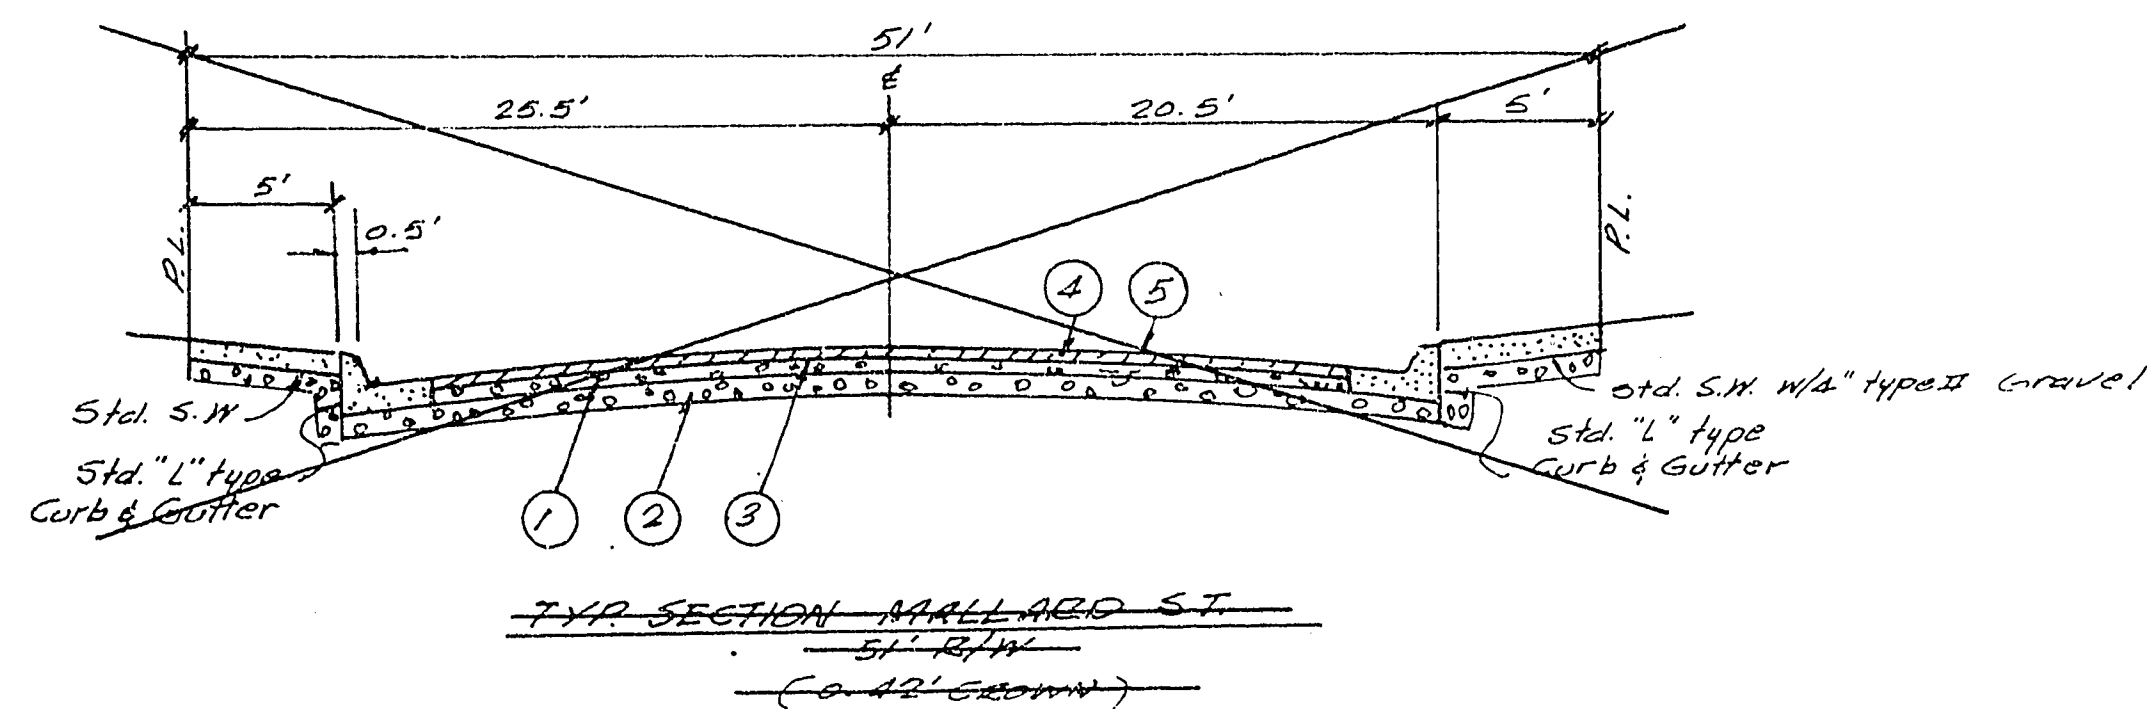

TYPICAL SECTION 51' R/W (CROSSFALL)
(MALLARD STREET)

QUANTITY ESTIMATE	
STREET IMPROVEMENTS	
2" AC Pavement	4,858 CY
Std. L Type Curb & Gutter	2,708 LF
Std. 4' x 5' Conc. Sidewalk	11,000 SF
Std. Conc. Valley Gutter	342 SF
SEWERAGE SYSTEM	
Std. Concrete Manholes	3 EA
8" VCP	2,894 LF
4" Service laterals	30 EA
WATER SYSTEM	
6" Gate Valve	5 EA
6" ACP	123 LF
6" x 6" x 6" TEE	5 EA
3/4" House Services	29 EA
3/4" x 5/8" Meters	29 EA
STREET LIGHTING	
3 GA. Standards	3 EA
11 GA. Standards	3 EA
175 Watt M.V. Luminaires	6 EA
250 " " "	1 EA

REV	DATE	DESCRIPTION	BY	APPR.
10				
9				
8				
7				

CHARLESTON HEIGHTS
TRACT 50-D-1
CONSTRUCTION DETAILS

DESIGNED	TPJAN ENGINEERING INC.	1729 S. WESTERN	SHEET 1
DRAWN	LAZ VEGAS	NEVADA	OF 8
CHECKED	APPROVED	DATE	

1074-1040-50D-1