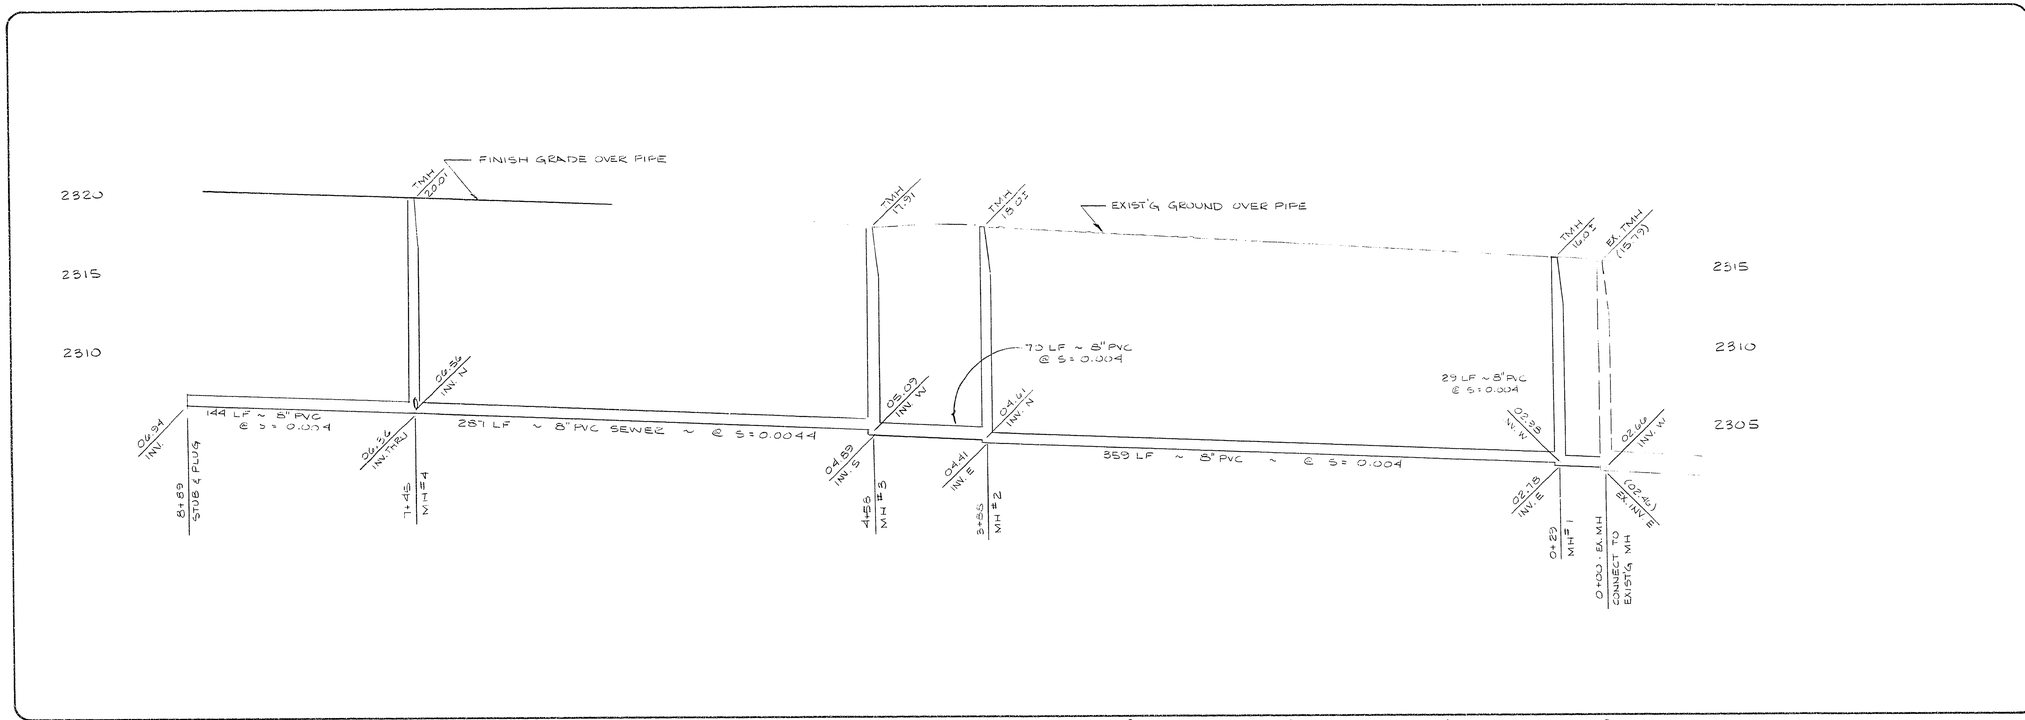

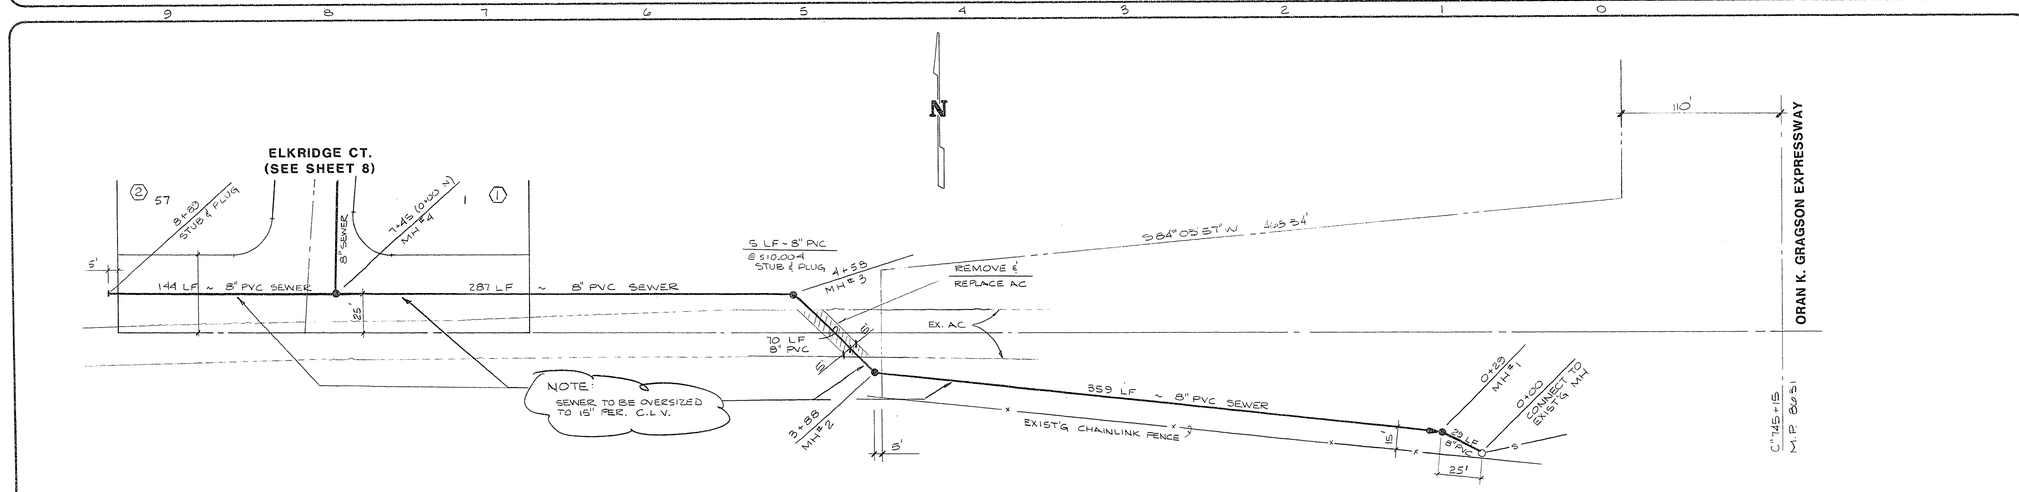

BENCH MARK

C0010B1 - BR SPIKE ON THE EAST SIDE OF POWER POLE #65125 IN THE SW CORNER OF LORENZI AND COWAN ROAD INTERSECTION. 0.70' ABOVE NATURAL GROUND: BASED ON THE 1974 AERIAL CONTROL DATUM.

ELEVATION: ~~2300.95~~

CONSTRUCTION BENCH MARK:

REBAR AND ALCAP RLS 2050 AT THE 1/16 CORNER, ALEXANDER AND RAINBOW EXPRESSWAY.

ELEVATION: 2318.73

REV.	DATE	BY	REVISION
1	4-20-88	SCD	ADD STA. PER NDOT
1	7-1-88	RPF	MOVE MH #3

PLASTER DEVELOPMENT

LAS VEGAS, NEVADA

CONSULTING ENGINEERS — PLANNERS
2300 PASEO DEL PRADO BUILDING A SUITE 100
LAS VEGAS, NEVADA 89102 PHONE (702) 873-7536

vtn nevada

TITLE: **SEWER PLAN & PROFILE**
ALEXANDER ROAD

PROJECT: **CHARLESTON HEIGHTS TRACT 63 UNIT 1**

WO NO. 3179-1
BY RPF
DATE APR. 88
SCALE HOR. 1" = 40' VERT. 1" = 4'

SHEET **7** OF **13** SHEETS

4/19/88

3079Y-1040-63-1