


2450

2450

2445

2450

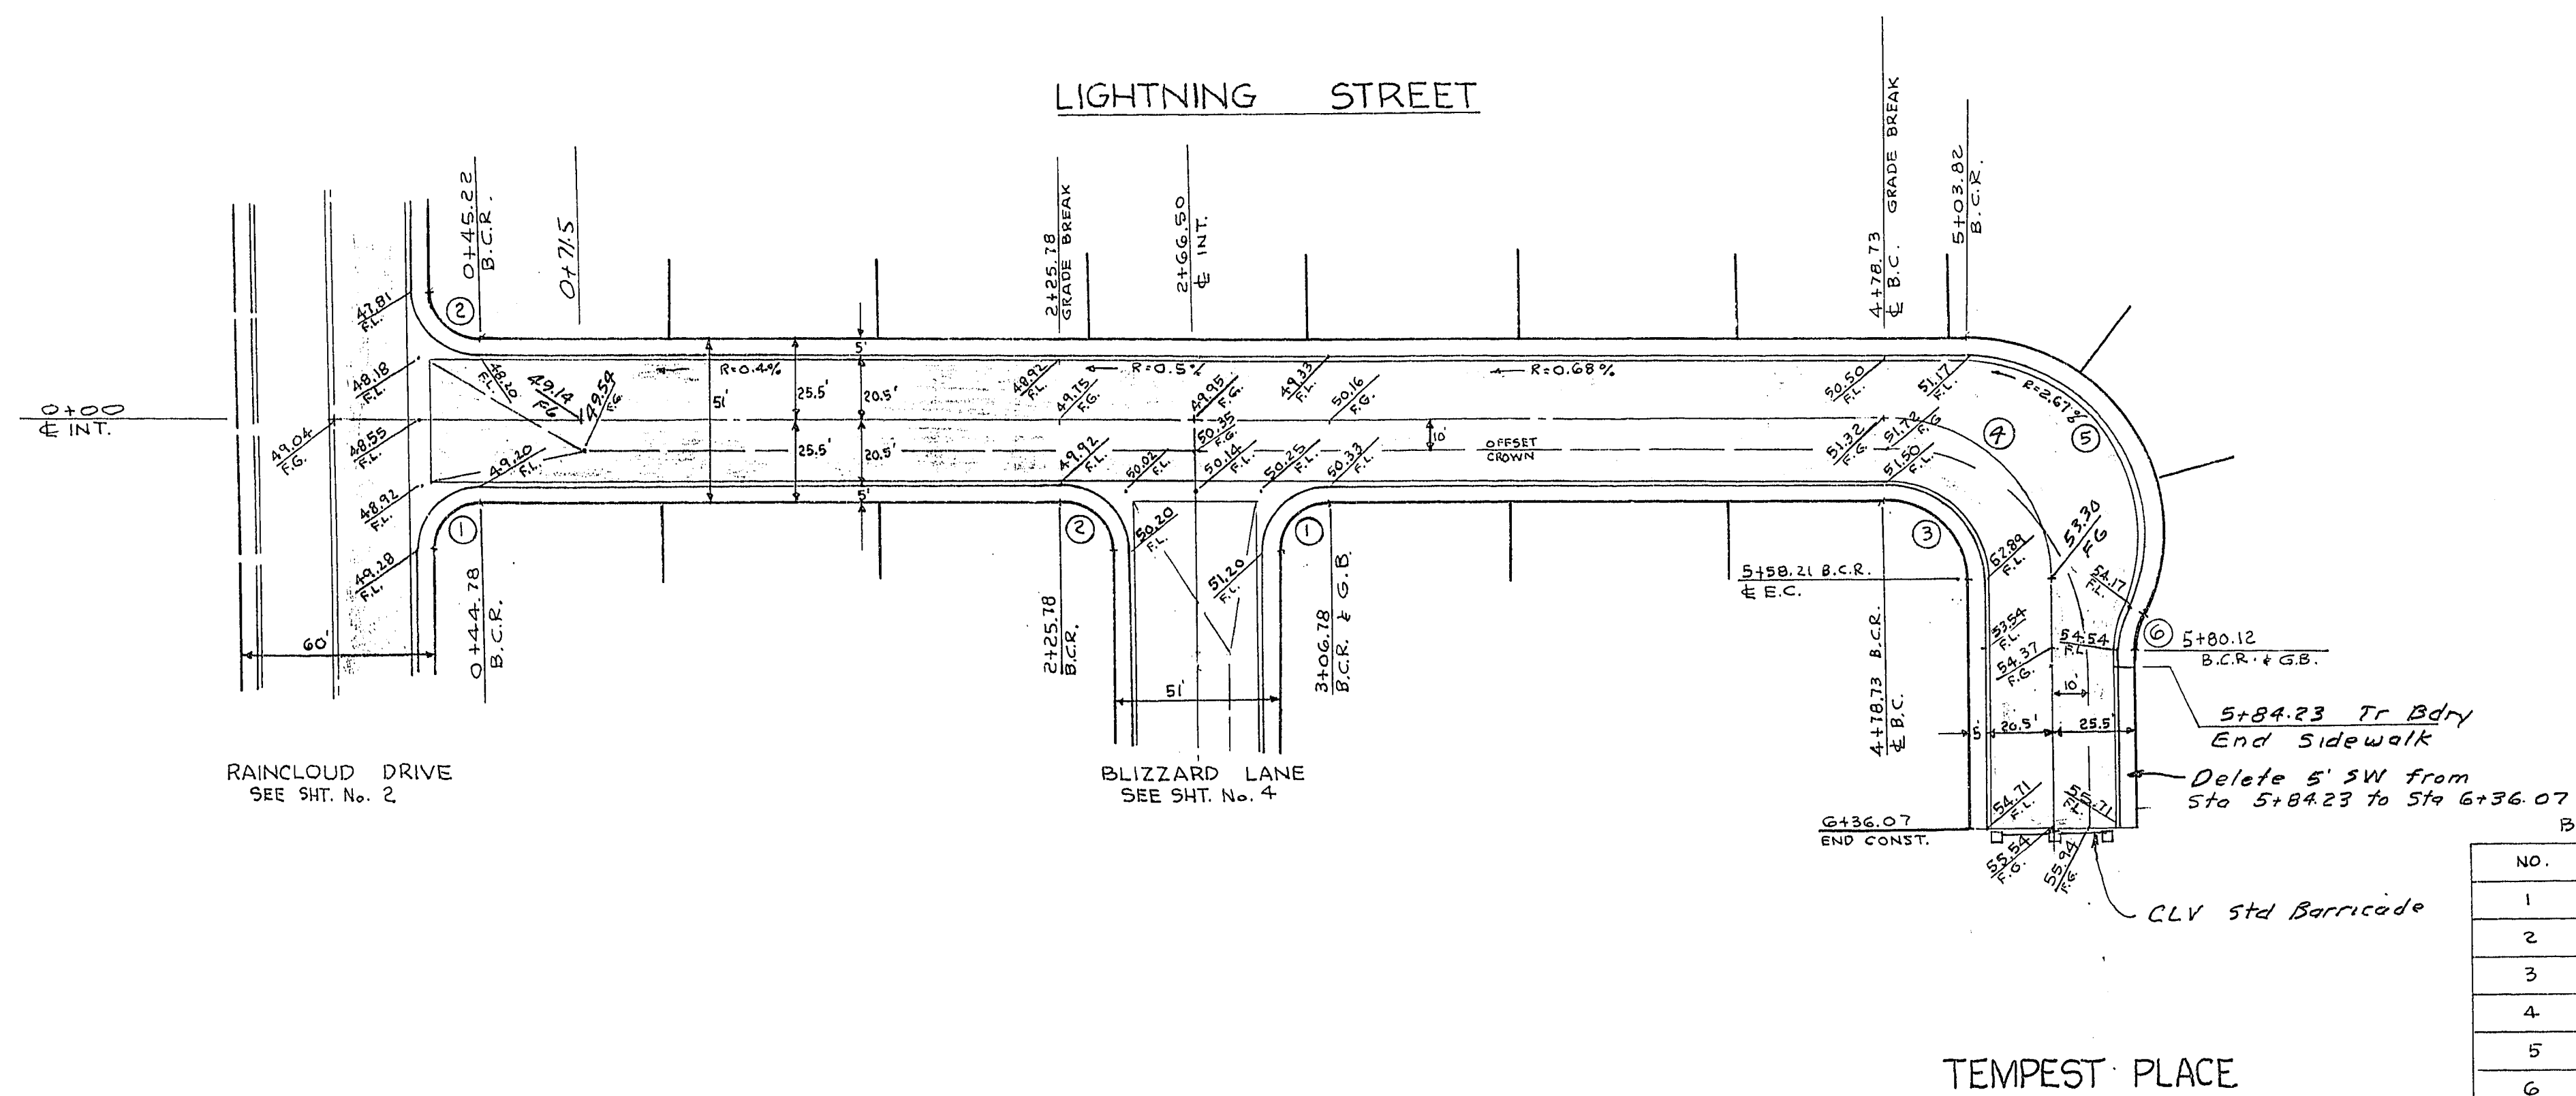

APPROVED BY

Las Vegas City Engineer 3/1/76
LAS VEGAS CITY ENGINEER DATE

J. D. Decker 3-12-76
LAS VEGAS FIELD ENGINEER DATE

SUBMITTED BY

Charley R. Johnson 1-26-76
CHARLEY R. JOHNSON R.P.E. DATE
NEVADA CERTIFICATE No. 3005

VTN CONSULTING ENGINEERS • PLANNERS
2201 PARADISE ROAD, LAS VEGAS, NEVADA 89105
(702) 735-0227

**CHARLESTON RAINBOW UNIT 12D
STREET IMPROVEMENT PLAN
LIGHTNING STREET & TEMPEST PLACE**

SCALE:	WO. NO. 1066-12D	DATE 1-26-76	SHEET	OF
HORIZ: 1" = 4'-0"	DES.	REV.	3	9
VERT: 1" = 4'	CHK.	REV.		

107Y-1055-12D

860

850

840

850

LIGHTNING STREET









