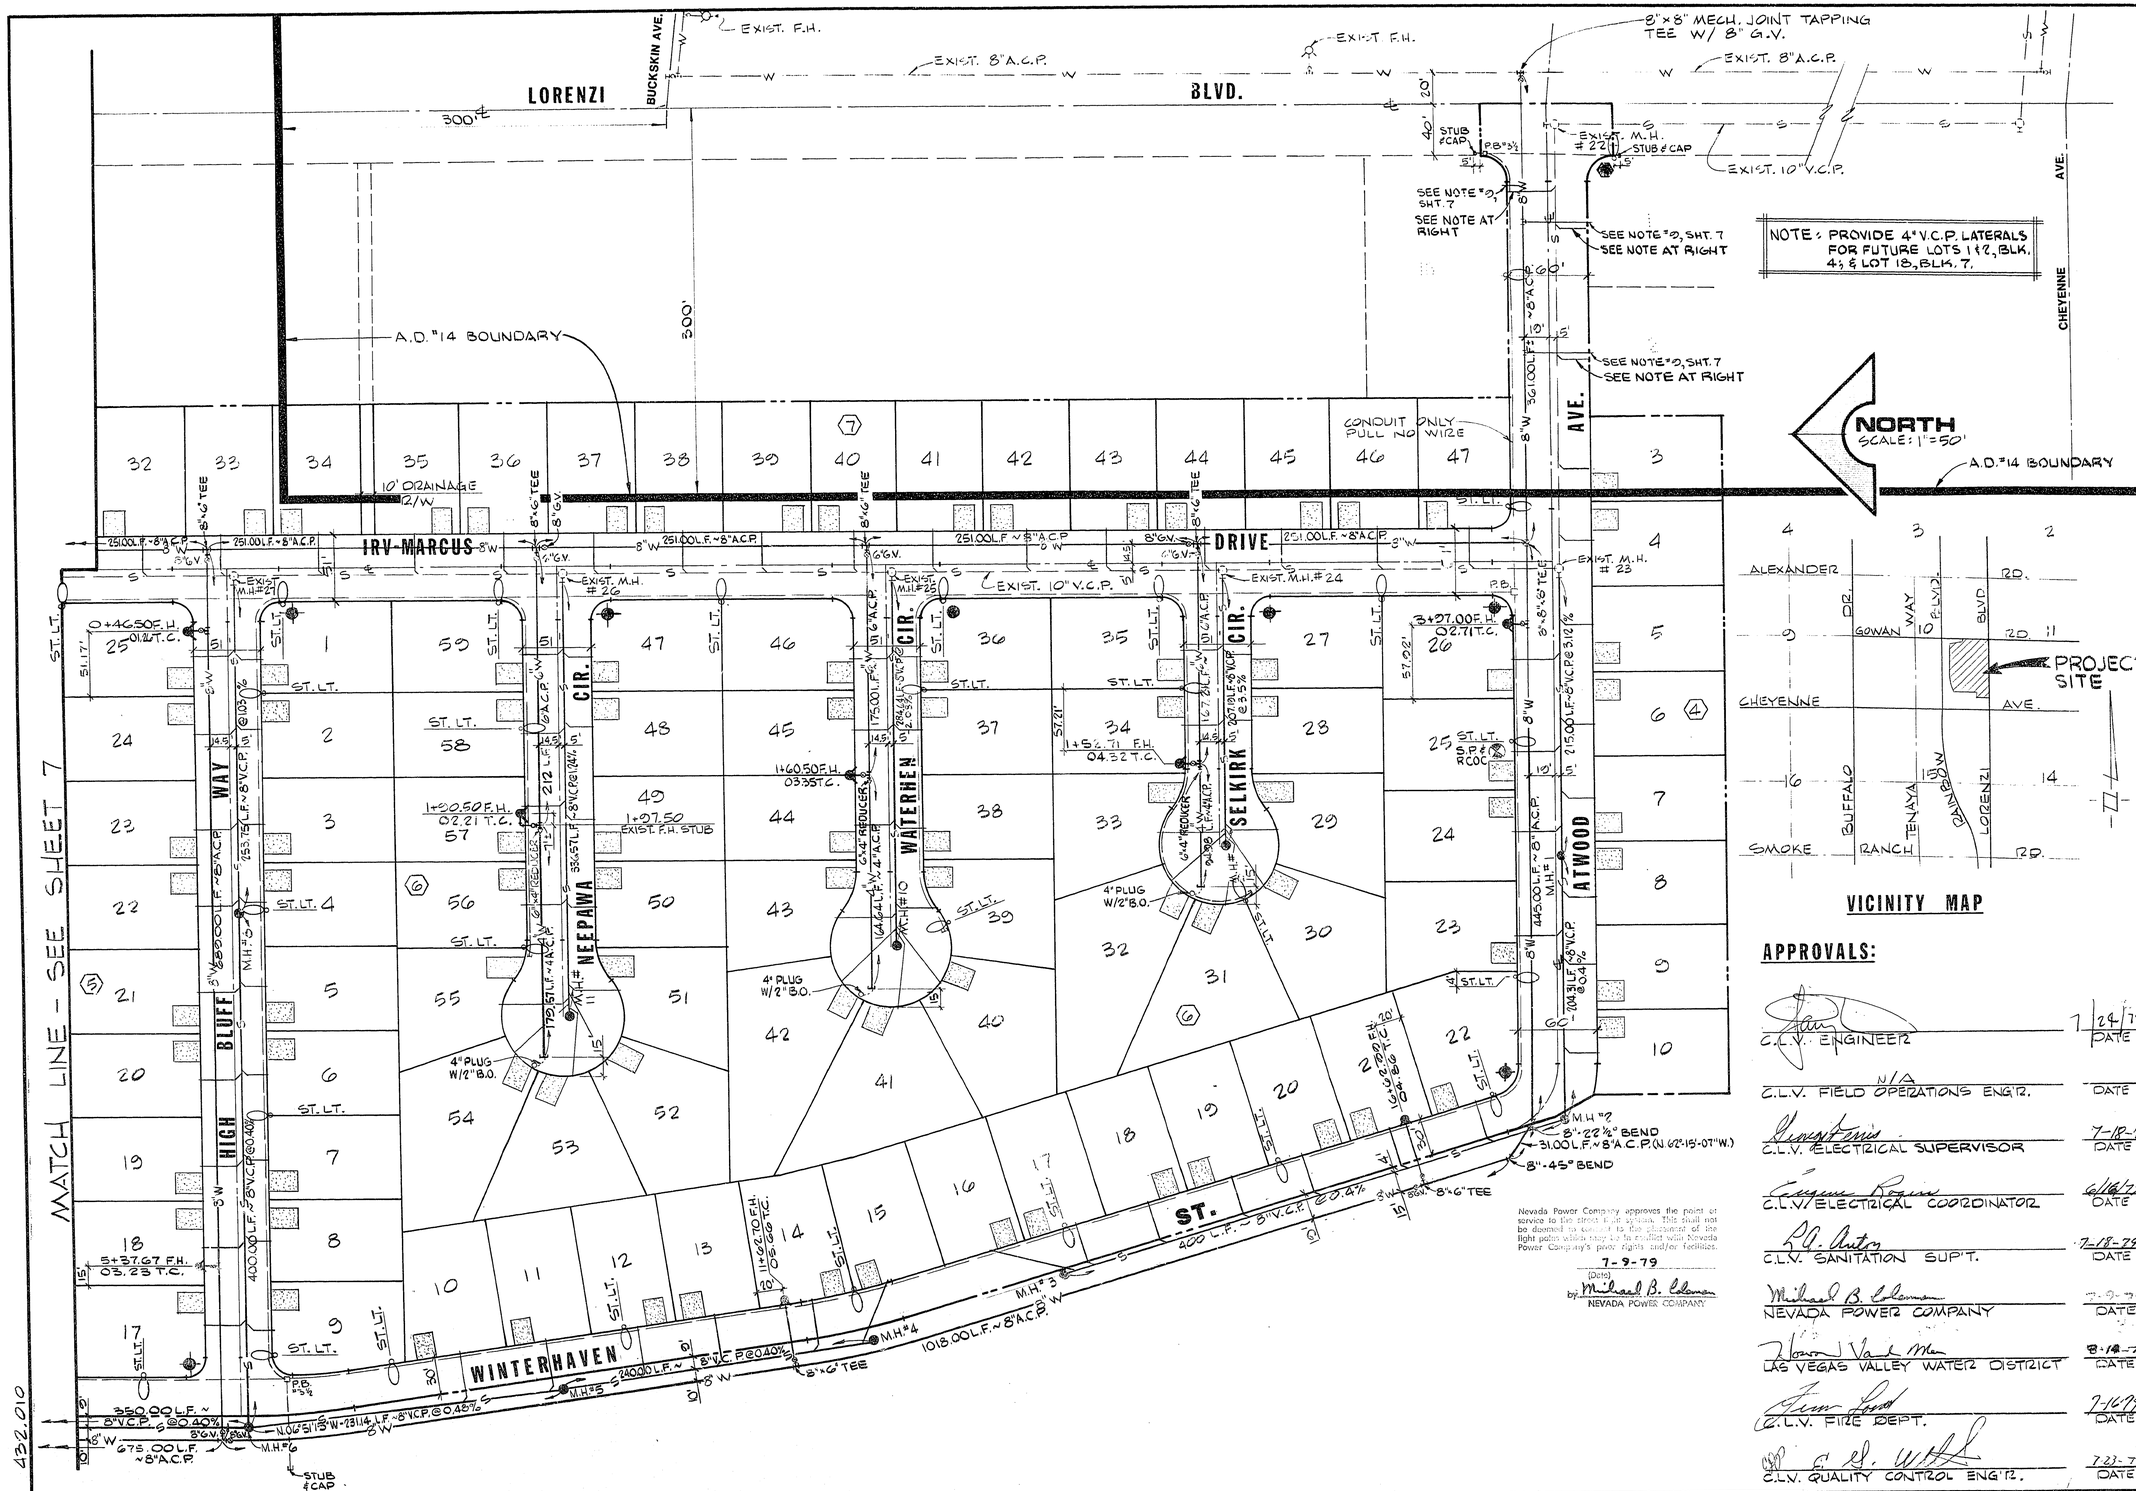

REV	DATE	DESCRIPTION
1	8/14/79	RELOCATED F.H. ON NEEPAWA CIR. -10' EAST
2	1/3/80	RELOCATED F.H. ON NEEPAWA CIR.
3	2/20/80	ADD 4" V.C.P. LATERALS FOR FUTURE SERVICE, BLK. 2 & 7

RECOMMENDED: 3724 R.E. NO. — 7/24/79 DATE — G. C. WALLACE

G. C. WALLACE
Consulting Engineers, Inc.
1100 East Sahara Ave. · Las Vegas, Nevada 89104 · 732-3330

BECKER & SONS
CHARLESTON HEIGHTS — TRACT NO. 56A
UTILITY PLAN I

APPROVALS:

C.L.V. ENGINEER	7/24/79 DATE
C.L.V. FIELD OPERATIONS ENG'R. N/A	DATE
C.L.V. ELECTRICAL SUPERVISOR	7-18-79 DATE
C.L.V. ELECTRICAL COORDINATOR	6/18/79 DATE
C.L.V. SANITATION SUP'T.	7-18-79 DATE
NEVADA POWER COMPANY	7-9-79 DATE
LAS VEGAS VALLEY WATER DISTRICT	8-14-79 DATE
C.L.V. FIRE DEPT.	7-16-79 DATE
C.L.V. QUALITY CONTROL ENG'R.	7-23-79 DATE

SHEET 6 OF 23 SHEETS

9/78 DIETERICH-POST 6532B

3078-1040-56A