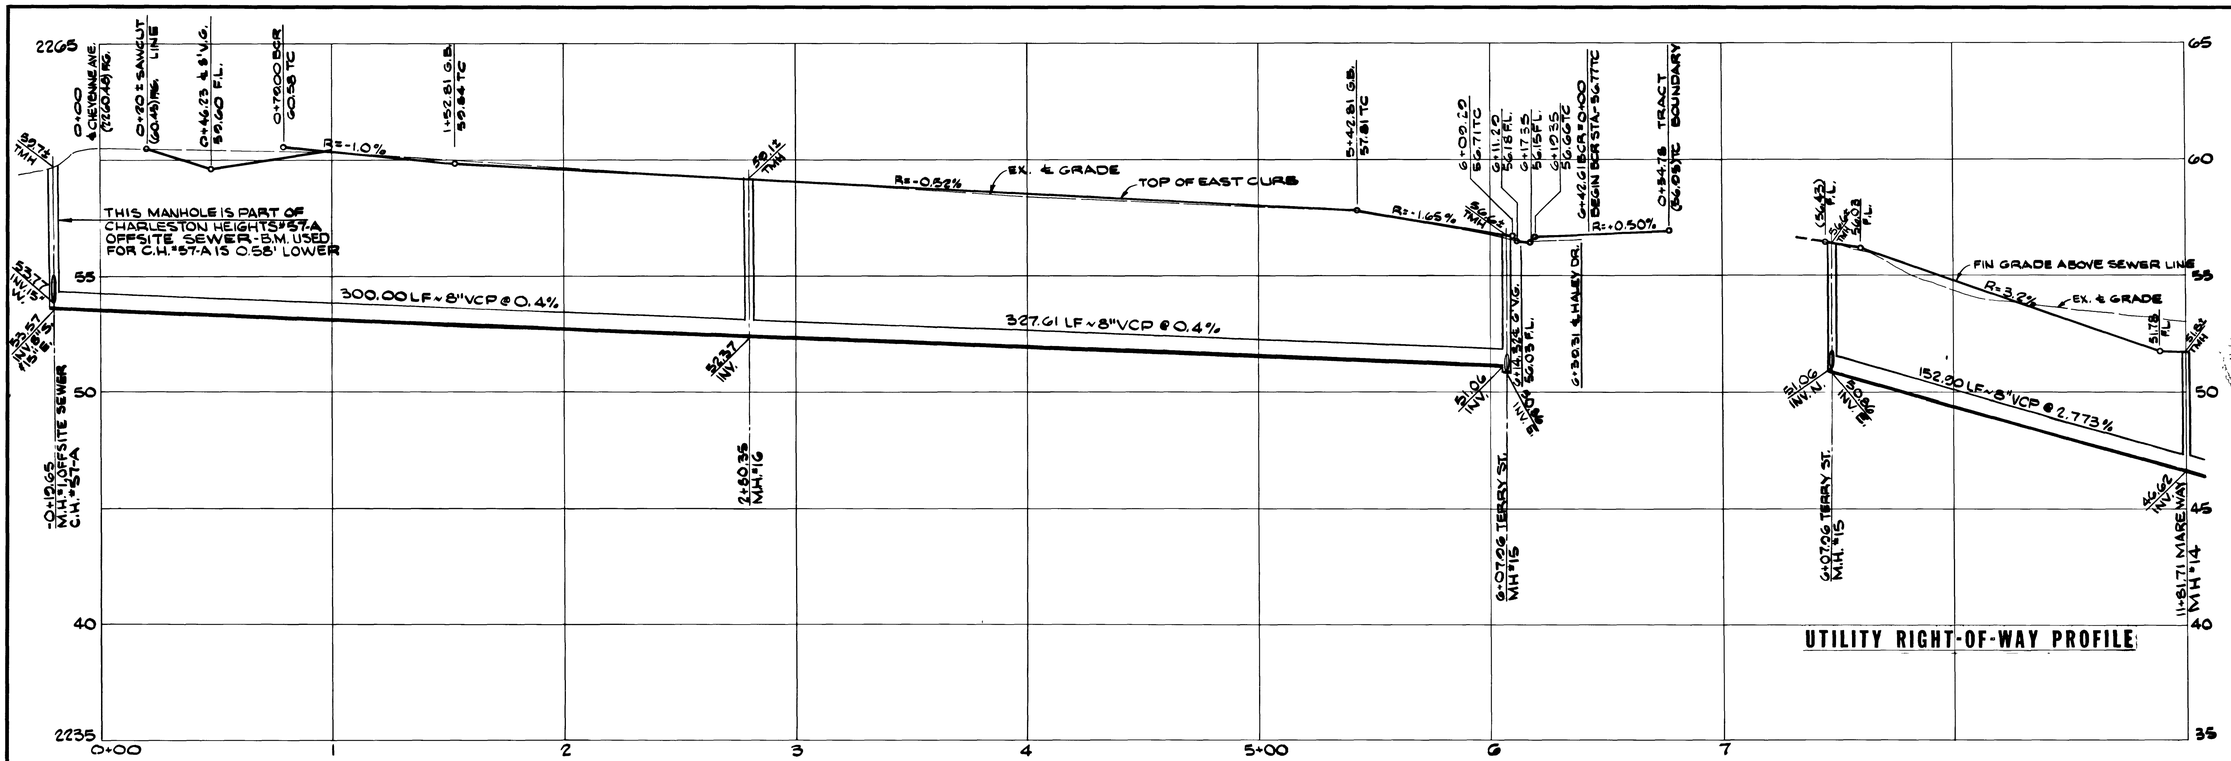

PROFILE

SCALE: HORIZ. 1" = 30'
VERT. 1" = 5'

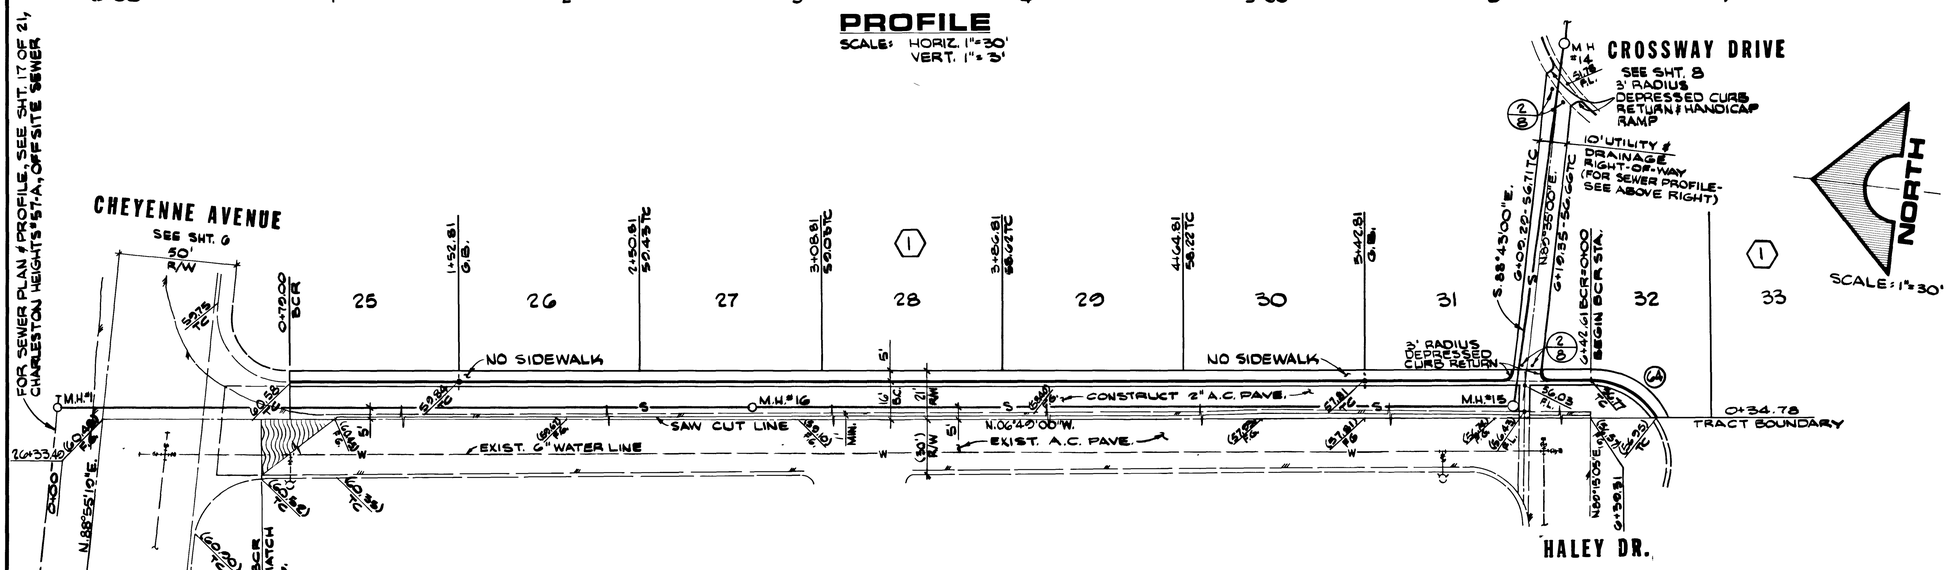

NOTE:
PORTION WEST OF ℄ OF TERRY ST. IS TO BE CONSTRUCTED BY OTHERS

CURVE DATA				
NO.	Δ	B.C.R.	L	T
64	66°25'10"	30.00'	34.78'	19.64'

APPROVALS:

C.L.V. ENGINEER	2/21/79 DATE	C.L.V. TRAFFIC ENGINEER	2-14-79 DATE
C.L.V. FIELD OPERATIONS ENGINEER	2-20-79 DATE	C.L.V. SANITATION SUPT.	2-14-79 DATE
		C.L.V. QUALITY CONTROL ENG'R.	2-19-79 DATE

REV	DATE	DESCRIPTION
1	8/24/79	ADDED DEPRESSED CURB RETURN & HANDICAP RAMP & DRAINAGE R/W
		DELETED STL. PL.

RECOMMENDED: G. C. WALLACE
D. LUNA
C.L.V. 4 3/8/79 DATE
REGISTERED PROFESSIONAL ENGINEER No. 3794

G. C. WALLACE
Consulting Engineers, Inc.
1100 East Sahara Ave. · Las Vegas, Nevada 89104 · 732-3330

BECKER & SONS
CHARLESTON HEIGHTS — TRACT NO. 55-B
TERRY STREET

SHEET 7 OF 12 SHEETS

345220

9/78 DIETERICH-POST 6420B

3050

1079-1040-558

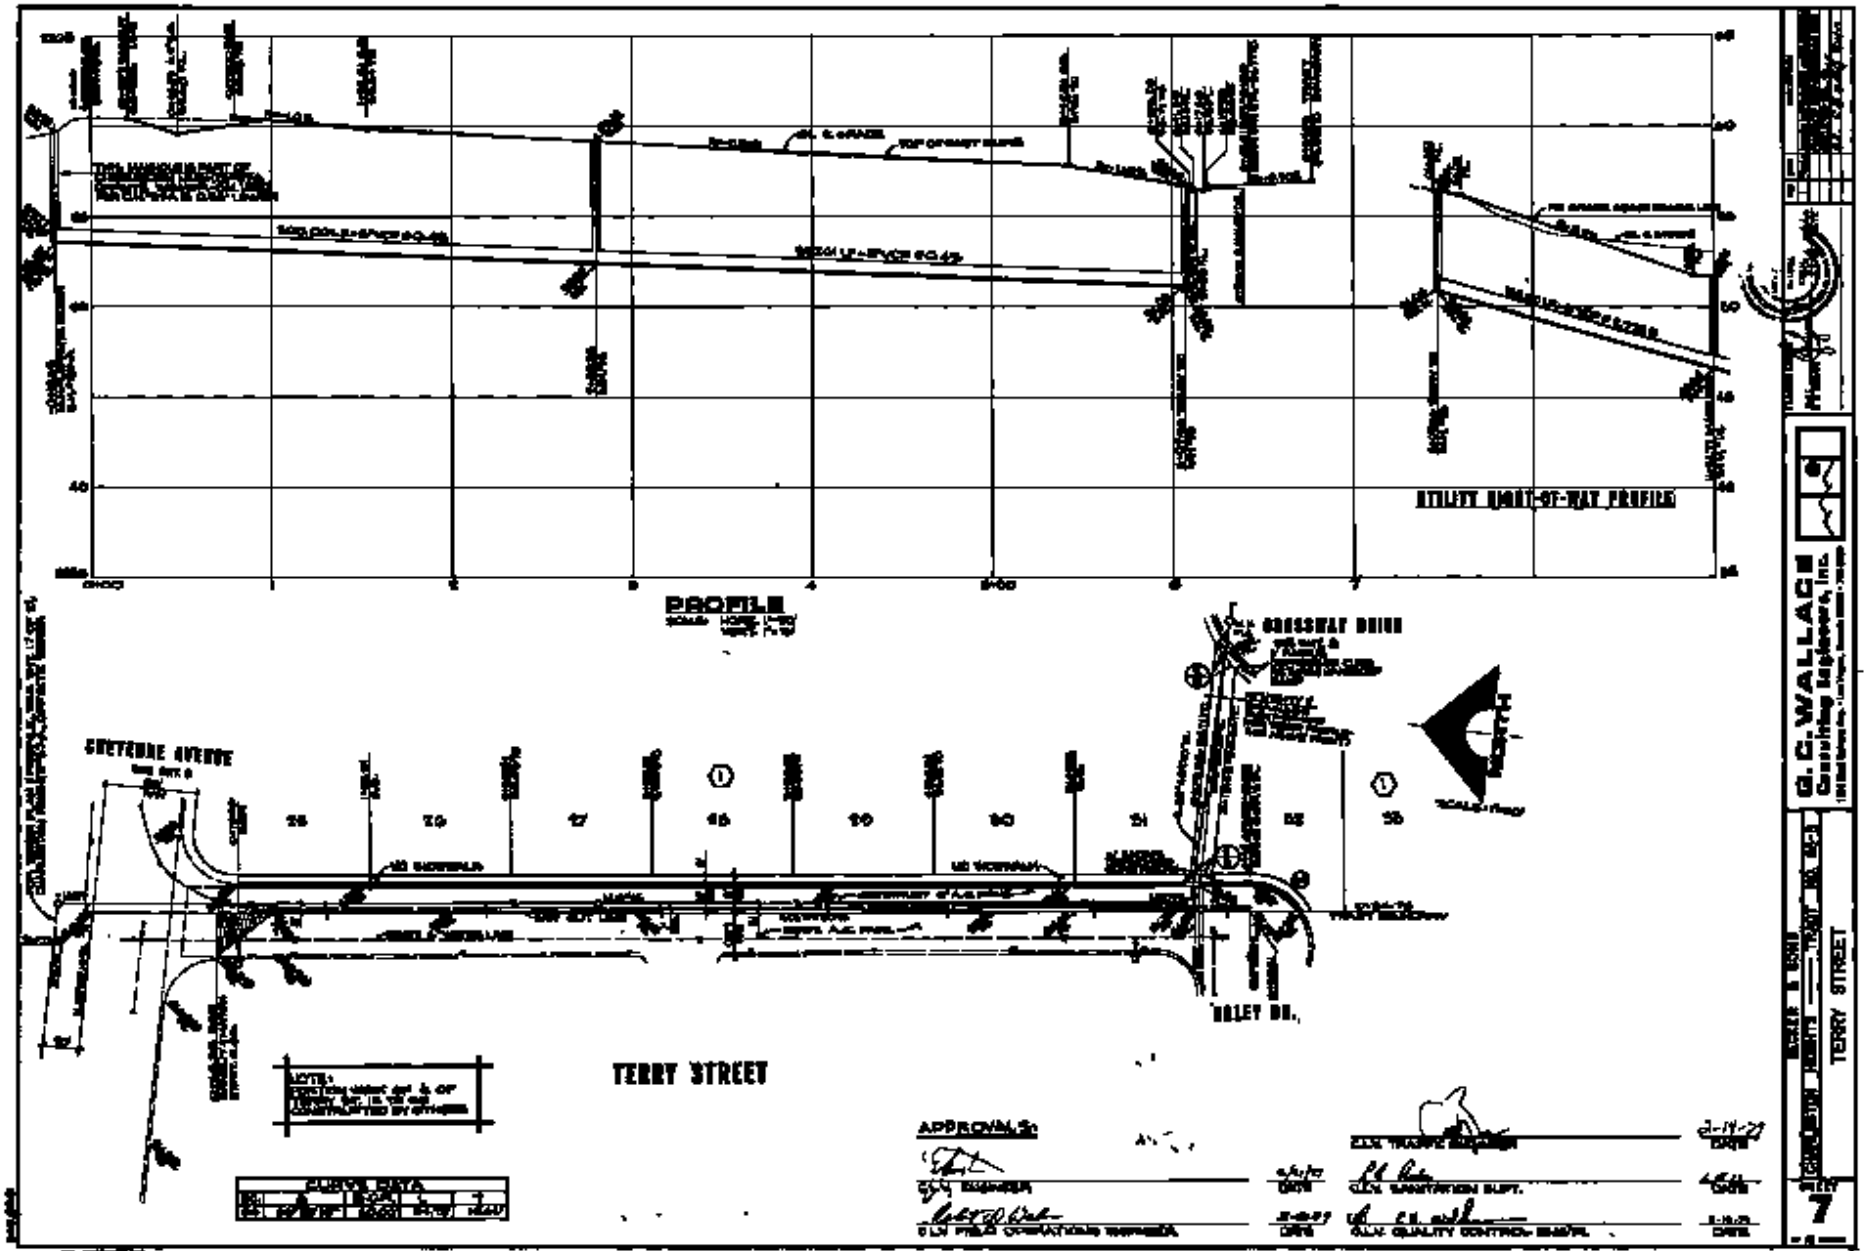
UTILITY RIGHT-OF-WAY PROFILE
PROFILE
TERRY STREET
APPROVALS:
G.C. WALLACE
Consulting Engineers, Inc.
TERRY STREET
SHEET
7