


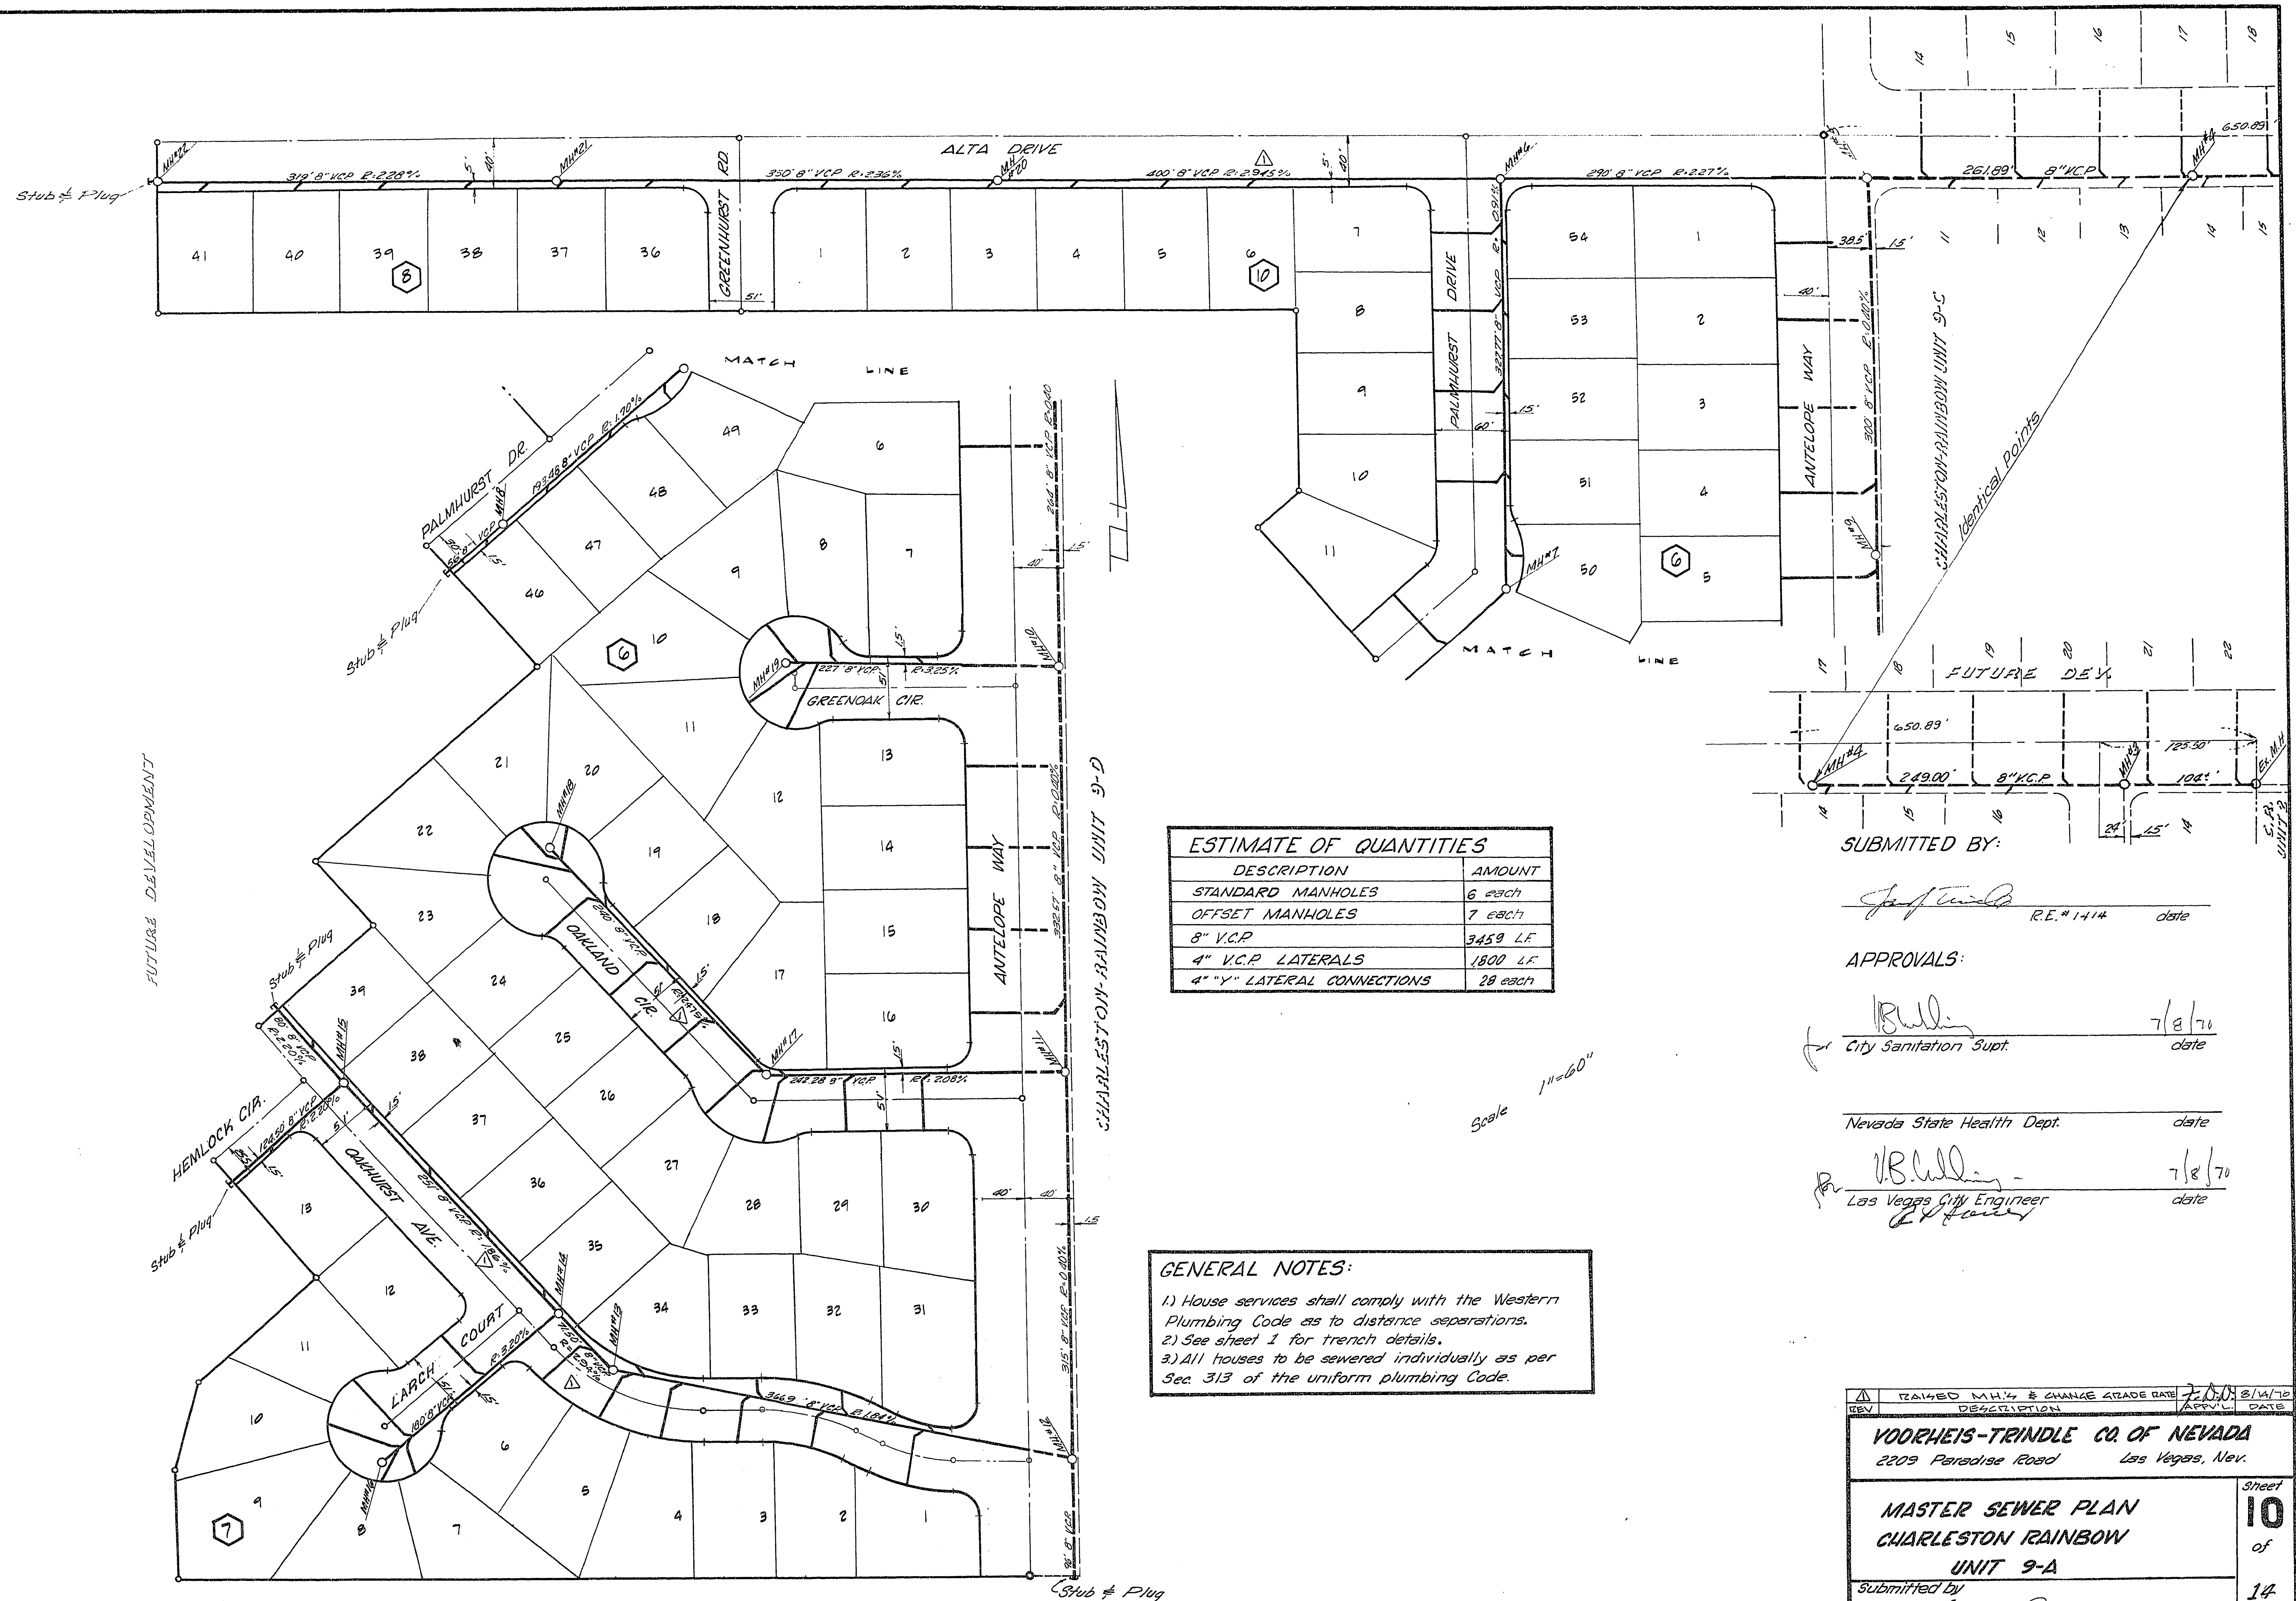

ESTIMATE OF QUANTITIES	
DESCRIPTION	AMOUNT
STANDARD MANHOLES	6 each
OFFSET MANHOLES	7 each
8" V.C.P.	3459 LF
4" V.C.P. LATERALS	1800 LF
4" "Y" LATERAL CONNECTIONS	28 each

GENERAL NOTES:

- 1) House services shall comply with the Western Plumbing Code as to distance separations.
- 2) See sheet 1 for trench details.
- 3) All houses to be sewerer individually as per Sec. 313 of the uniform plumbing Code.

SUBMITTED BY: Jeff Trindle R.E. # 1-114 date

APPROVALS: B. Bullin 7/8/70
City Sanitation Supt. date

Nevada State Health Dept. date
By B. Bullin 7/8/70
Las Vegas City Engineer date

REV	DESCRIPTION	DATE
1	RAISED M.H.'s & CHANGE GRADE RATE	7-20-70
VOORHEIS-TRINDLE CO. OF NEVADA 2209 Paradise Road Las Vegas, Nev.		
MASTER SEWER PLAN CHARLESTON RAINBOW UNIT 9-A		Sheet 10 of 14
Submitted by <u>Jeff Trindle</u>		Date <u>4-22-70</u> R.E. 1A/1A