
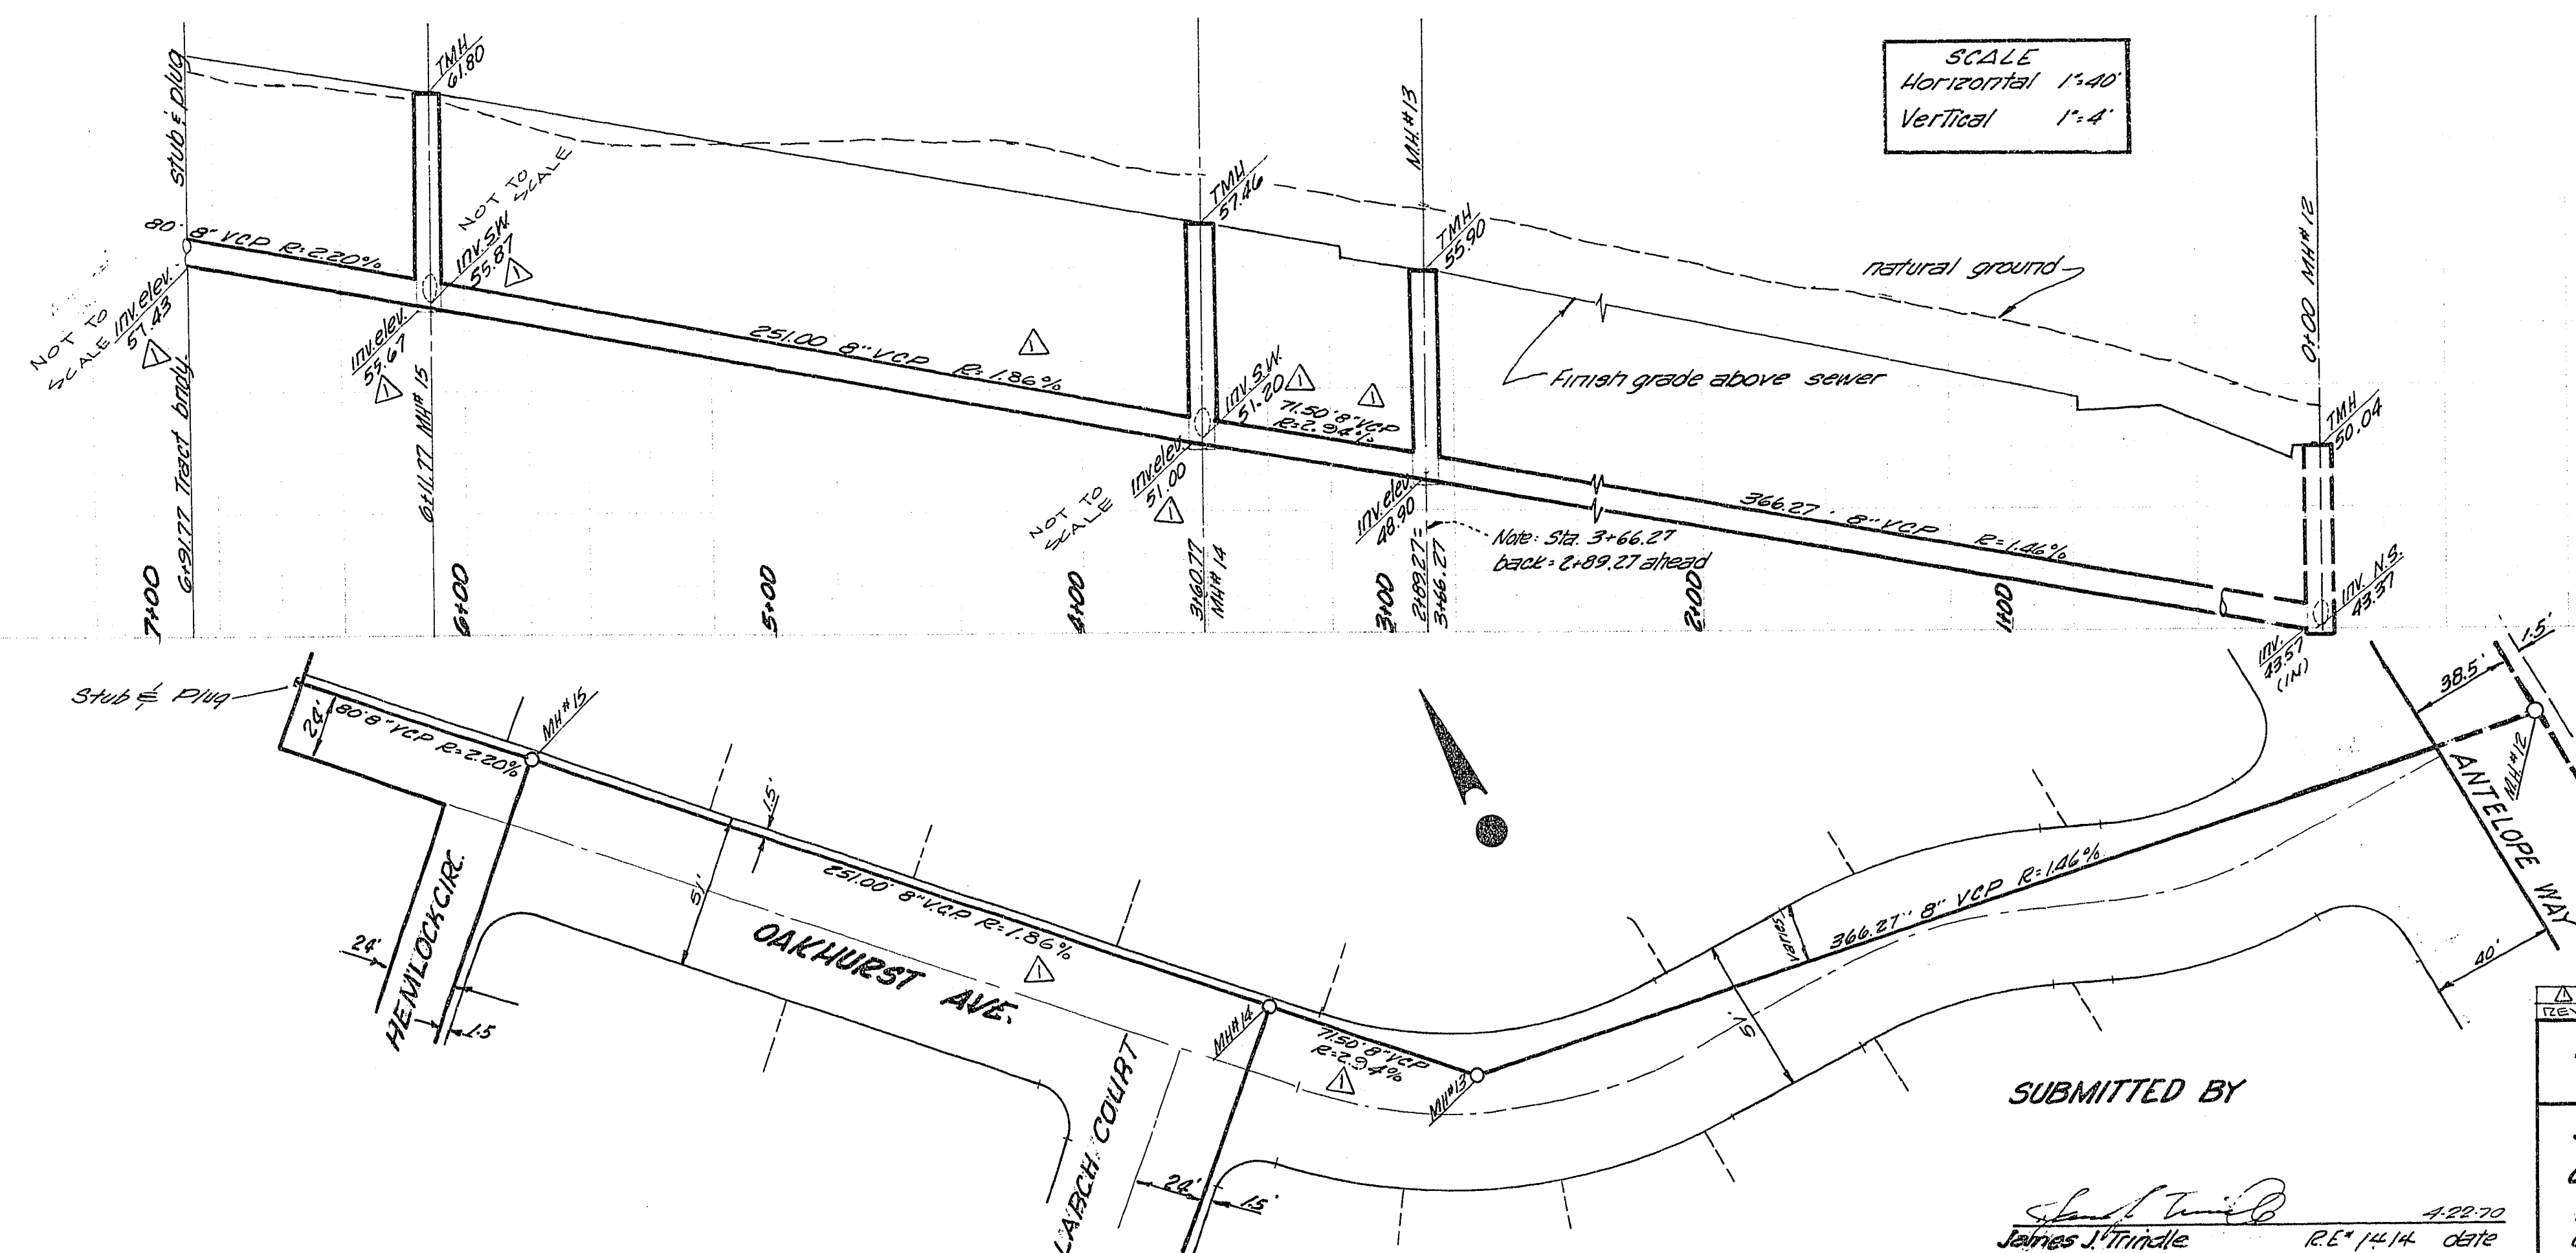


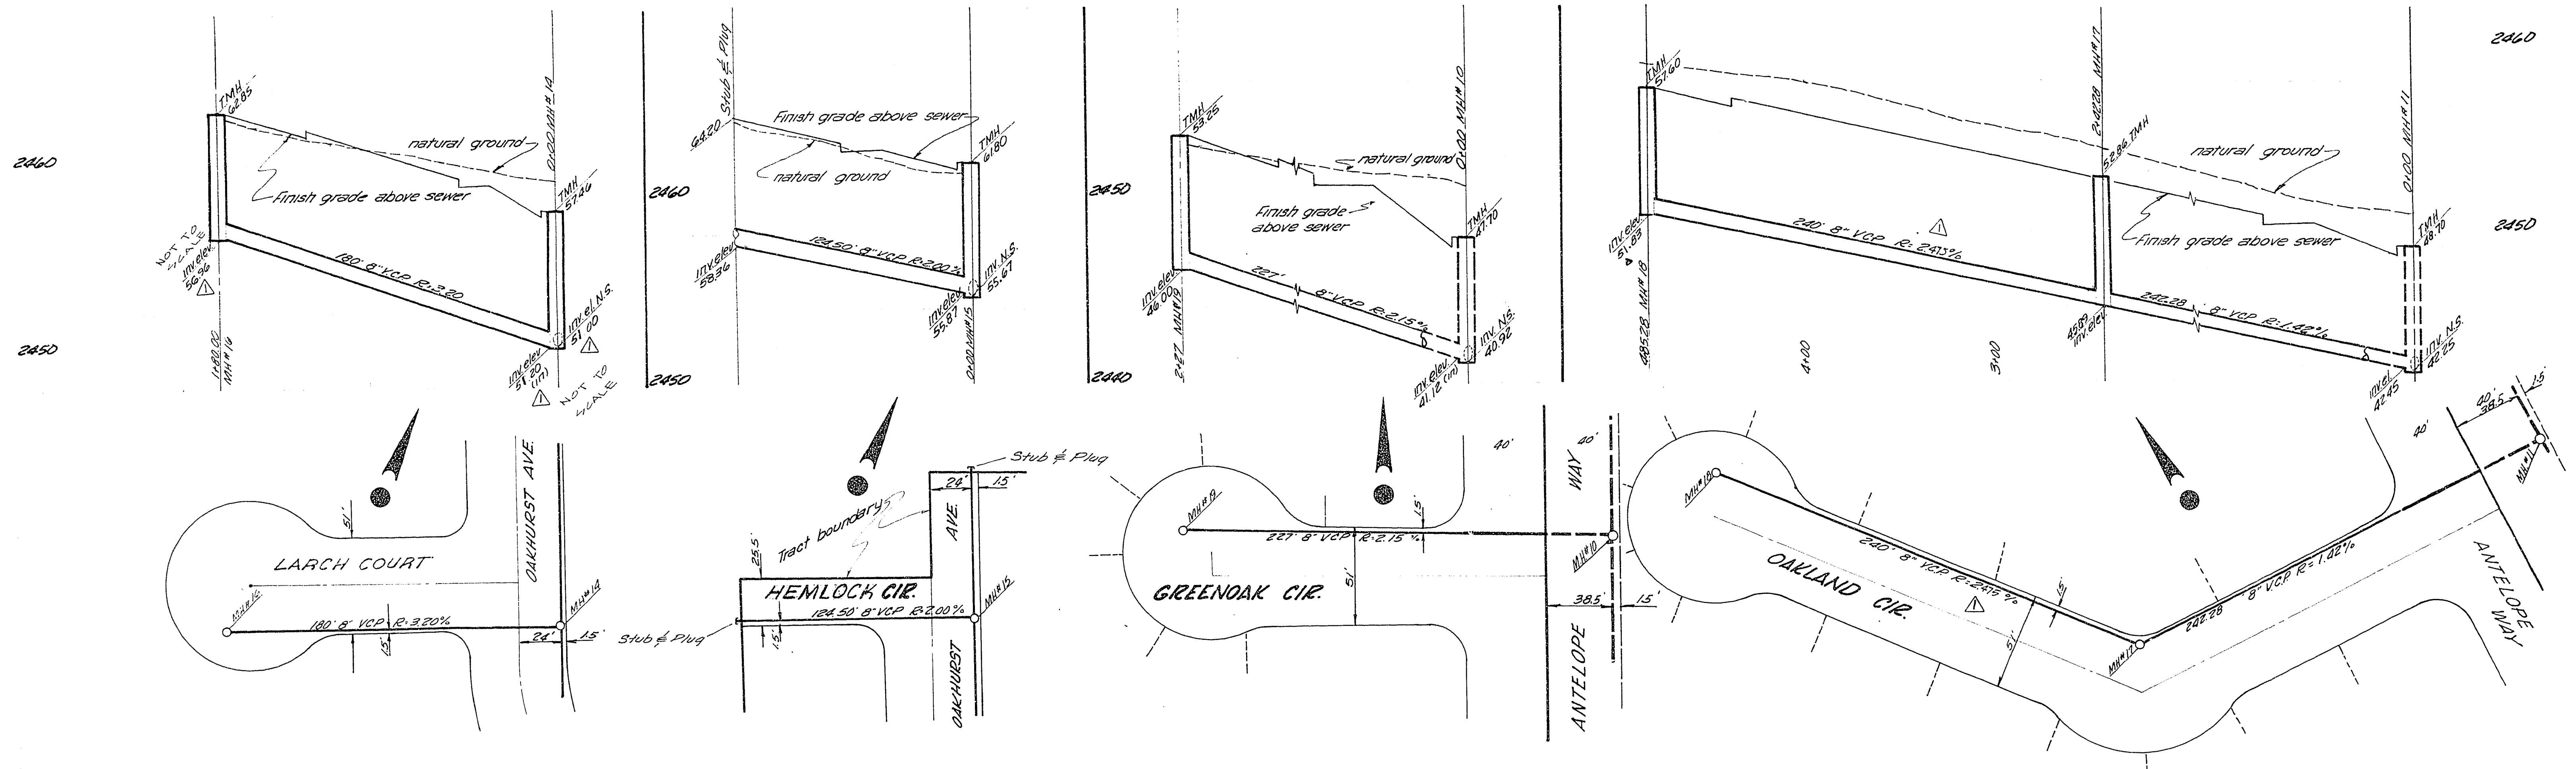

SUBMITTED BY
James J. Trindle
RE 1414 date 4-22-70

APPROVALS

J. D. Oakes 7-8-70
Las Vegas Field Engineer date
B. H. 7/6/70
Supt of Sanitation date
B. H. 7/8/70
Las Vegas City Engineer date

REV	DESCRIPTION	DATE
1	RAISED M.H.'s & CHANGE GRADE RATE	7/8/70
2	DESCRIPTION	7/8/70

VOORHEIS-TRINDLE CO. OF NEVADA
2209 Paradise Road Las Vegas, Nevada

SEWER PLAN & PROFILE
CHARLESTON RAINBOW UNIT 9-A
Larch Ct - Hemlock Cir - Greenoak Cir
Oakland Cir - Oakhurst Ave.

Sheet 13 of 14