
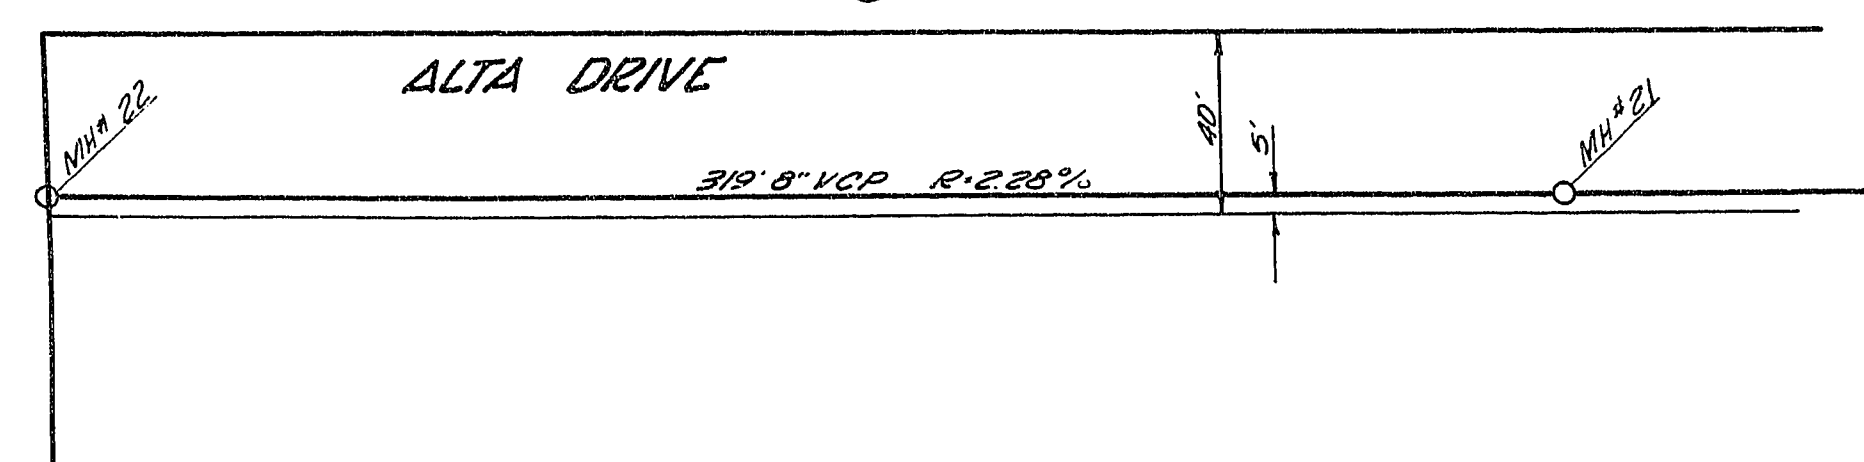
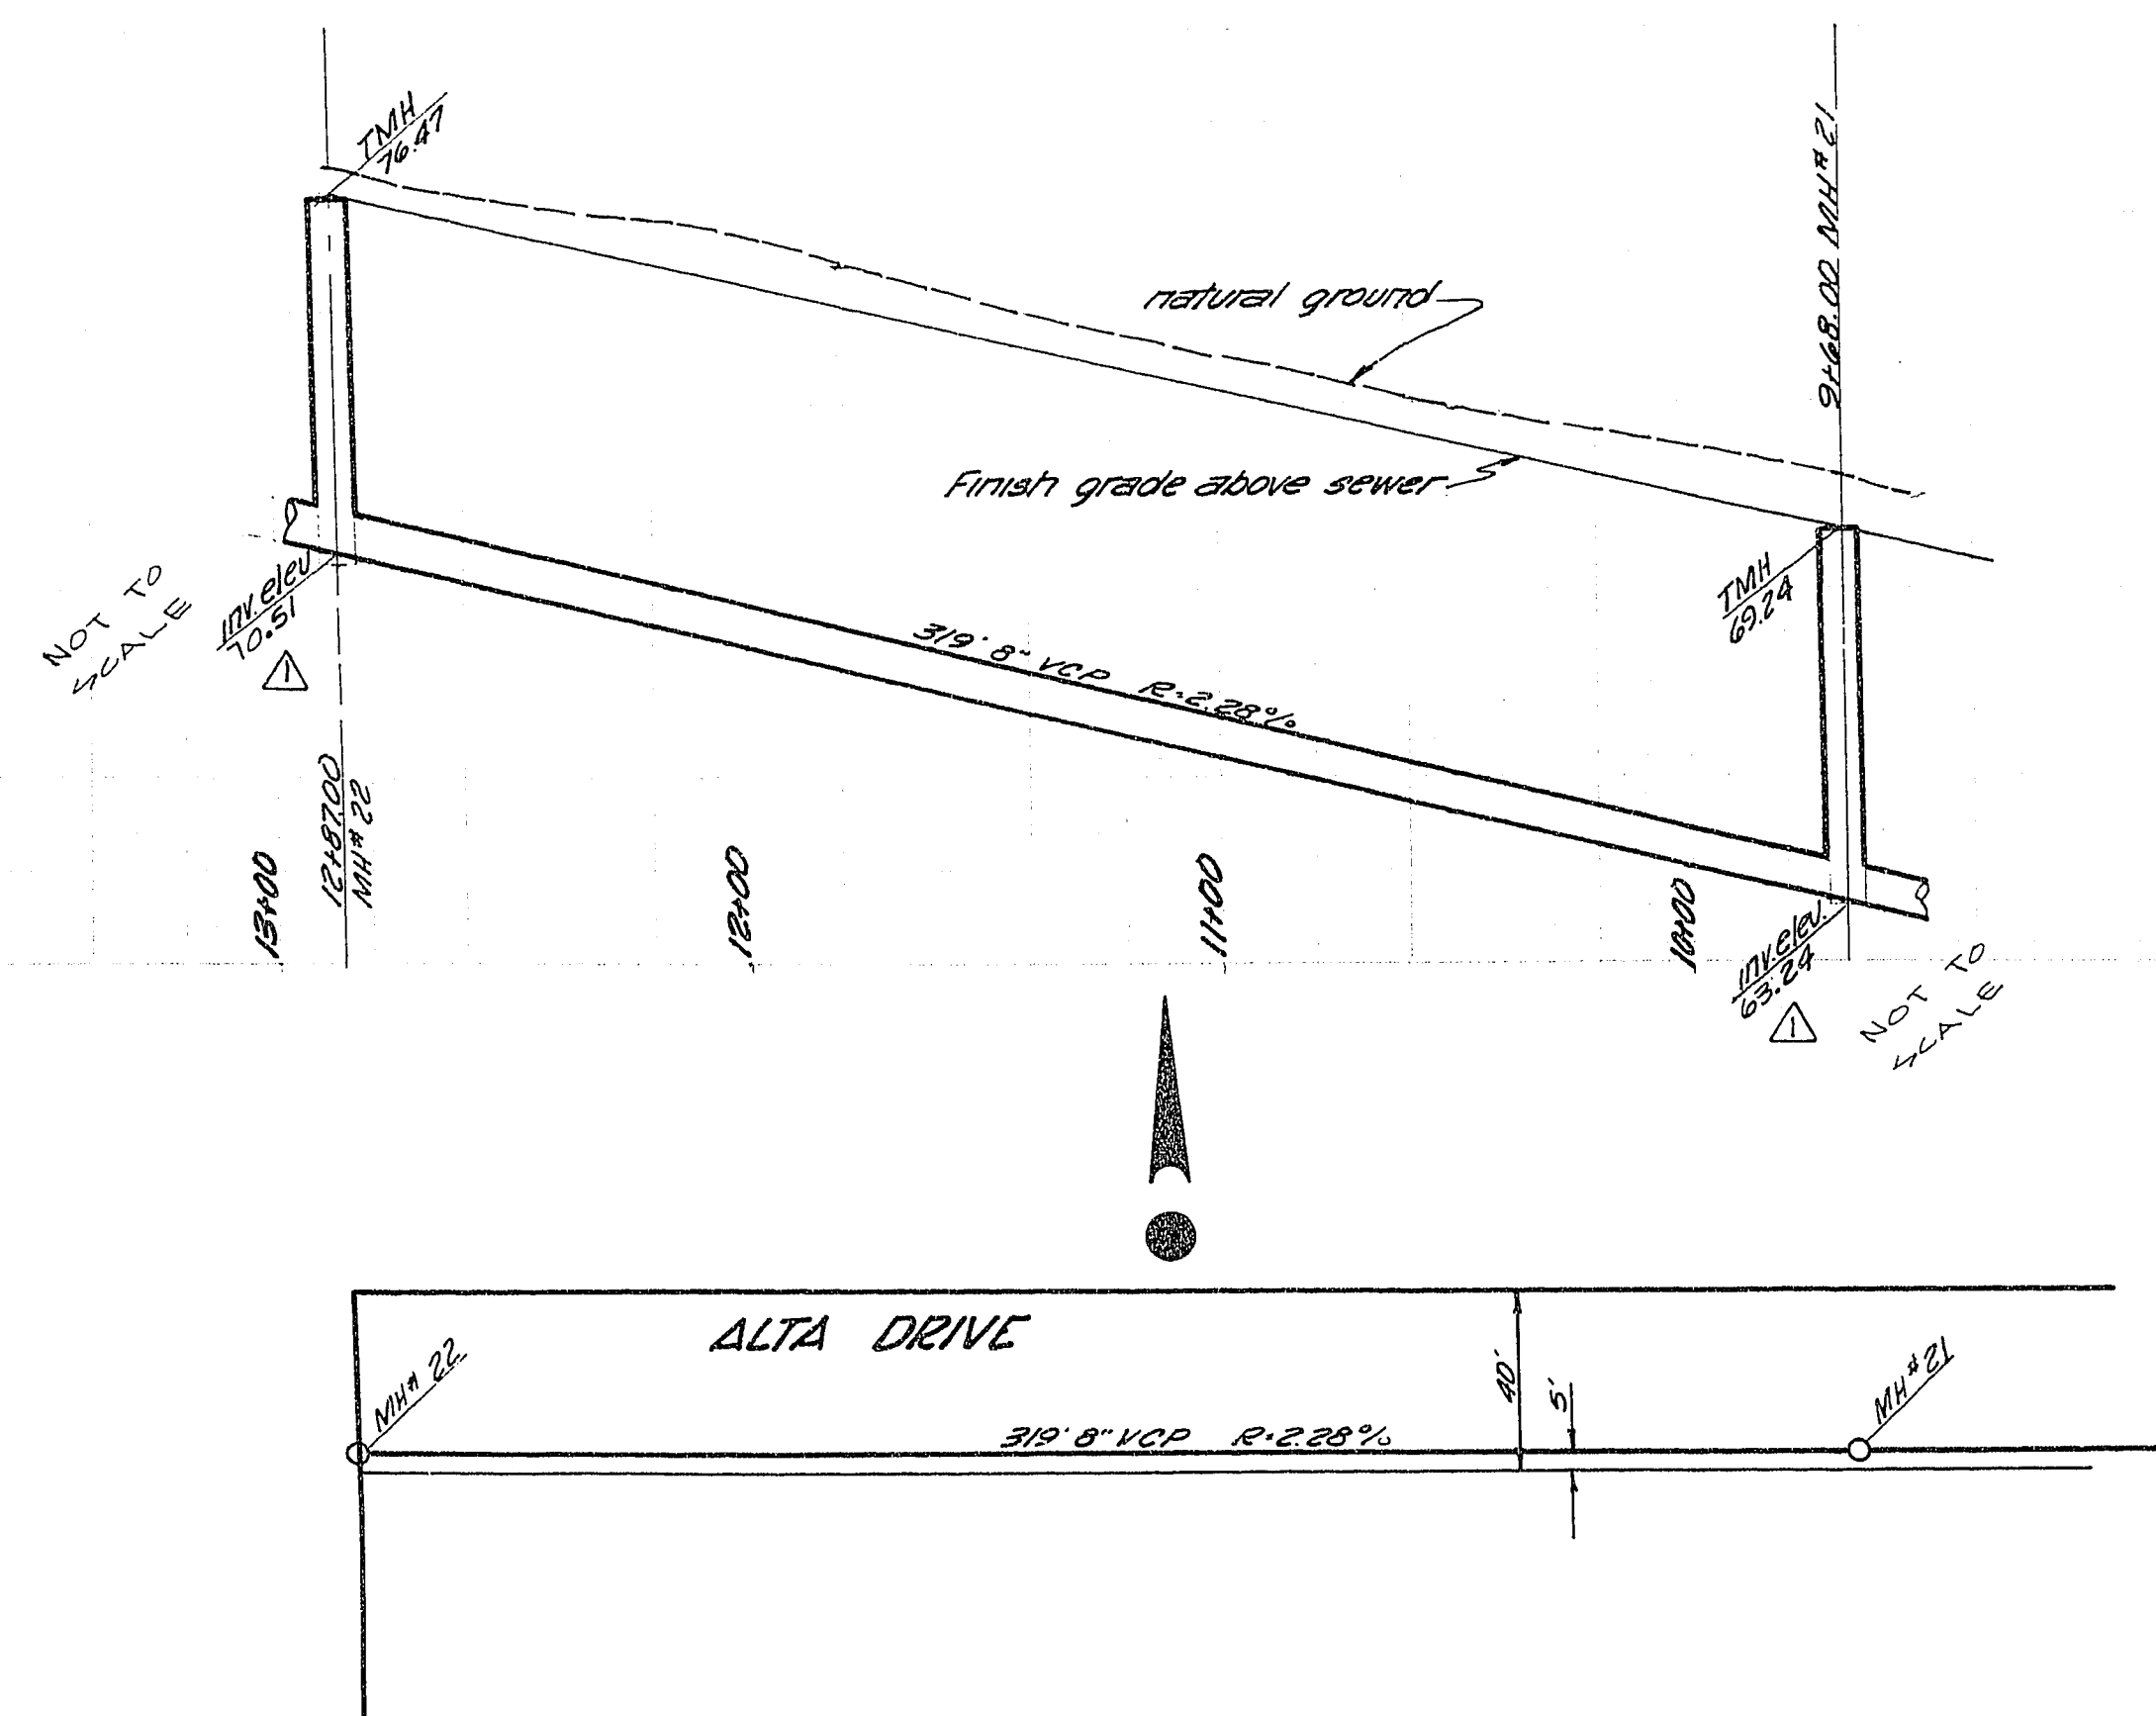
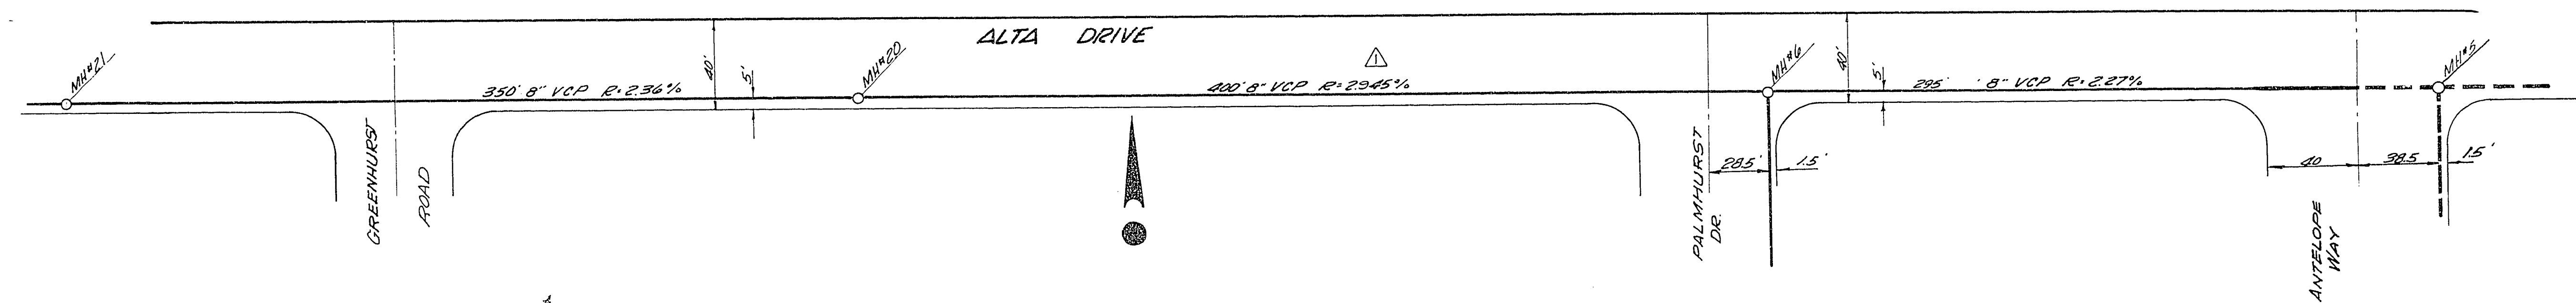


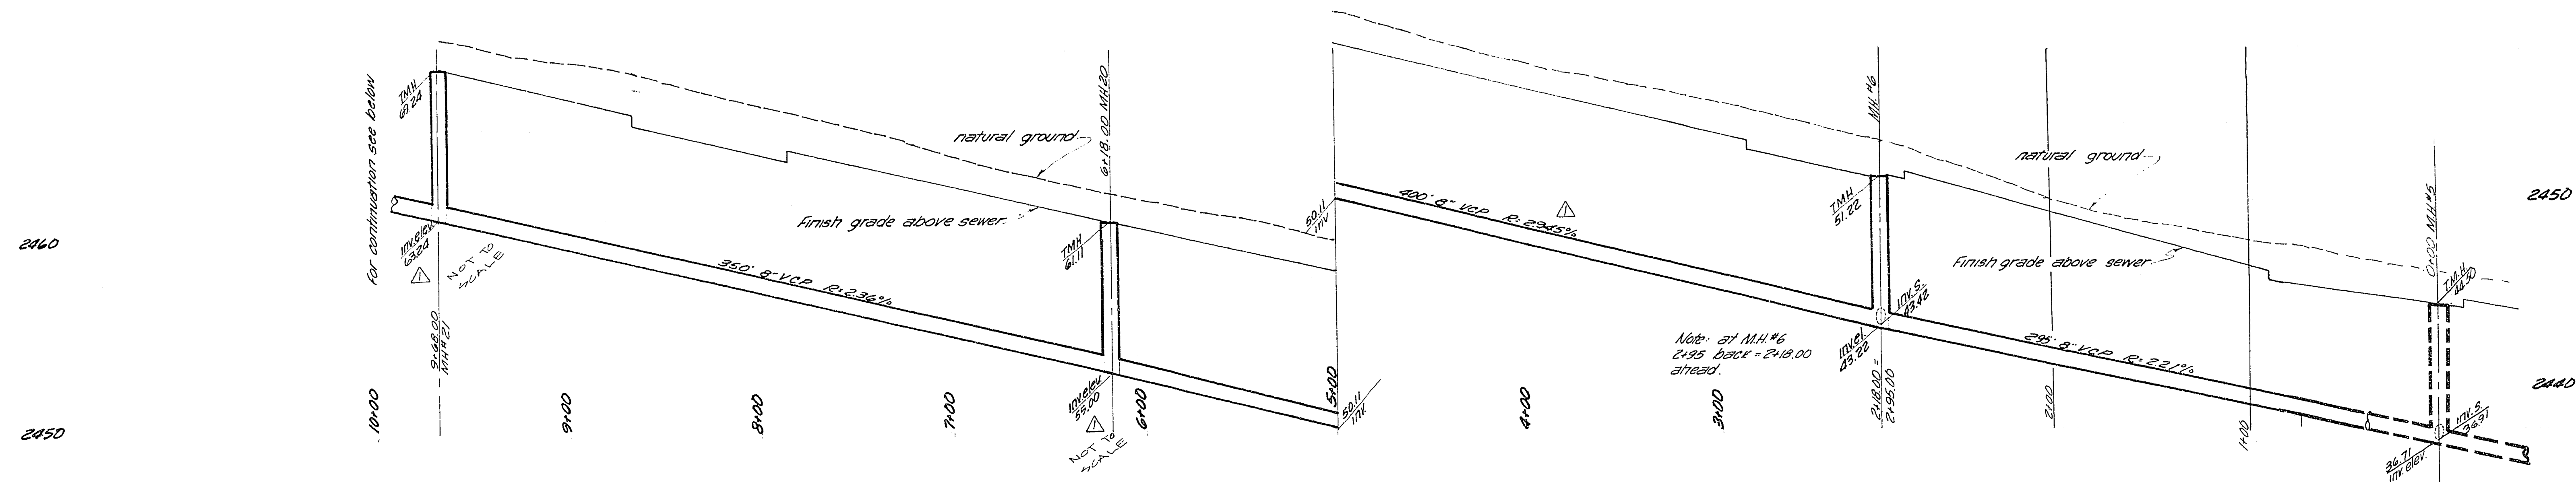

SCALE
Horizontal 1"=40'
Vertical 1"=4'

SUBMITTED BY:

James J. Trindle
James J. Trindle RE# 1414 6/72

APPROVALS							
<i>W. B. Sullivan</i> Las Vegas City Engineer	7/8/70 date						
<i>W. B. Sullivan</i> Supt. of Sanitation	7/8/70 date						
<i>J. D. Sullivan</i> City of Las Vegas Field Engineer	7-8-70 date						
<table border="1"> <thead> <tr> <th>REVISION</th> <th>DESCRIPTION</th> <th>DATE</th> </tr> </thead> <tbody> <tr> <td>1</td> <td>TRAINED M.H.'s & CHANGE GRADE RATE</td> <td>7/8/70</td> </tr> </tbody> </table>		REVISION	DESCRIPTION	DATE	1	TRAINED M.H.'s & CHANGE GRADE RATE	7/8/70
REVISION	DESCRIPTION	DATE					
1	TRAINED M.H.'s & CHANGE GRADE RATE	7/8/70					
VOORHEIS-TRINDLE CO. OF NEVADA 2209 Paradise Road Las Vegas, Nev.							
SEWER PLAN & PROFILE CHARLESTON RAINBOW UNIT 9-A ALTA DRIVE							
SHEET 14 OF 14							