
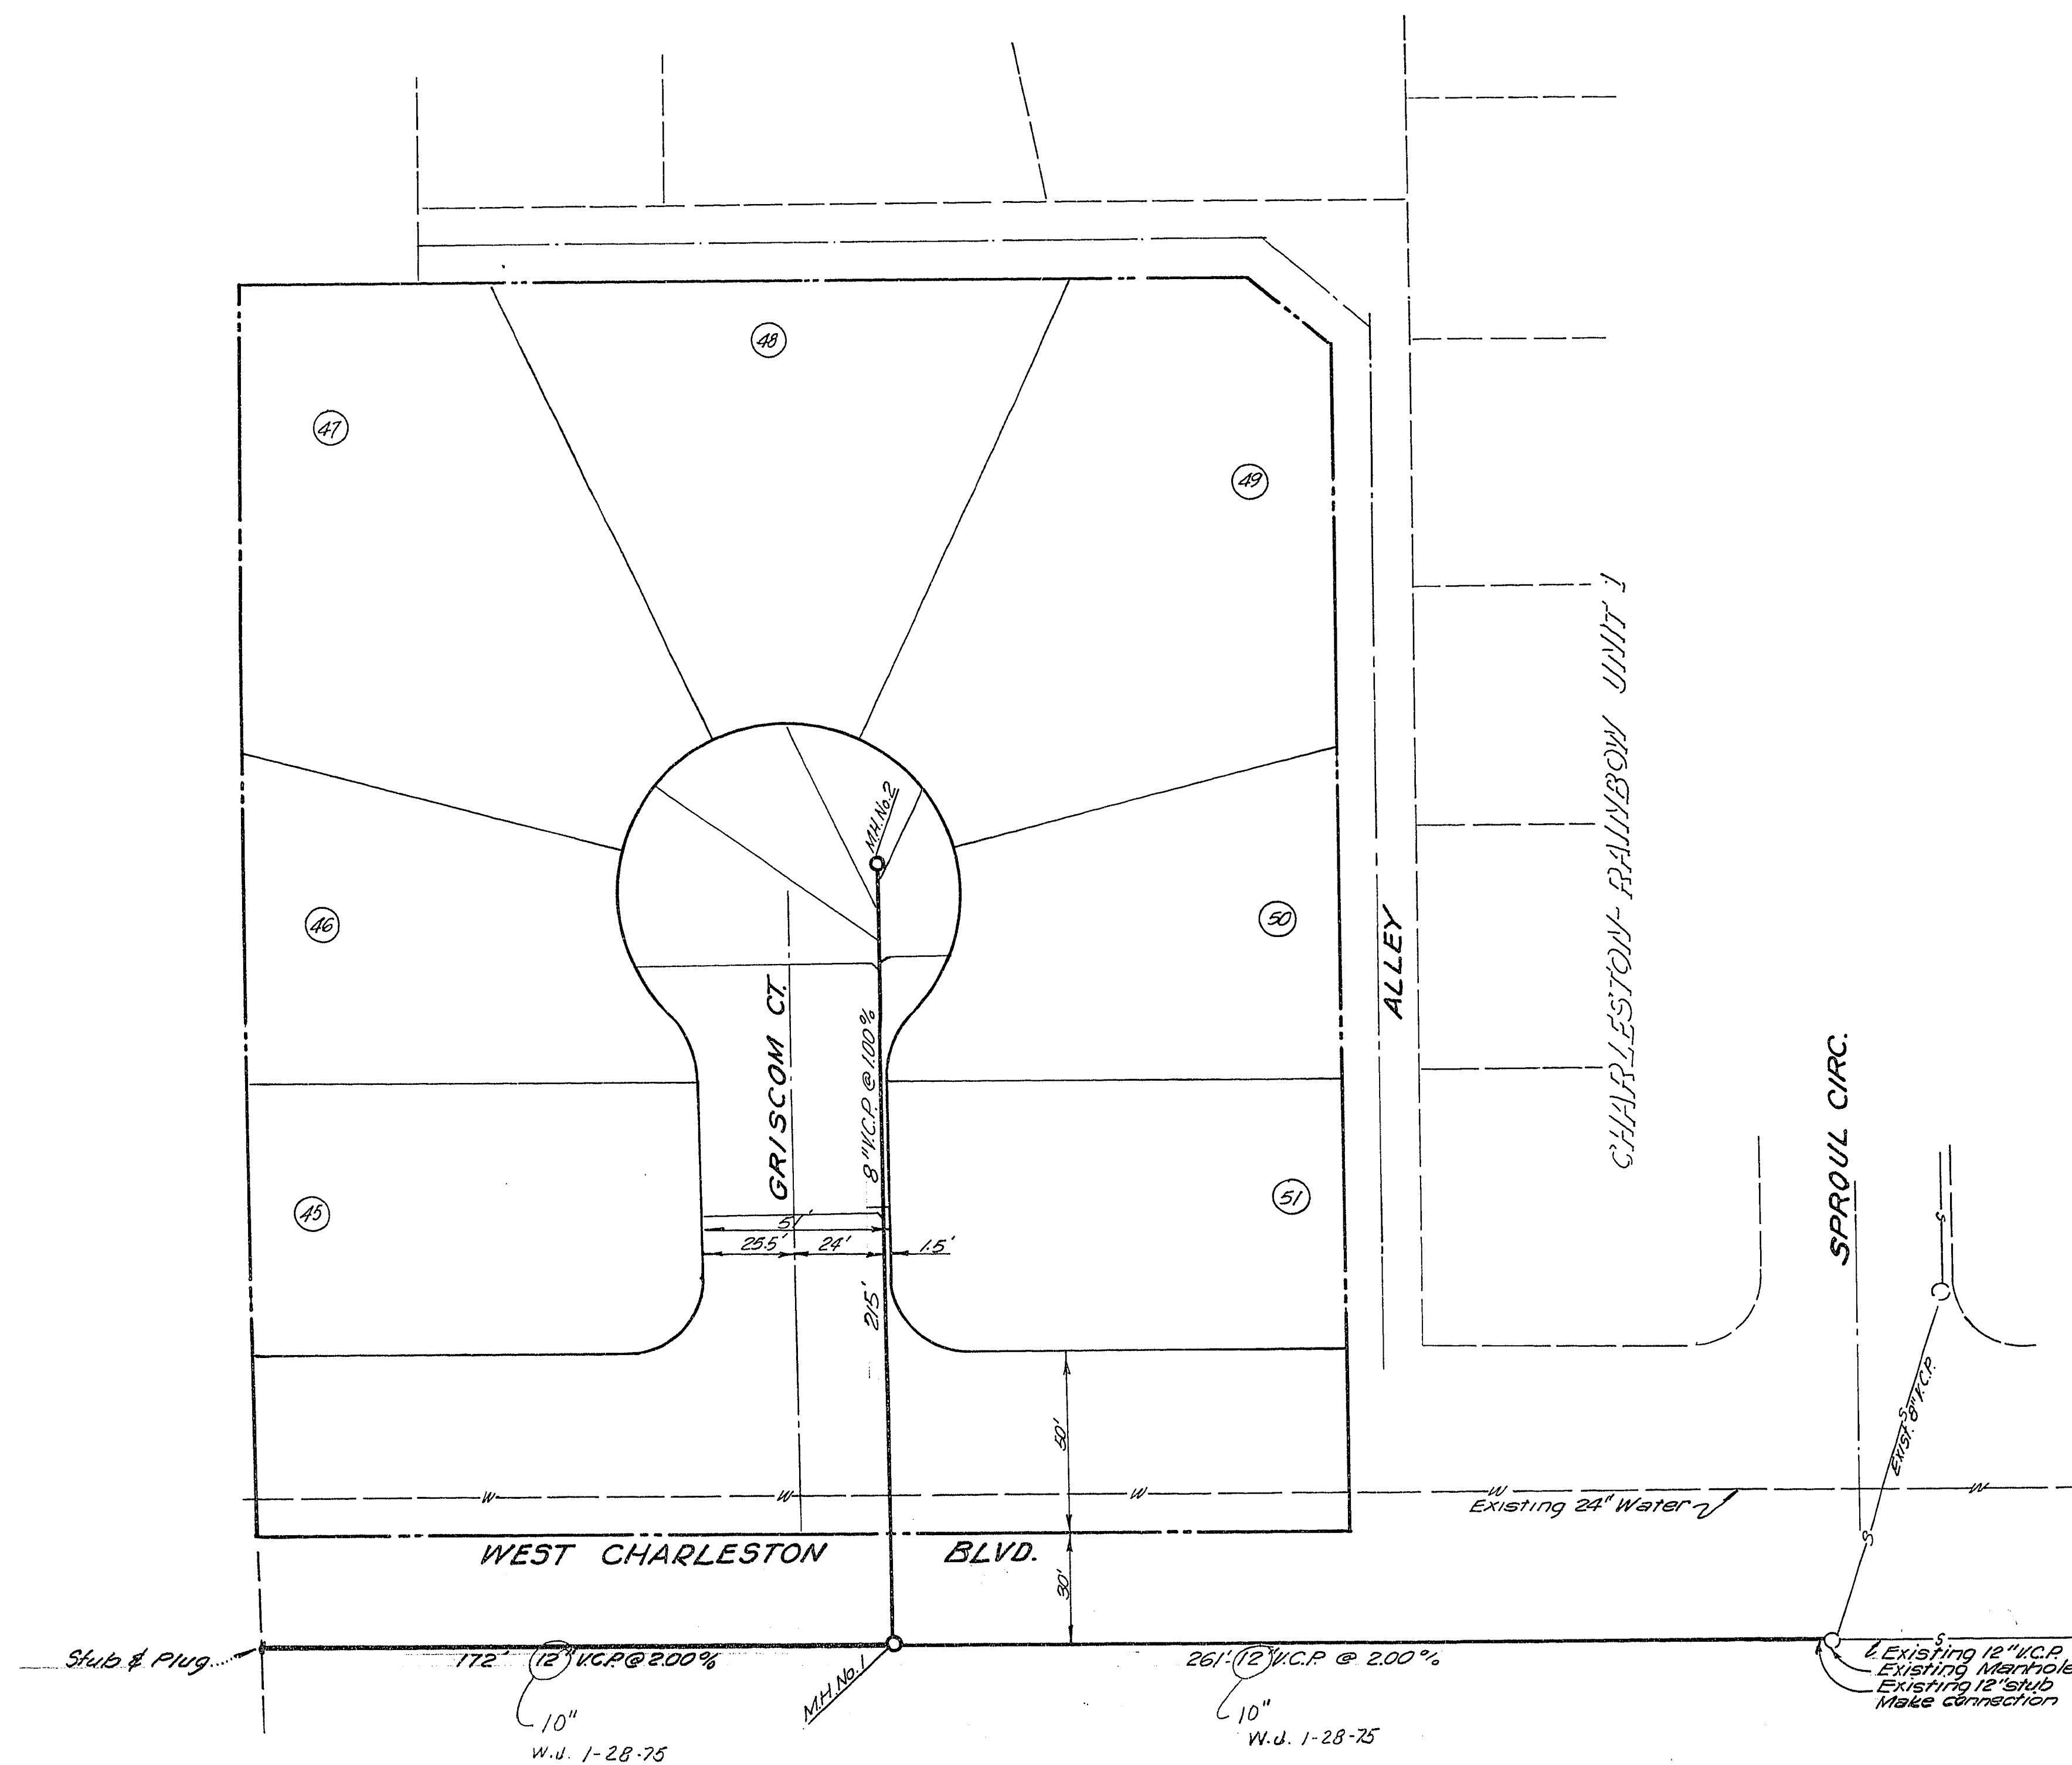


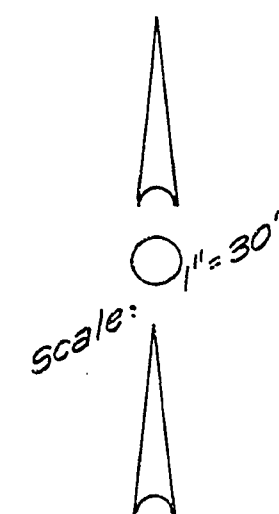

GENERAL NOTES:

1. All sewer materials & construction shall meet the standards & specifications of the Las Vegas Engineering Dept. & Las Vegas Sanitation Dept.
2. All house services shall conform to the Western Plumbing Code.
3. See sheet 1 for ditch details.

ESTIMATE OF QUANTITIES

1. Standard Sewer Manholes	2 Ea.
2. 12" V.C.P. Sewer Main	433 L.F.
3. 8" V.C.P. Sewer Main	215 L.F.
4. 4" V.C.P. Sewer Laterals	7 Ea.
5. 12" Sewer stub	1 Ea.

APPROVALS:

<i>[Signature]</i> City Engineer	10-9-68 Date
<i>[Signature]</i> Field Engineer	9-27-68 Date
Supt. of Sanitation	Date

VOORHEIS-TRINDLE CO. OF NEVADA

CHARLESTON-RAINBOW UNIT No. 8
MASTER SEWER PLAN

Submitted by
[Signature] 2/12/69
Victor G. Krametbauer, R.C.E. 1511 Date

Sheet
4
of 6

3074-1055-8