
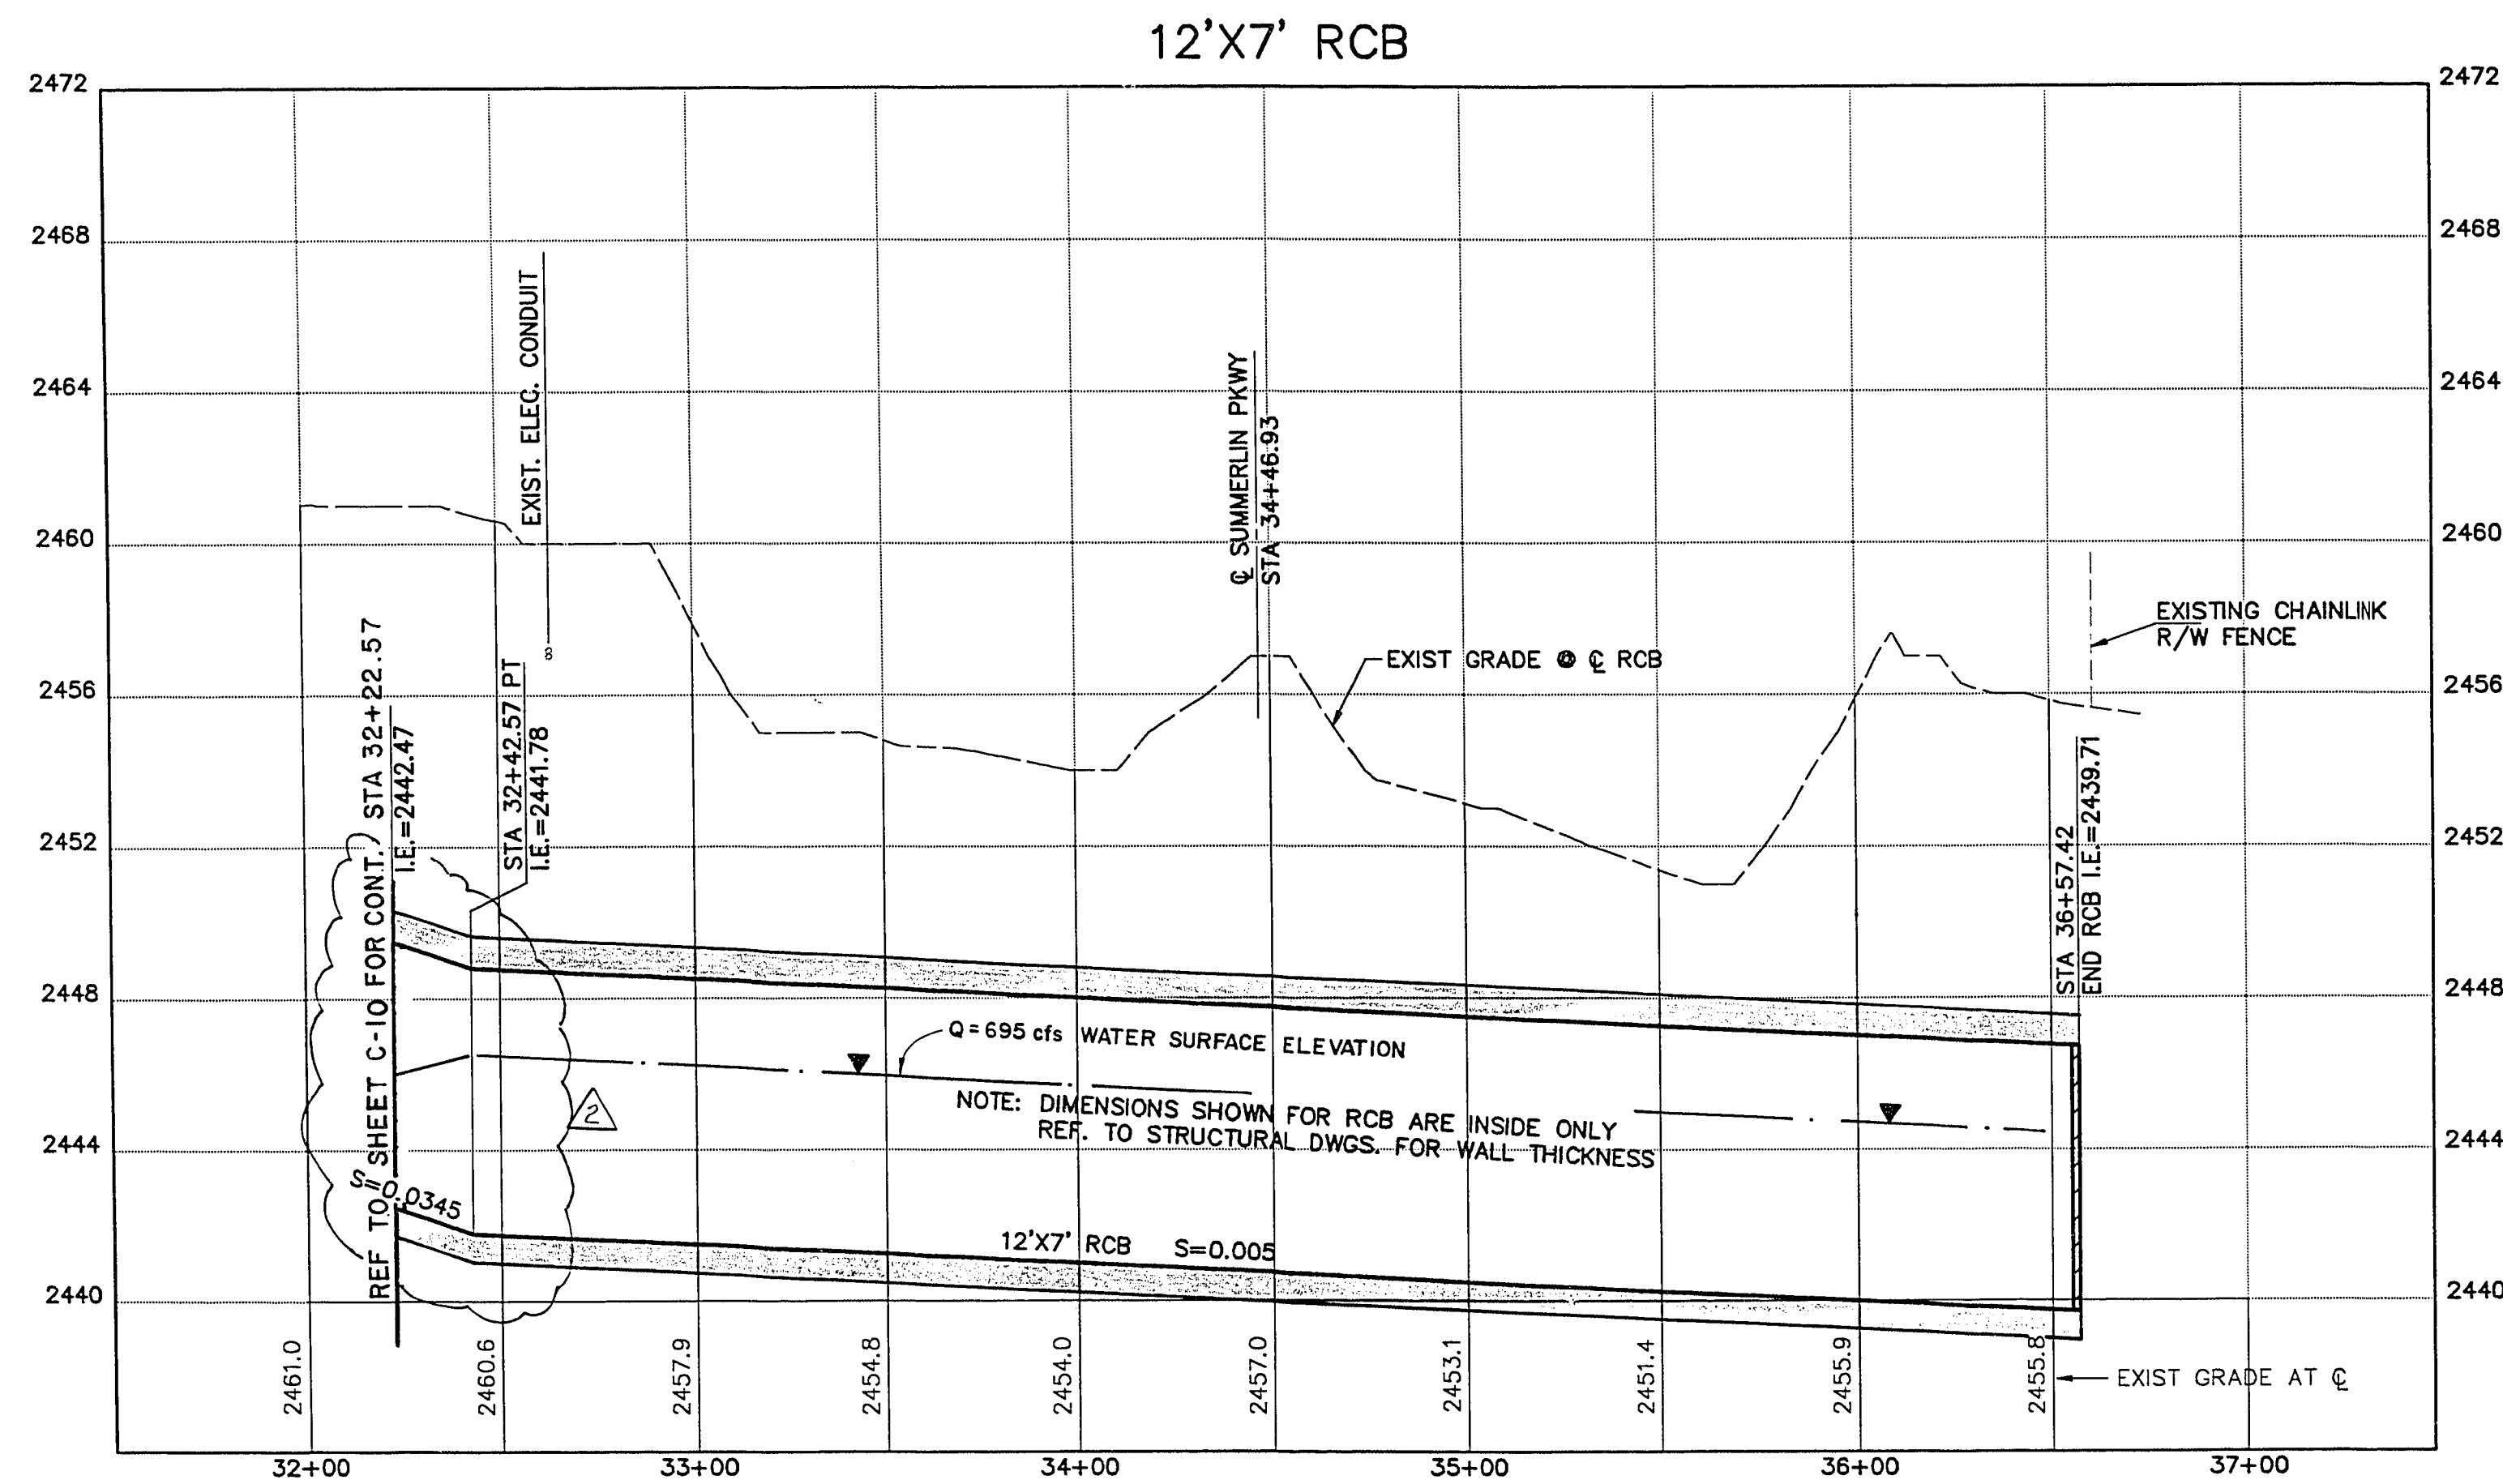
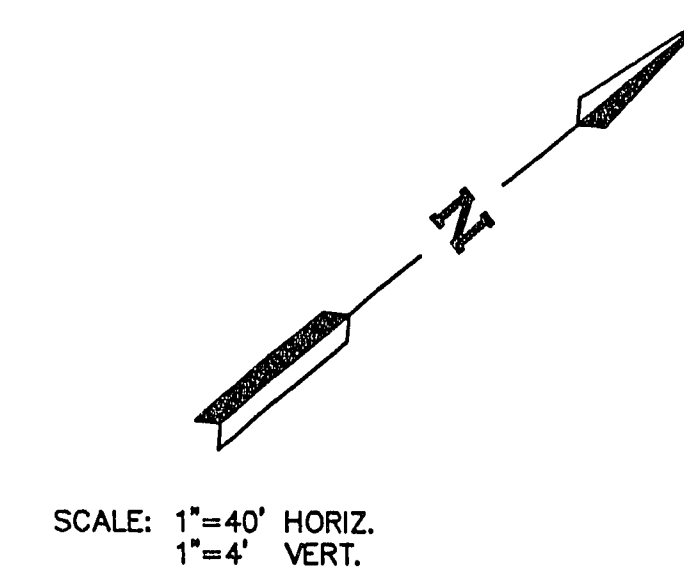


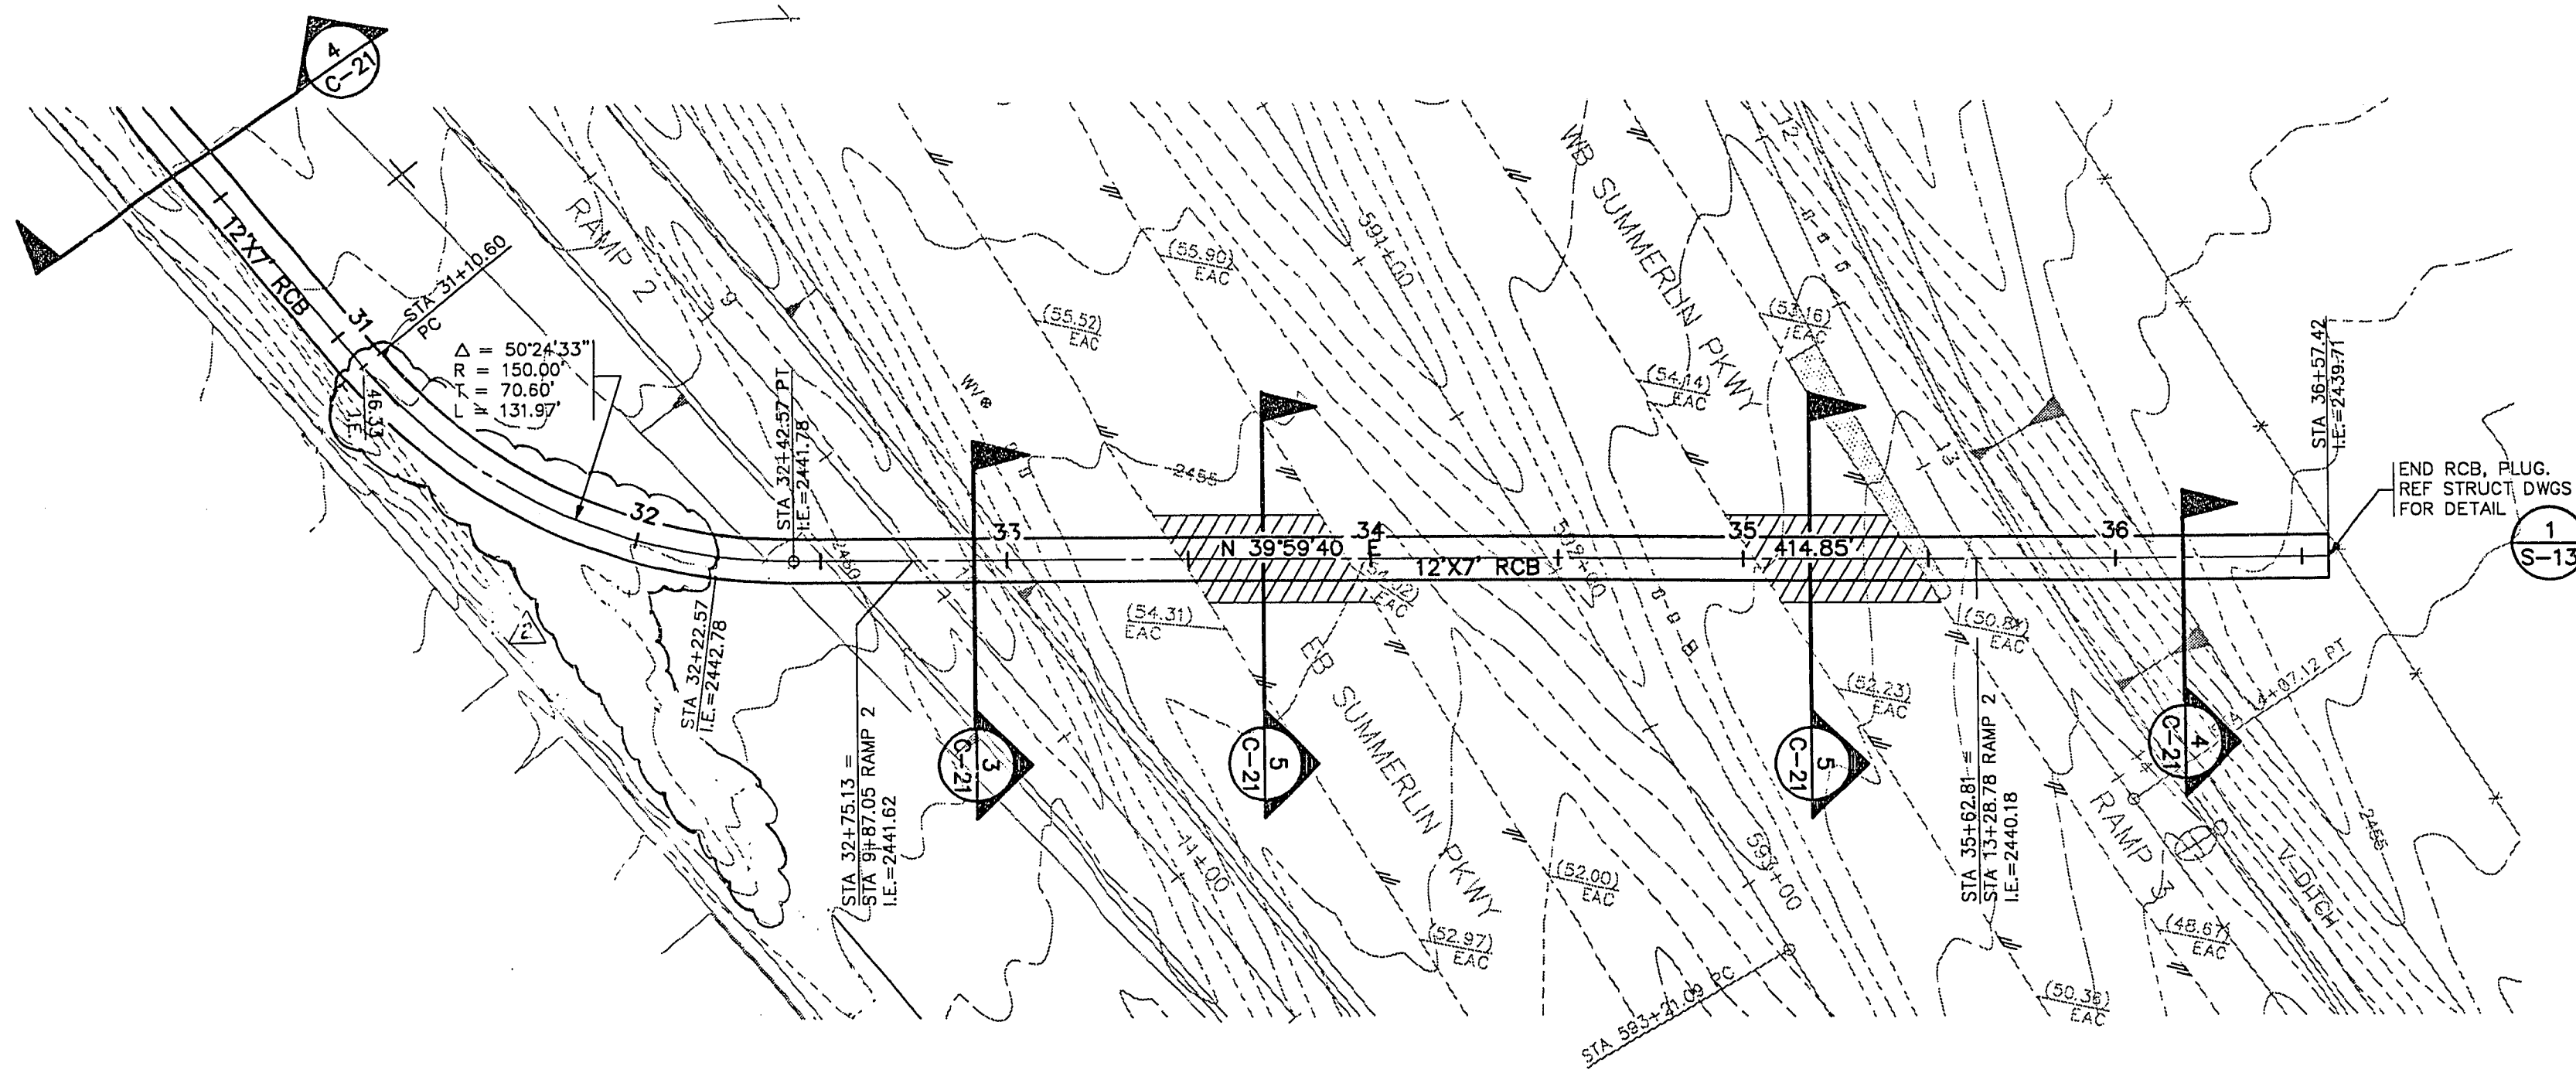

STA 32+22.57 TO STA 36+57.42


Call before you Dig.
1-800-227-2600
UNDERGROUND SERVICES

PLAN AND PROFILE / RCB

BUFFALO INTERCHANGE
WITH SUMMERLIN PARKWAY
AND BUFFALO DRIVE ROADWAY BETWEEN WESTCLIFF AND WASHINGTON

CITY of LAS VEGAS, NEVADA

C-18
OF 22

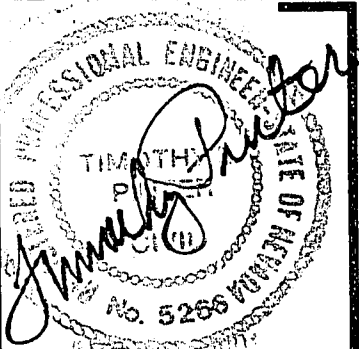

GB&L CONSULTING ENGINEERS
3850 S. EASTERN AVE. • SUITE 220 • LAS VEGAS, NEVADA 89109

CONSULTANT

ENGINEERS
PLANNERS
DESIGNERS
SURVEYORS

POGGEMEYER DESIGN GROUP
1140 ALMOND TREE LANE, SUITE 306 LAS VEGAS, NEVADA 89104 (702) 735-5108

REV	DATE	DESCRIPTION	APPROVED
1	1-9-92	RELEASED FOR BIDDING	GA/B
2	6-3-92	CHANGE ORDER NO. 1	
3			
4			
