

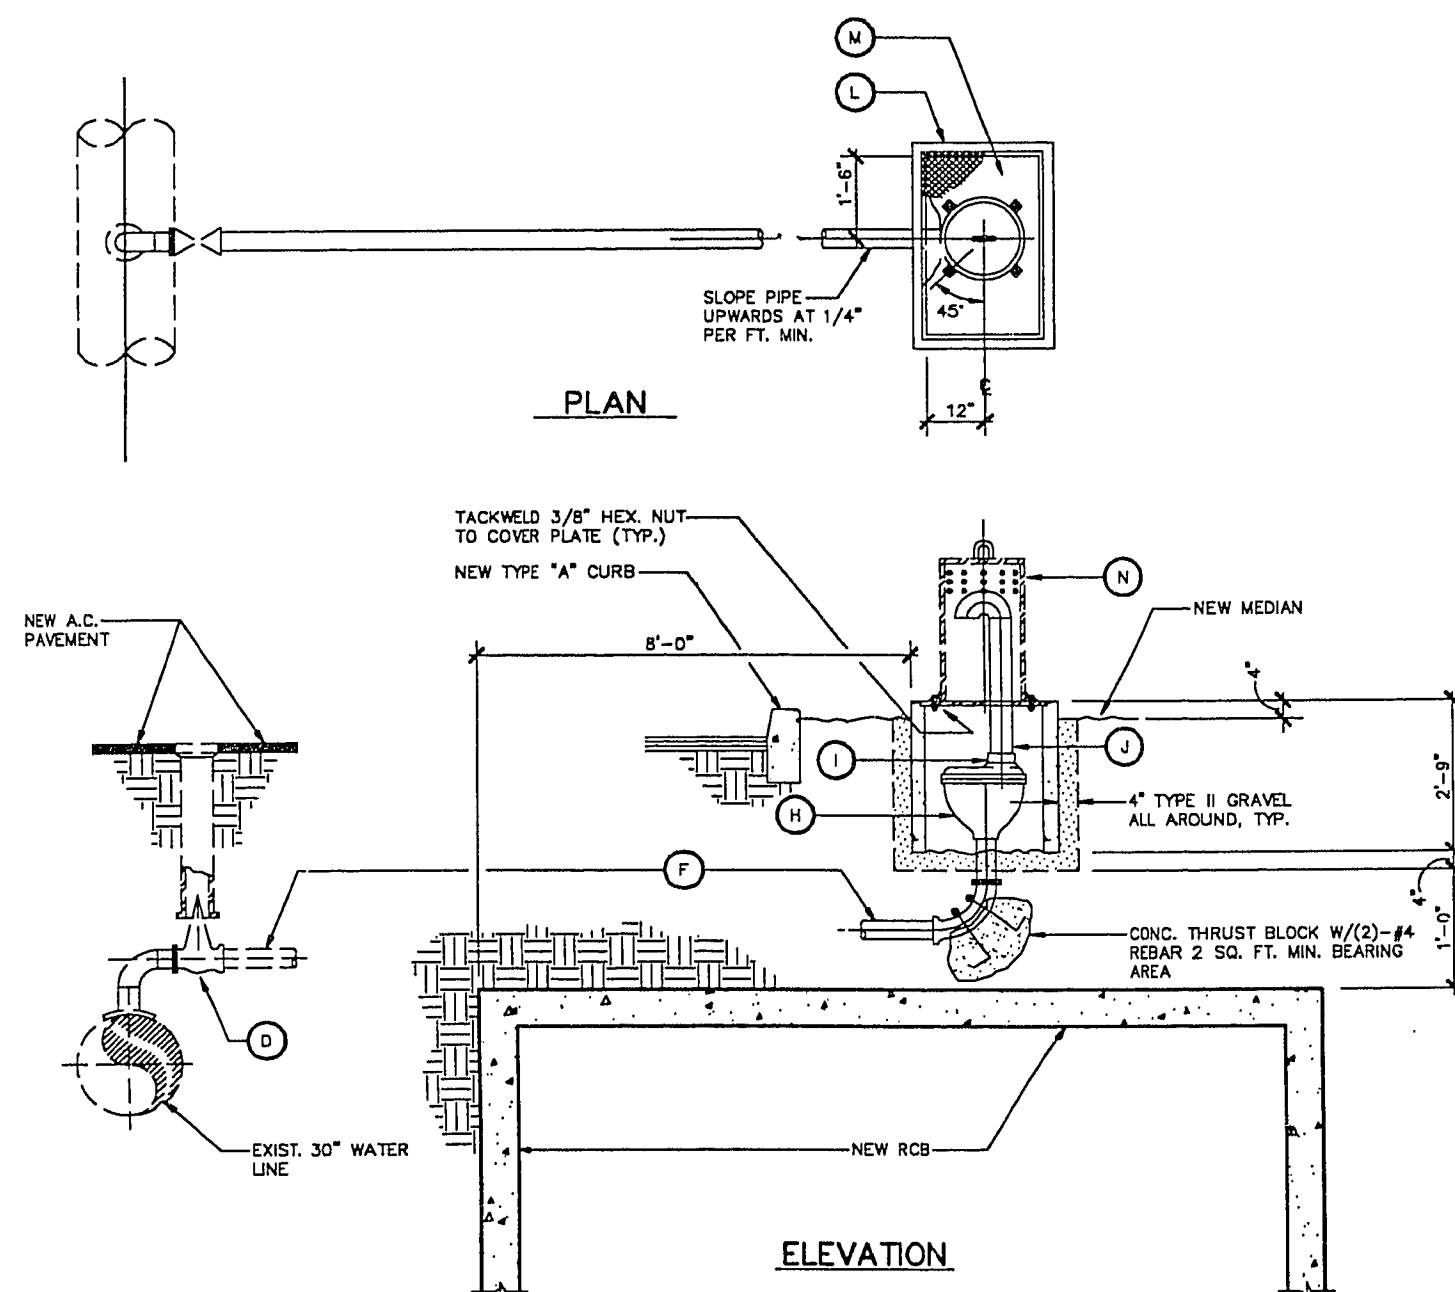


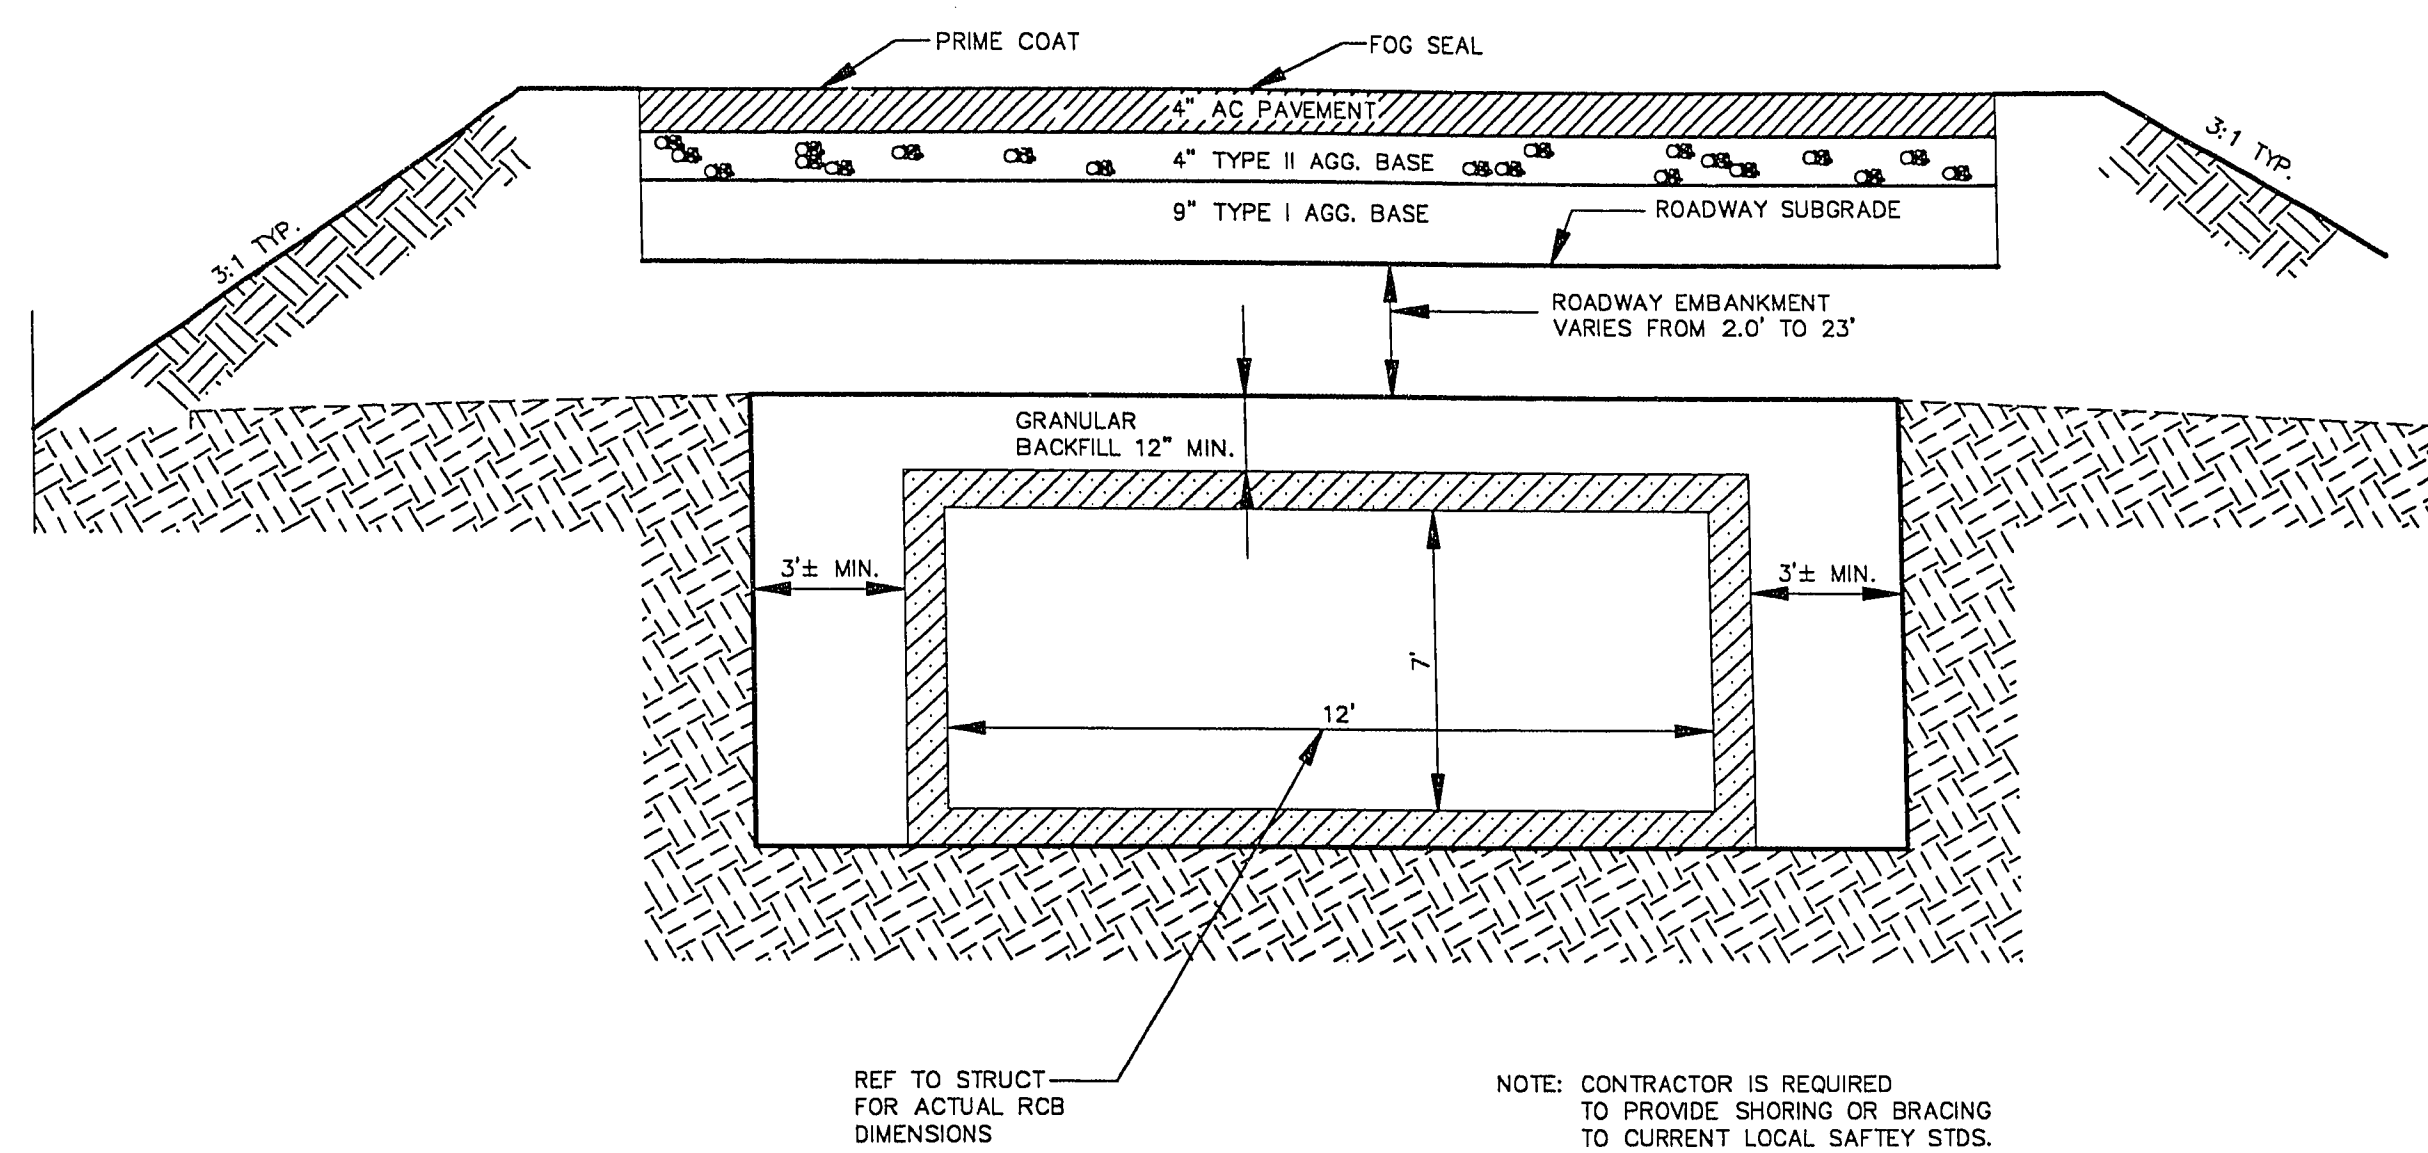




- KEYNOTE LEGEND**
- (A) 4" FLG. x RT. GATE VALVE W/2" OPERATING NUT
 - (B) 4" ACP. CL. 150
 - (C) 3" AIR VACUUM RE-USE VALVE. THREADED INLET & OUTLET
 - (D) 3" PVC-MPT x SLIP MALE ADAPTER
 - (E) 3" SCH. 40 PVC PIPE
 - (F) 2' x 3' PRECAST CONC. UTILITY VAULT, BROOKS NO. 100-18 OR APPROVED EQUAL. MARK COVER L.V.V.W.D.
 - (G) 5/8" THICK GALV. TRAFFIC COVER, BROOKS NO. 100-18 OR APPROVED EQUAL. MARK COVER L.V.V.W.D.
 - (H) REUSE EXISTING STEEL PIPE COVER

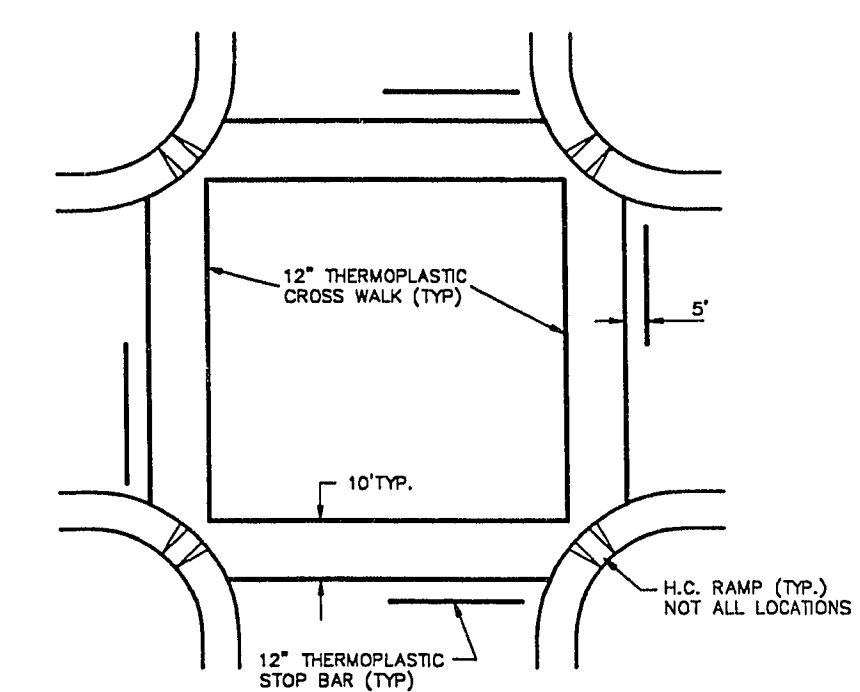

DETAIL AIR-VACUUM RELEASE VALVE

CROSSWALK STRIPING PLAN (INT. TYP)




RCB TRENCH SECTION - PAVED AREA

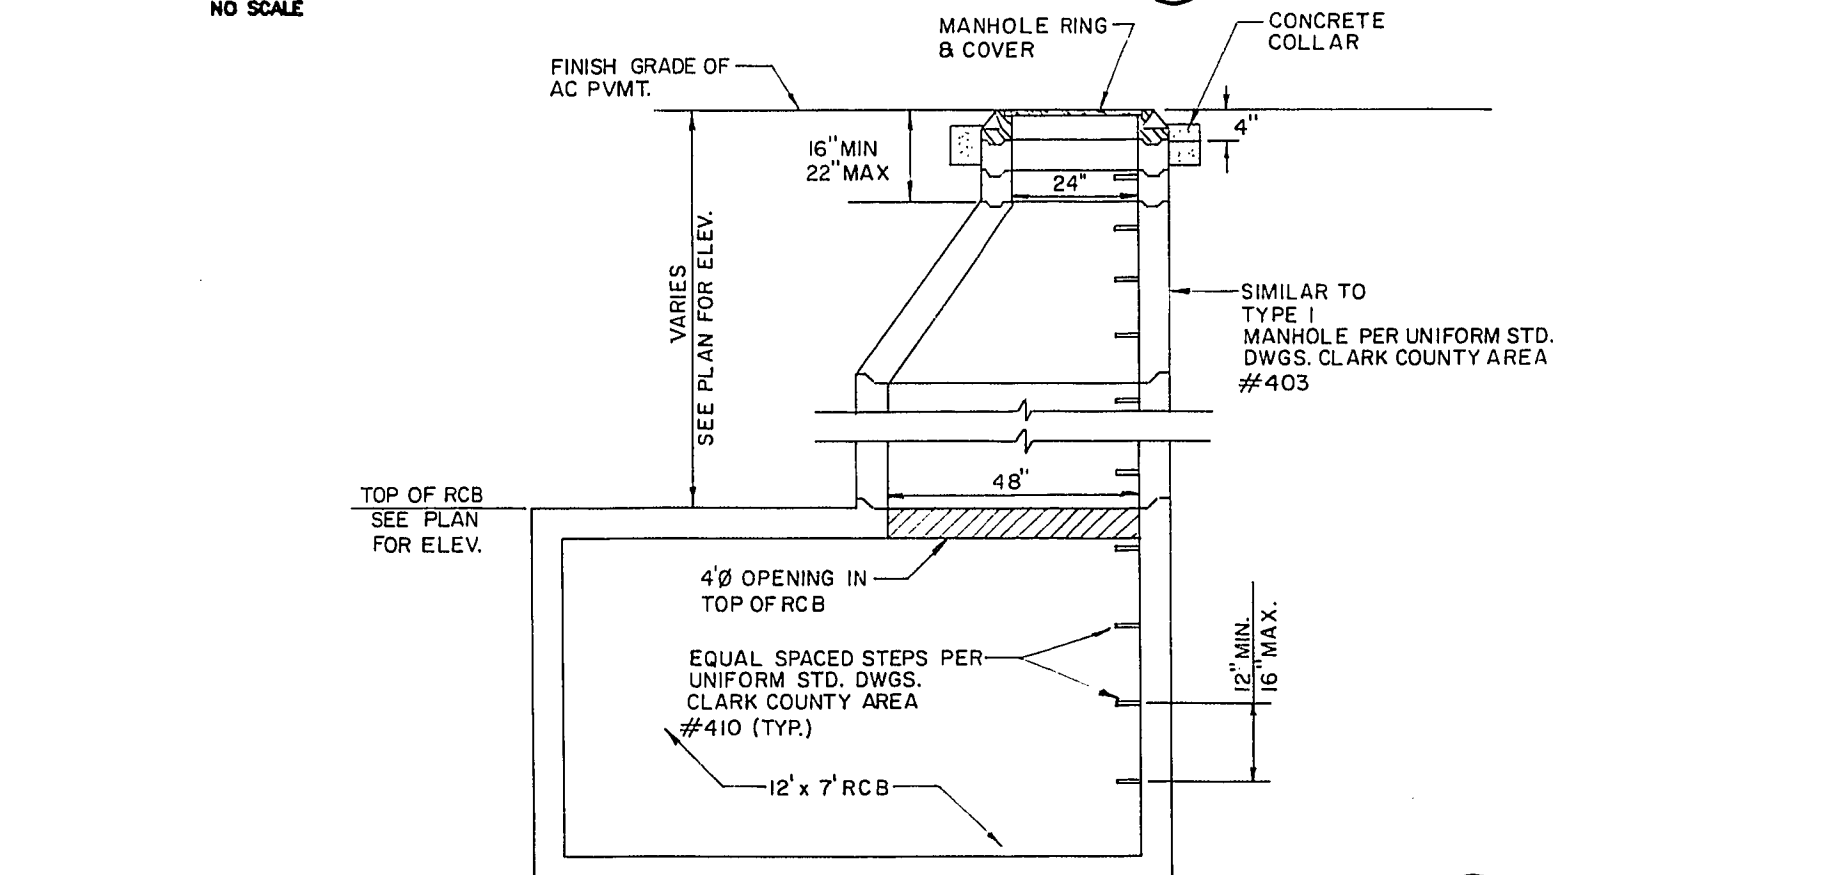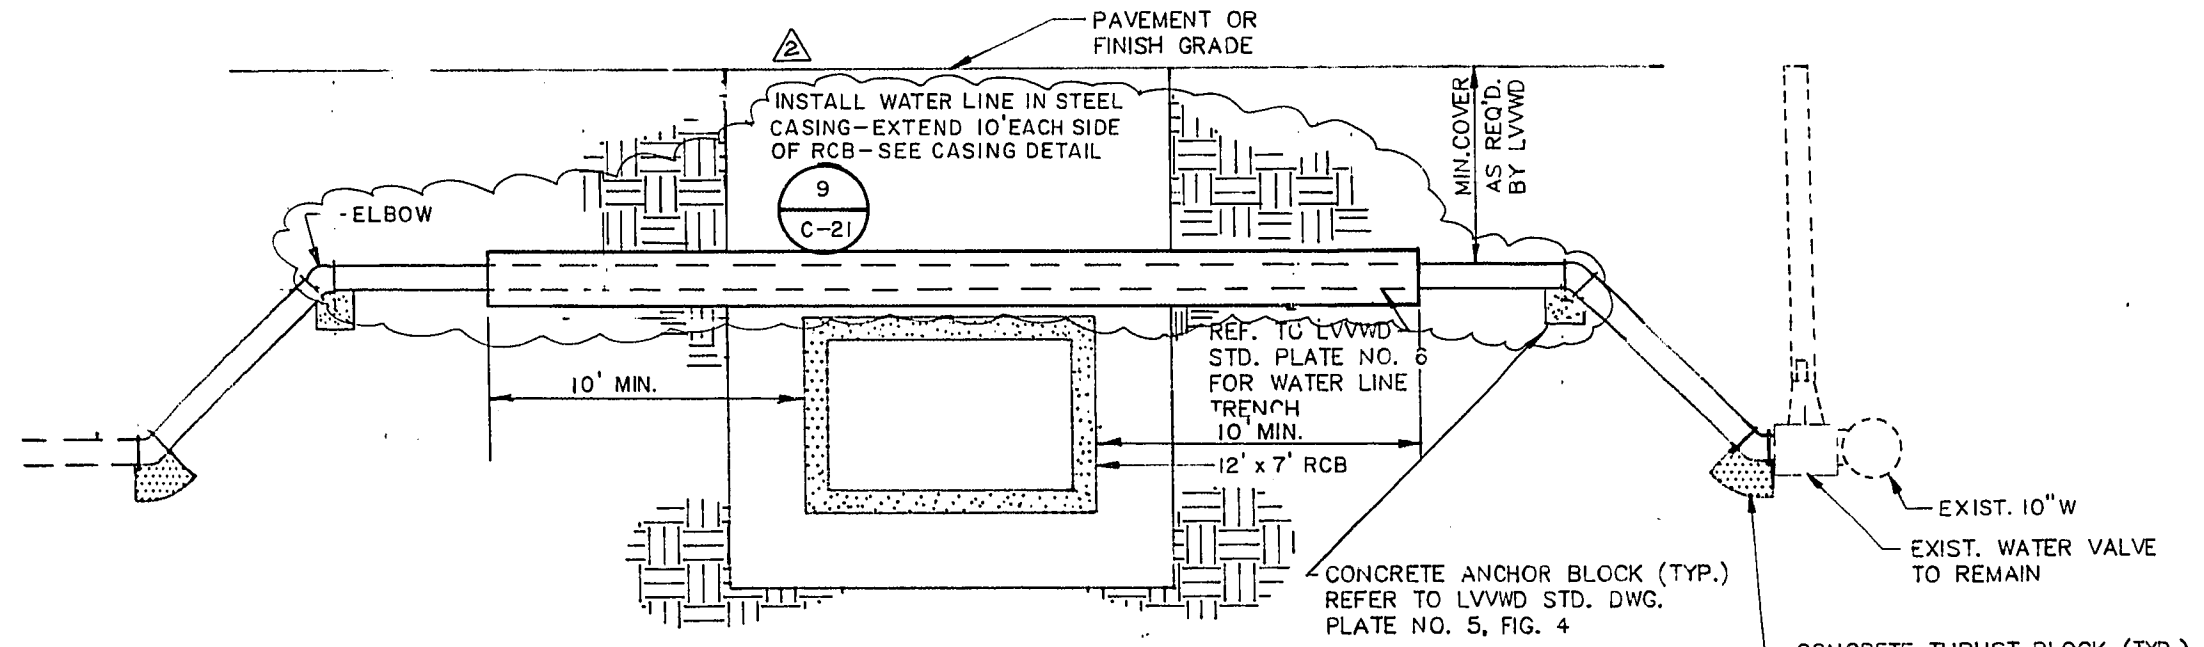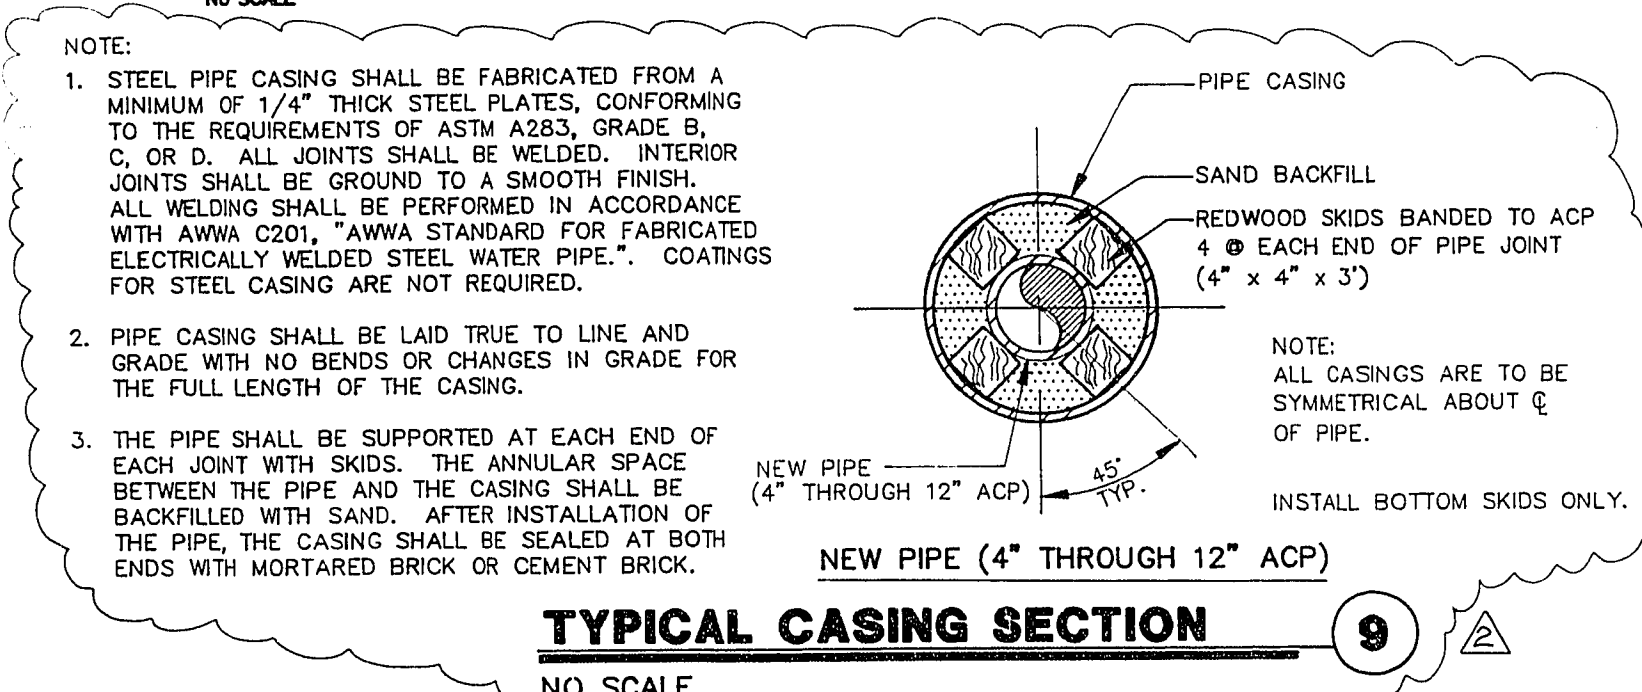

RCB TRENCH SECTION-UNPAVED AREA

TYPICAL RELOCATION DETAIL WATER CROSSING OVER RCB

RCB TYPICAL SECTION-SUMMERLIN PKWY

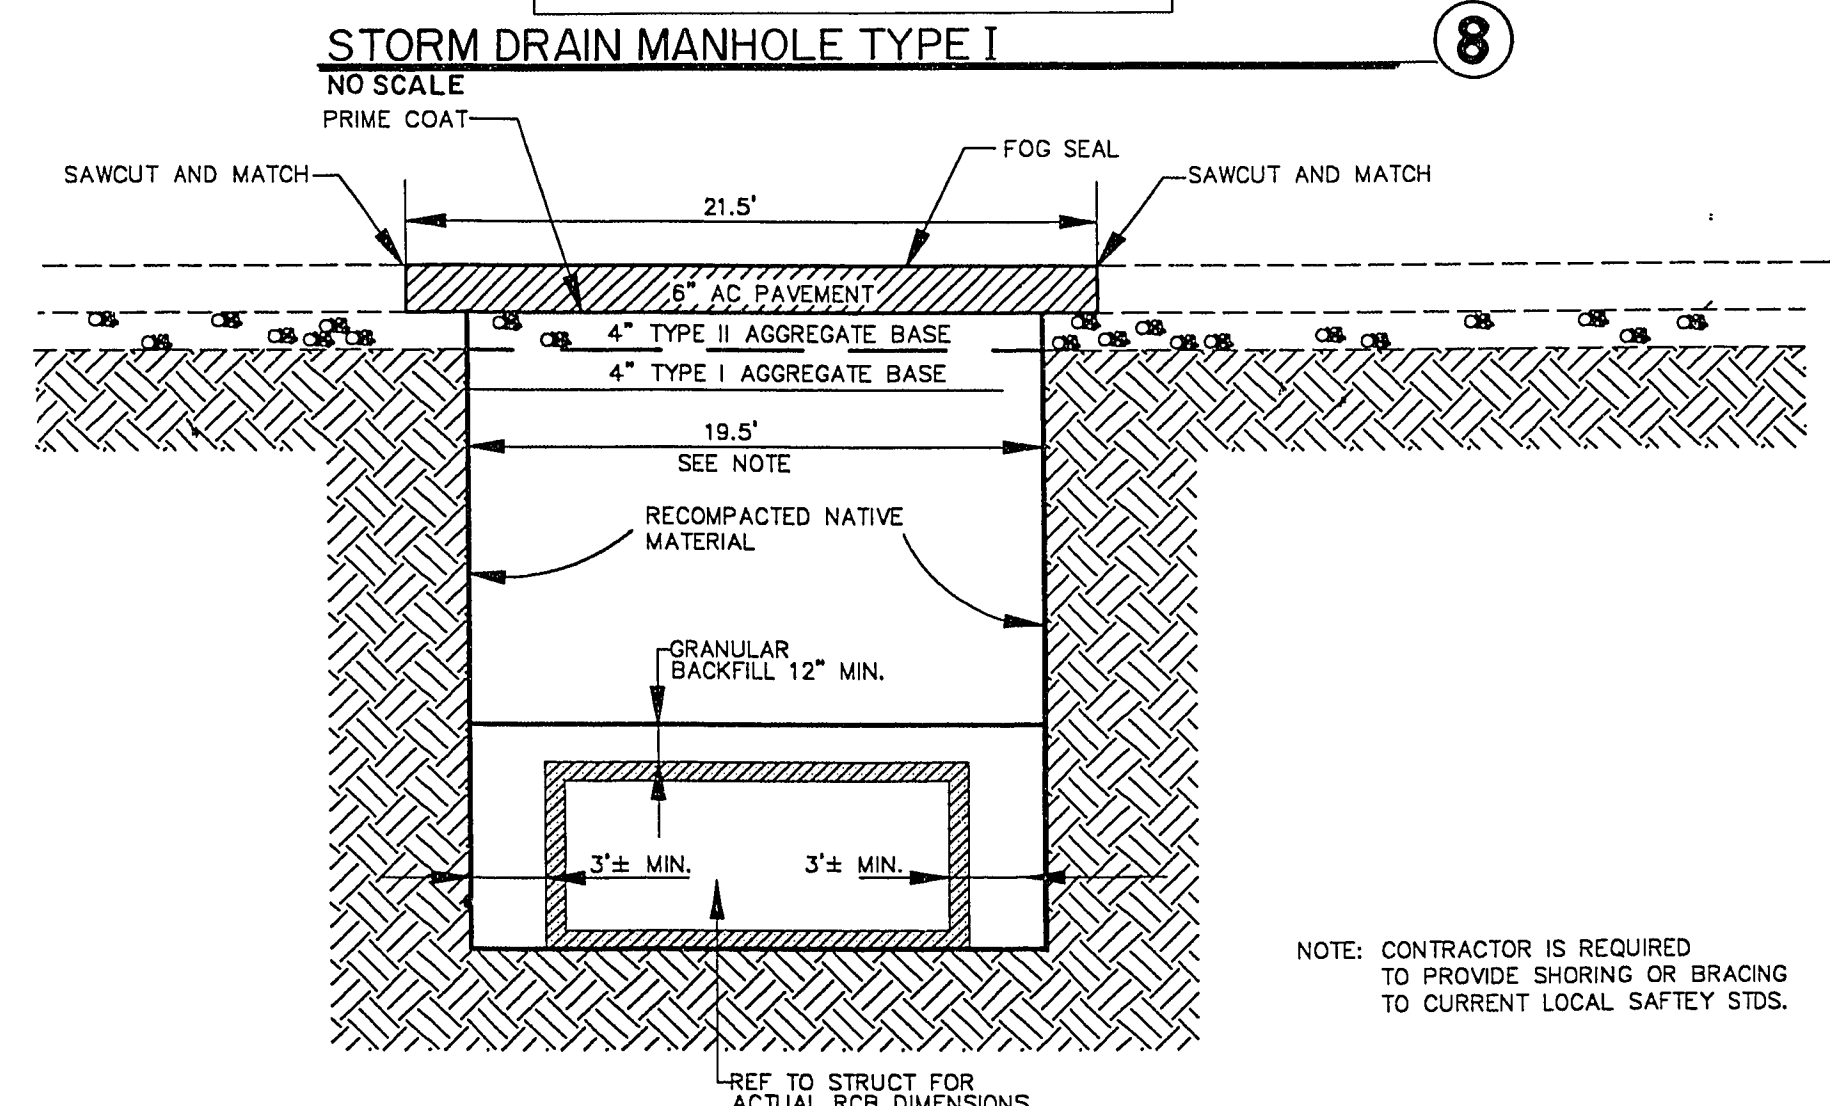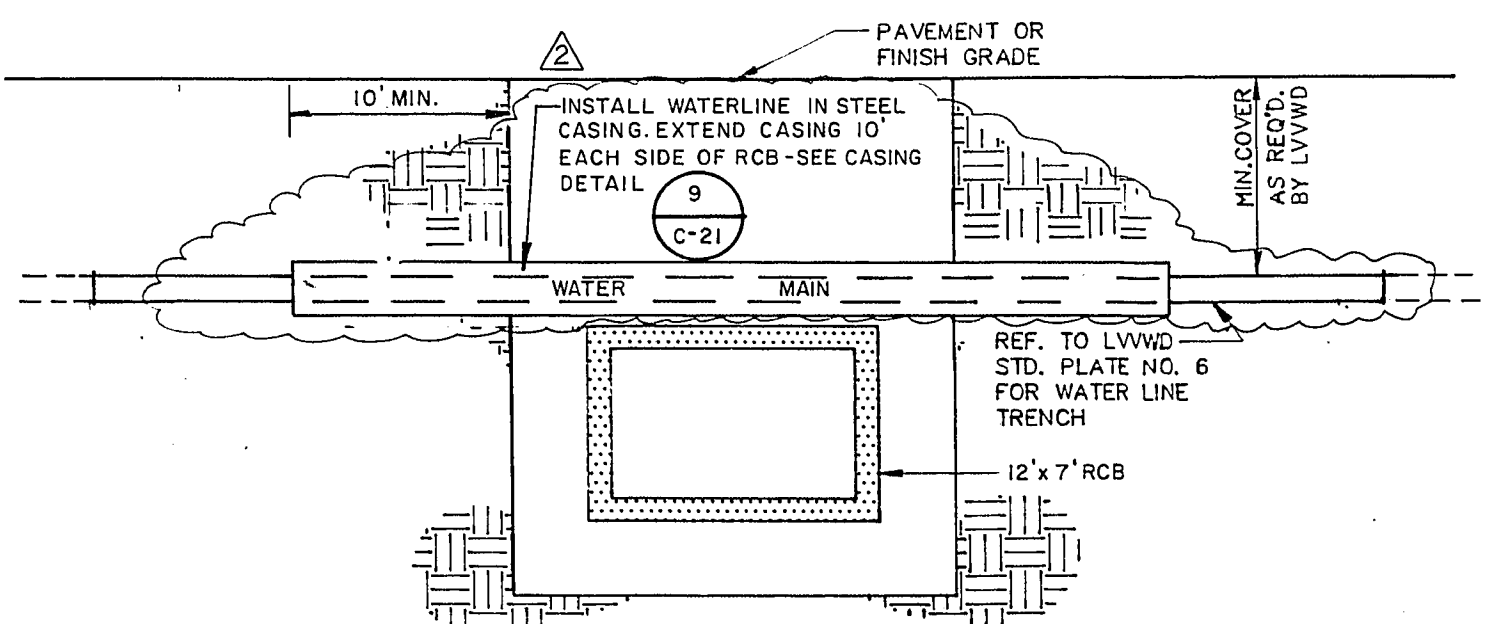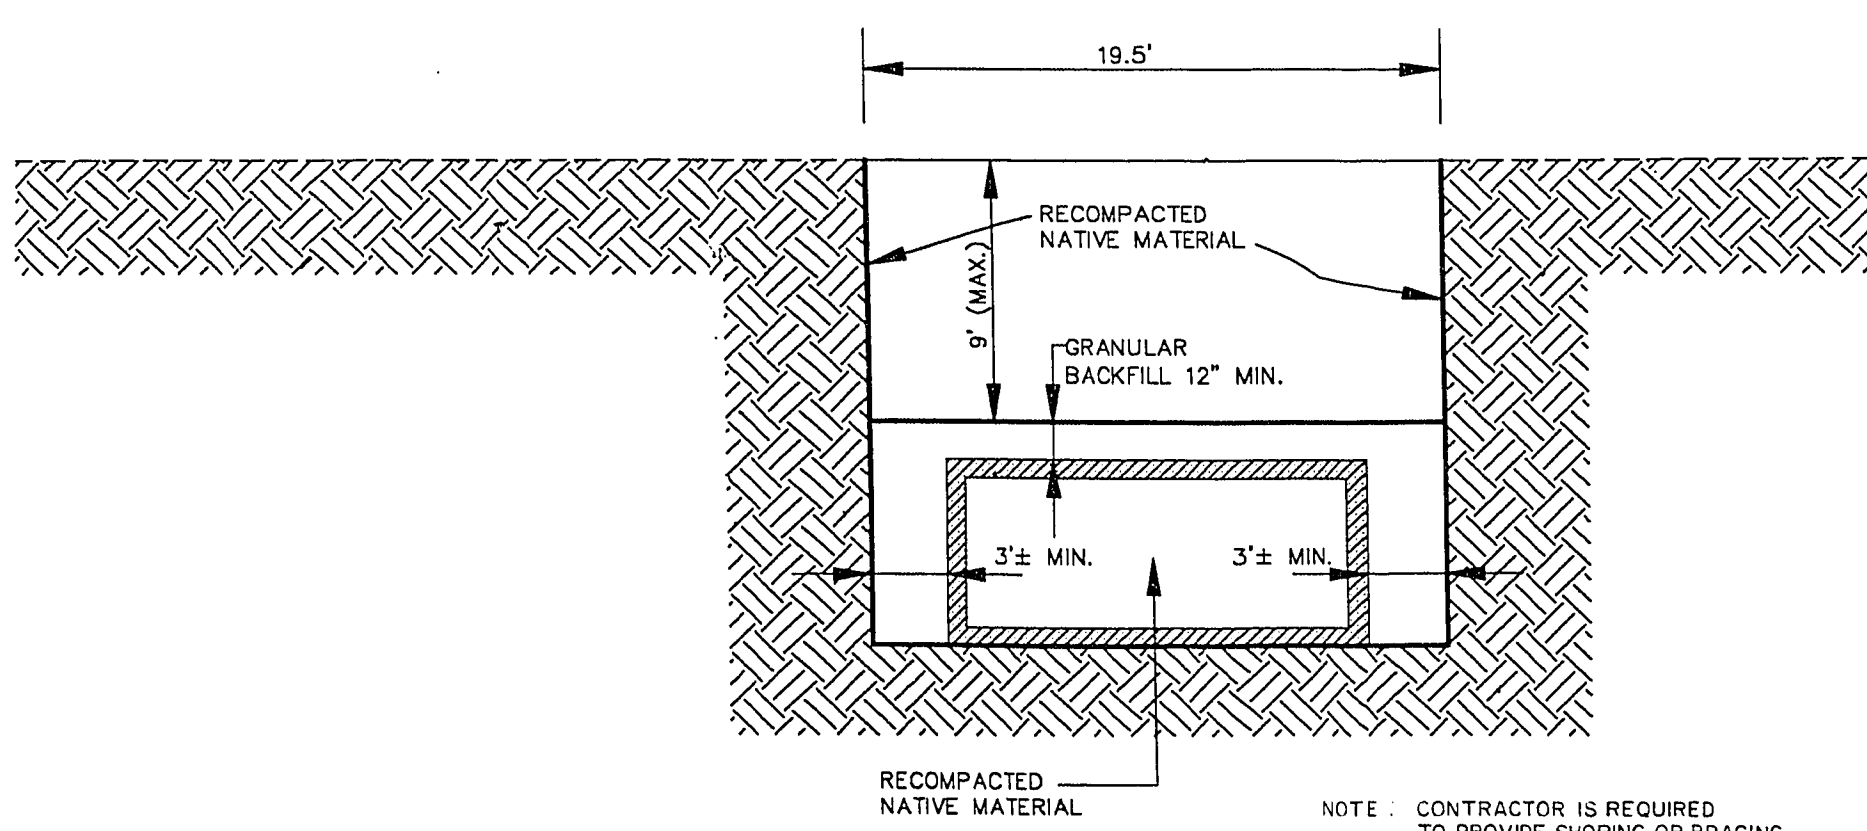

GB&L CONSULTING ENGINEERS
 3650 S. EASTERN AVE. • SUITE 220 • LAS VEGAS, NEVADA 89109
 (702) 735-5108

DETAILS
BUFFALO INTERCHANGE
 with SUMMERLIN PARKWAY
 and BUFFALO DRIVE ROADWAY BETWEEN WESTCLIFF AND WASHINGTON
 CITY of LAS VEGAS, NEVADA

0-21

1-800-227-2600

Call before you Dig.