
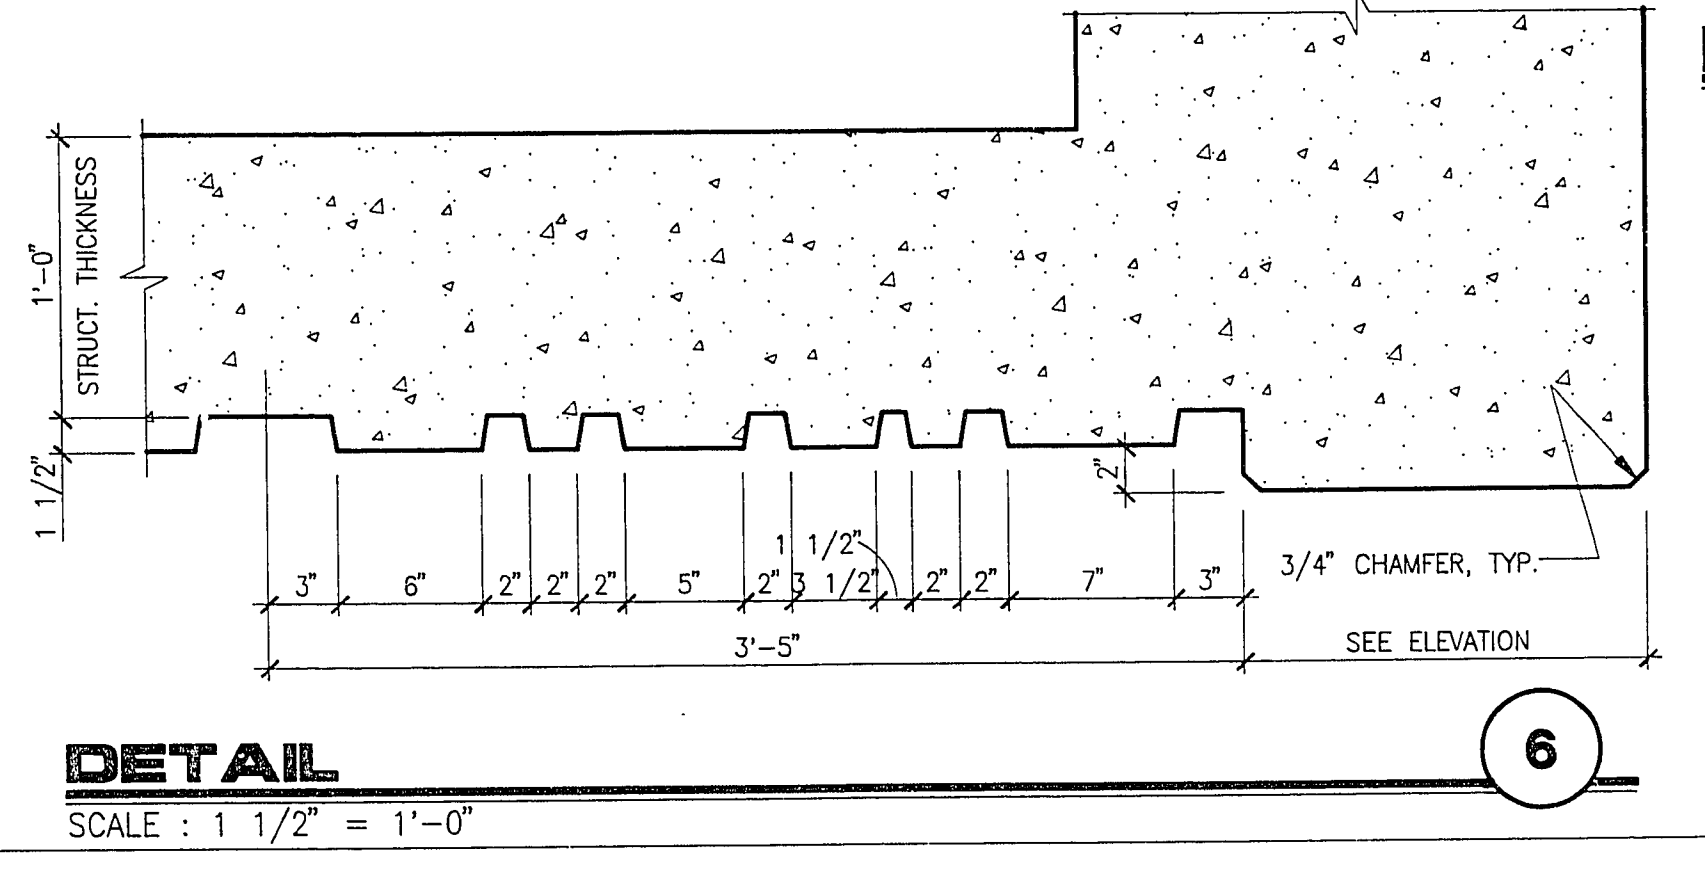
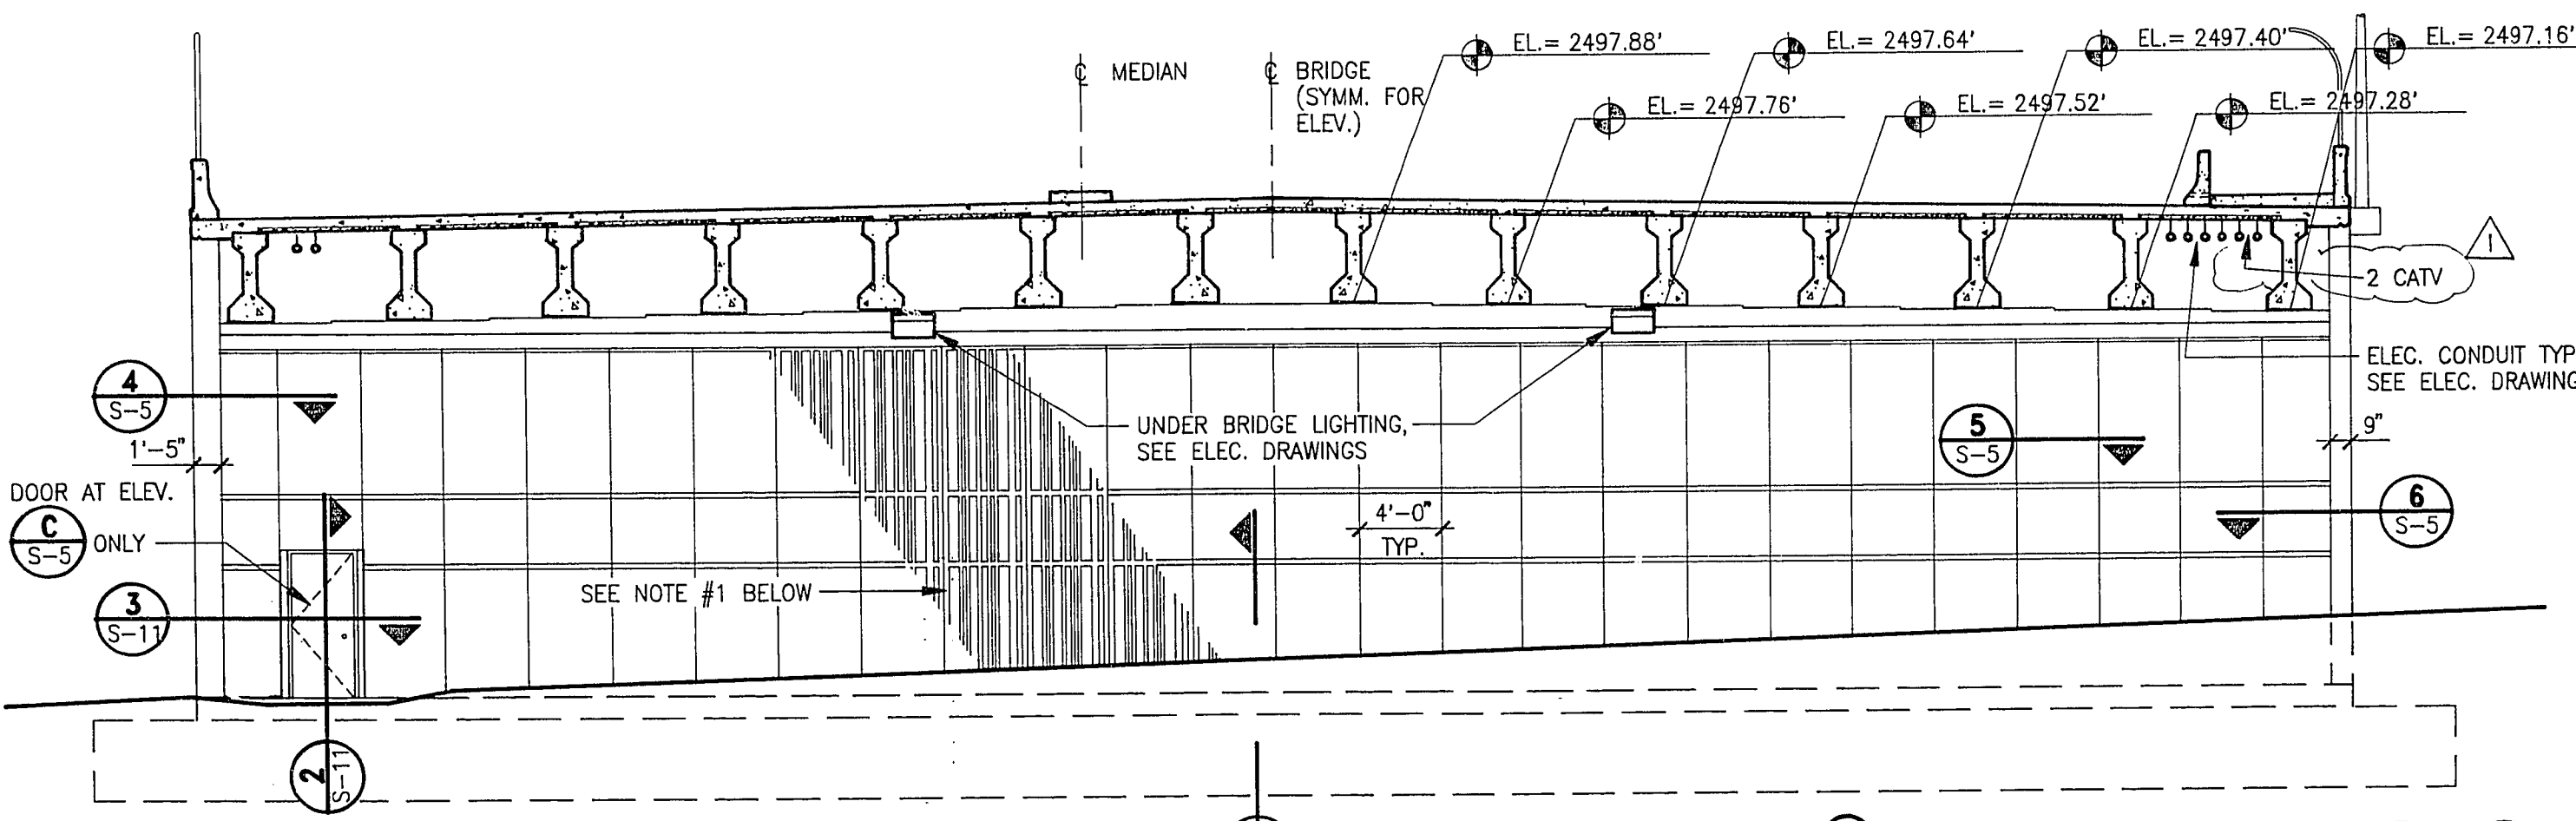
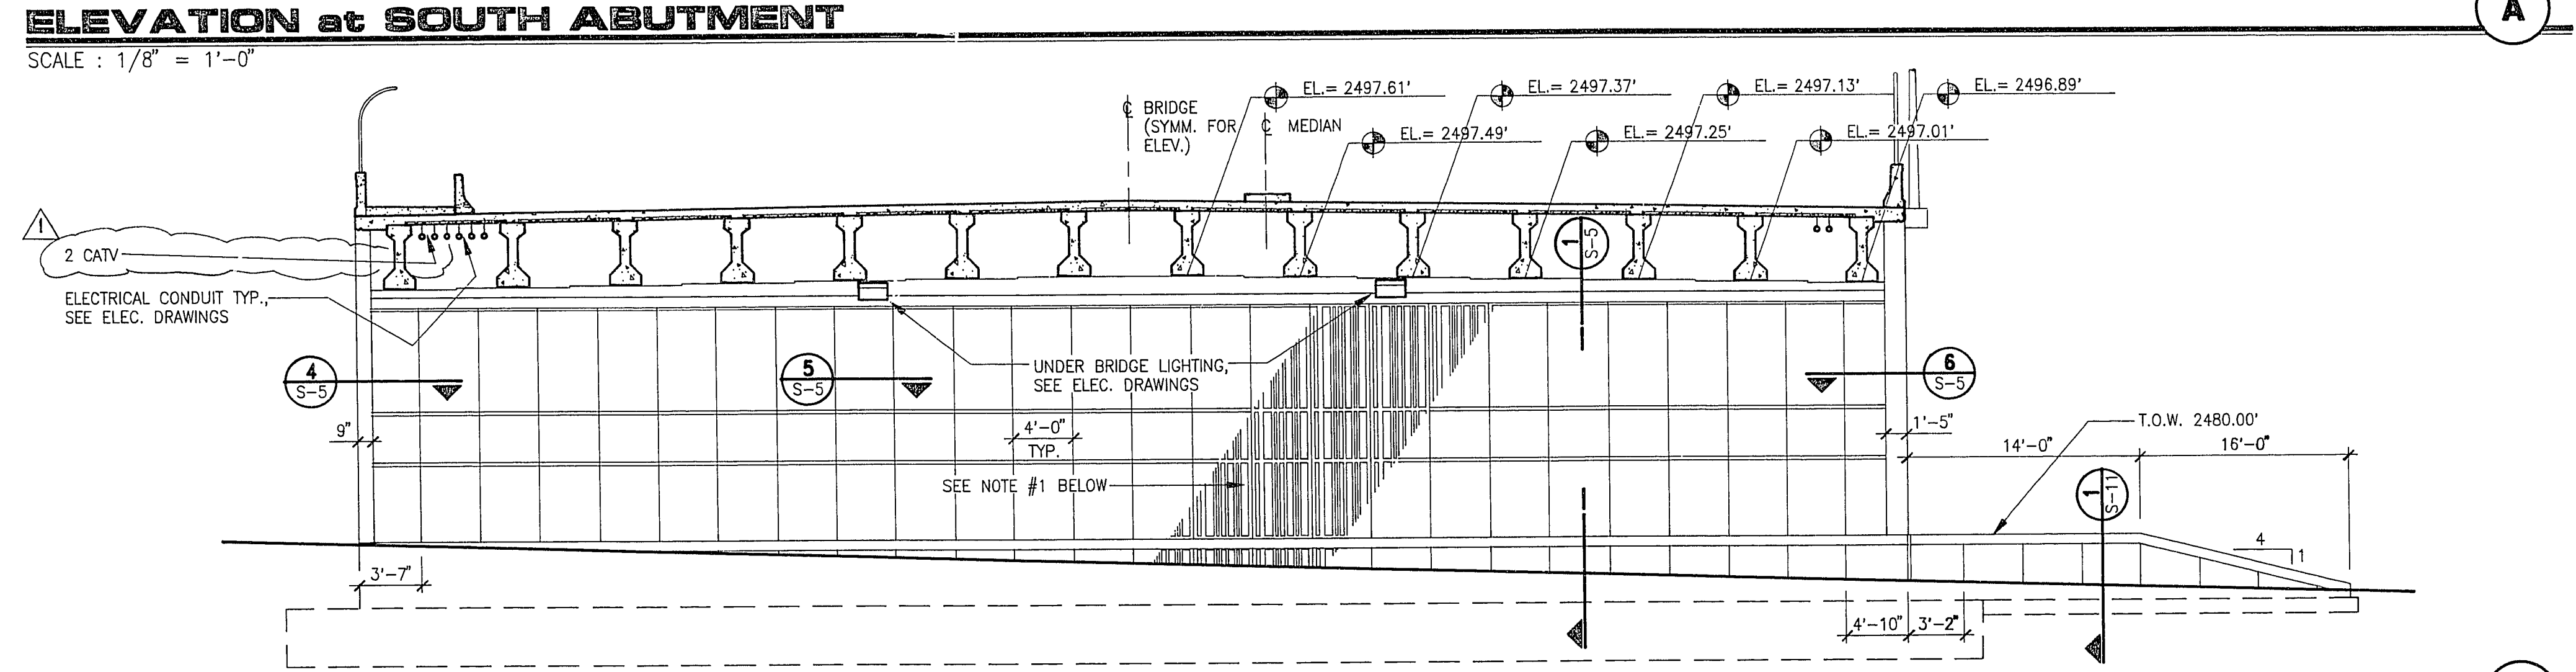
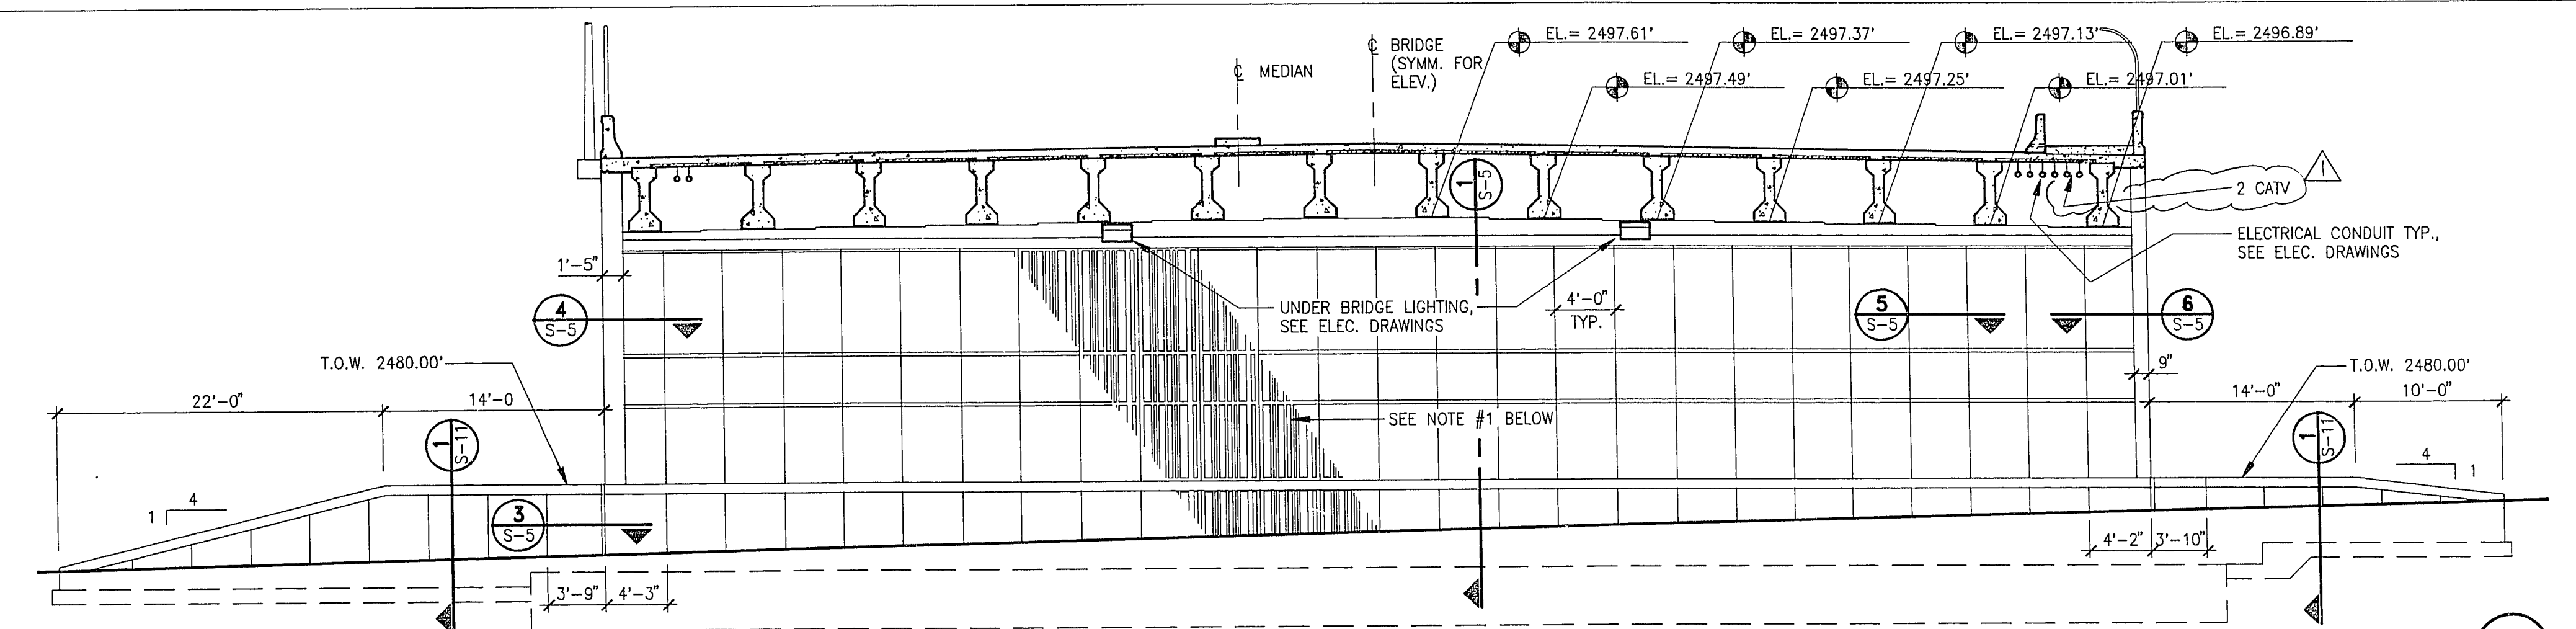
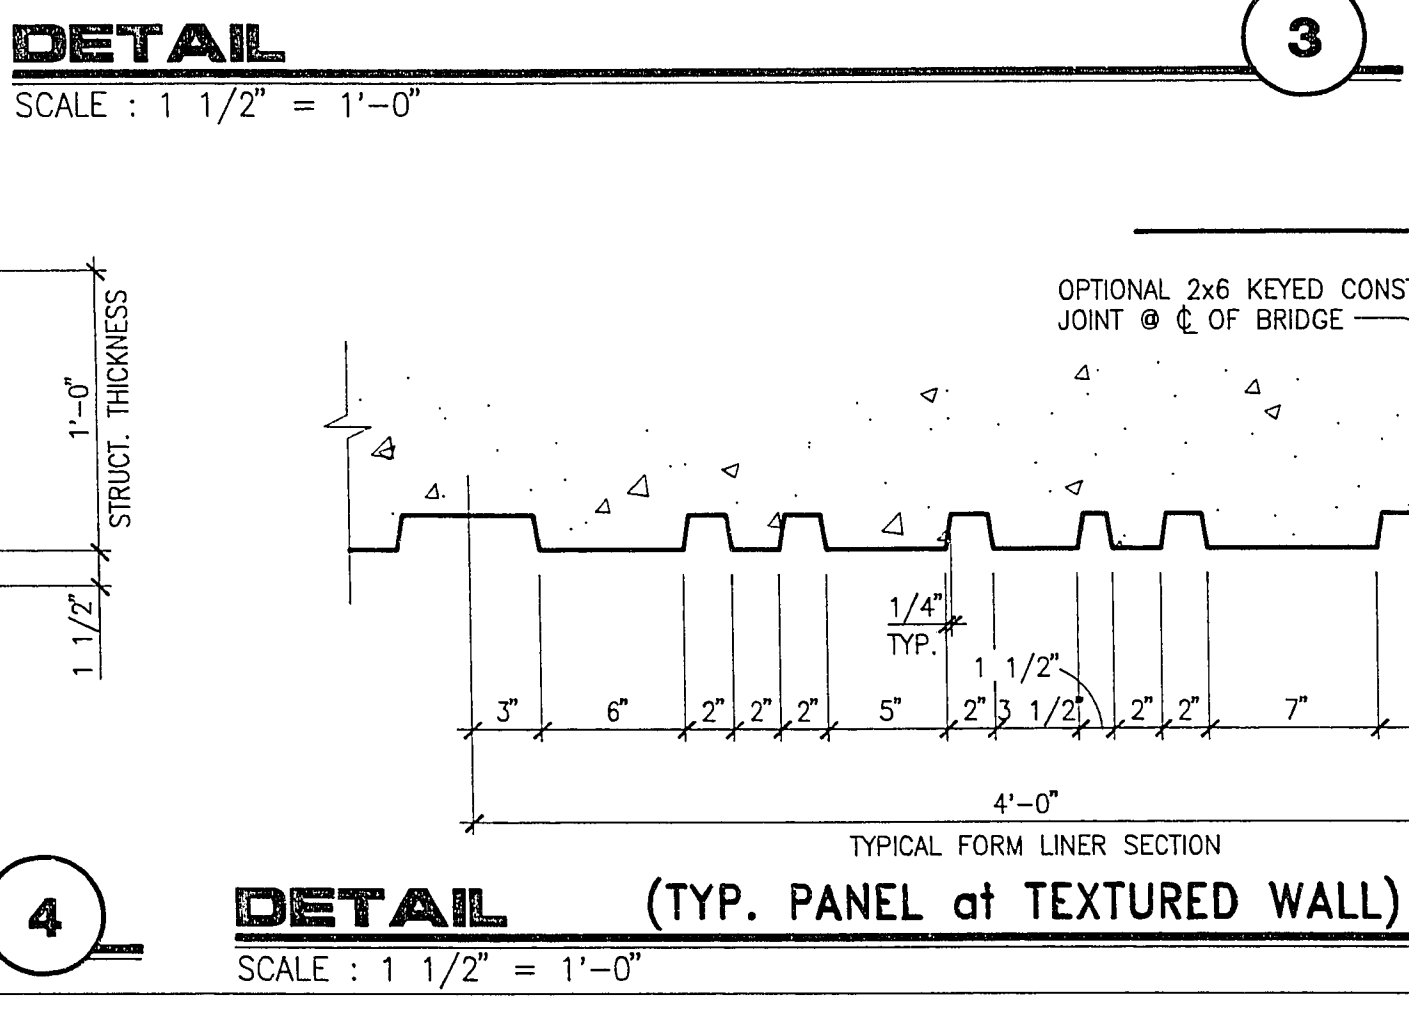
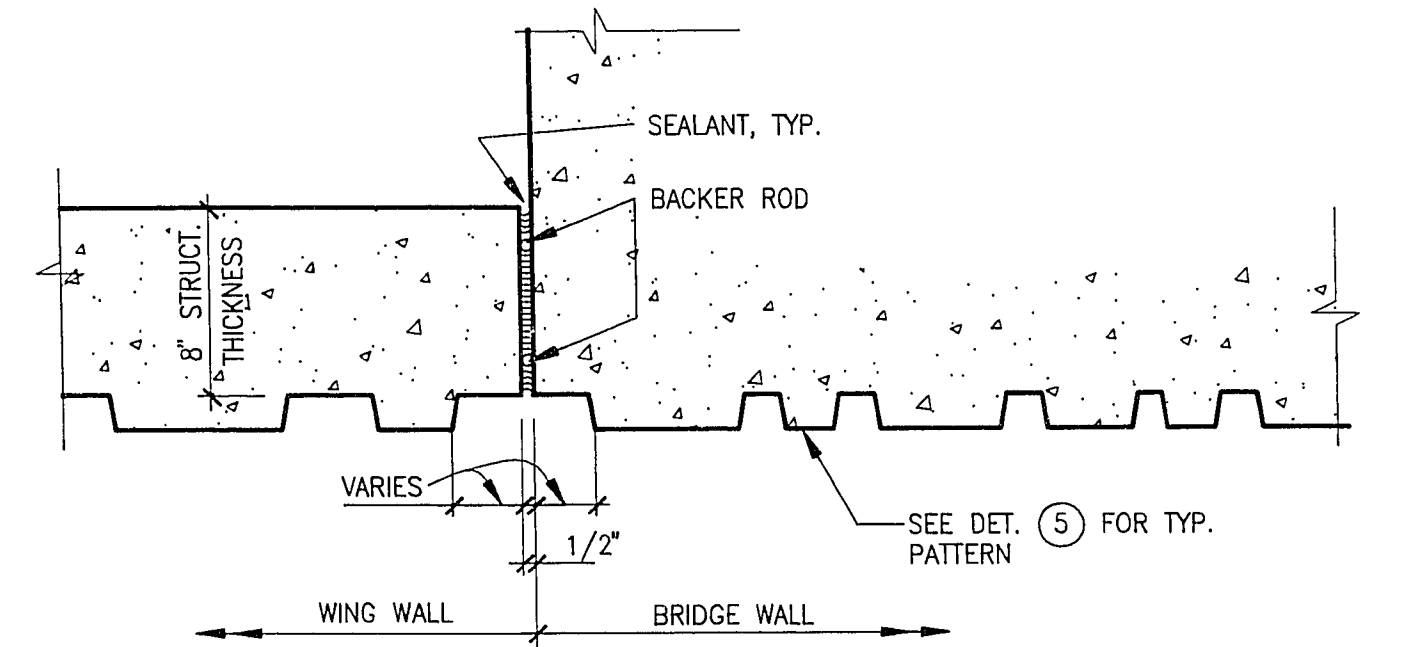
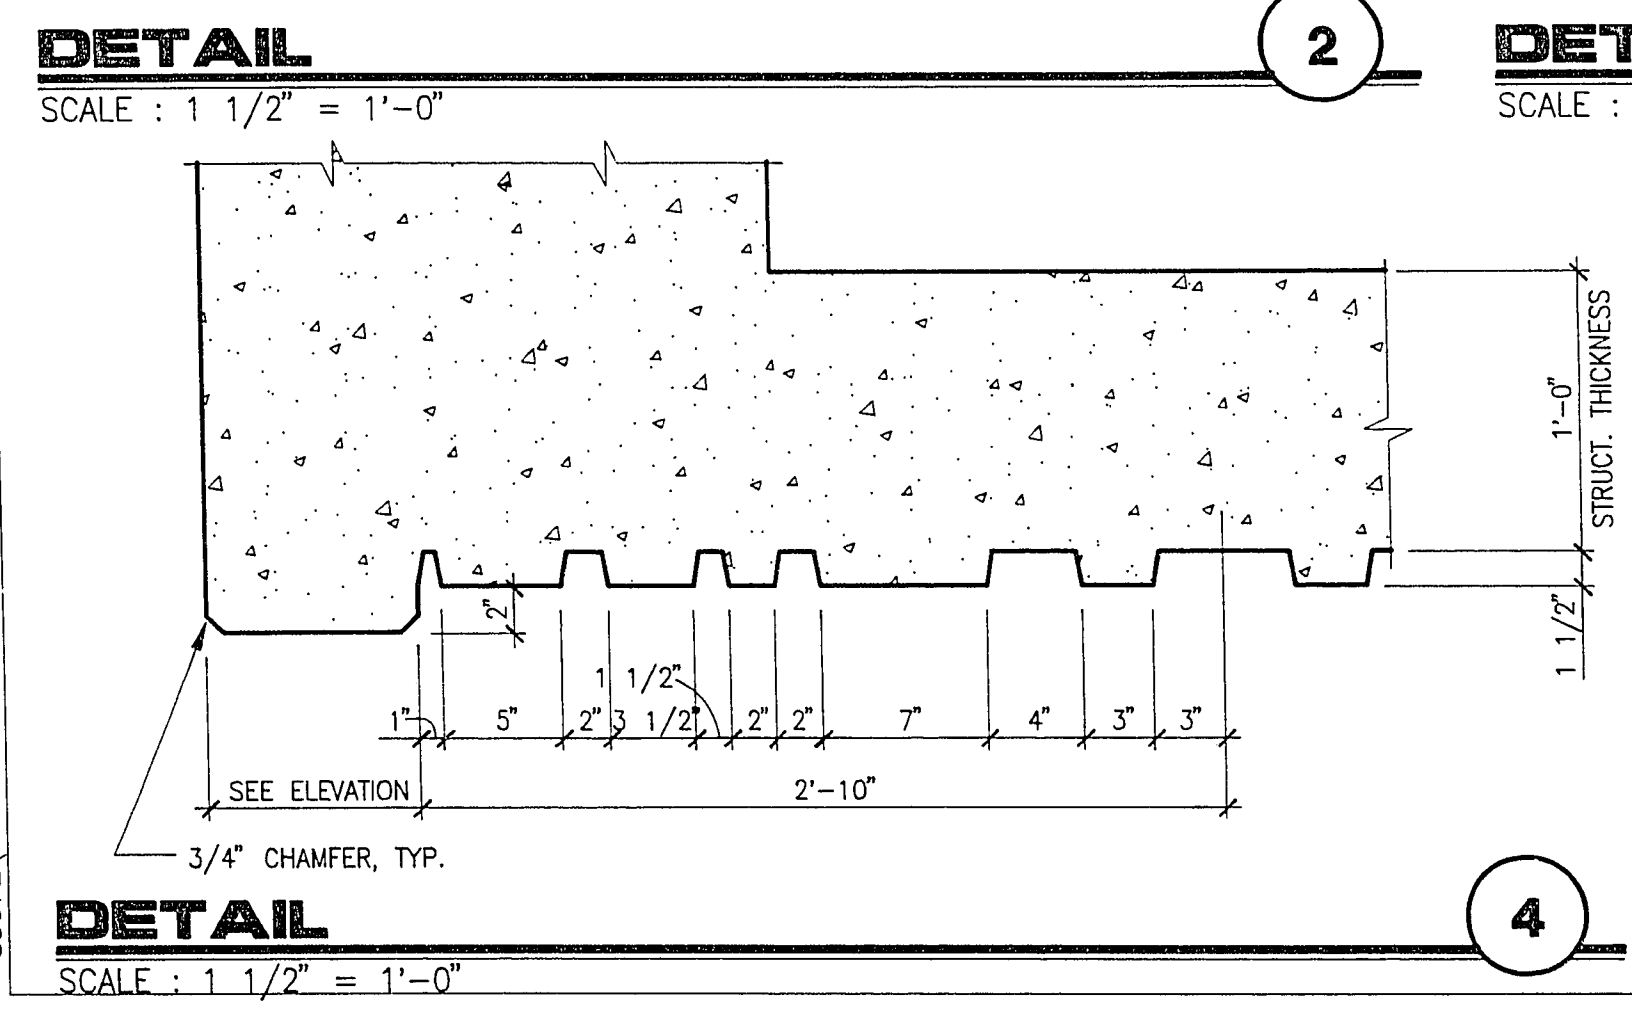
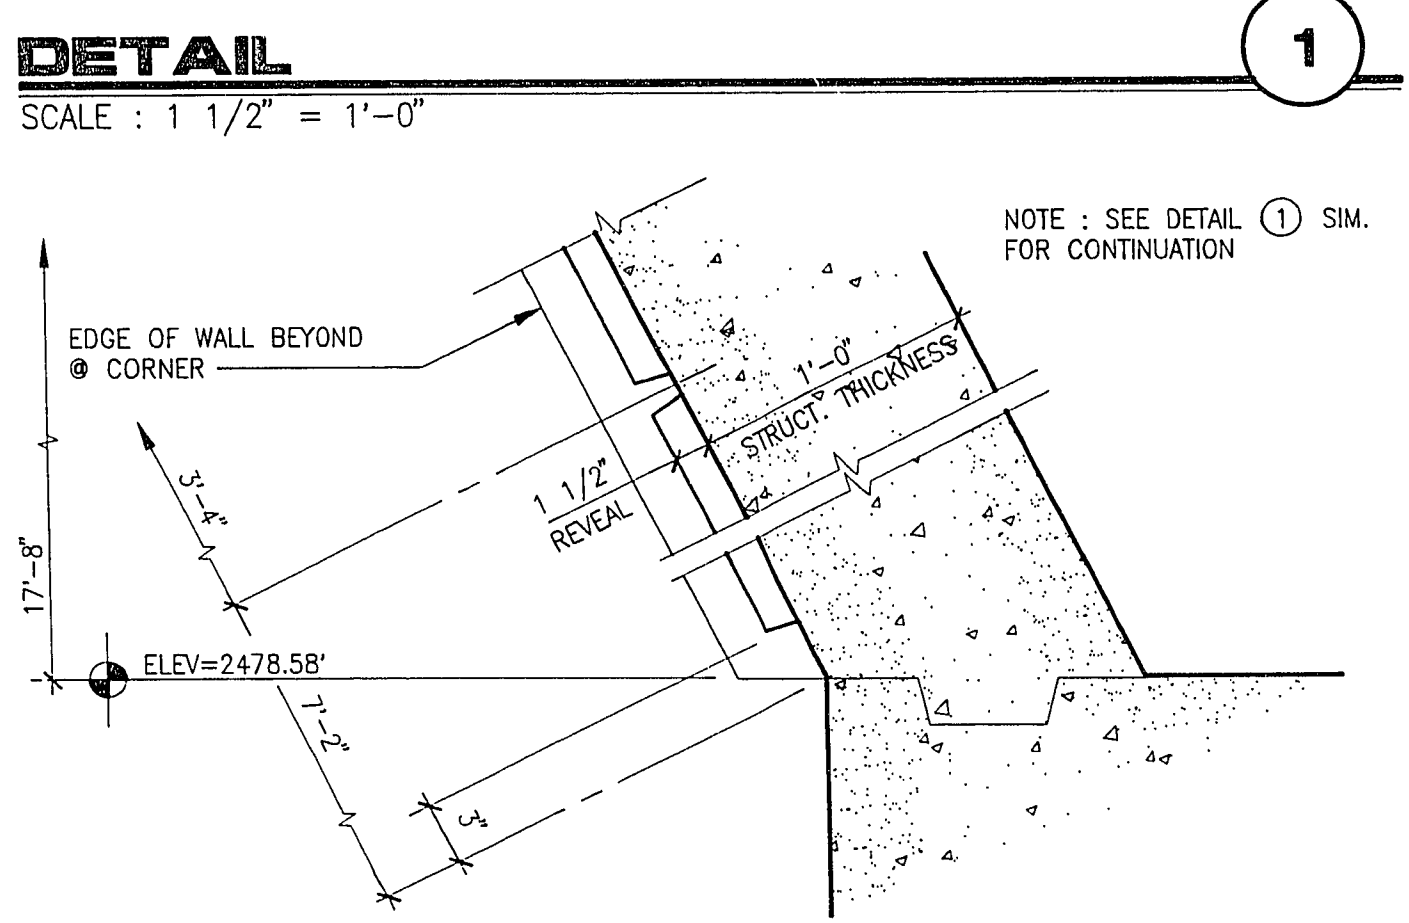


89072 S05 PLOTTED BY: KHO DATE: 03/23/92 TIME: 09:11 SCALE FACTOR: 1=1

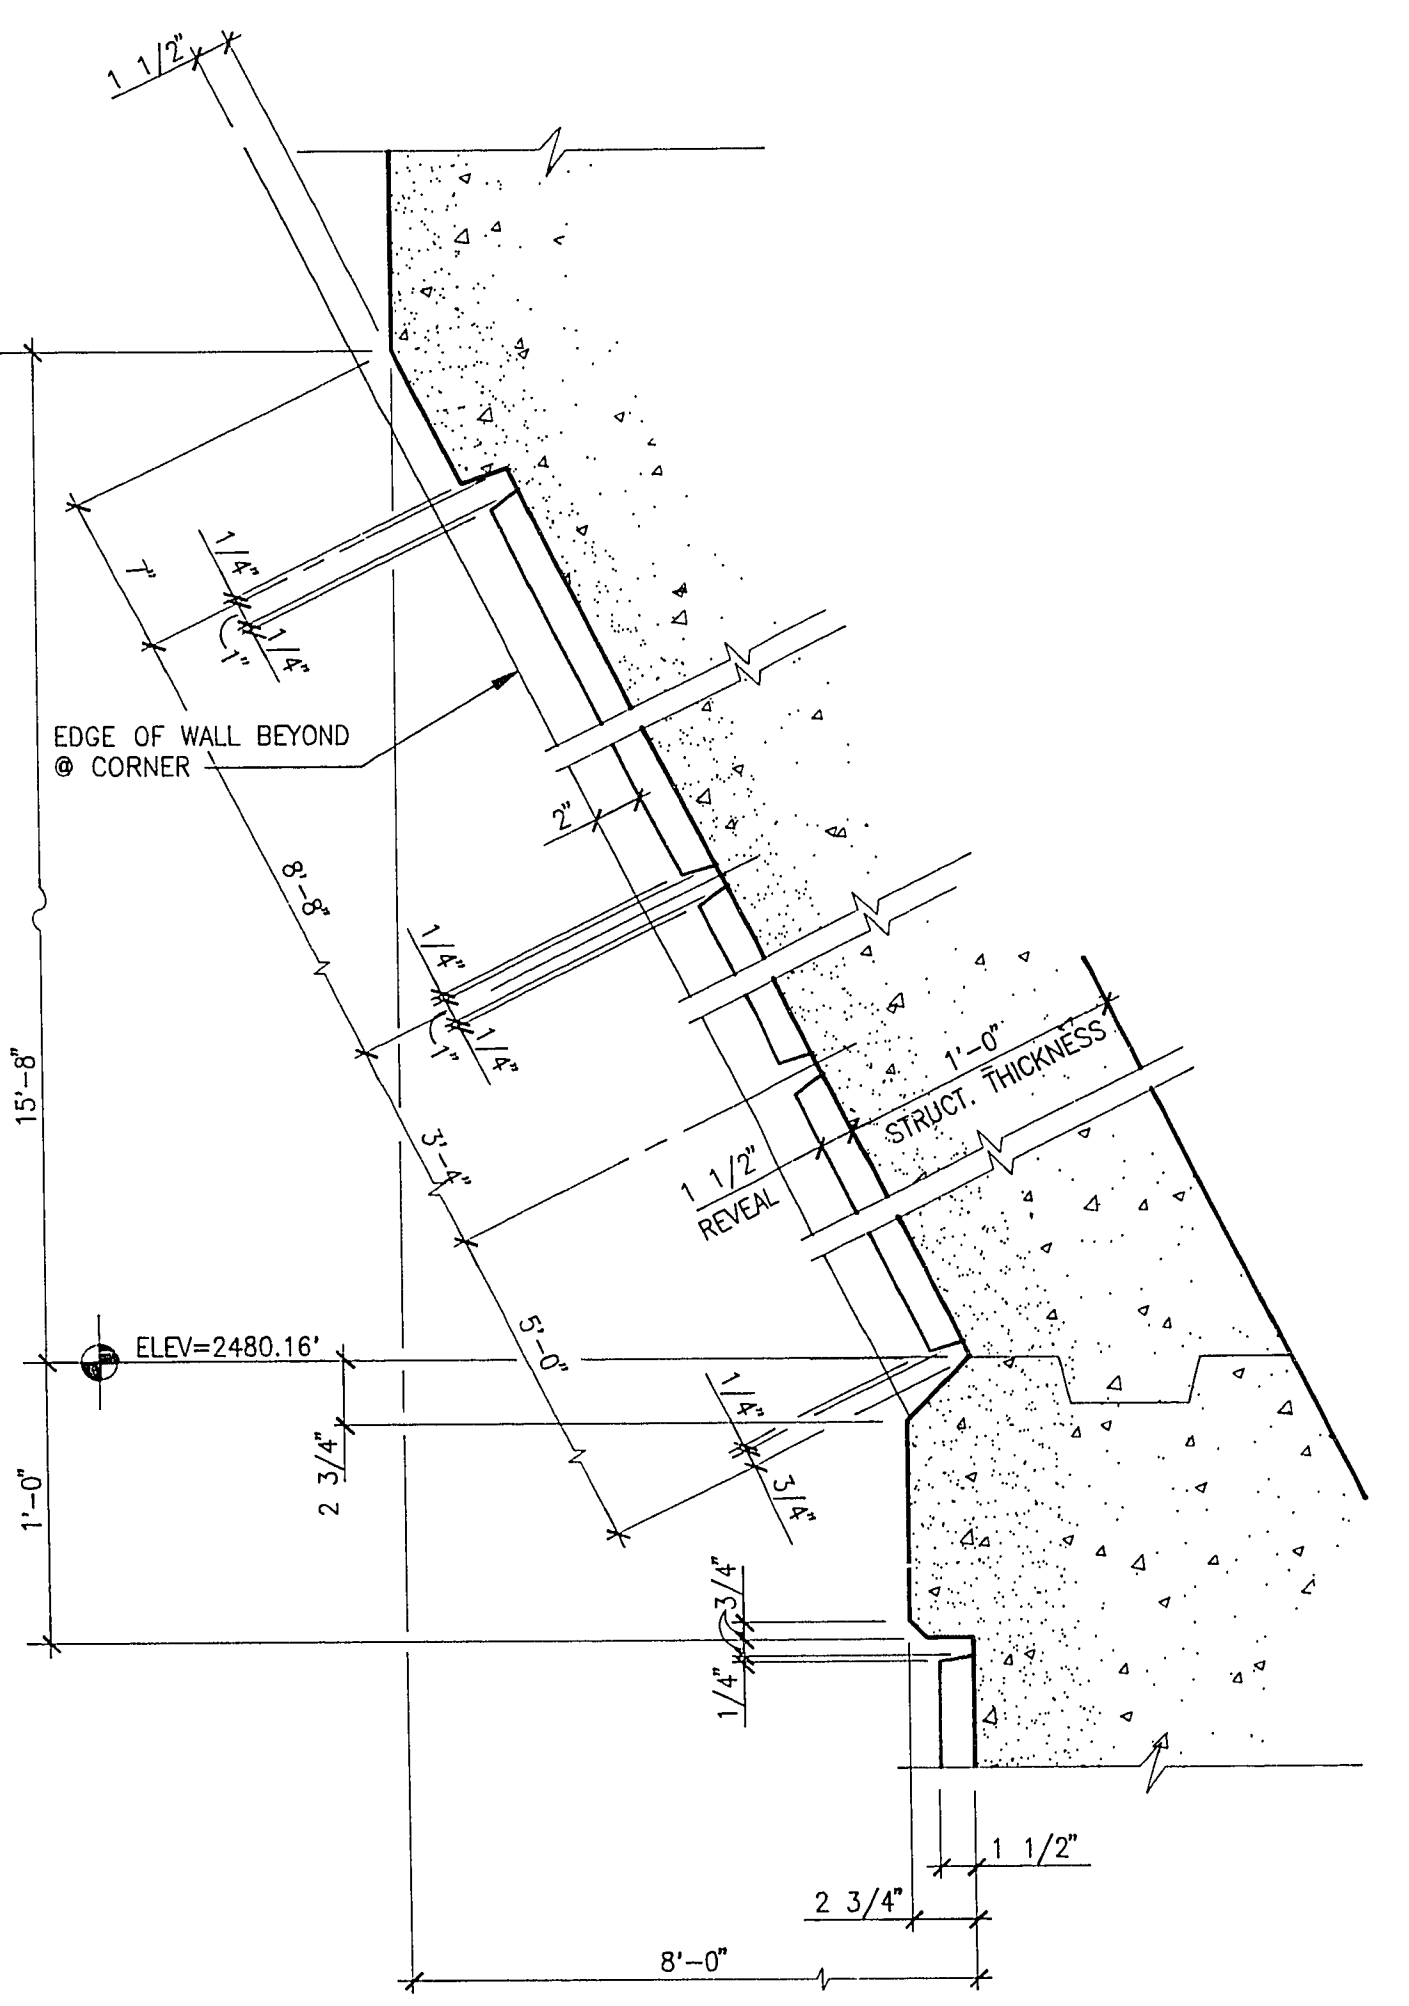

NOTES:

1. ALL DETAILS SHOWN ON THIS SHEET ARE FOR PATTERN OF NOISE ABATEMENT RUSTICATIONS ONLY. RUSTICATION PATTERN IS BASED ON ARIZONA HIGHWAY DEPT. STANDARD PATTERN. FORM LINERS ARE BY "BURKE" OR EQUAL.

FOR REINFORCING AND OTHER DETAILS OF WALLS NOT SHOWN ON THIS SHEET, SEE TYPICAL WALL SECTIONS AND DETAILS.

GBSL CONSULTING ENGINEERS
3650 S. EASTERN AVE. • SUITE 220 • LAS VEGAS, NEVADA 89109

TRANSVERSE ELEVATIONS
BUFFALO INTERCHANGE
with SUMMERLIN PARKWAY
and BUFFALO DRIVE ROADWAY BETWEEN WESTCLIFF AND WASHINGTON
CITY OF LAS VEGAS, NEVADA

89072
DESIGNED BY: GAB
DRAWN BY: KEP
CHECKED BY: GAB
DATE: 12/23/91

DESCRIPTION
1-9-92 RELEASED FOR BIDDING
3-16-92 ADDENDUM 1

SHEET NUMBER
0-5
OF 14

107-V1753