



89072 ED2 PLOTTED BY: KHO DATE: 05/29/92 TIME: 12:19 SCALE FACTOR: 1=40

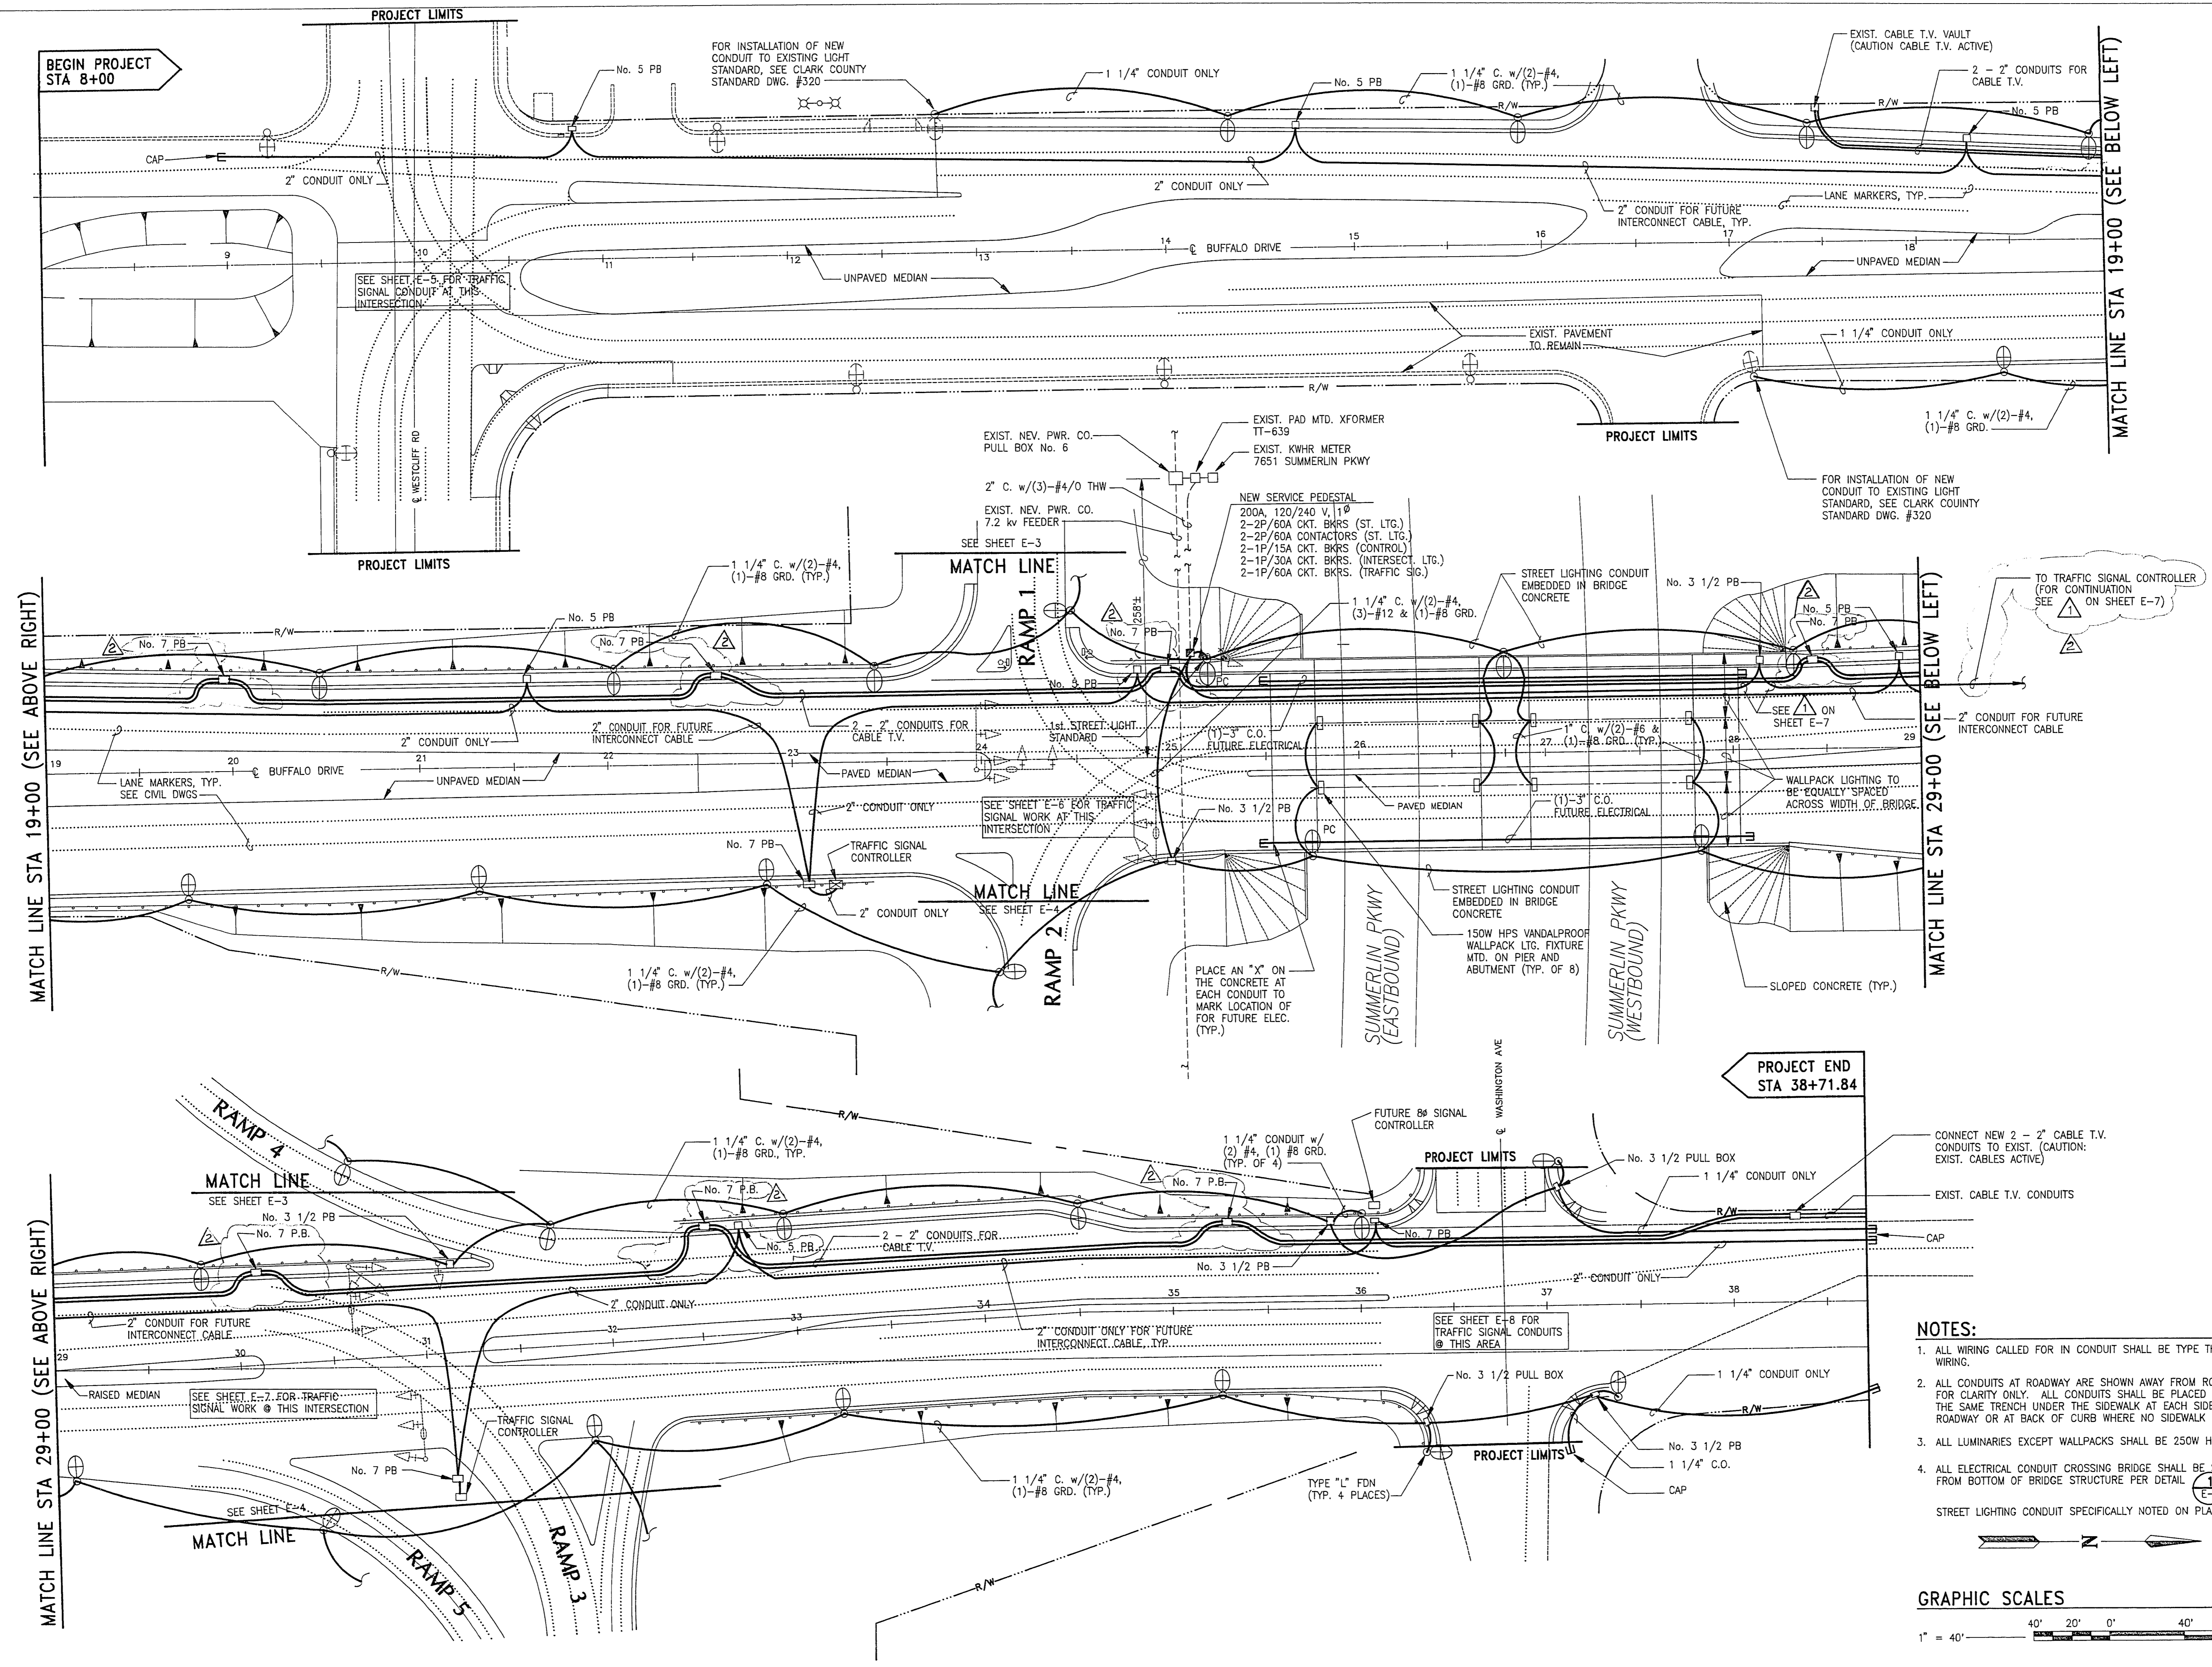

- NOTES:**
1. ALL WIRING CALLED FOR IN CONDUIT SHALL BE TYPE THW WIRING.
 2. ALL CONDUITS AT ROADWAY ARE SHOWN AWAY FROM ROAD FOR CLARITY ONLY. ALL CONDUITS SHALL BE PLACED IN THE SAME TRENCH UNDER THE SIDEWALK AT EACH SIDE OF ROADWAY OR AT BACK OF CURB WHERE NO SIDEWALK OCCURS.
 3. ALL LUMINARIES EXCEPT WALLPACKS SHALL BE 250W HPS
 4. ALL ELECTRICAL CONDUIT CROSSING BRIDGE SHALL BE SUSPENDED FROM BOTTOM OF BRIDGE STRUCTURE PER DETAIL (E-1) EXCEPT STREET LIGHTING CONDUIT SPECIFICALLY NOTED ON PLAN ABOVE.

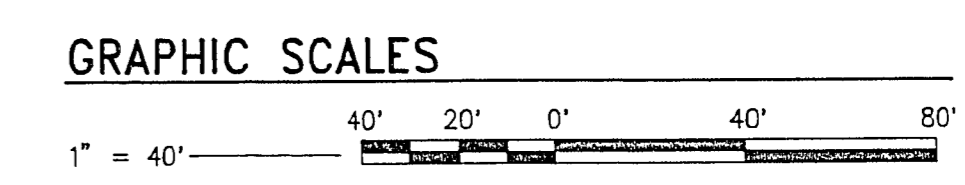

GB&L CONSULTING ENGINEERS
 3650 S. EASTERN AVE. • SUITE 220 • LAS VEGAS, NEVADA 89109
 CONSULTANT

DESCRIPTION	DATE	BY
1-9-92 RELEASED FOR BIDDING	89072	
3-16-92 ADDENDUM 1		
6-3-92 CHANGE ORDER #1		
4/23/91		

DESIGNED BY: HW
 DRAWN BY: SJS
 CHECKED BY: HW
 DATE: 4/23/91

STREET LIGHTING @ BUFFALO DR. BUFFALO INTERCHANGE
 with SUMMERLIN PARKWAY and BUFFALO DRIVE ROADWAY BETWEEN WESTCLIFF AND WASHINGTON CITY OF LAS VEGAS, NEVADA

SHEET NUMBER
 8