


88072 E03 PLOTTED BY: KHO DATE: 05/29/92 TIME: 12:04 SCALE FACTOR: 1=60

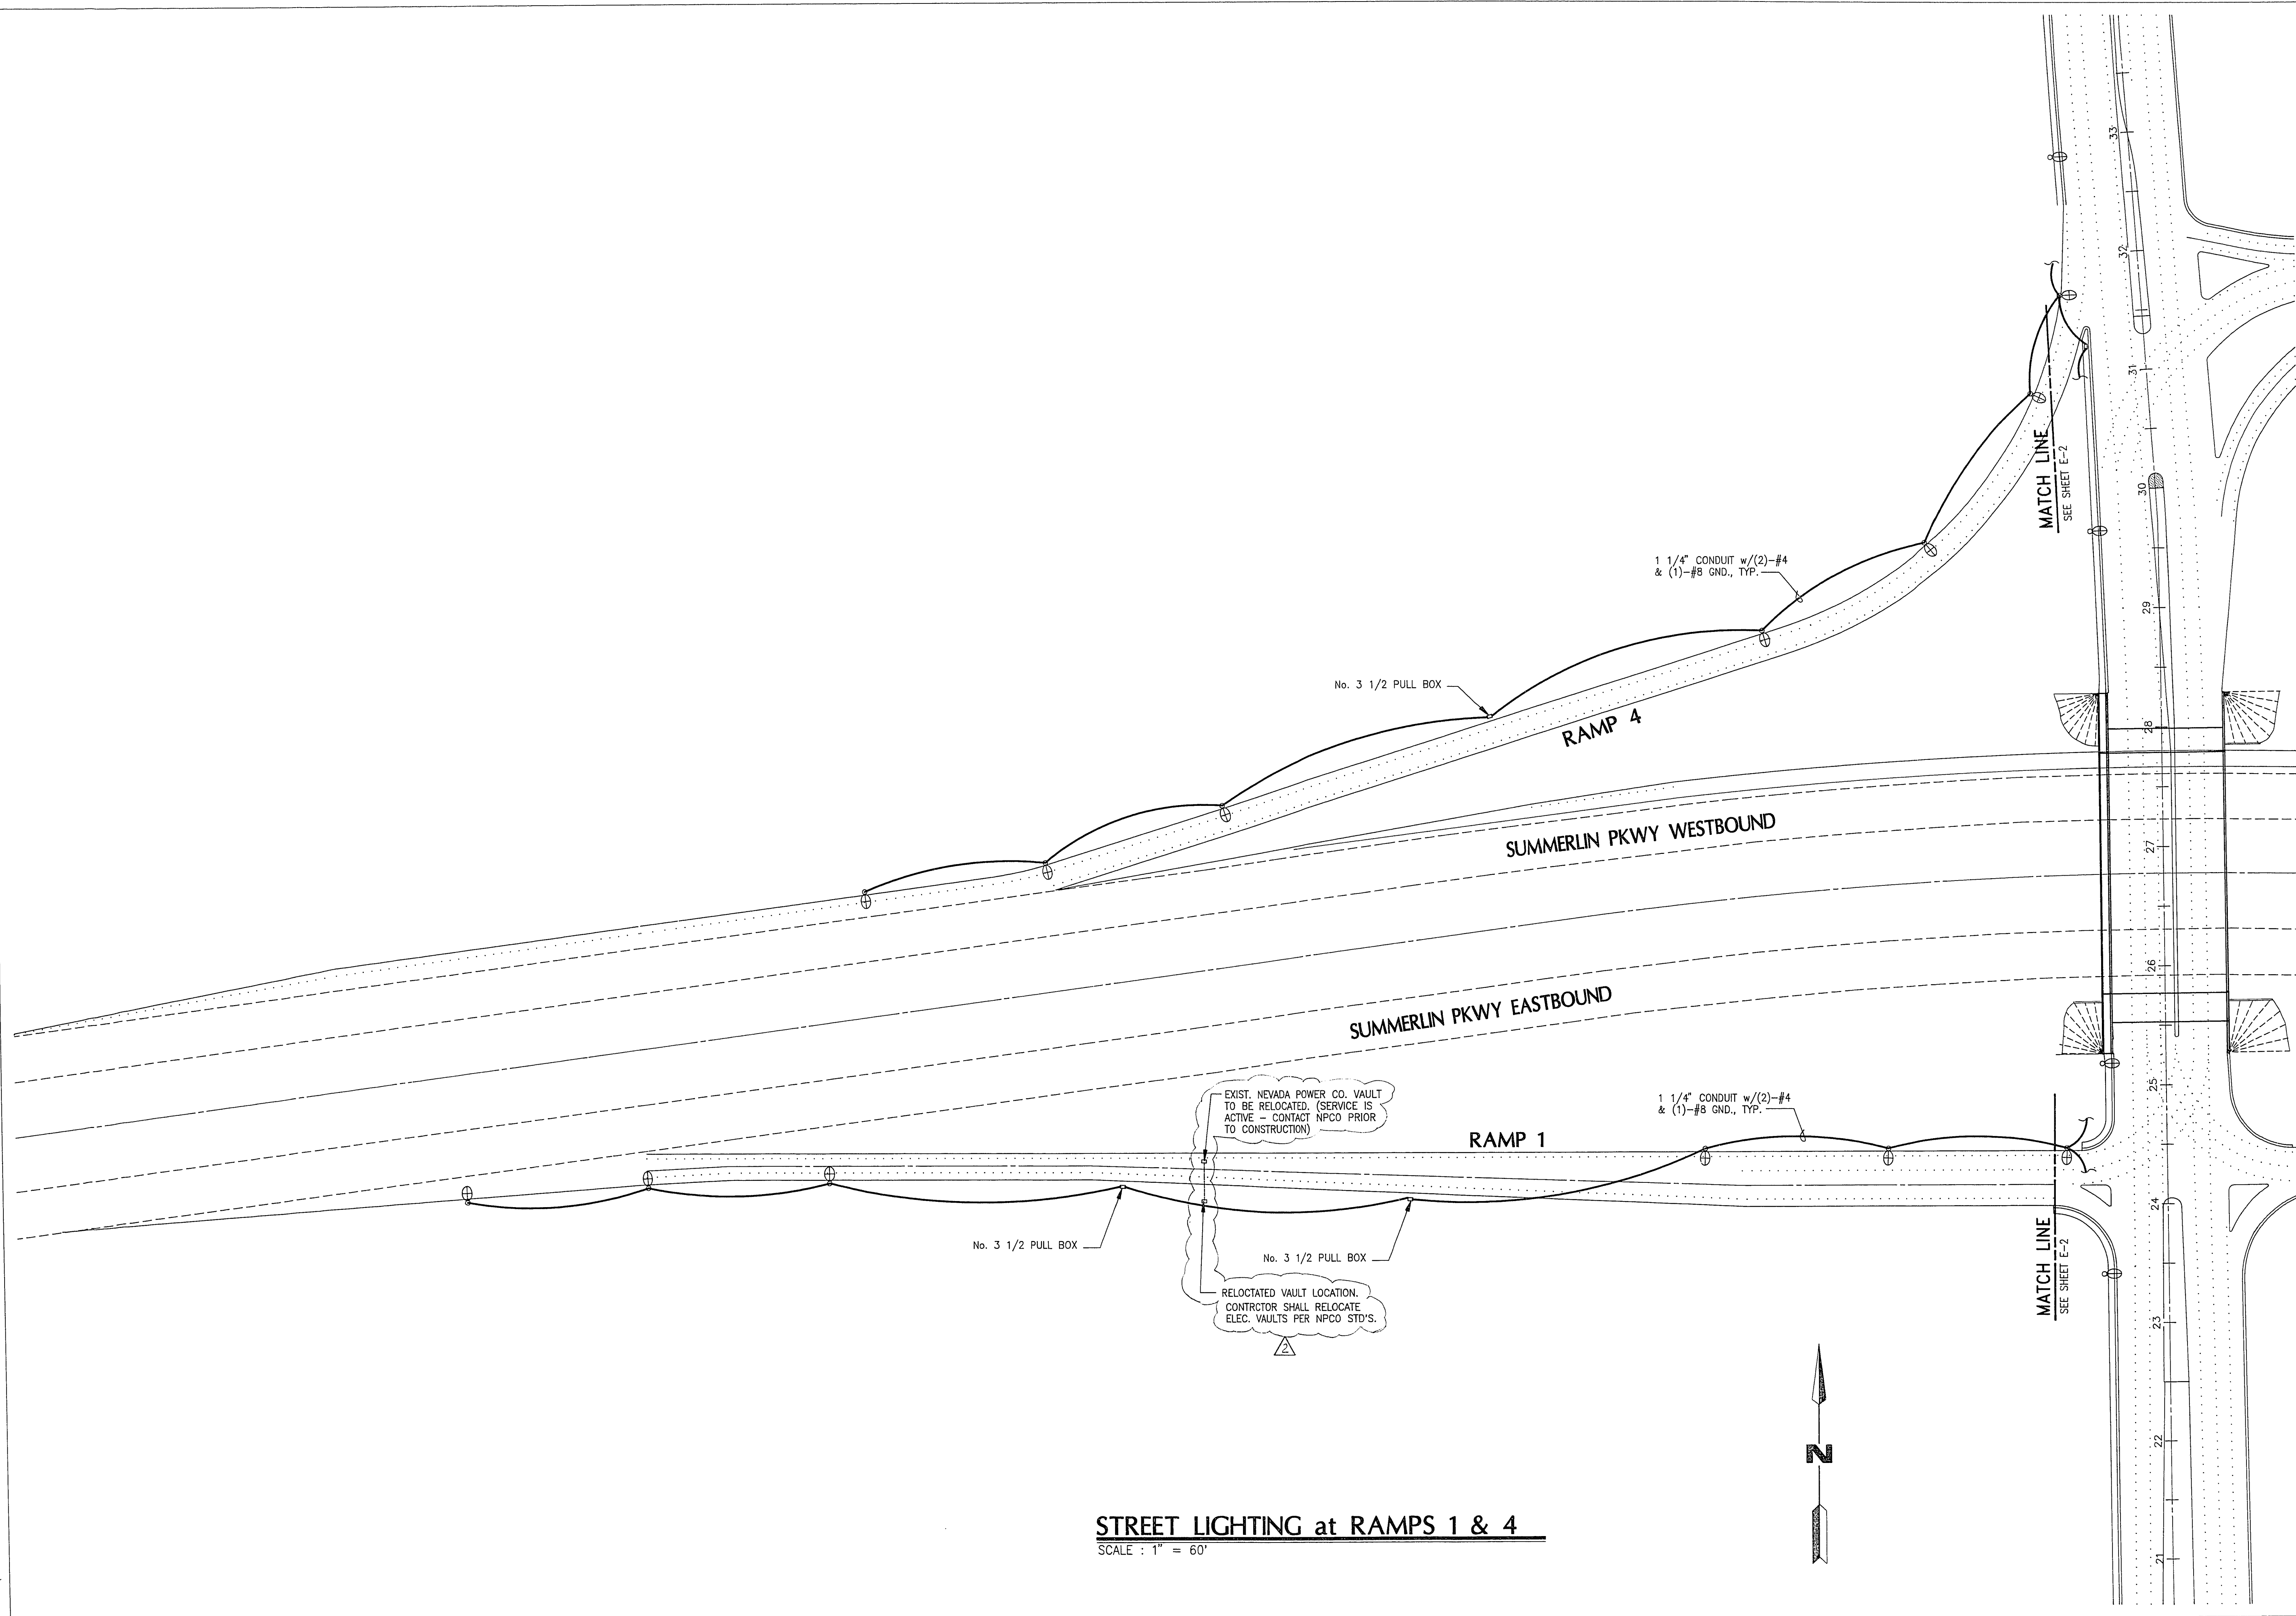

**STREET LIGHTING at RAMPS 1 & 4**  
 SCALE : 1" = 60'



**GB&L CONSULTING ENGINEERS**  
 3650 S. EASTERN AVE. • SUITE 220 • LAS VEGAS, NEVADA 89109  
 CONSULTANT

**STREET LIGHTS @ RAMPS 1 and 4**  
**BUFFALO INTERCHANGE**  
 with SUMMERLIN PARKWAY  
 and BUFFALO DRIVE ROADWAY BETWEEN WESTCLIFF AND WASHINGTON  
 CITY of LAS VEGAS, NEVADA

NO.	DATE	DESCRIPTION
1	1-9-92	RELEASED FOR BIDDING
2	6-3-92	CHANGE ORDER #1

JOB NO.	REV	DATE
88072	HW	4/23/91

DESIGNED BY	DRAWN BY	CHECKED BY	DATE
LWA	LWA	HW	4/23/91

SHEET NUMBER  

 107-V1753