


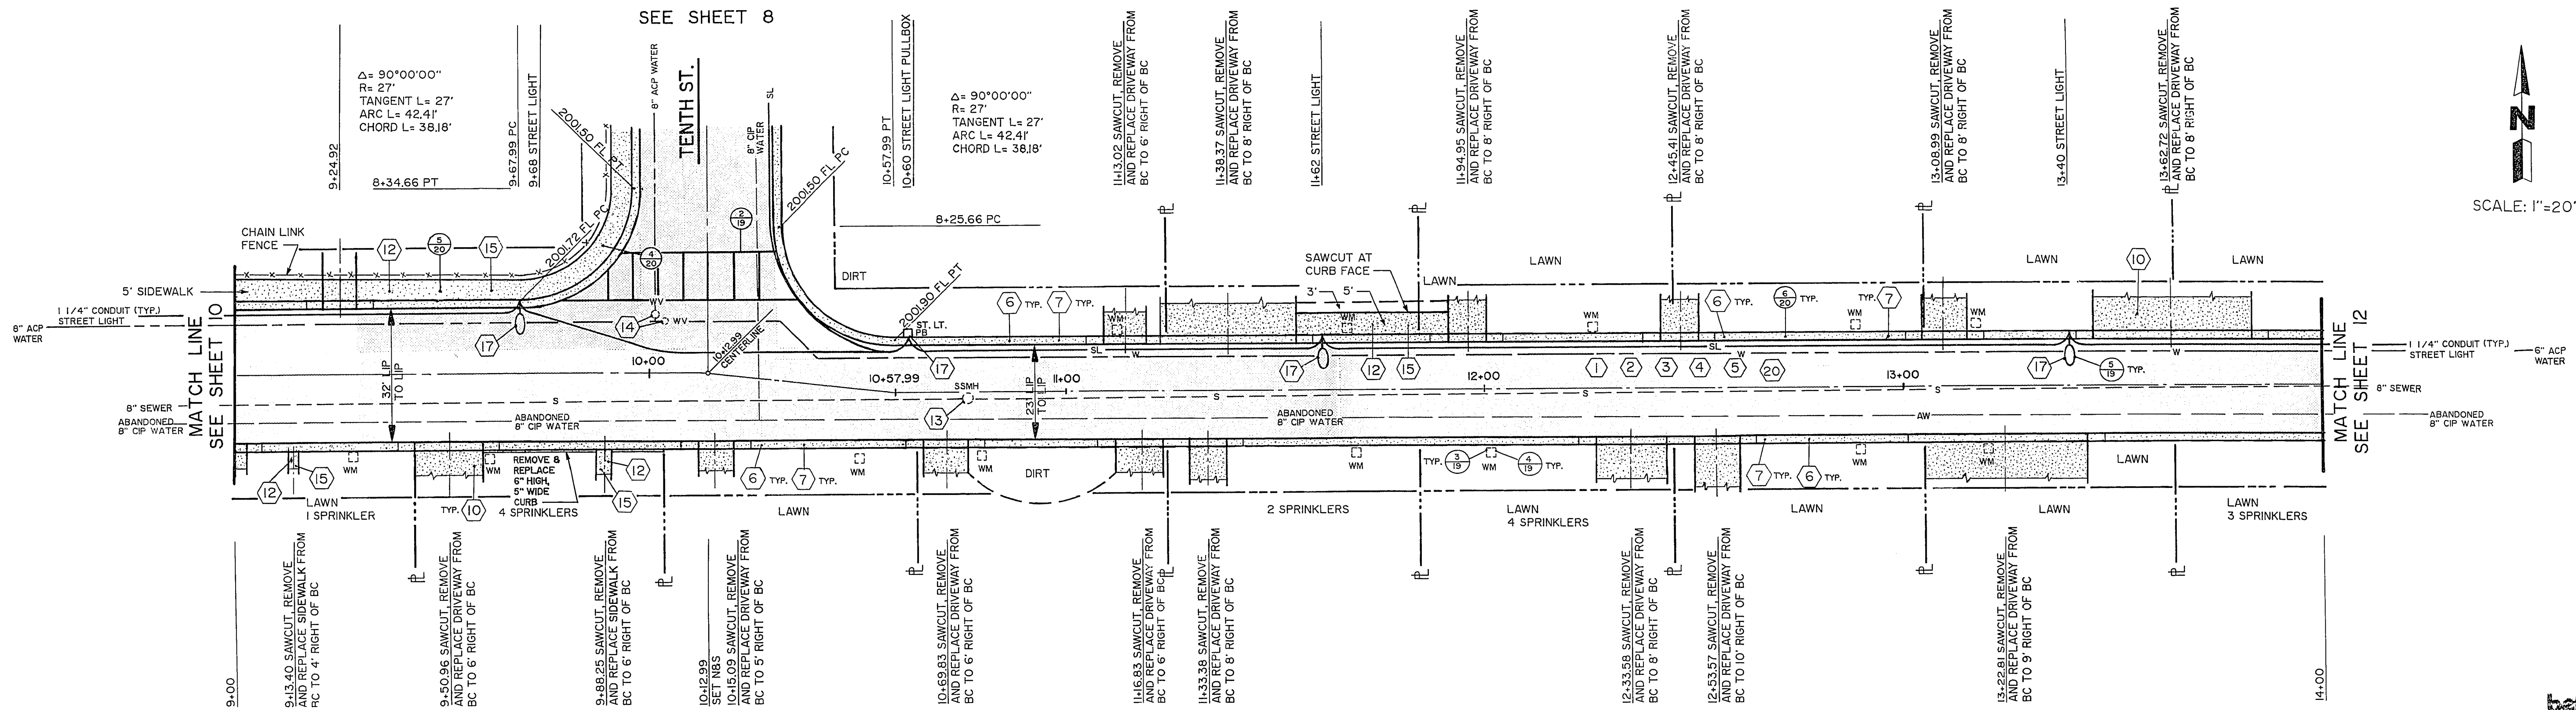


SCALE: 1"=20'

Call before you Dig.


1-800-227-2600
UNDERGROUND SERVICE USA

SWEENEY AVENUE

2003
2002
2001
2000
1999

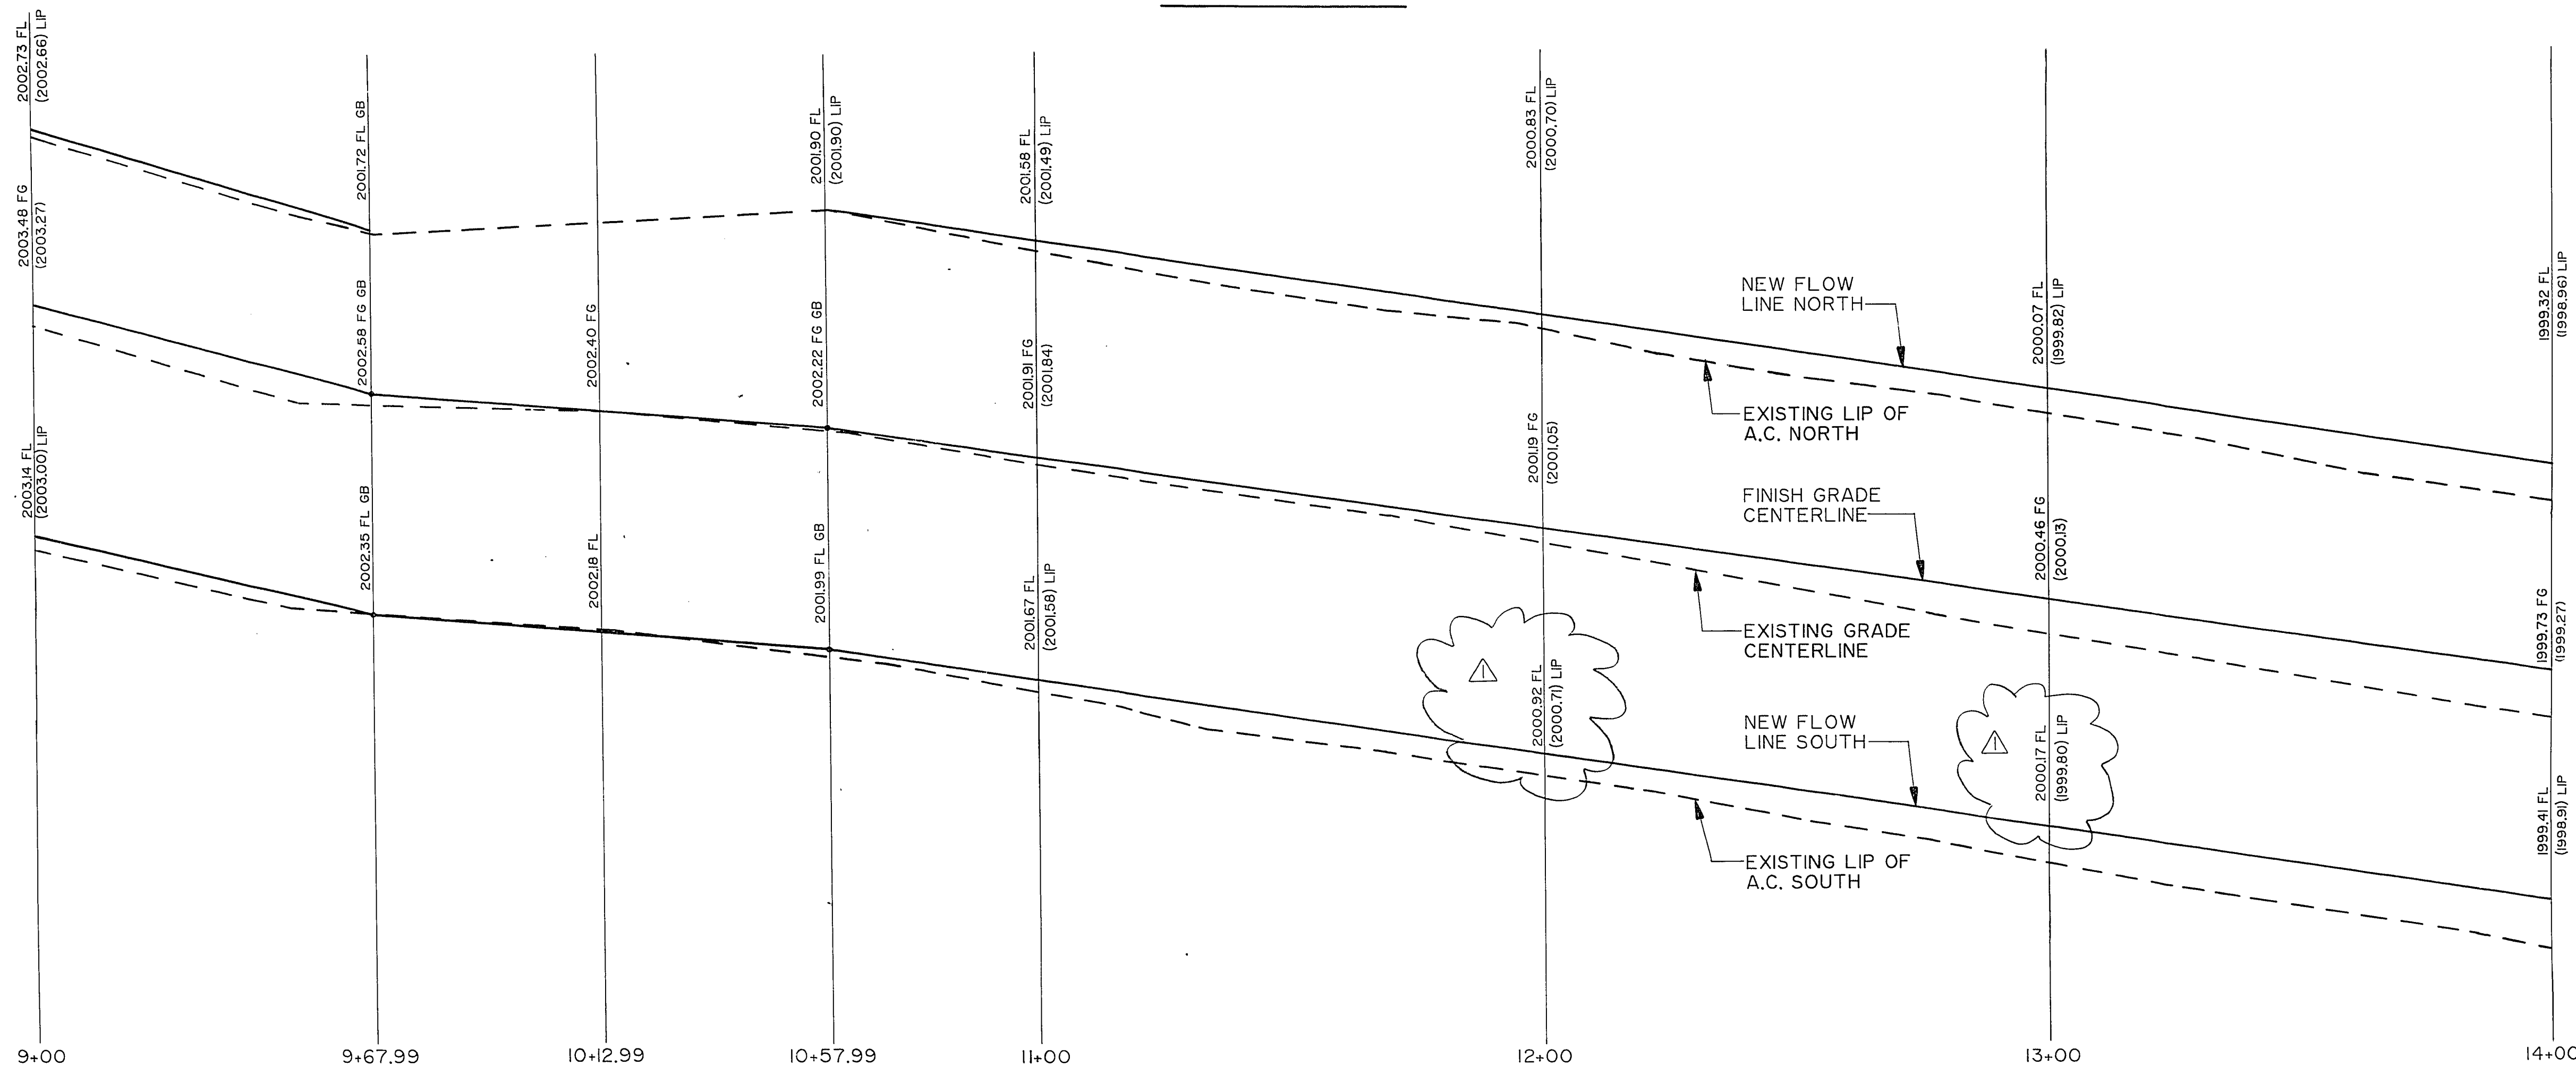

2003
2002
2001
2000
1999

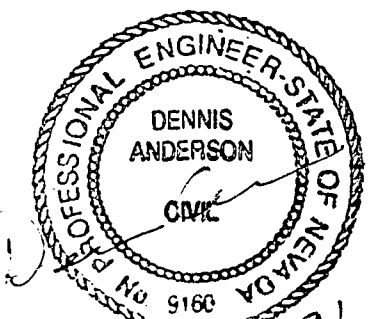

107-VI801

SHEET 11 OF 23

REVISD 11/6/91 BY B.P.

23-3-14

1990 - 1991 STREET REHABILITATION HUNTRIDGE PHASE I PROJECT