
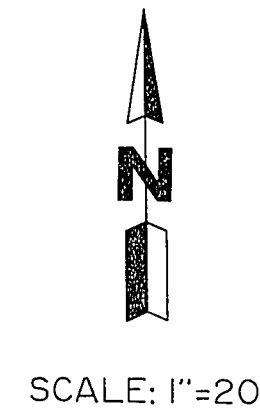



SEE SHEET 14

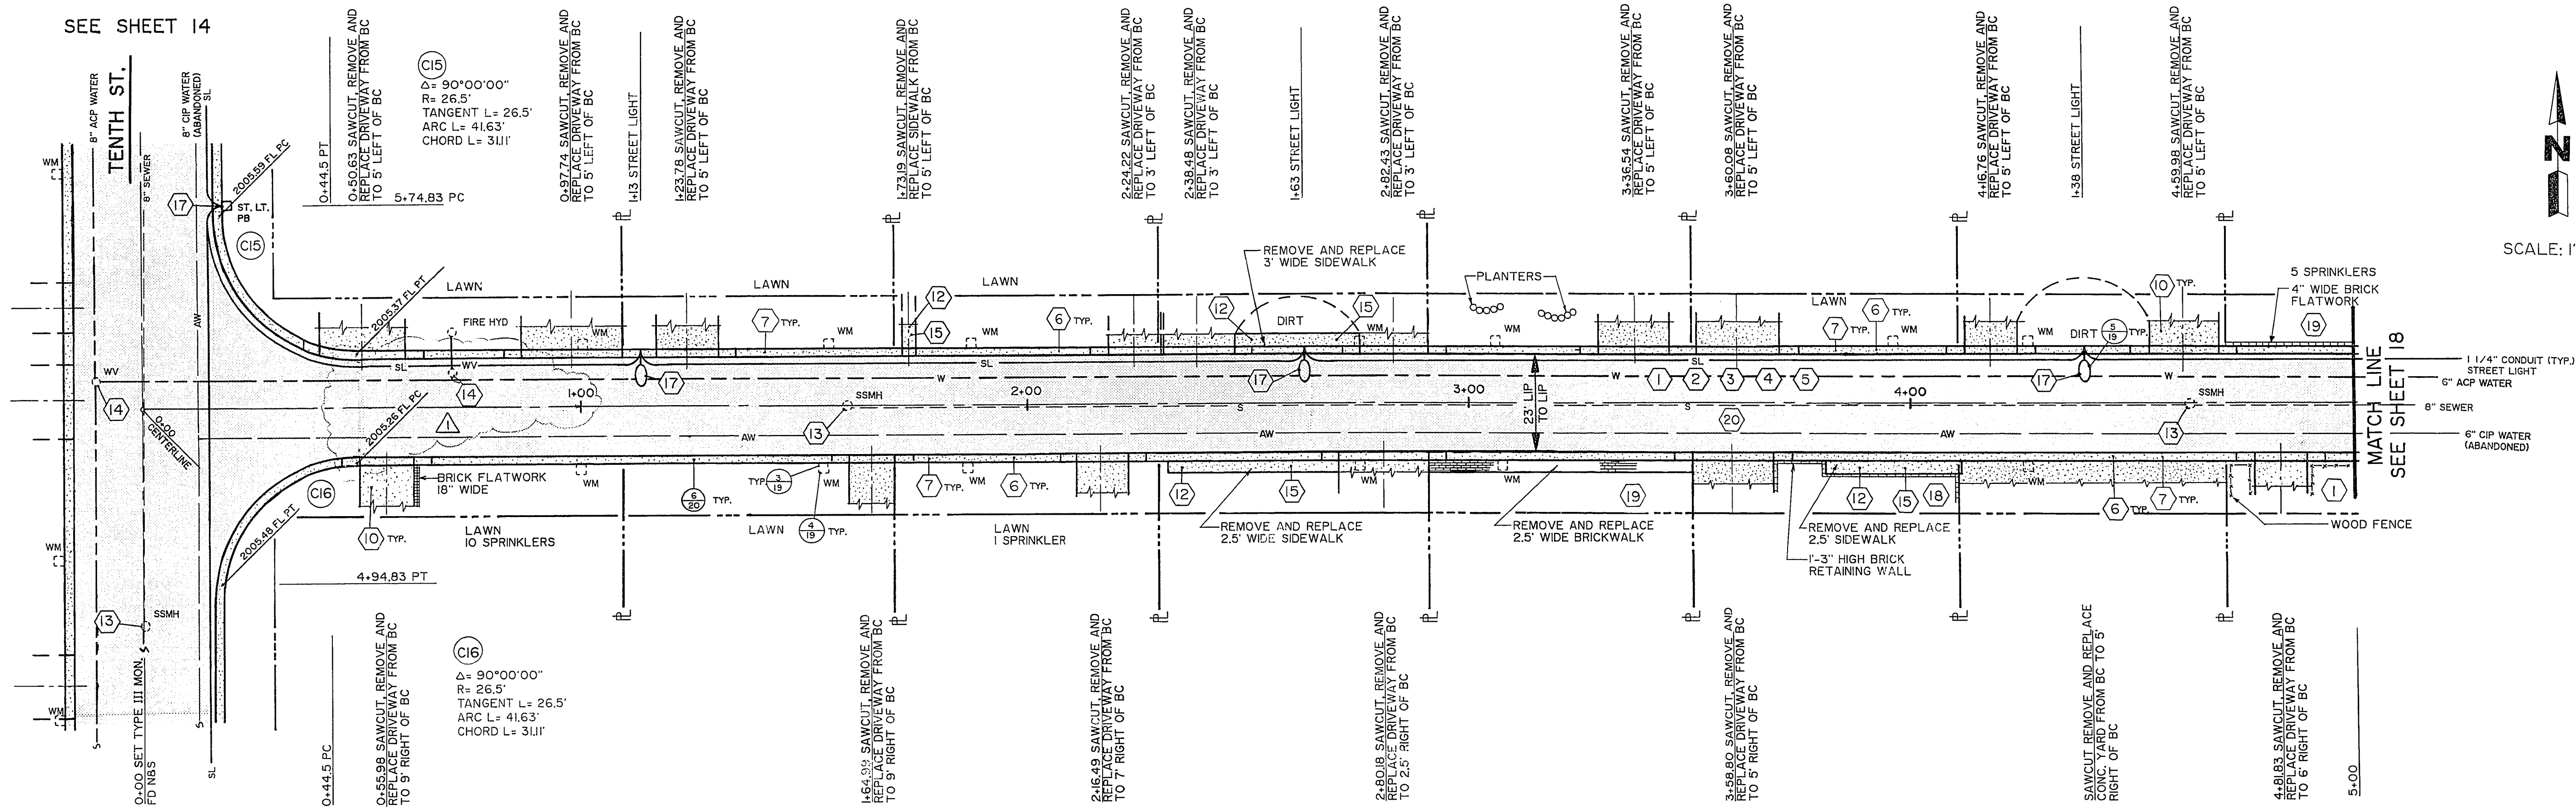


BRACKEN AVENUE

Call before you Dig.

1-800-227-2600  
UNDERGROUND SERVICE BUREAU

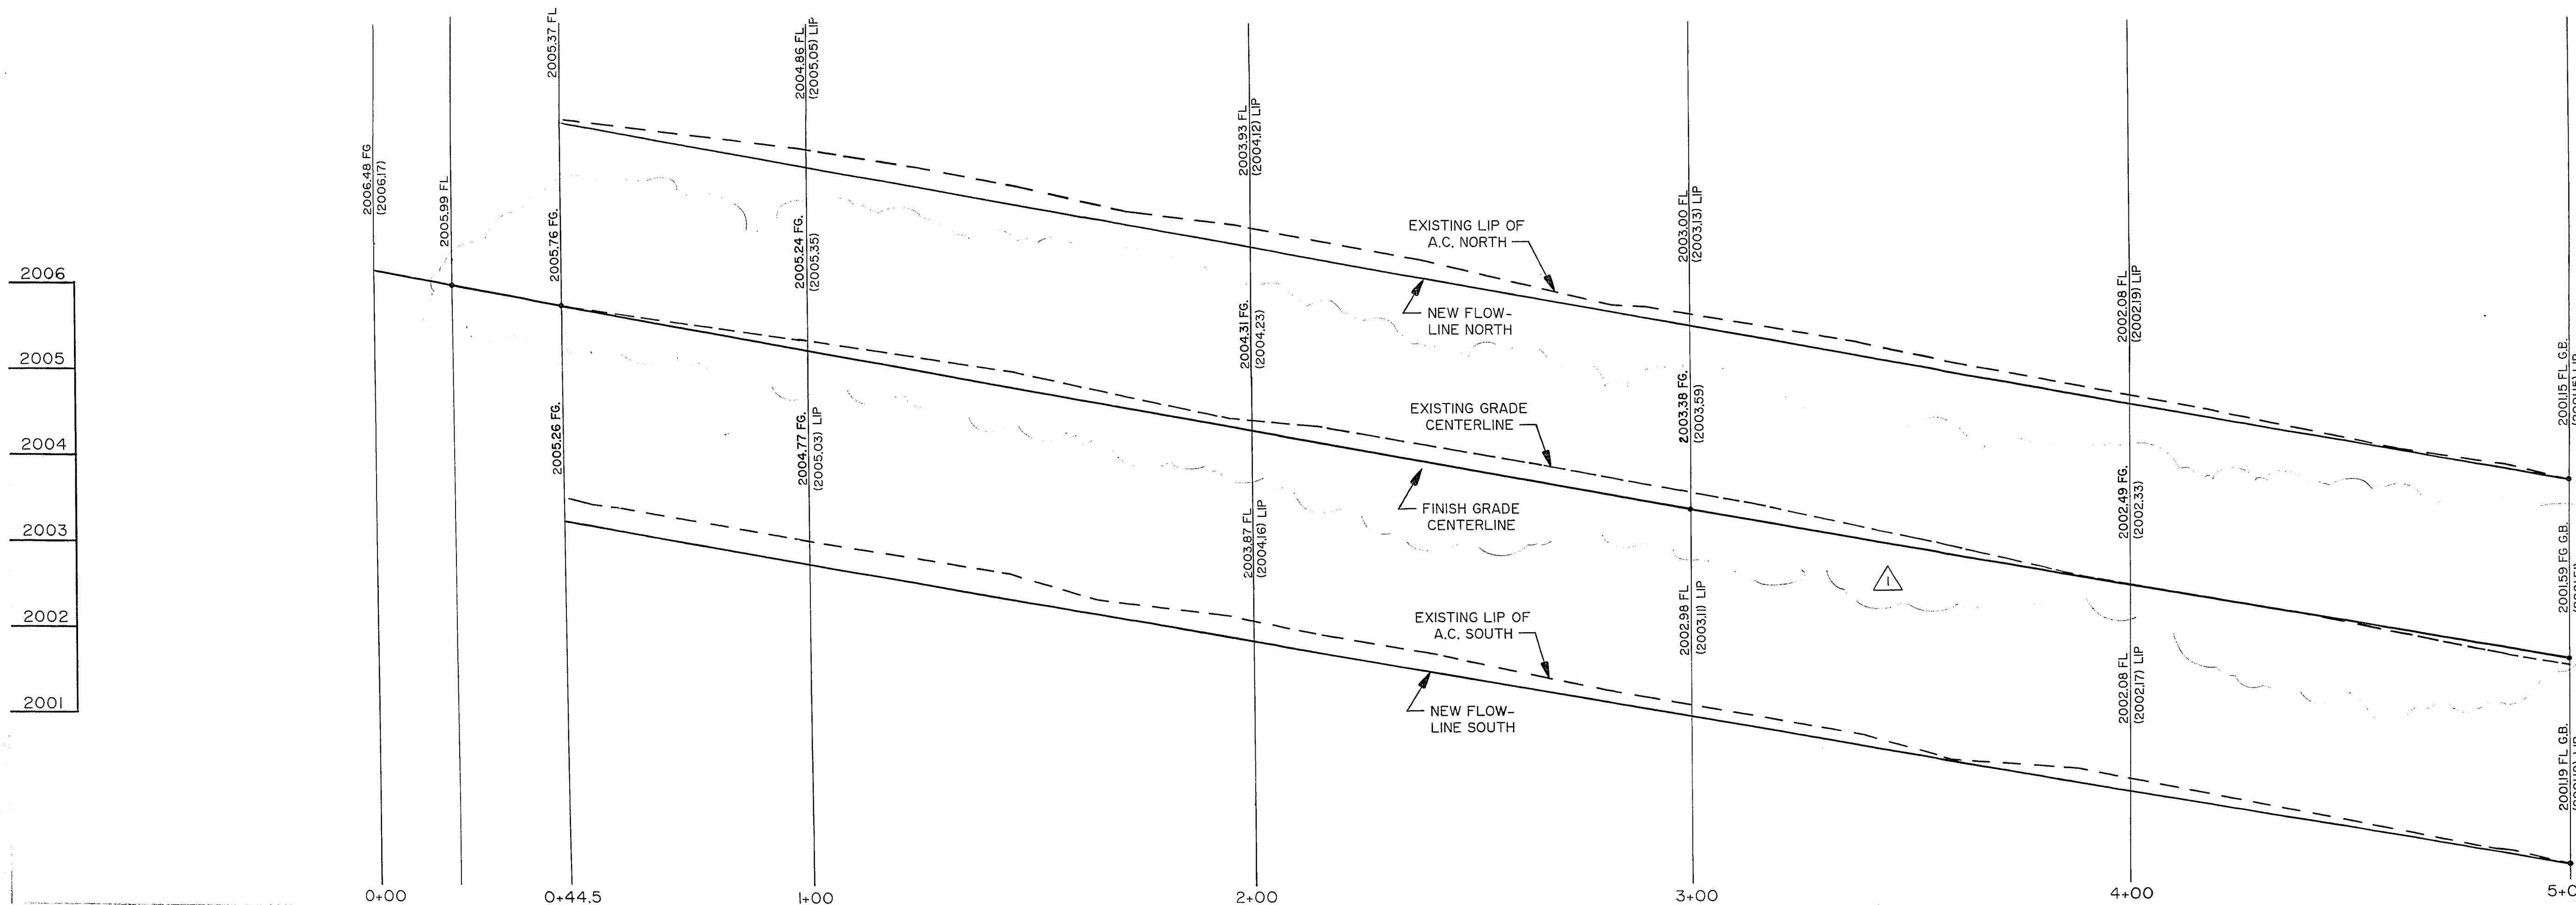

|      |
|------|
| 2006 |
| 2005 |
| 2004 |
| 2003 |
| 2002 |
| 2001 |

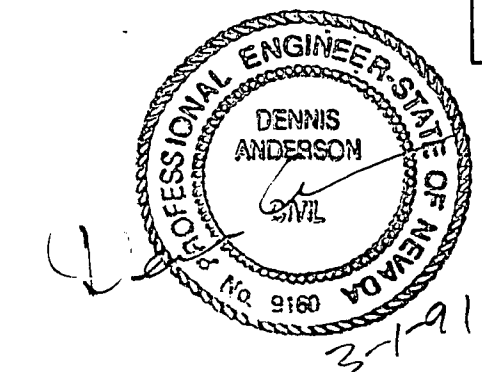

107-VI801  
SHEET 17 OF 23

REVIS 12 SEPT. 1991 BY G.G.