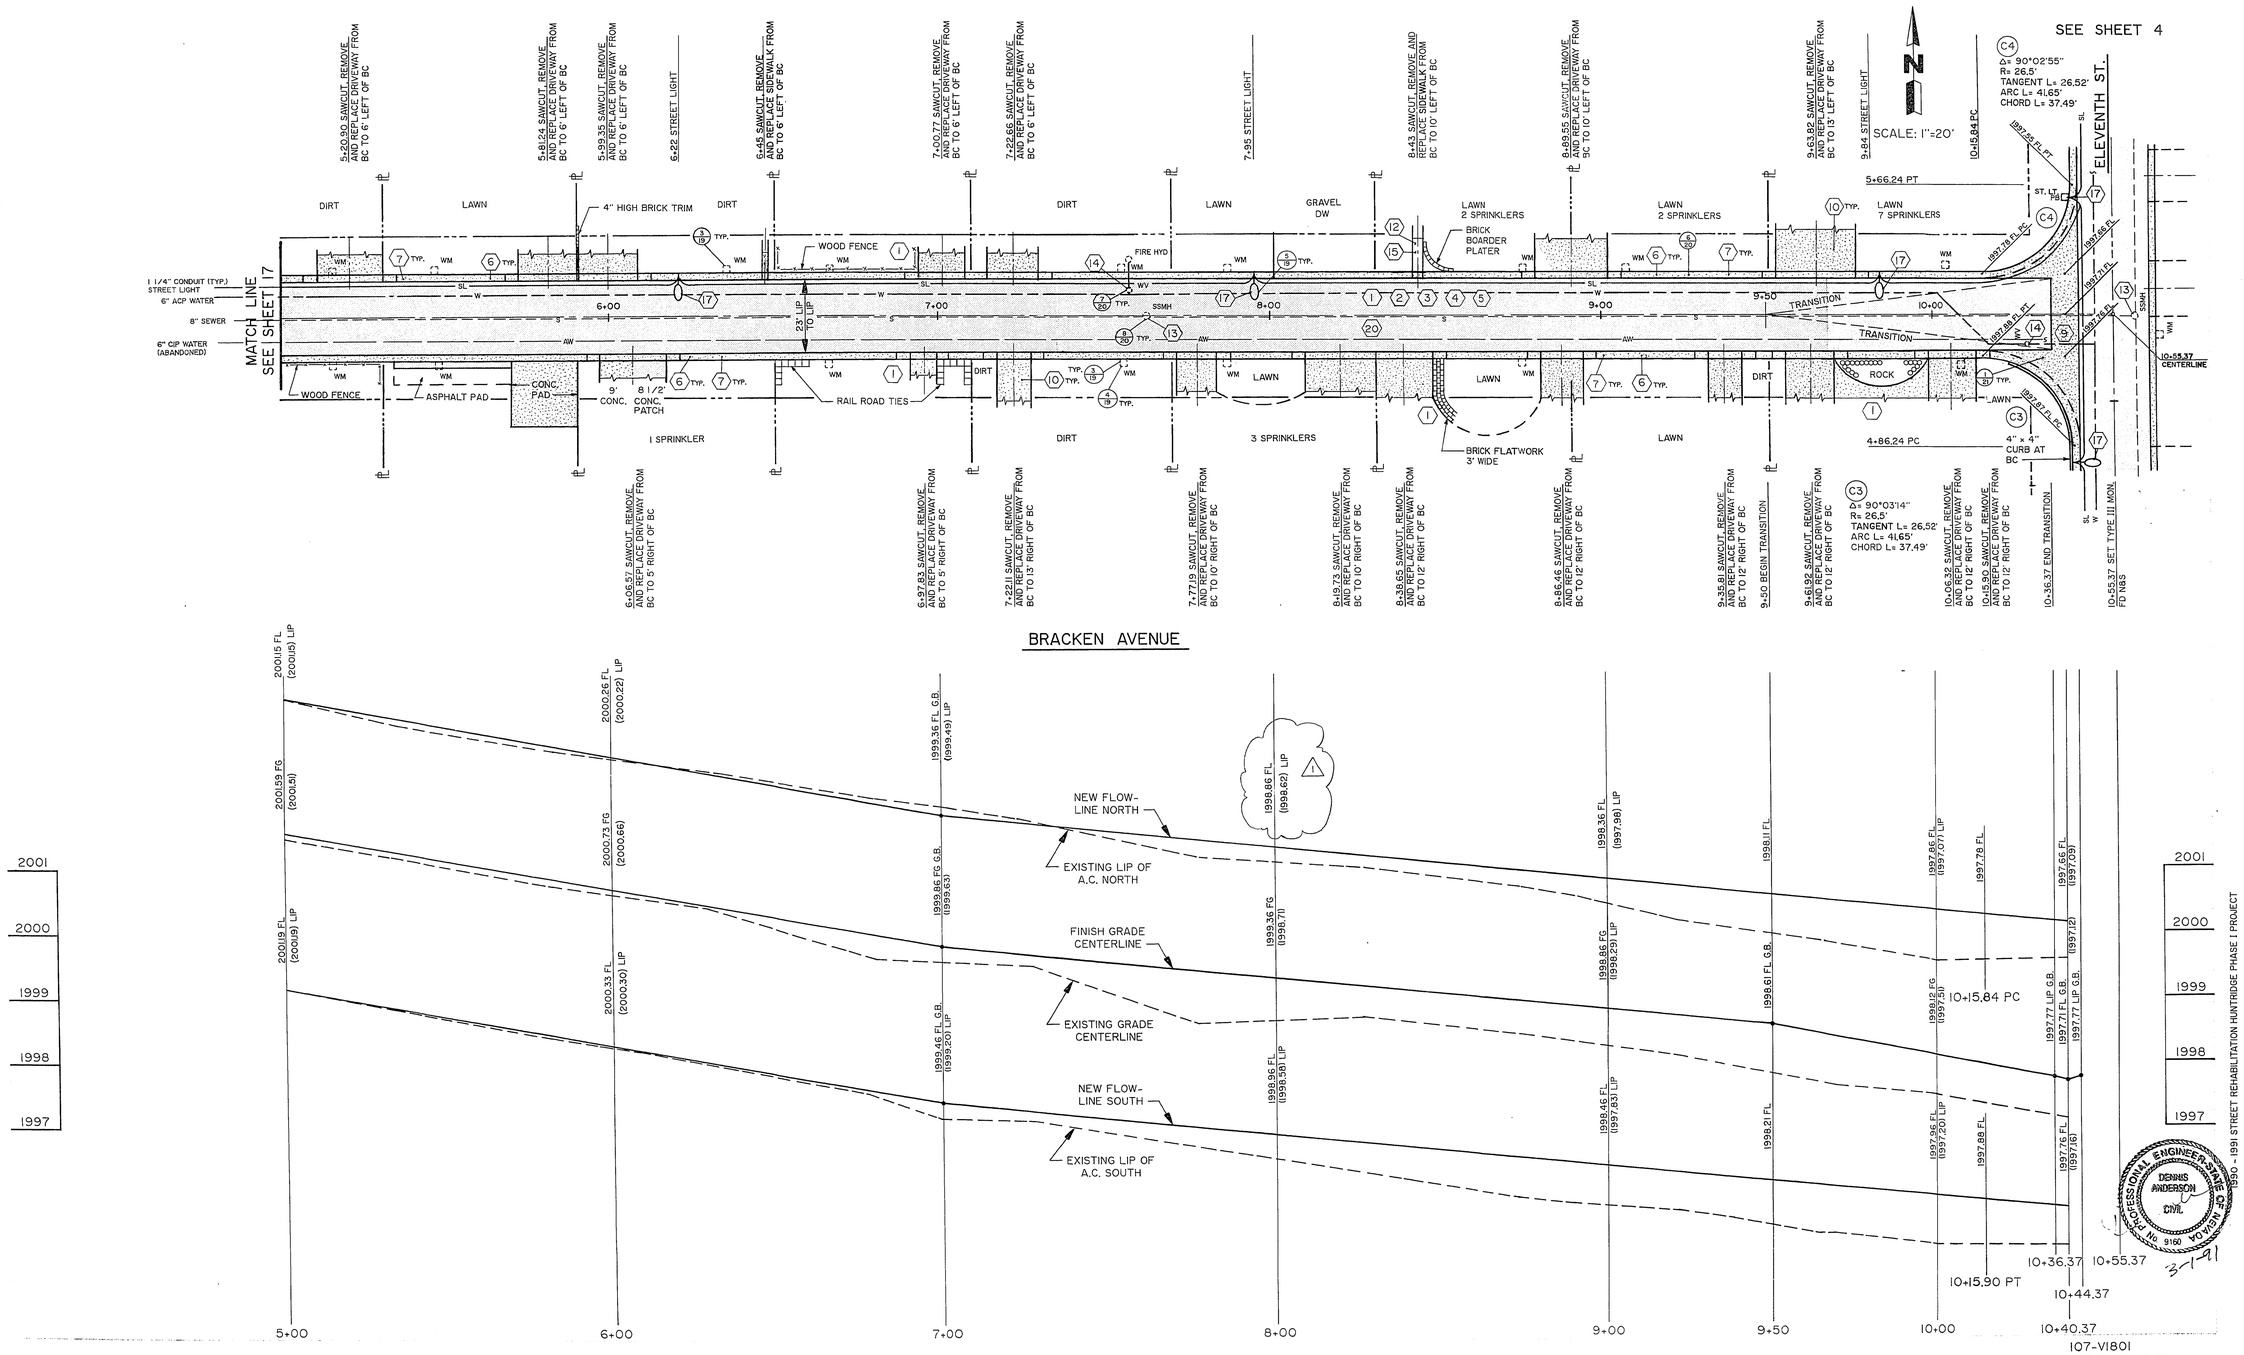

1990 - 1991 STREET REHABILITATION HUNTRIDGE PHASE I PROJECT

107-V1801
SHEET 18 OF 23

REVISED 18 SEPT. 1991 BY B.P.