
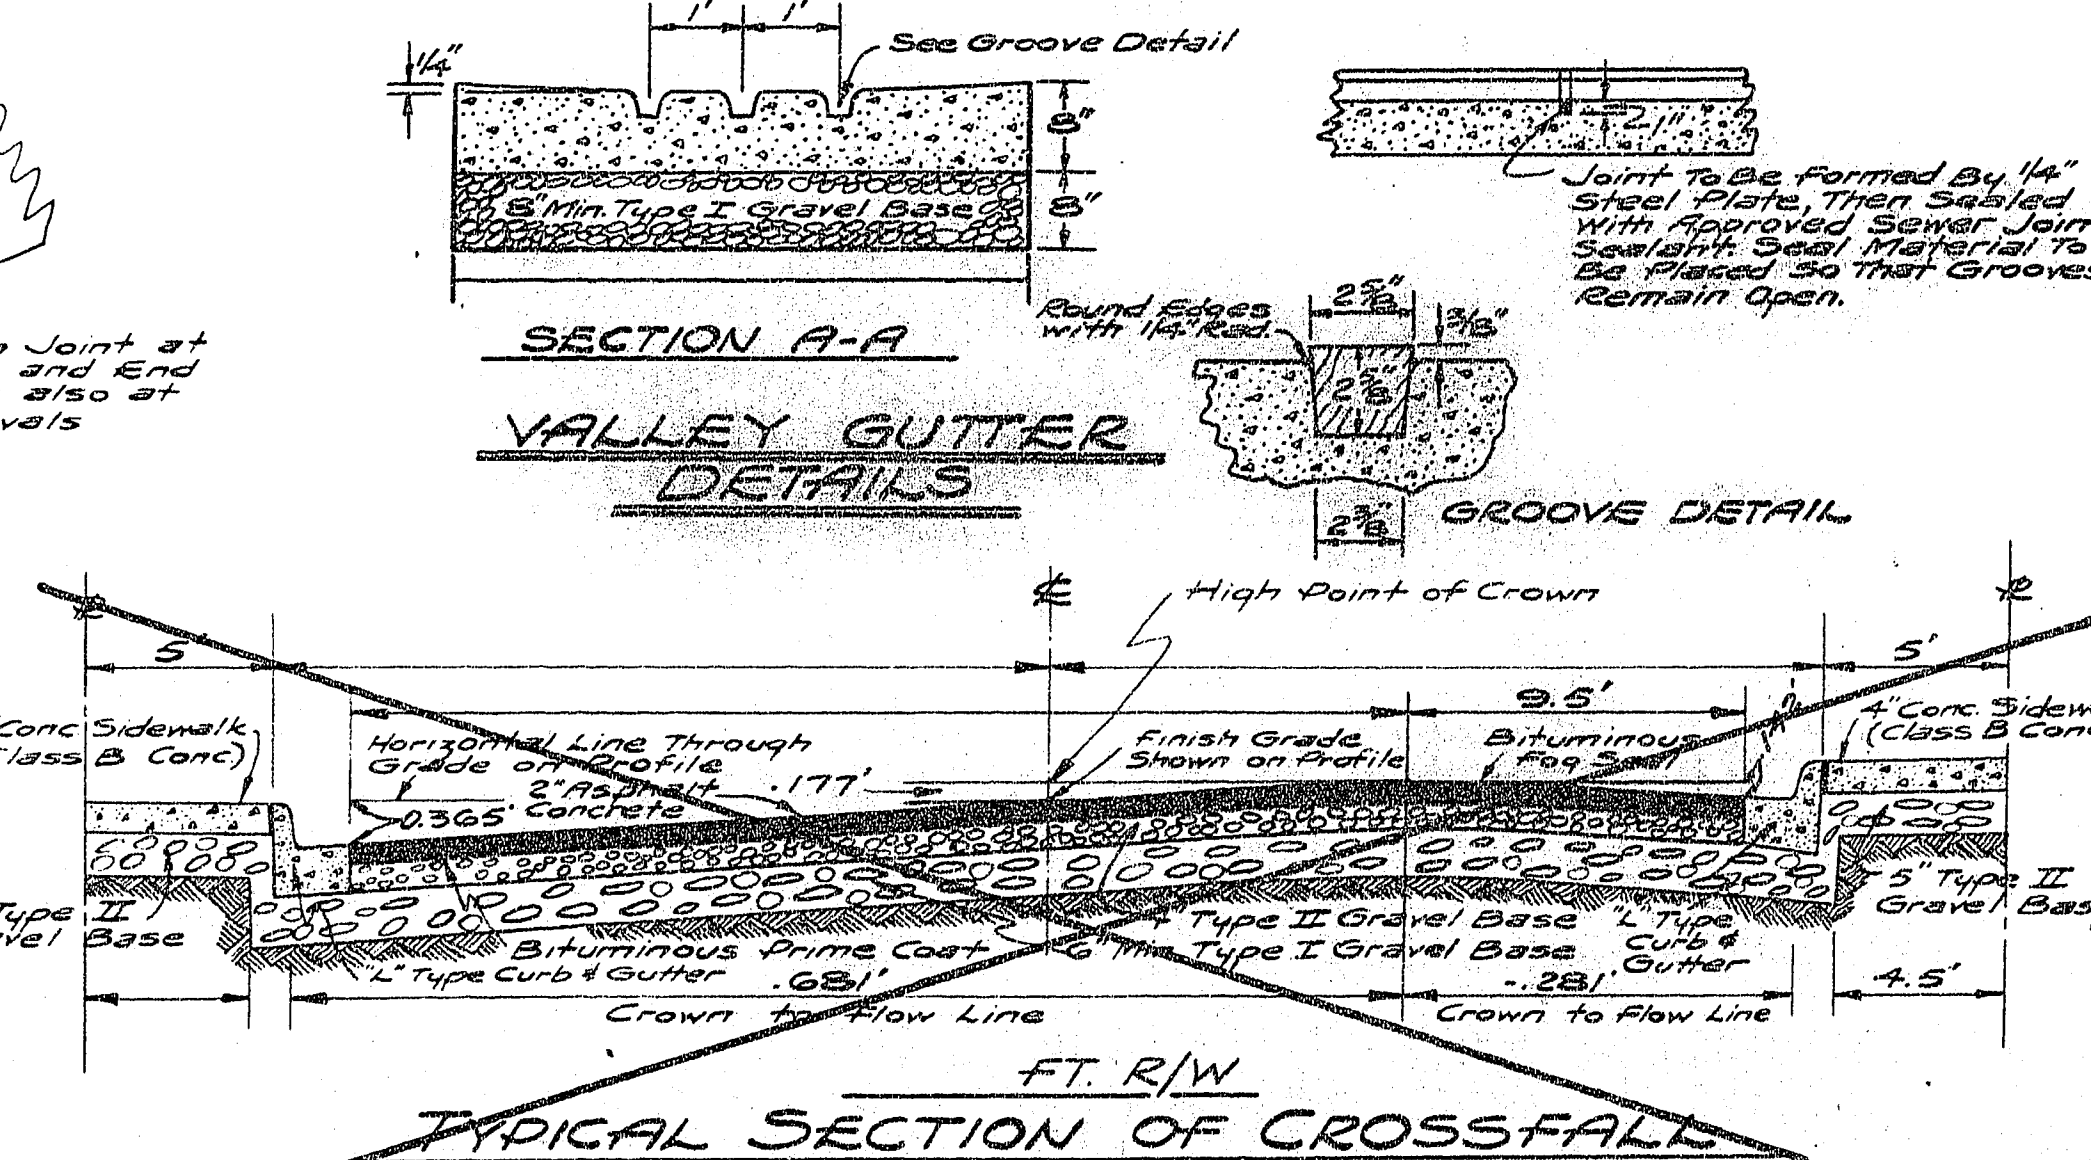
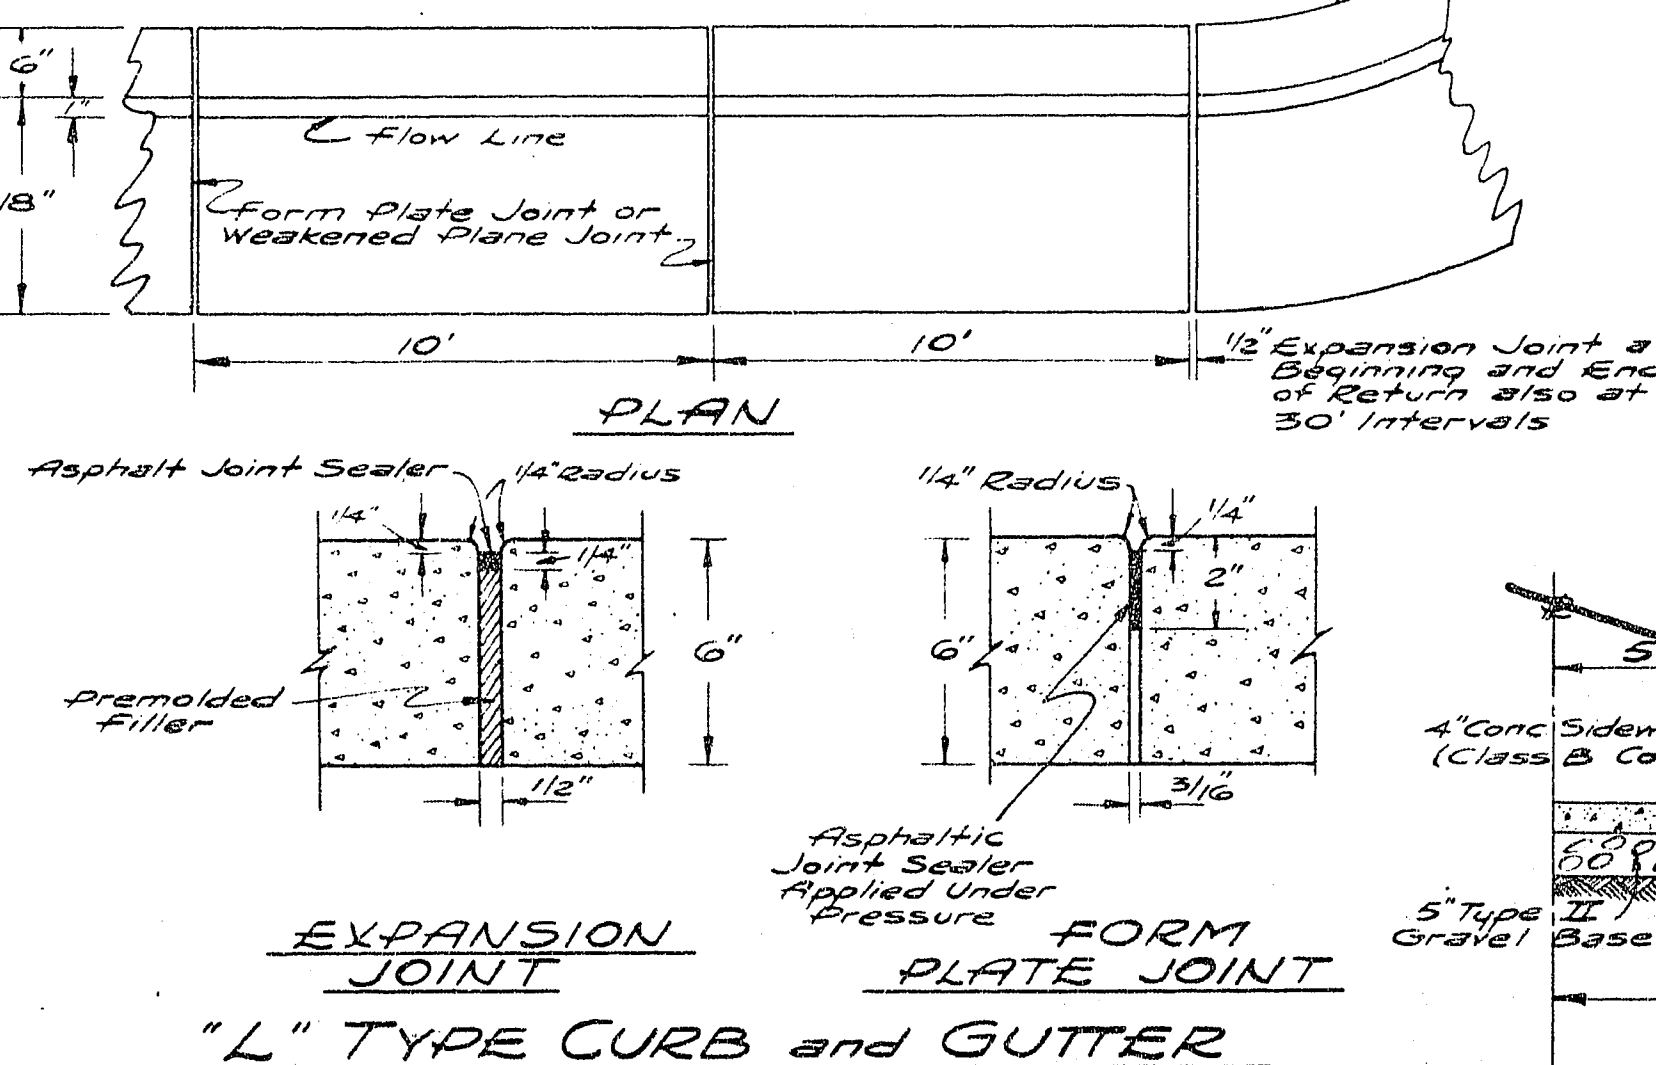
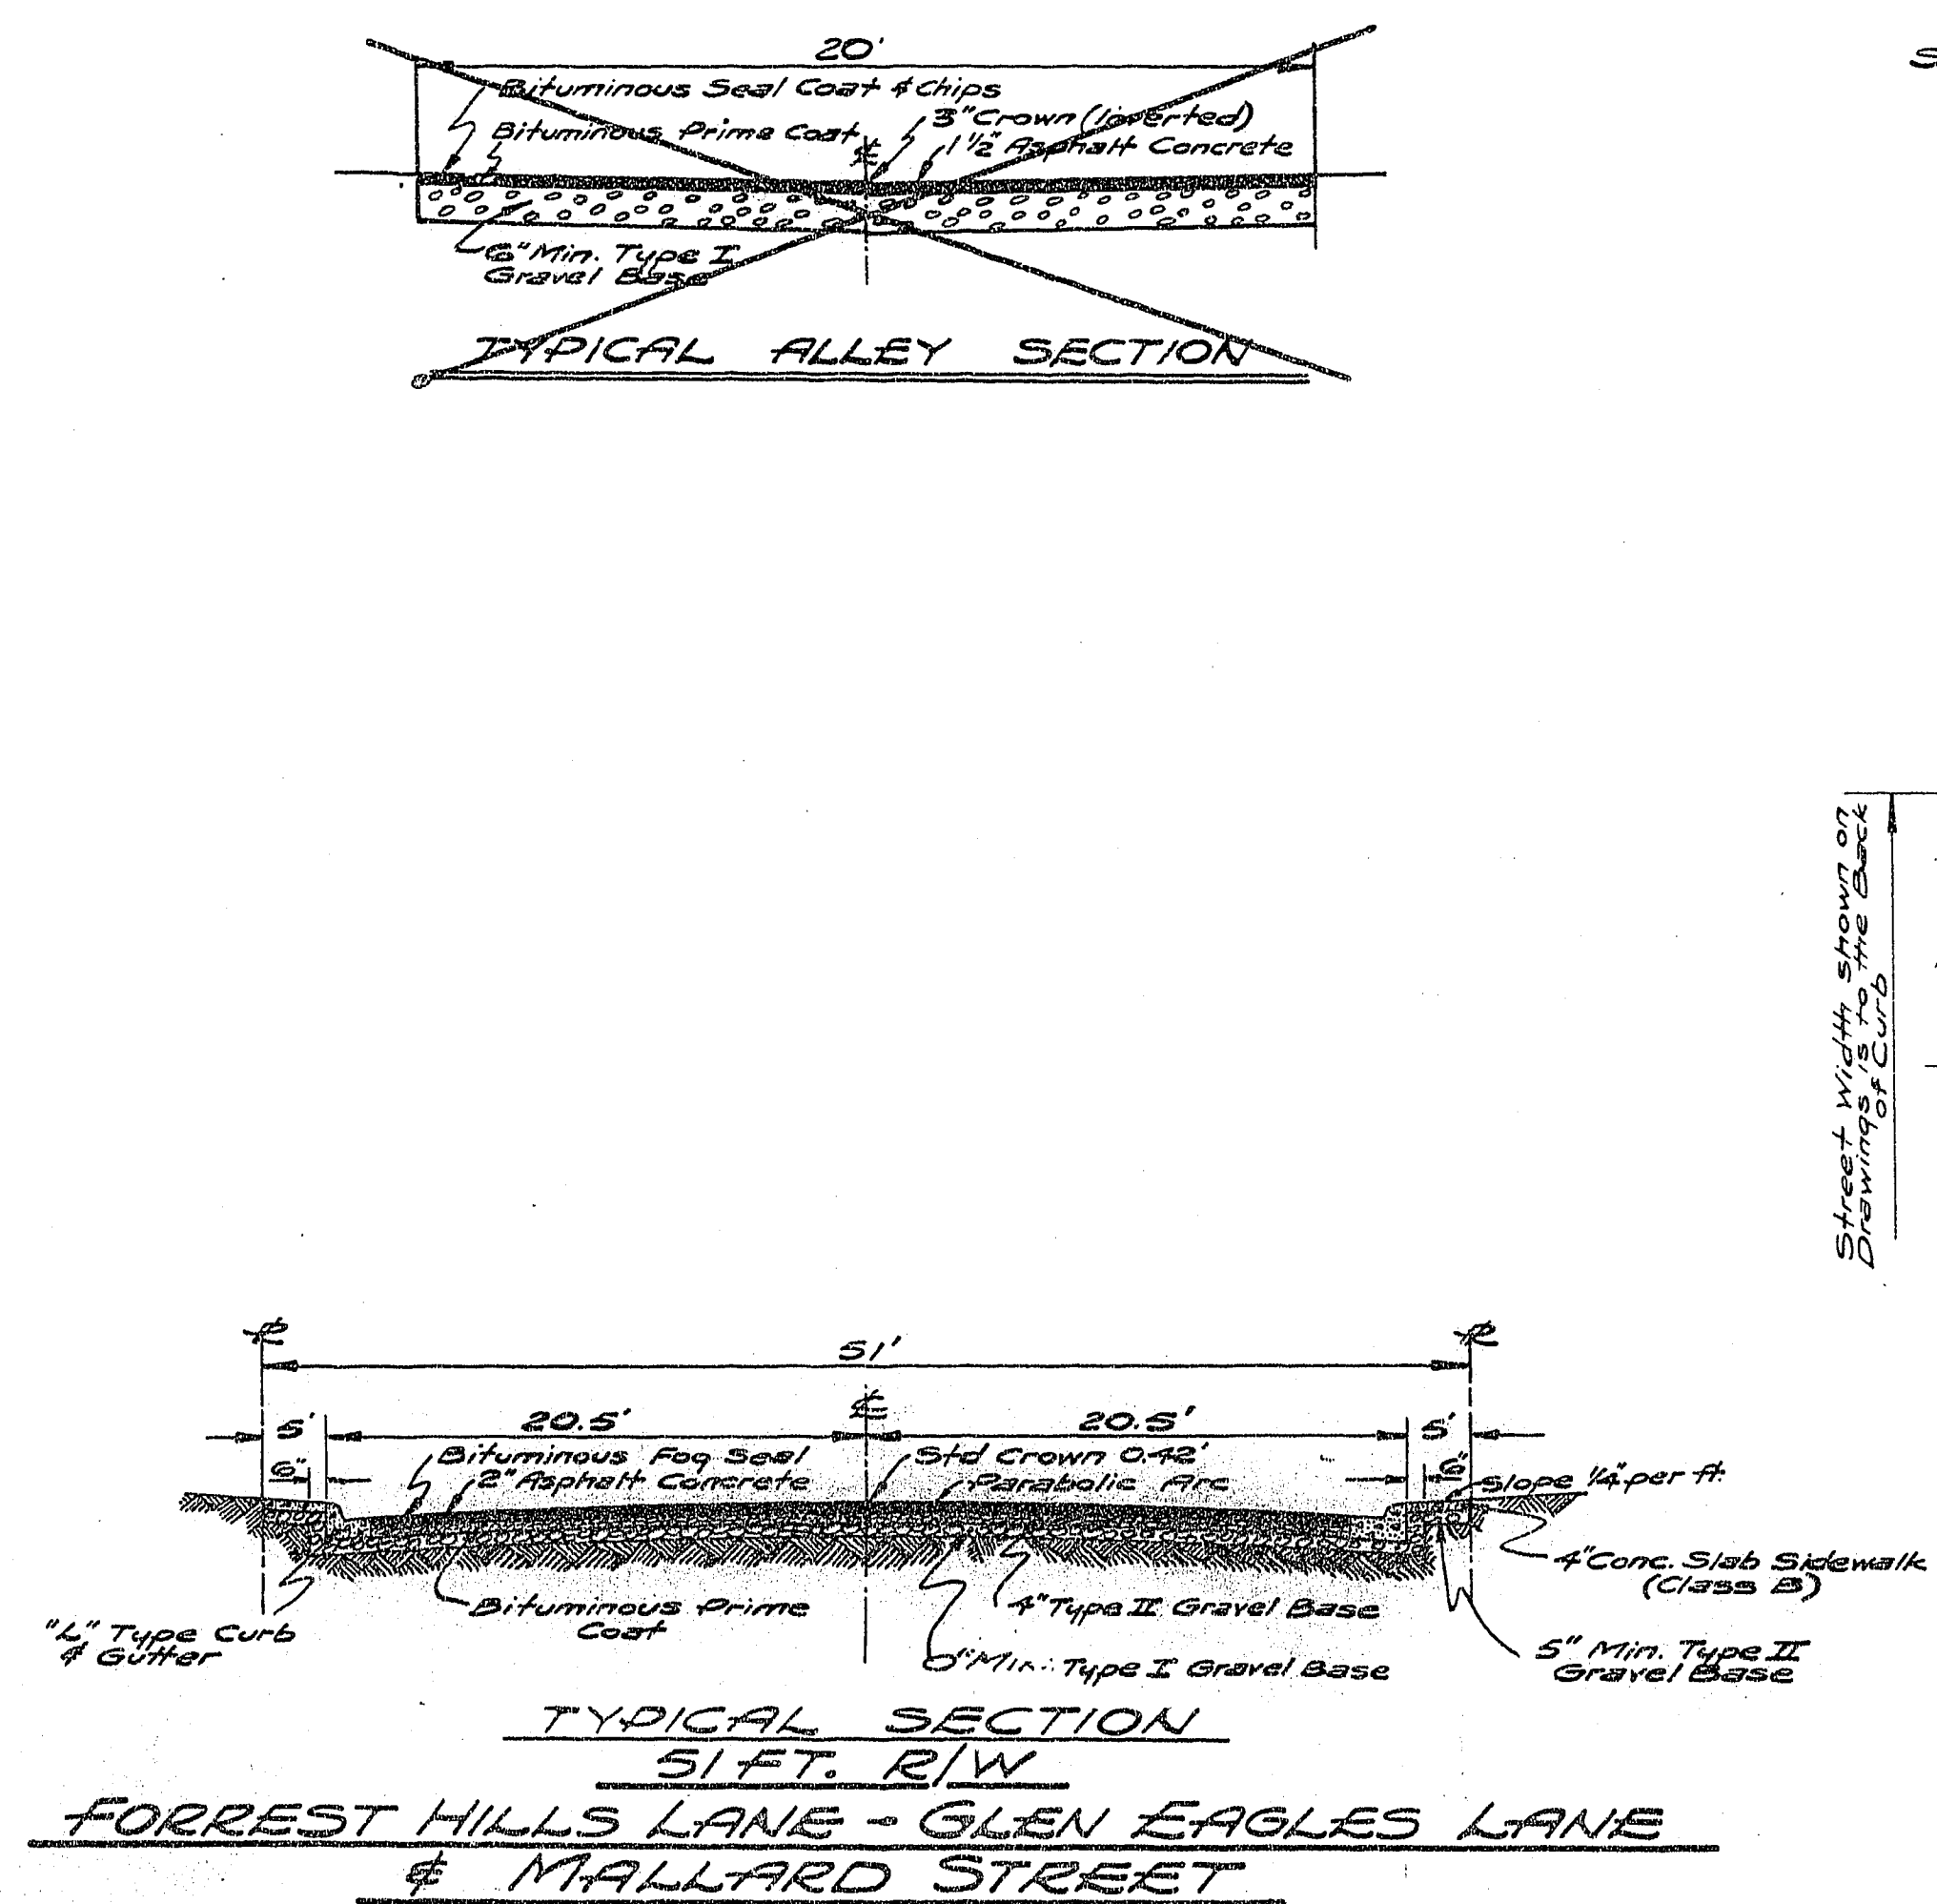
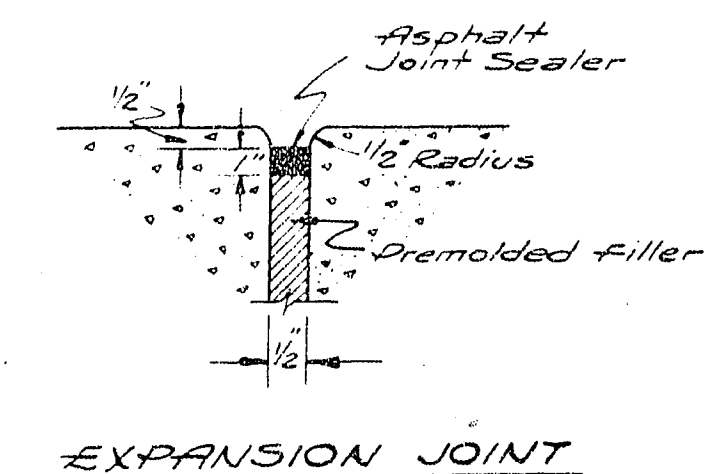
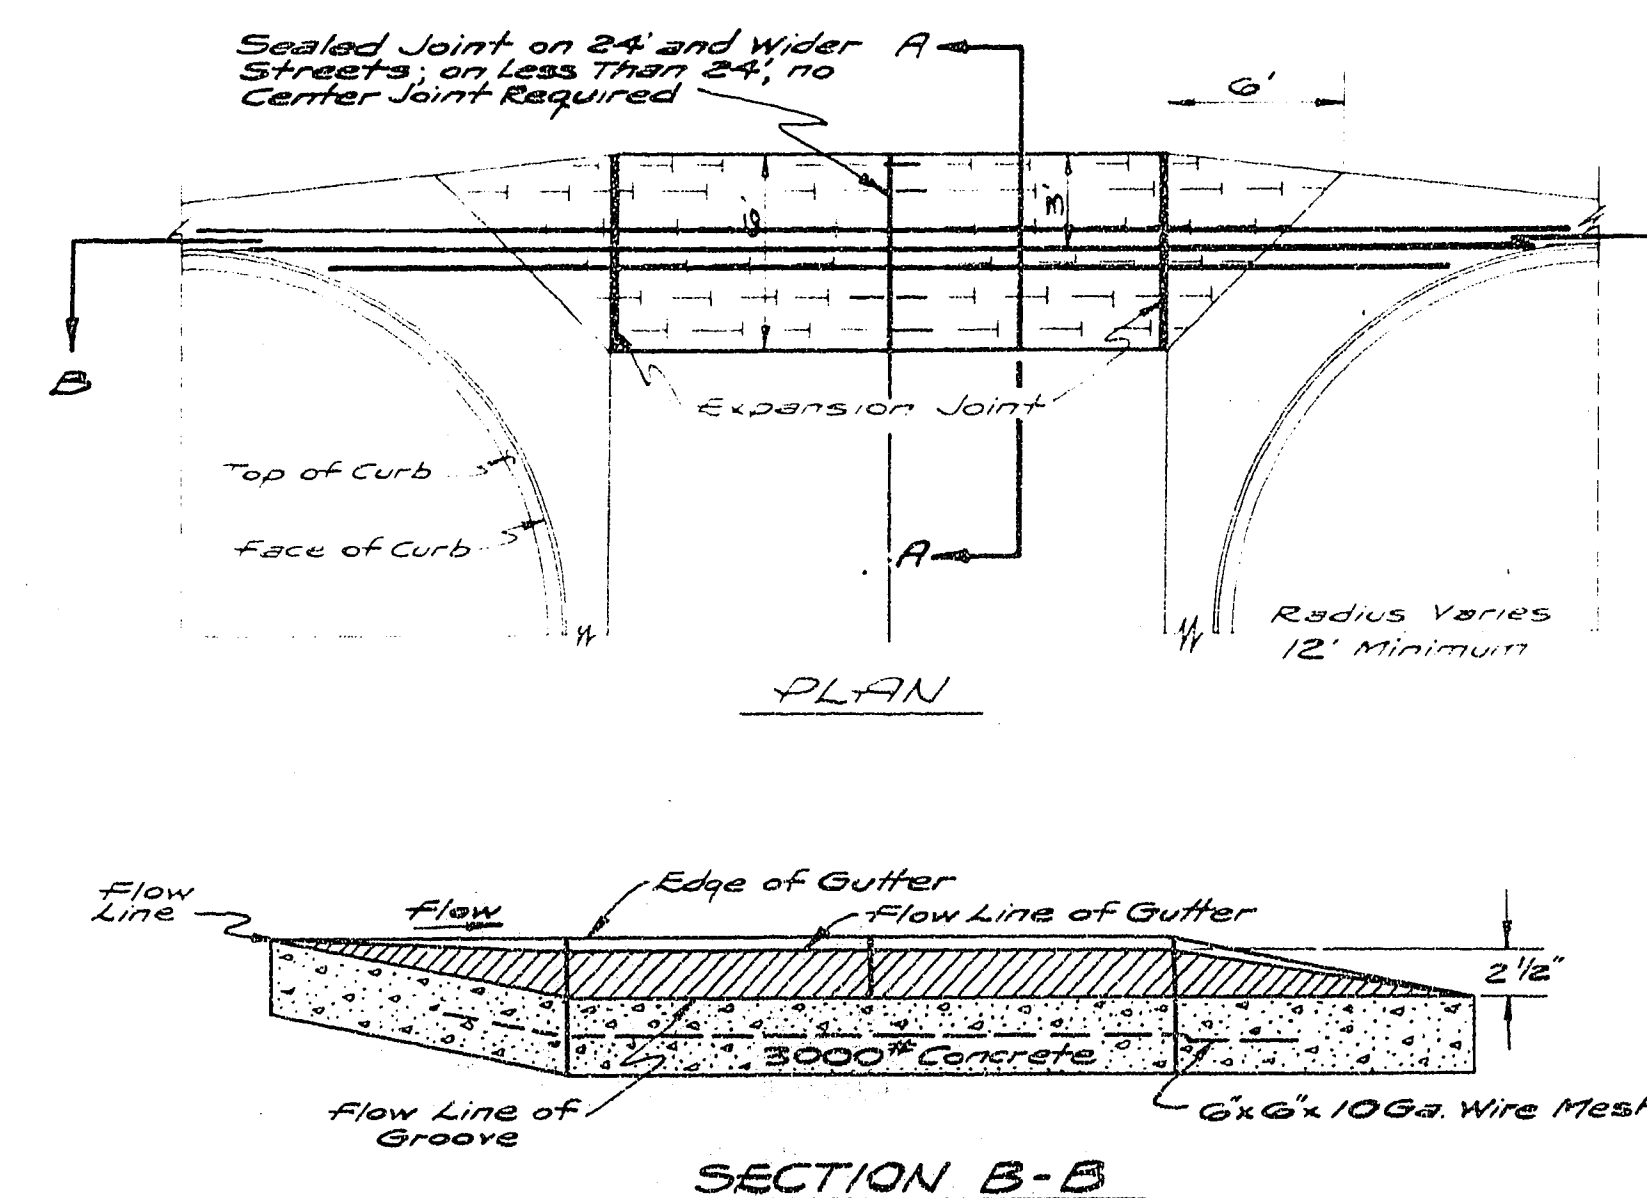
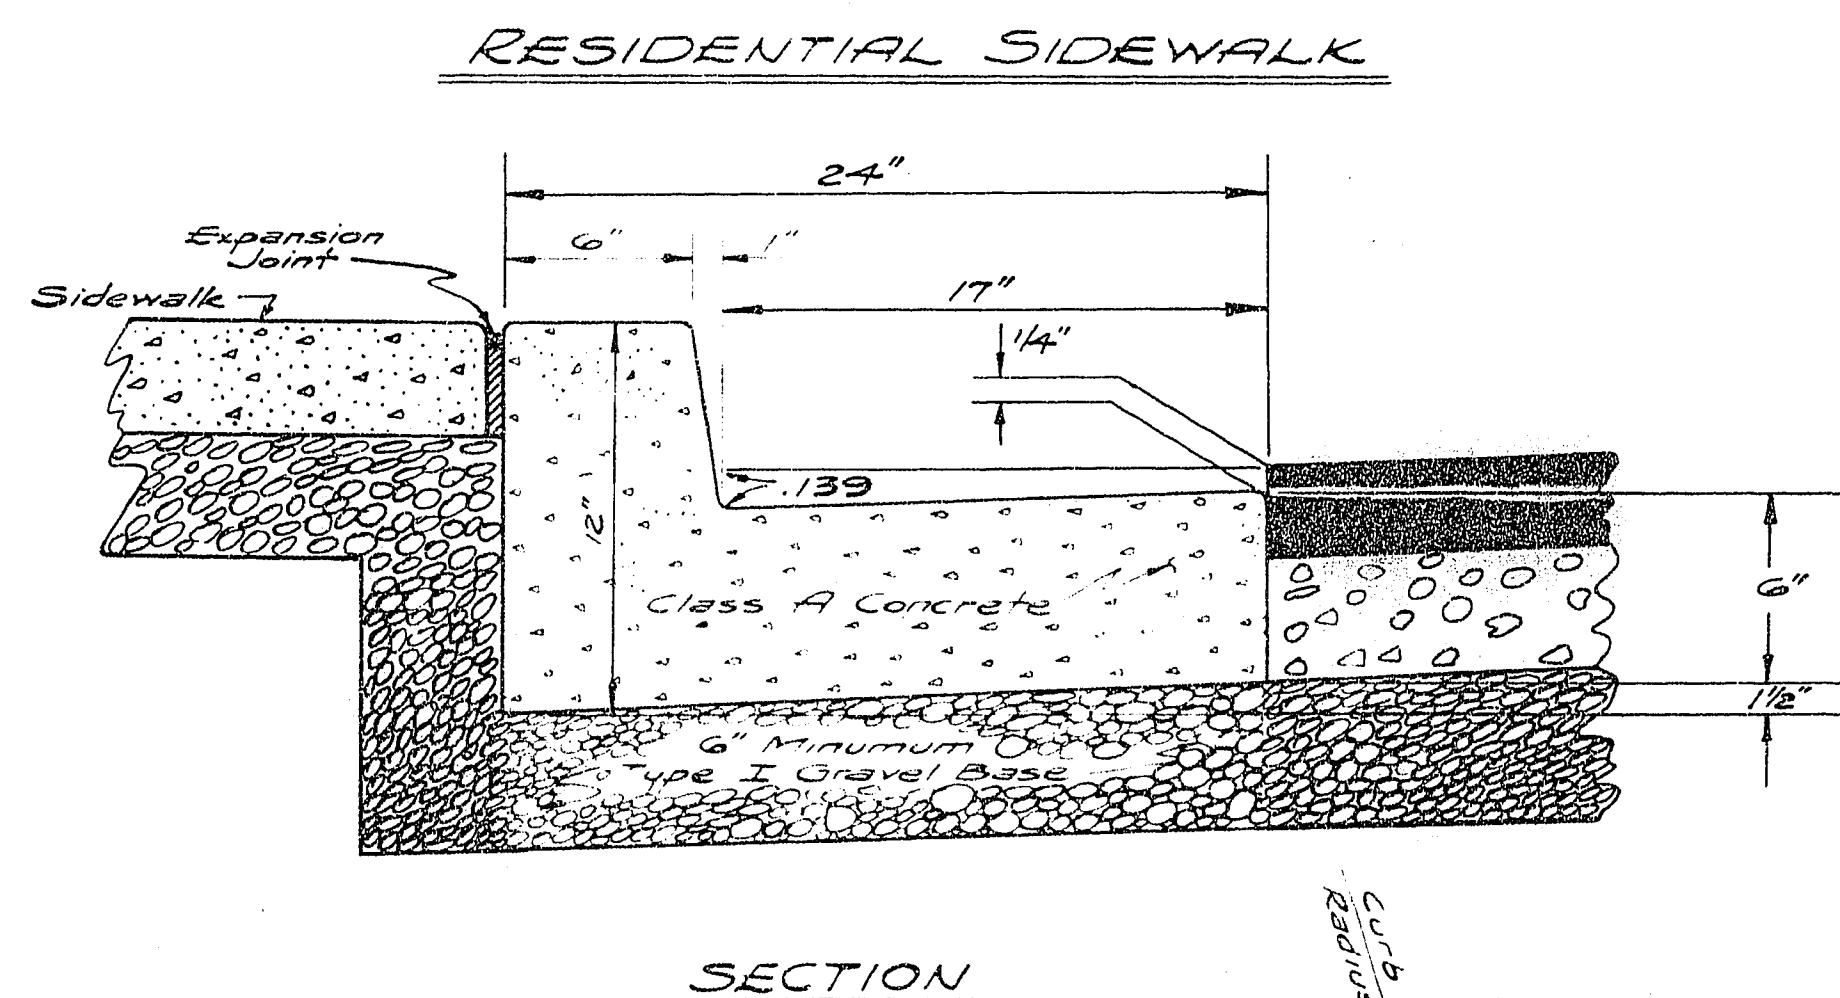
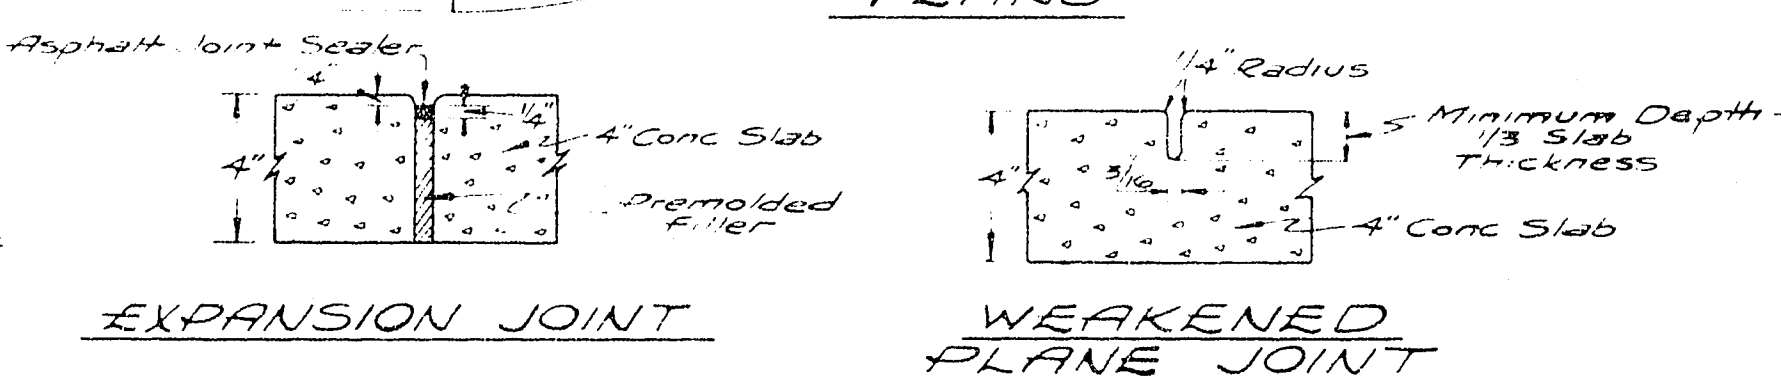
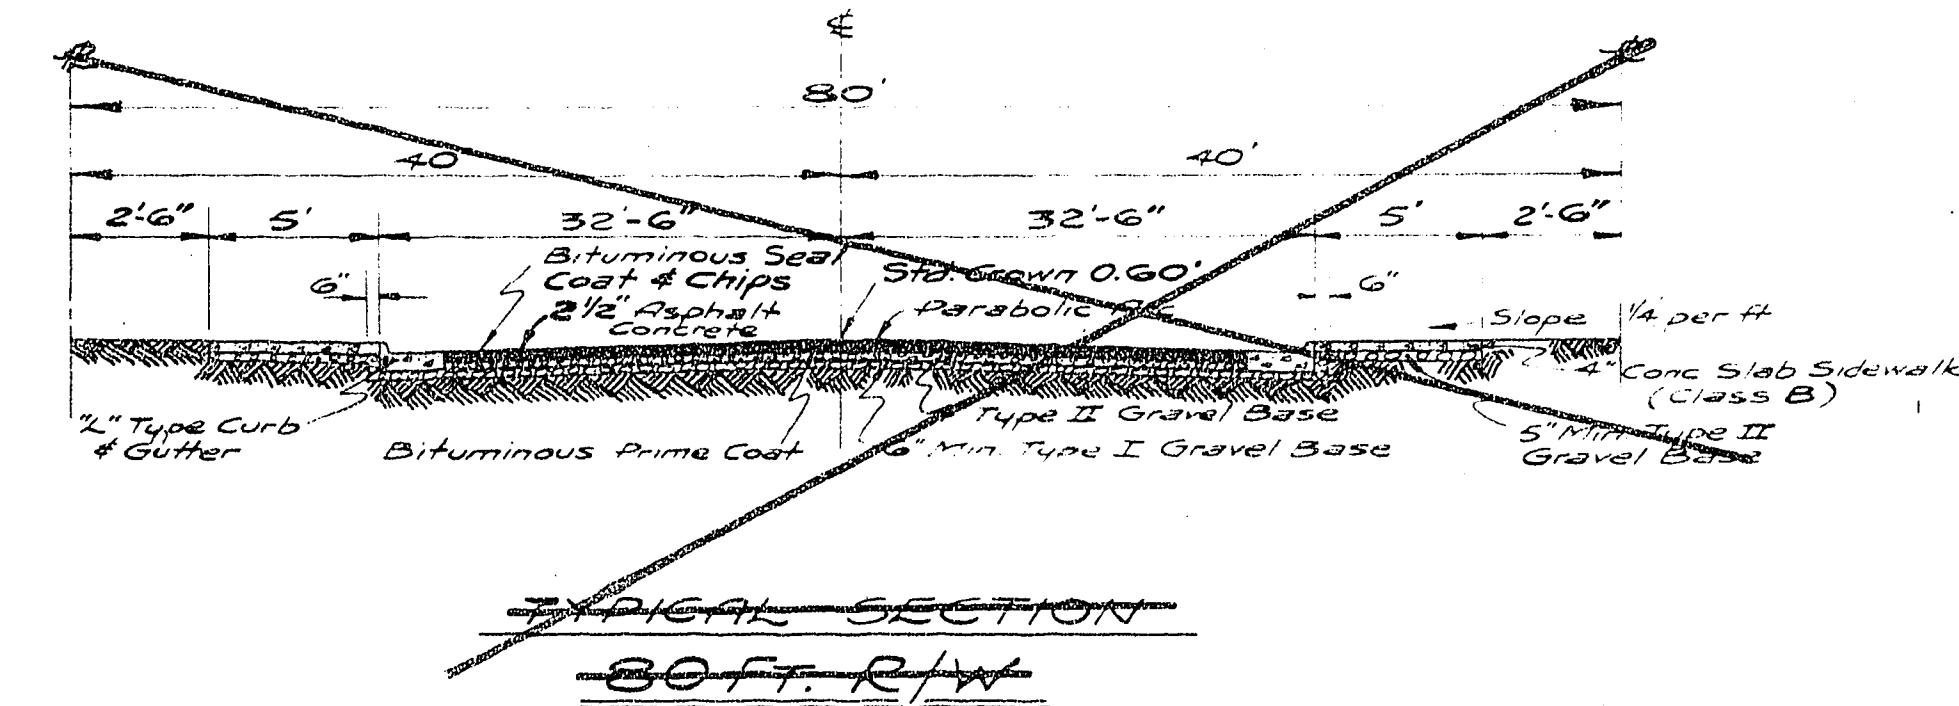
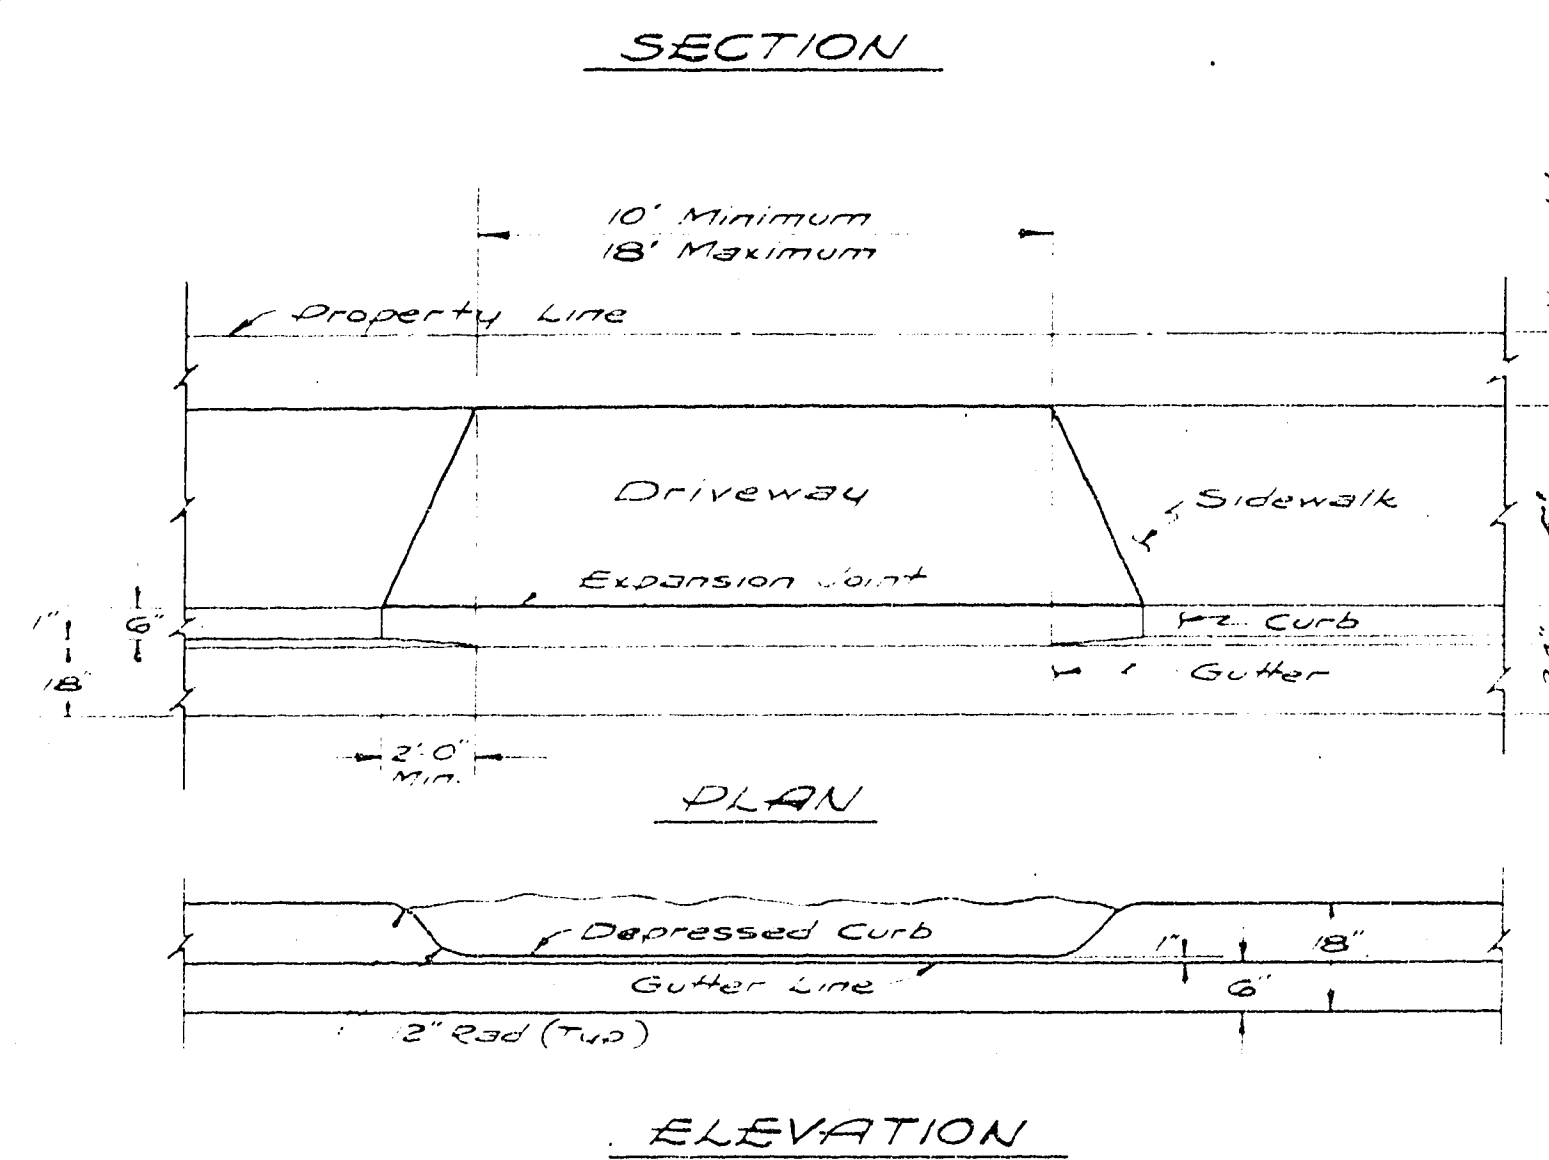
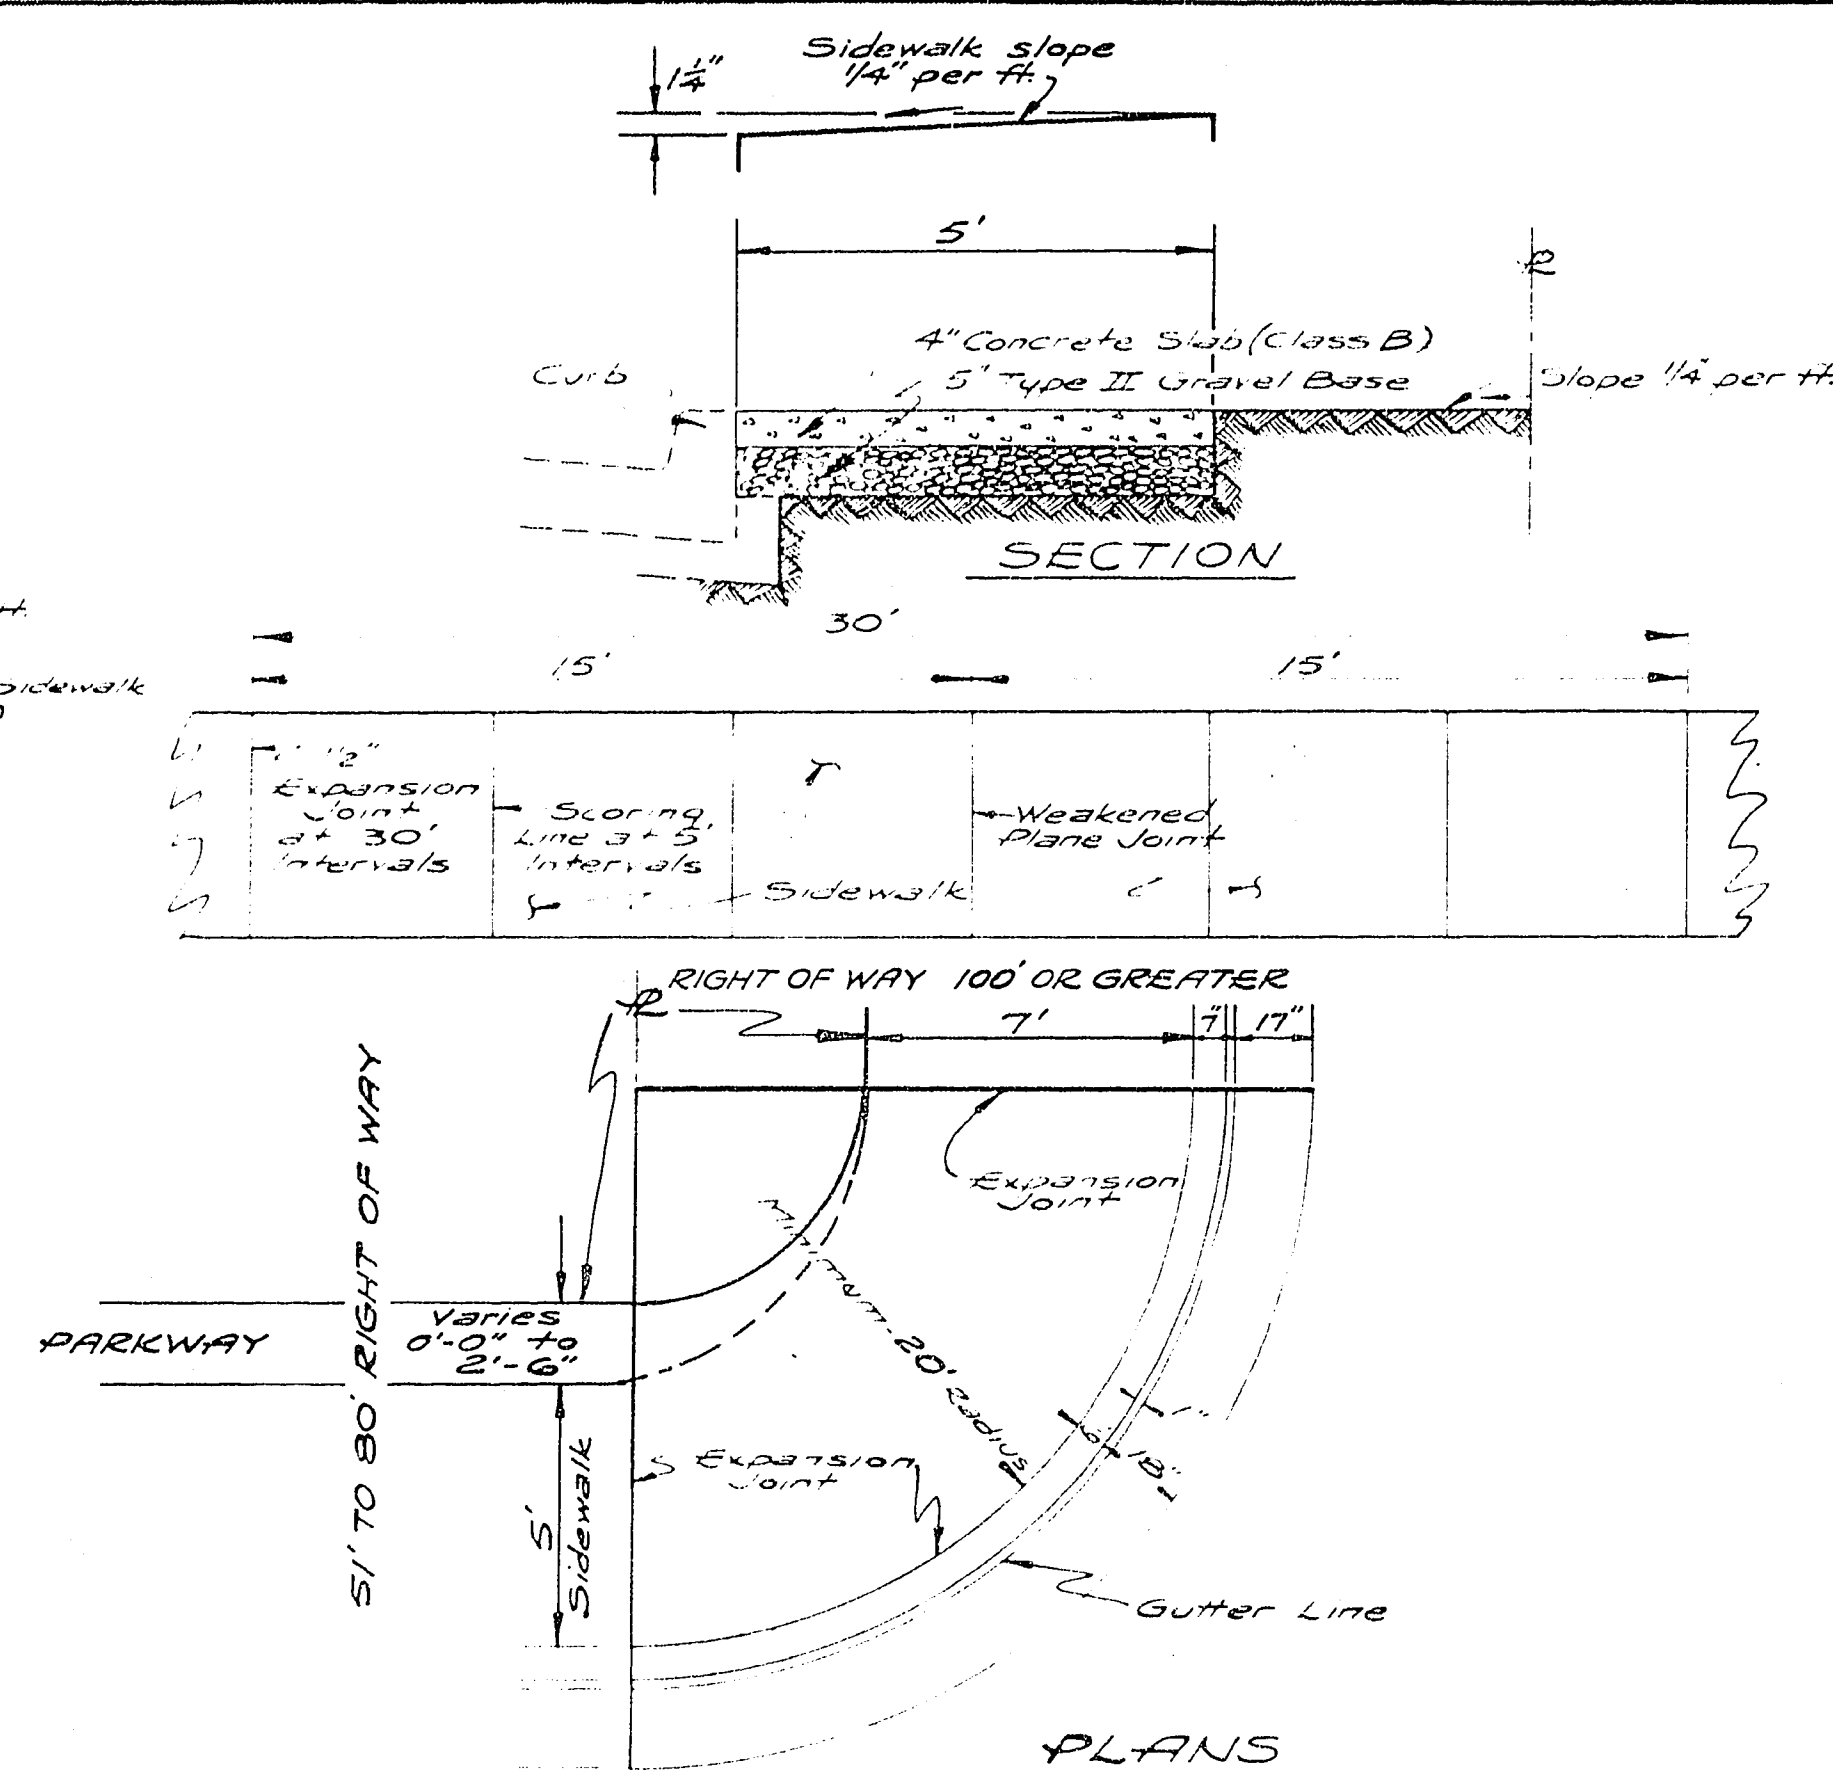


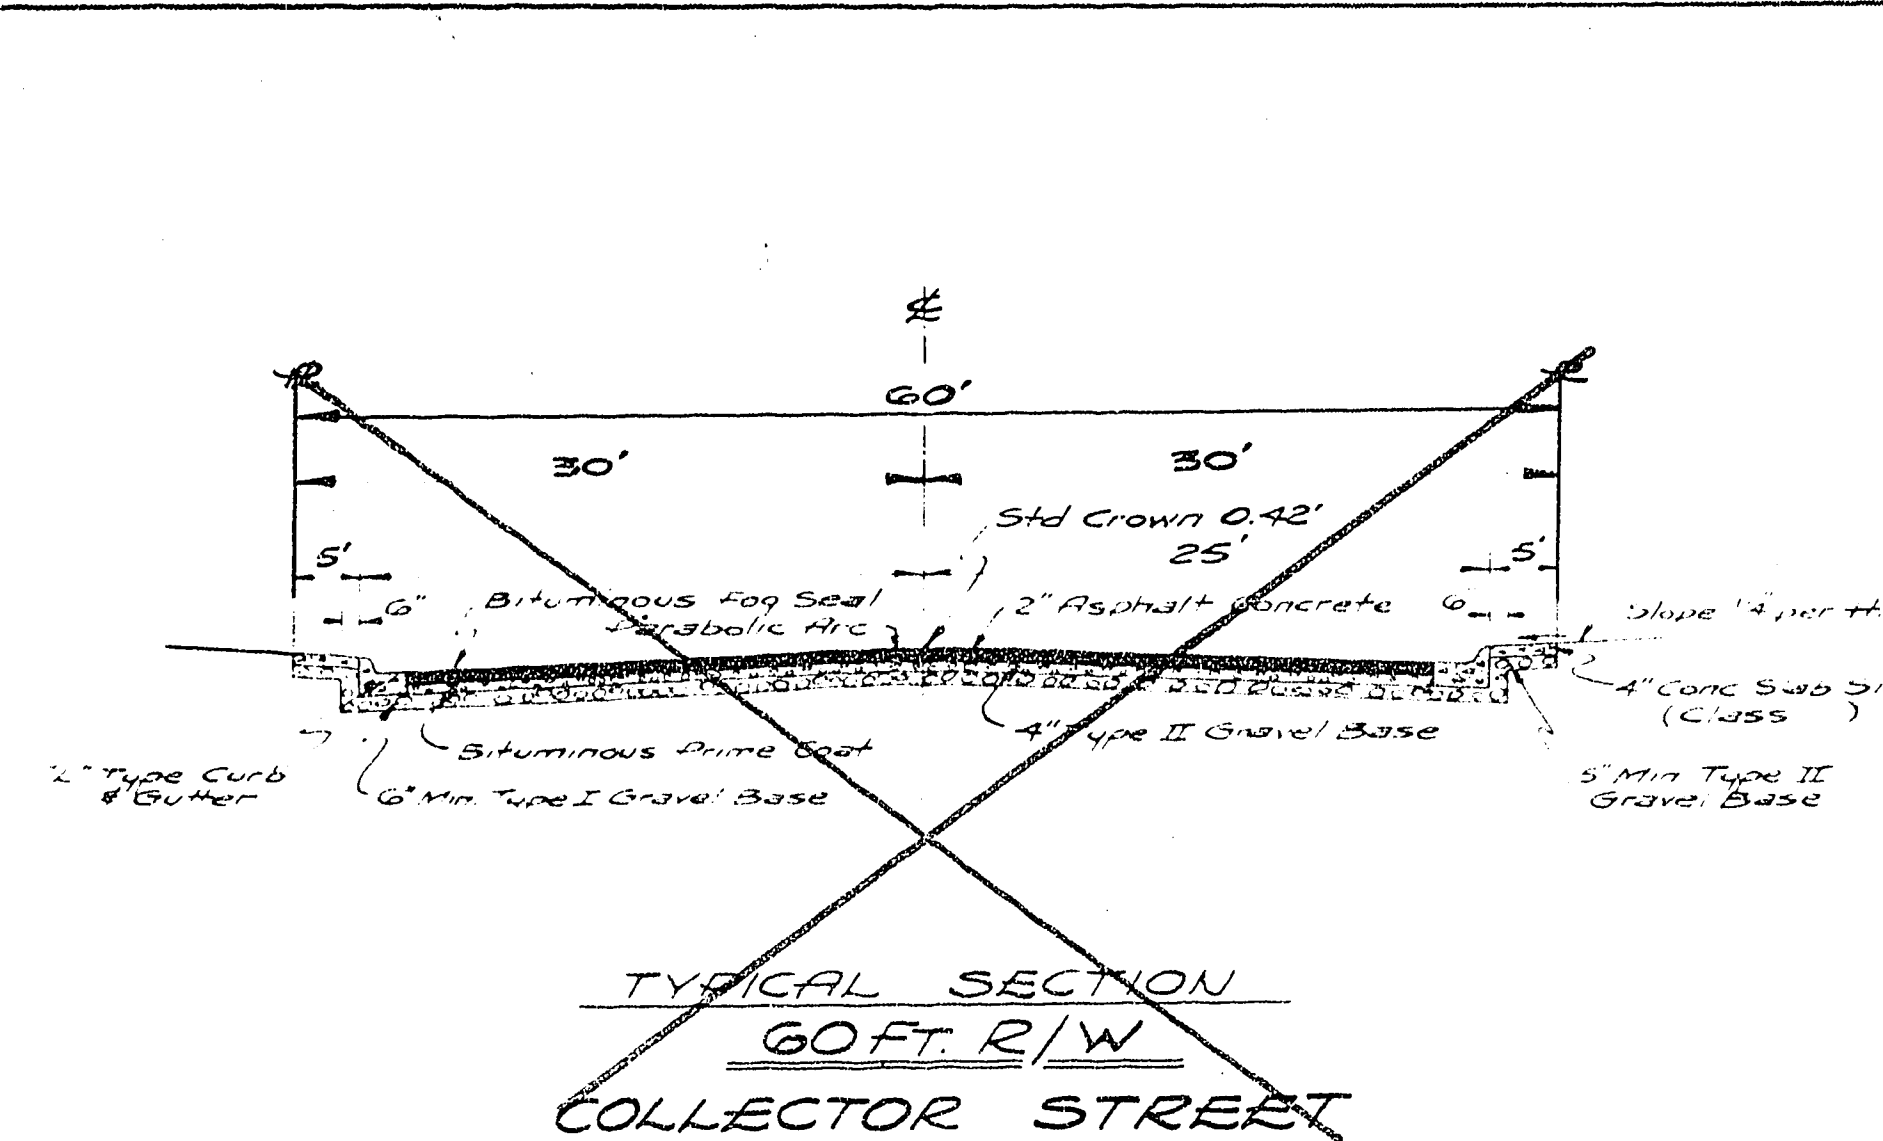

NOTES

All street construction shall be done in accordance with the requirements and specifications of the City of Las Vegas.

This drawing has no scale.

APPROVALS

R. P. Jones 2-6-63
City Engineer Date

James M. Smith 1-15-63
Field Engineer Date

DESIGNED			WESTERN ENGINEERS, INC.			SHEET		
DRAWN			LAS VEGAS			2		
CHECKED			APPROVED			DATE 1-15-63		
						OF		
						2		

