


WATER DISTRIBUTION PLAN

Las Vegas City Limits

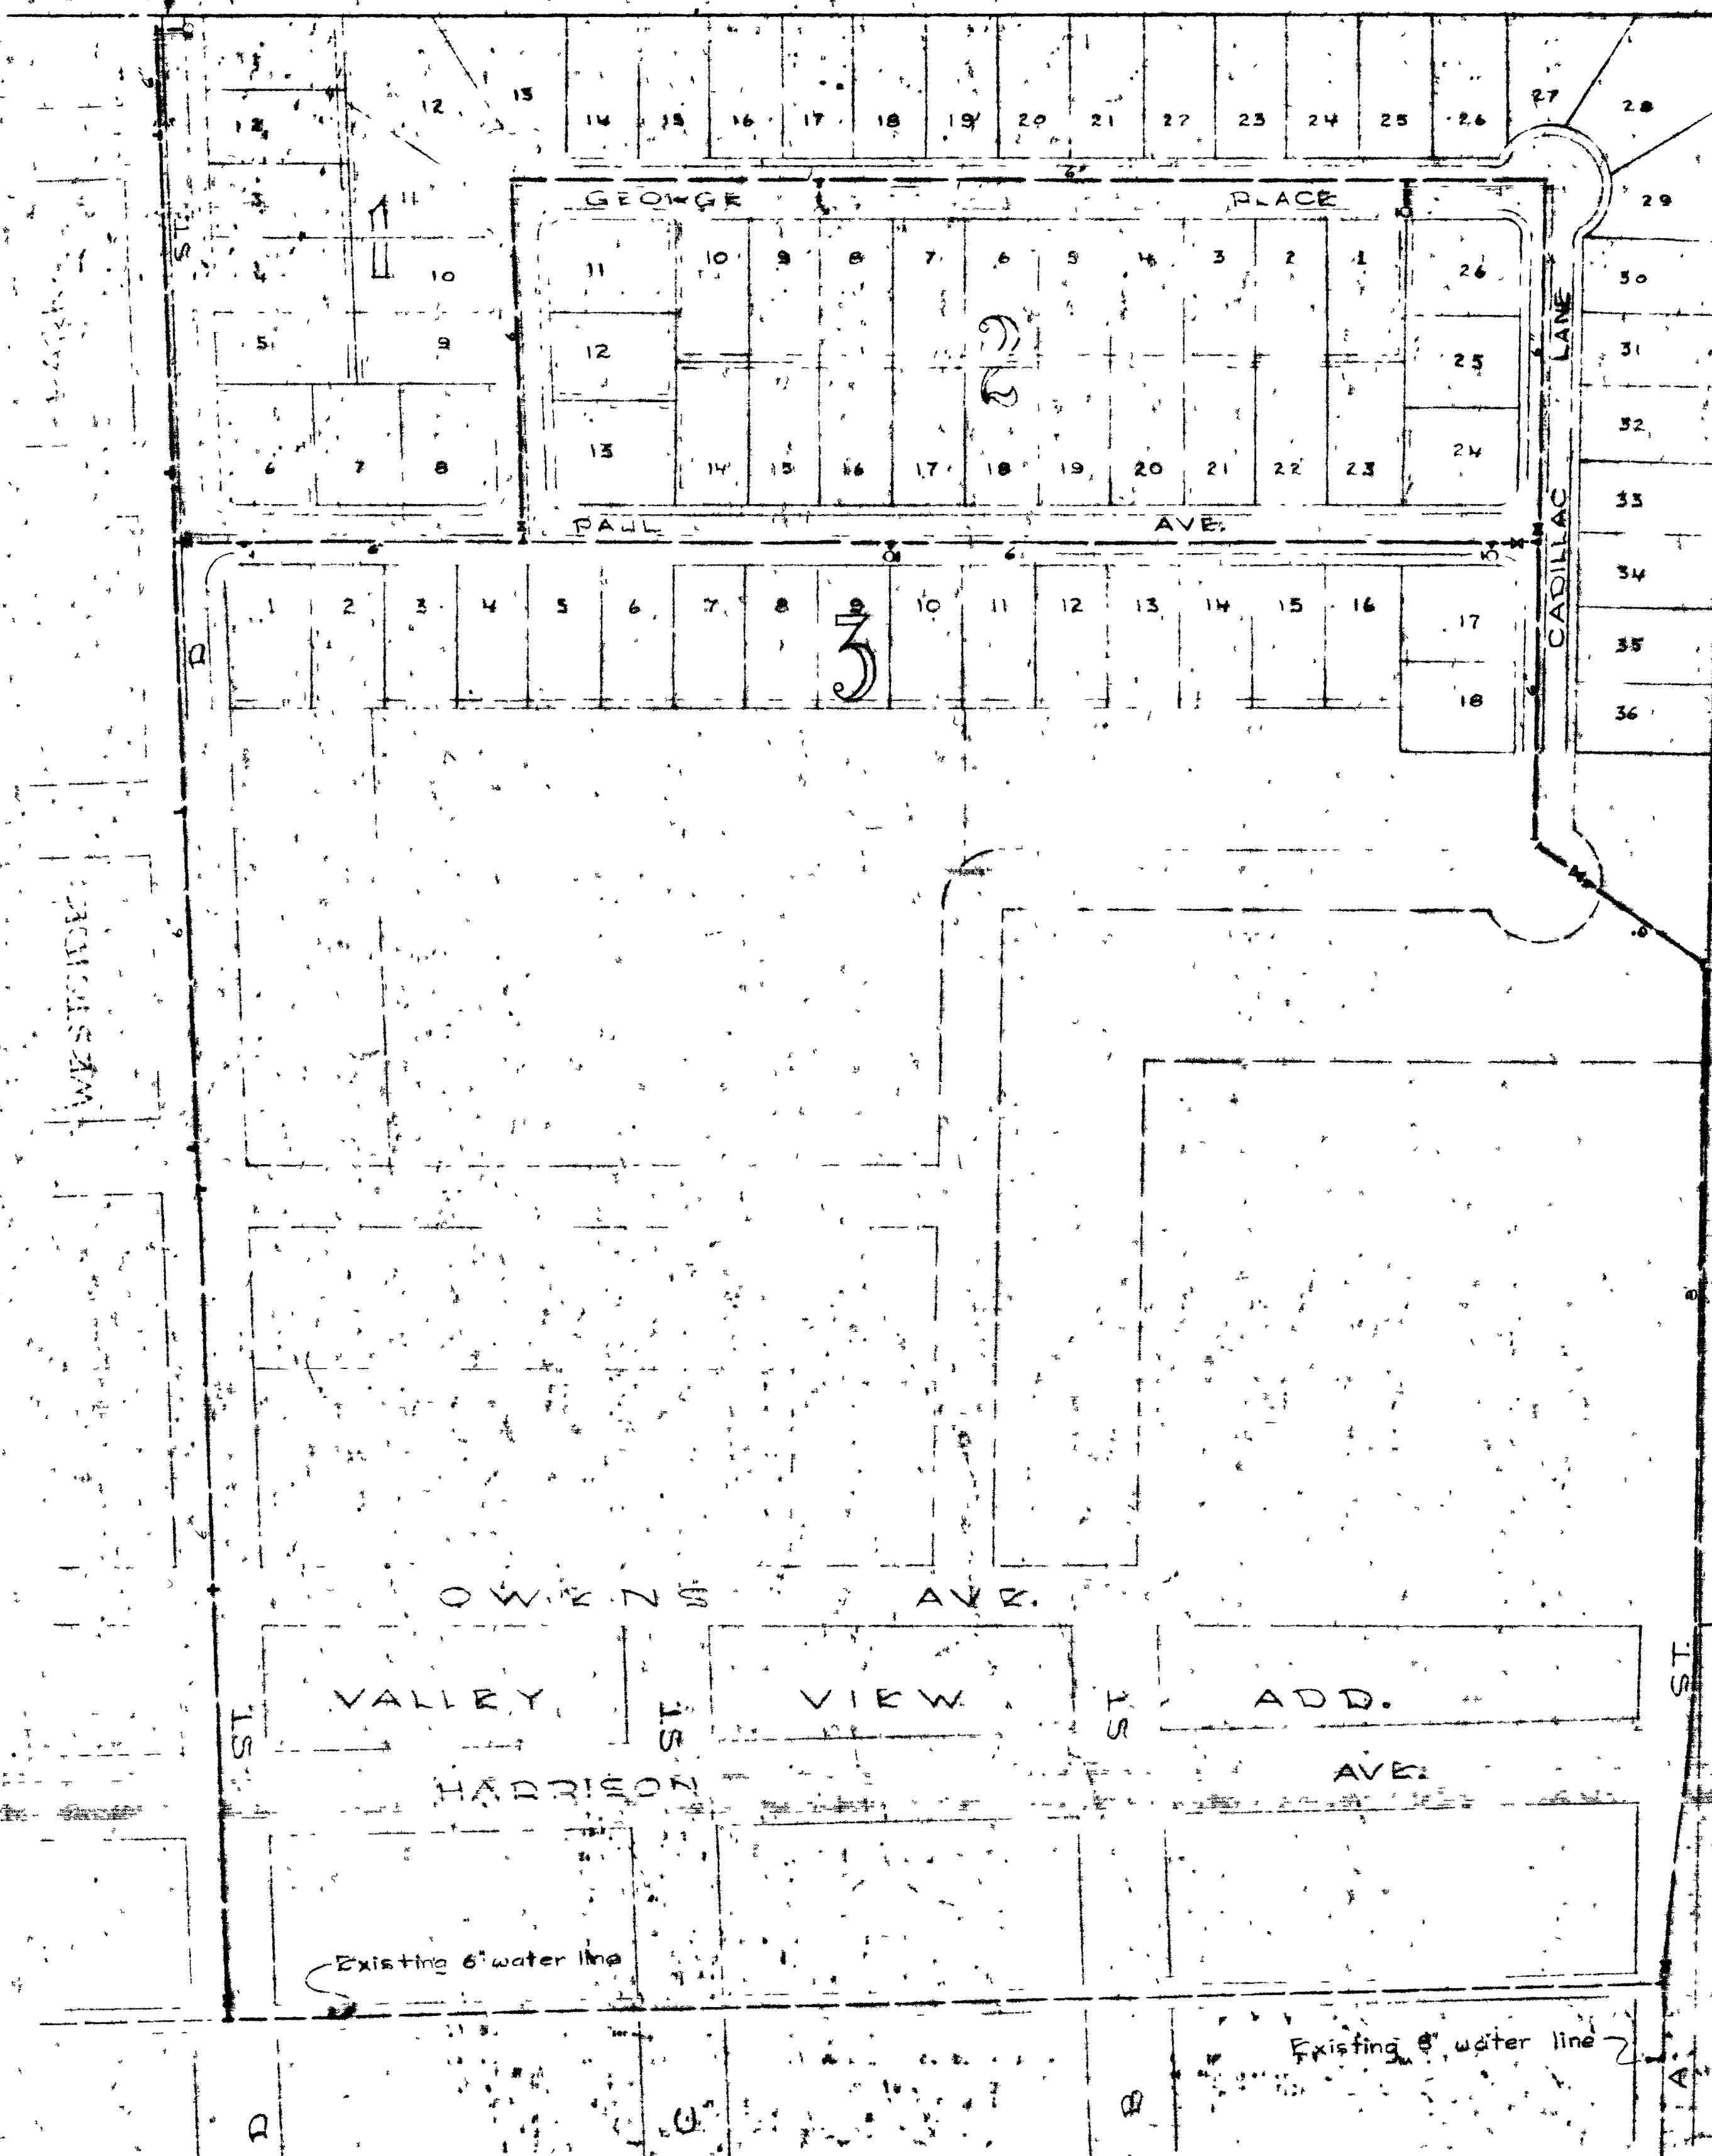


- LEGEND**
- Cast iron pipe, 12\"/>

Scale in Feet

- LEGEND**
- ✱ Indicates Street Light

NOTE
Construction shall be in accordance with proposed City of Las Vegas Standard Specifications for Residential Street Lighting dated November 3, 1952.

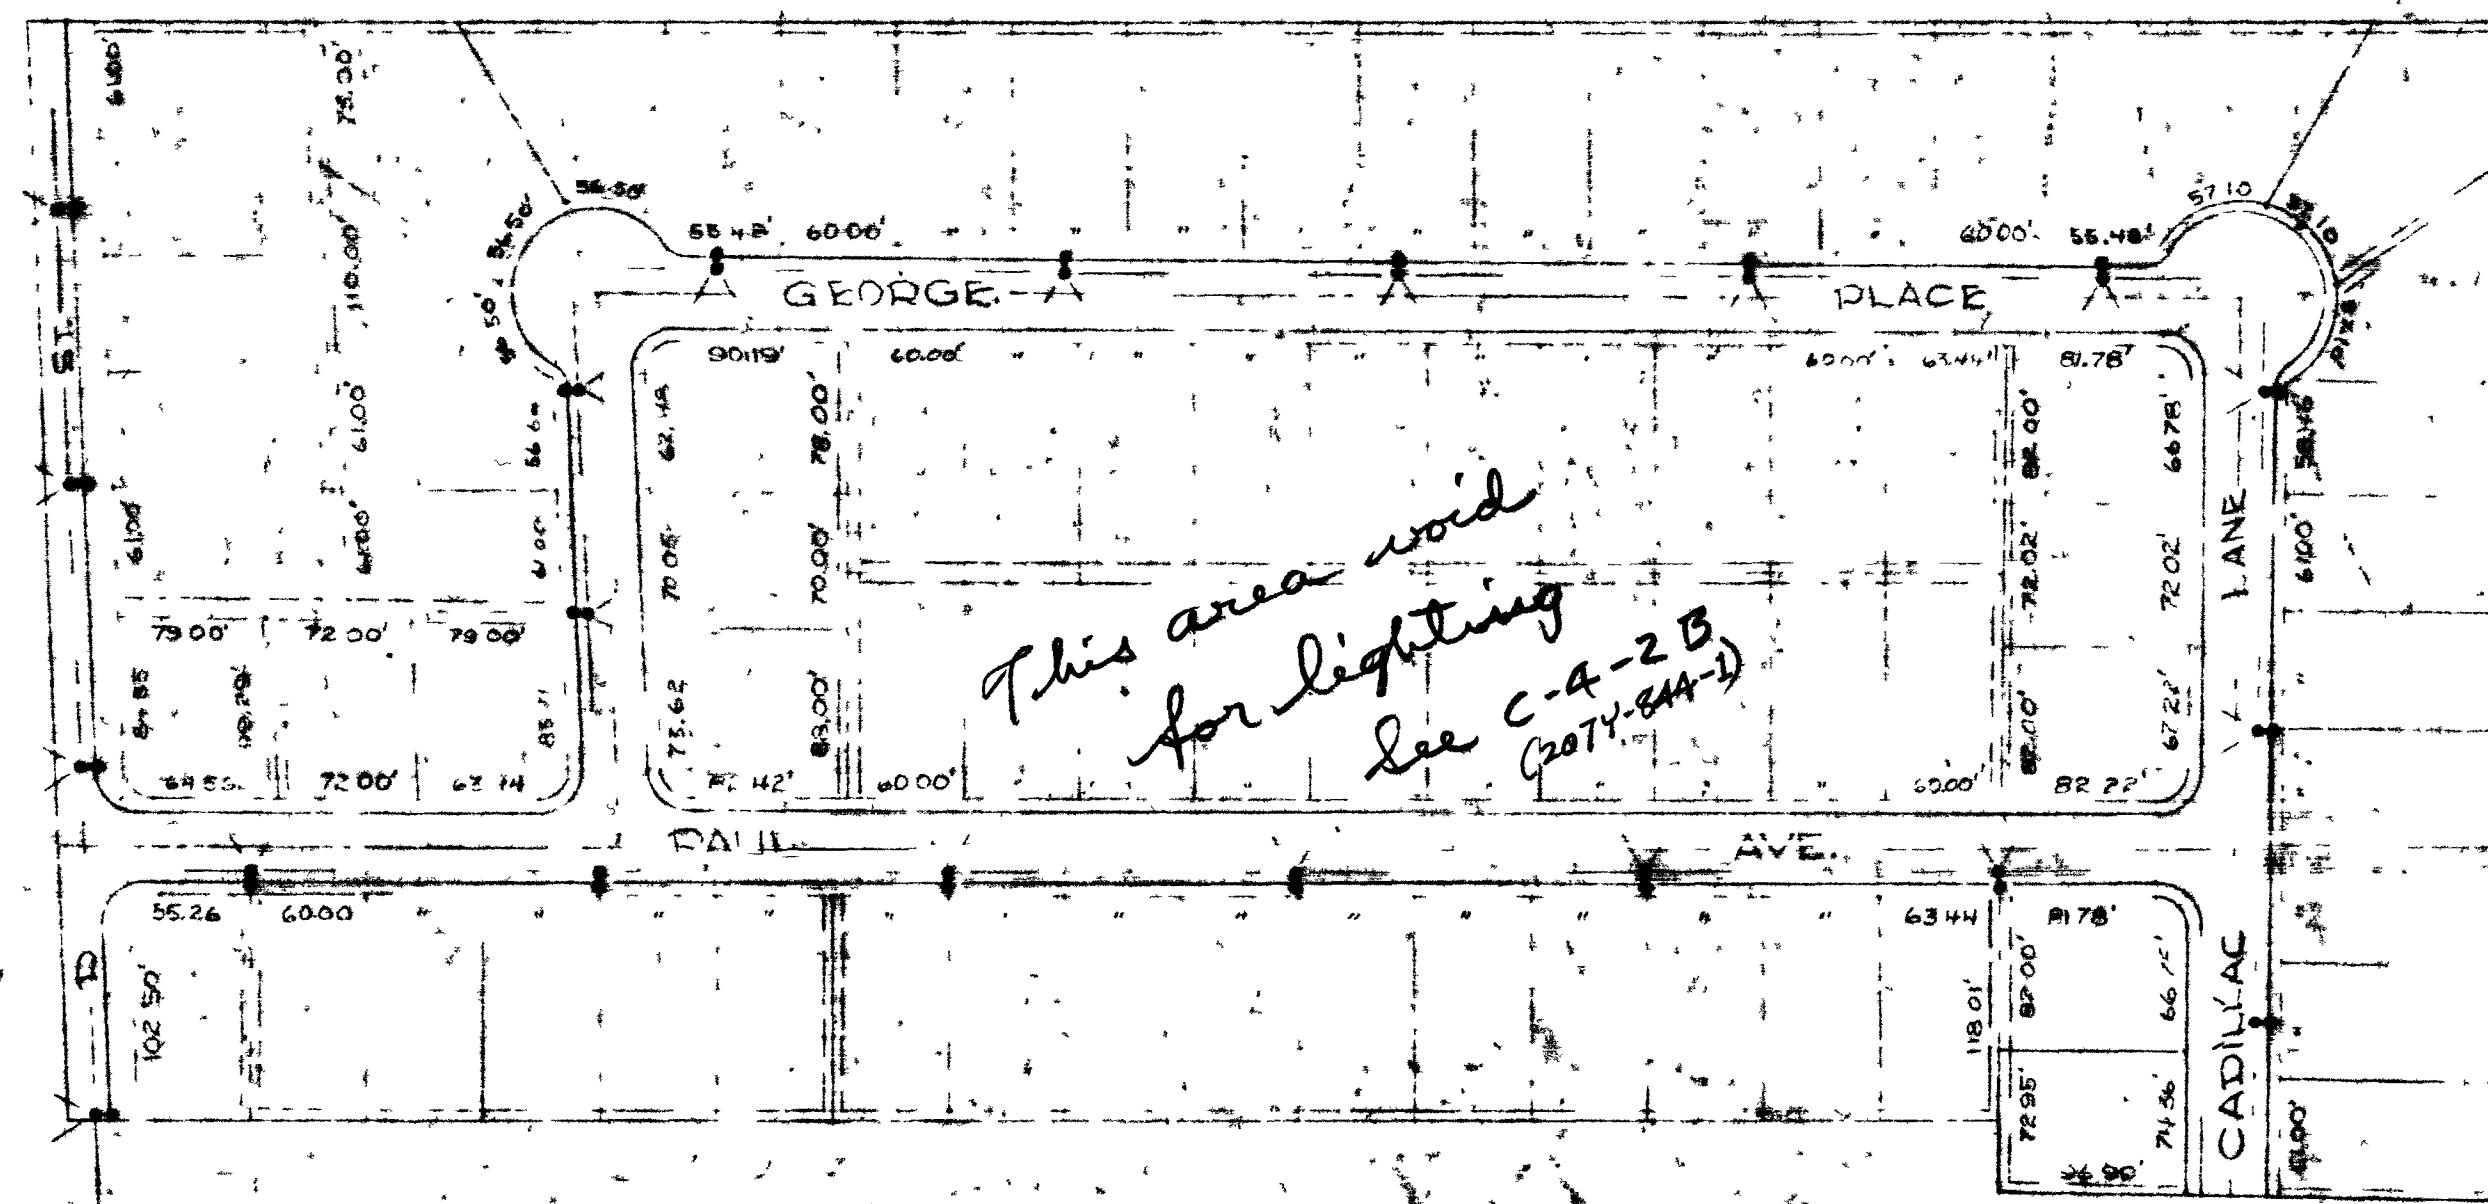

STREET LIGHTING PLAN

C-15-23

CONS. ENG. HARLAN BROWN REG. NEV. NO. 208 LAS VEGAS, NEVADA

Utility Plans of Cadillac Arms Tract 1

SHEET 5

567Y-1010-1

22-6-121

WATER DISTRIBUTION PLAN

Las Vegas City Limits









Las Vegas City Limits

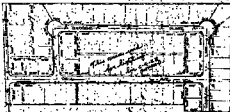

STREET LIGHTING PLAN




