


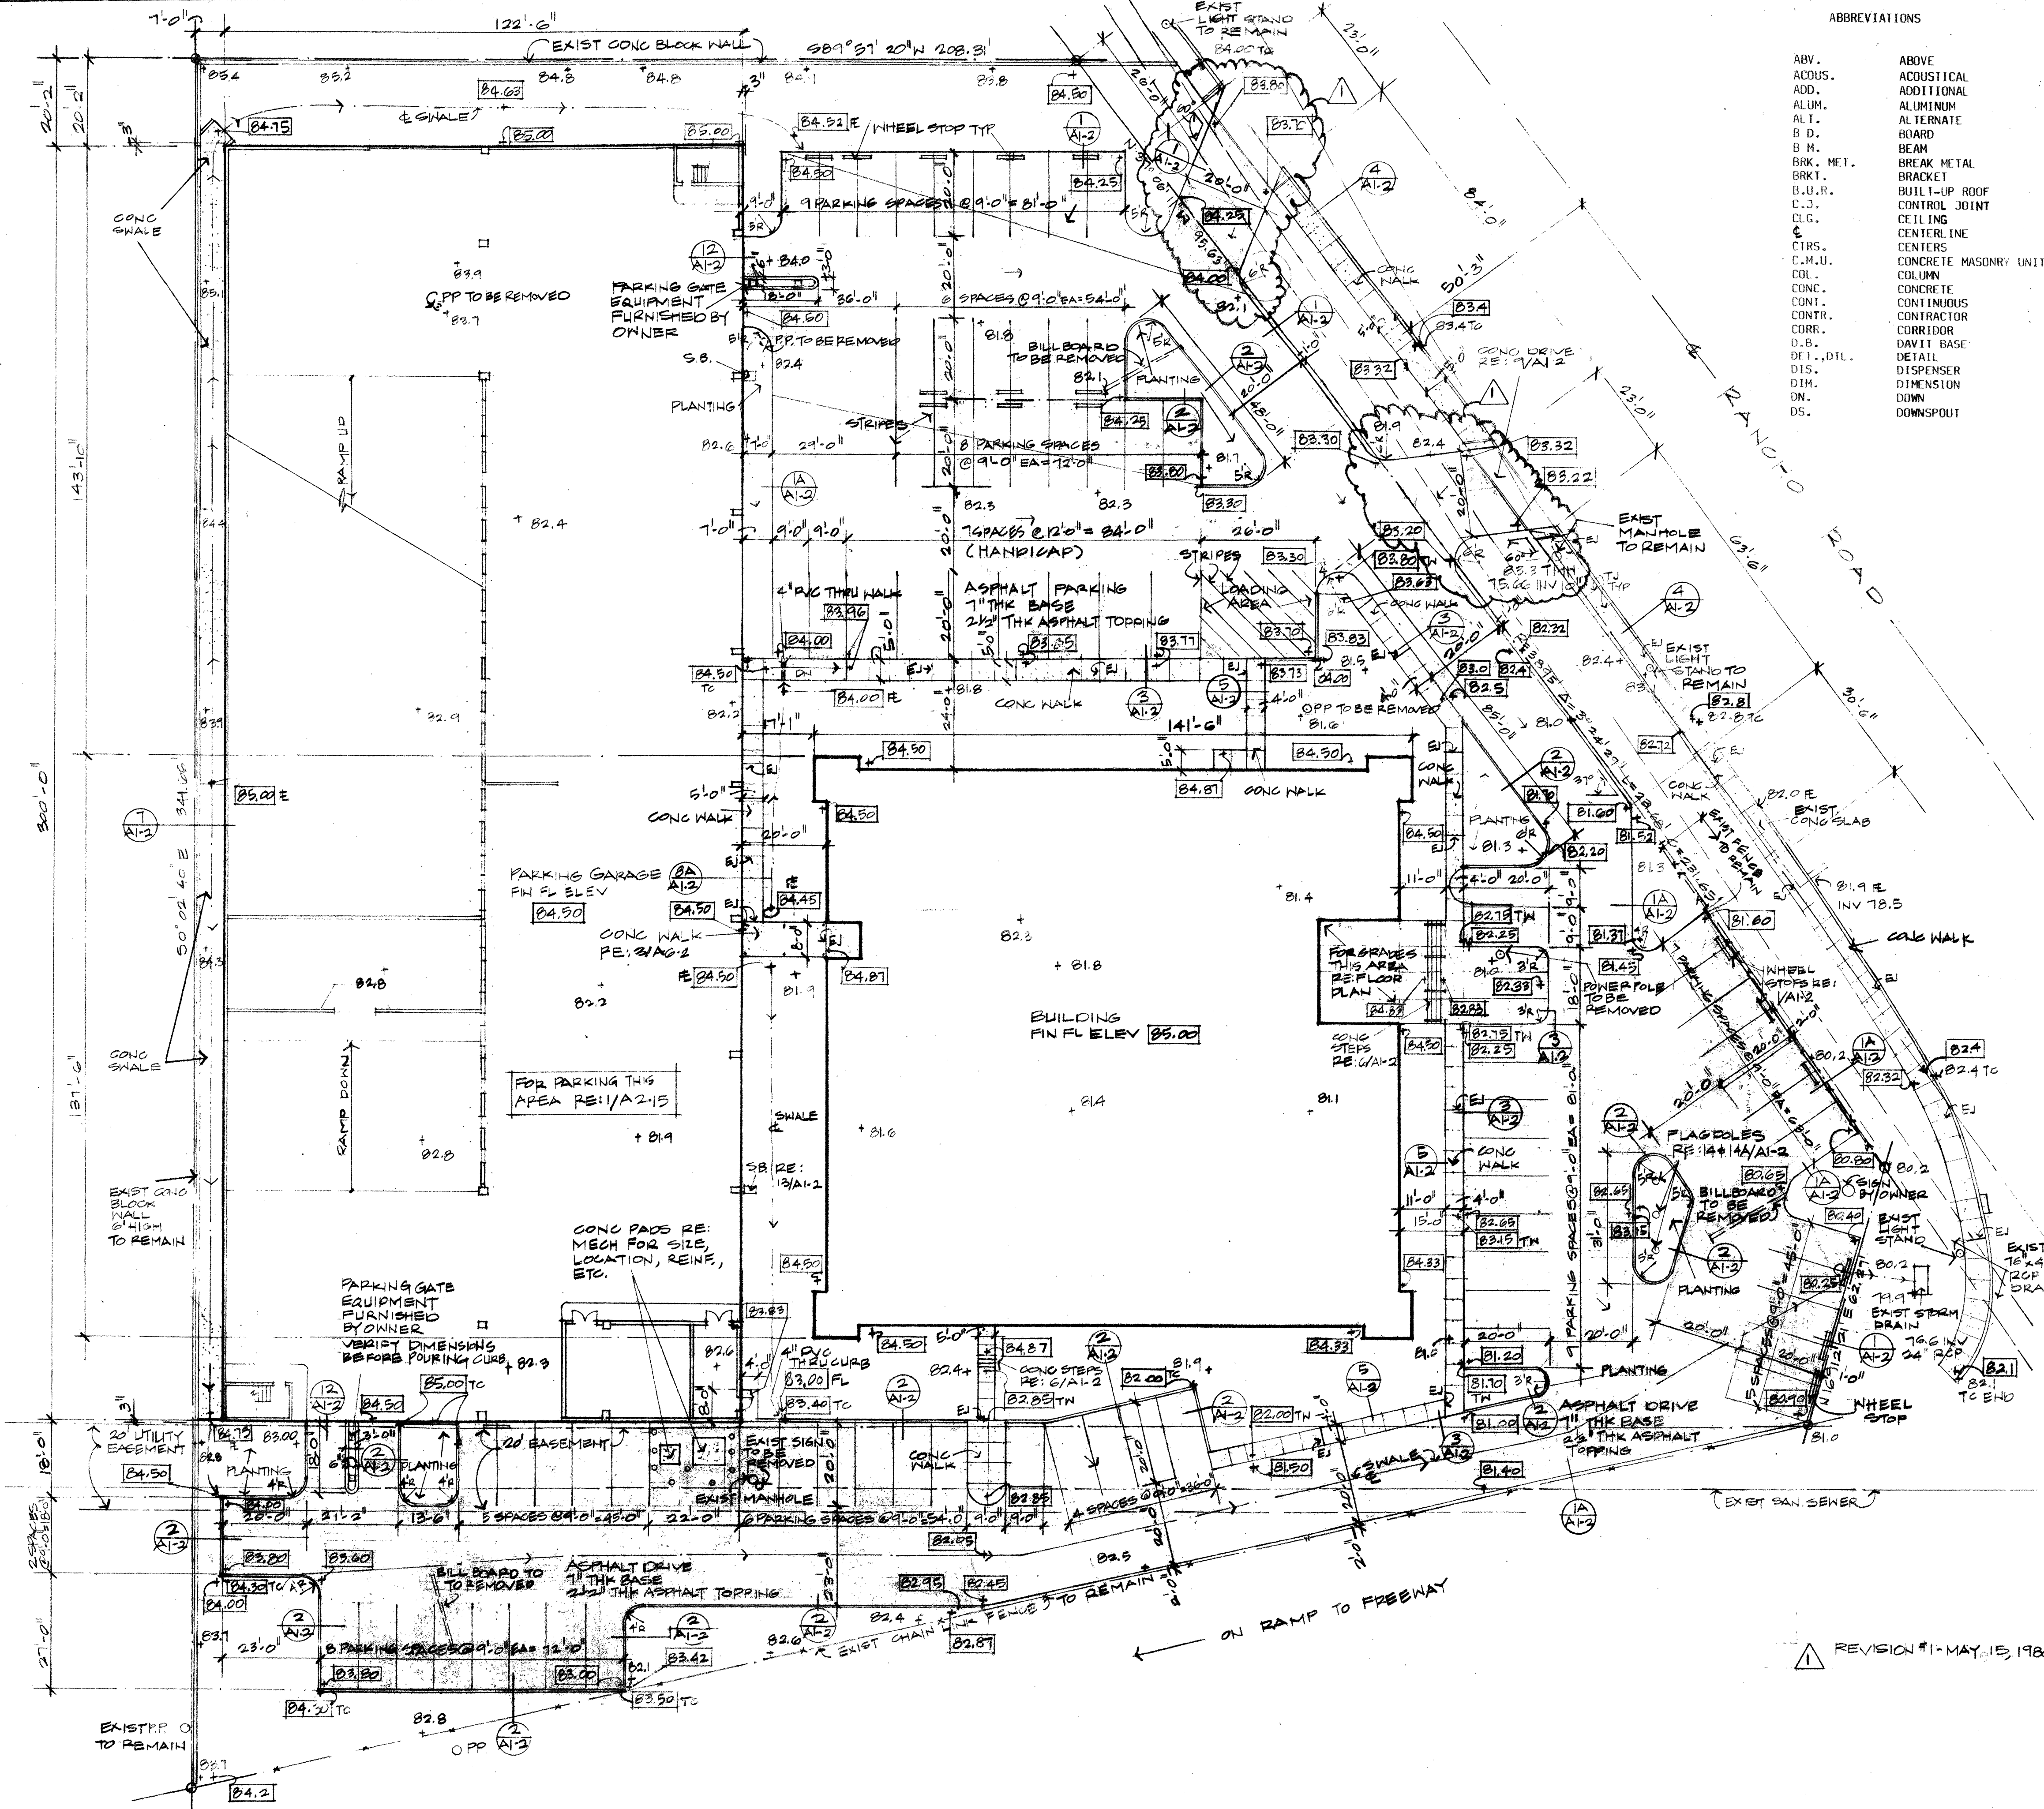

ABBREVIATIONS


ABV.	ABOVE	EA.	EACH
ACOUS.	ACUSTICAL	EXP. JT., E.J.	EXPANSION JOINT
ADD.	ADDITIONAL	ELEC.	ELECTRICAL
ALUM.	ALUMINUM	ELEV.	ELEVATOR
ALT.	ALTERNATE	EQ.	EQUAL
B.D.	BOARD	E.W.C.	ELECTRIC WATER COOLER
B.M.	BEAM	EXIST.	EXISTING
BRK. MET.	BREAK METAL	EXT.	EXTERIOR
BRKT.	BRACKET	F.D.	FLOOR DRAIN
B.U.R.	BUILT-UP ROOF	F.H.C.	FIRE HOSE CABINET
C.J.	CONTROL JOINT	FIN.	FINISH
CLG.	CEILING	FIN.F.L., F.F.	FINISH FLOOR
C.L.	CENTERLINE	FL.	FLOOR
CIRS.	CENTERS	FL.M.	FLOOR LINE
C.M.U.	CONCRETE MASONRY UNIT	FLASH'G.	FLASHING
COL.	COLUMN	GA.	GAUGE
CONC.	CONCRETE	GALV.	GALVANIZED
CONT.	CONTINUOUS	G.I.	GALVANIZED IRON
CONTR.	CONTRACTOR	G.R.N.	GENERAL ROOF NOTE
CORR.	CORRIDOR	GYP. BD.	GYPSON BOARD
D.B.	DAVIT BASE	H.C.	HANDICAP
DEL., DTL.	DETAIL	HGT.	HEIGHT
DIS.	DISPENSER	H.M.	HOLLOW METAL
DIM.	DIMENSION	HORIZ.	HORIZONTAL
DN.	DOWN	INSUL.	INSULATION
DS.	DOWNSPOUT	JOINT	JOINT
		J.T.	JOINT WEIGHT
		LI.WT. INSUL.	INSULATING CONCRETE
		CONC.	CONCRETE
		MAS.	MASONRY
		MAX.	MAXIMUM
		MFR.	MANUFACTURER
		MECH.	MECHANICAL
		MEMBR.	MEMBRANE
		MET., MTL.	METAL
		M.O.	MASONRY OPENING
		NO.	NUMBER
		O.C.	ON CENTER
		O.D.	OUTSIDE DIAMETER
		OPP. HAND., O.H.	OPPOSITE HAND
		OPEN'G	OPENING
		PLAS. LAM.	PLASTIC LAMINATE
		P.T.D. & D.	PAPER TOWEL DISPENSER AND DISPOSAL
		PLYND.	PLYWOOD
		R.	RADIUS
		R.D.	ROOF DRAIN
		RES.	REFER TO
		REDWD.	REDWOOD
		REINF.	REINFORCING
		RM.	ROOM
		S.	SPACES
		SAN.	SANITARY
		S.B.	SPLASH BLOCK
		SCHED.	SCHEDULED
		SHEATH.	SHEATHING
		SHI.	SHEET
		STL.	STEEL
		STRUCT.	STRUCTURE
		T.D.	TIE DOWN
		TK.	THICK
		TOI.	TOILET
		T.O.S.	TOP OF STEEL
		T.P.H.	TOILET PAPER HOLDER
		TYP.	TYPICAL
		UL.	UNDERWRITERS LABORATORIES
		V.P.R.	VAPOR PRESSURE RELIEF
		VERT.	VERTICAL
		W.	WITH
		W.C.	WATER CLOSET
		WD.	WOOD
		W.P.	WATER PROOFING

LEGEND

[Pattern]	CONCRETE
[Pattern]	ASPHALT PAVING
81.00	EXISTING GRADE ELEV
80.00	FINISH GRADE ELEV
---	NEW SHALE (DIRECTION OF SLOPE)
TC	TOP OF CURB
T.W.	TOP OF WALK
P.P.	POWER POLE (EXIST)
M.H.	MANHOLE (EXIST)

1 SITE PLAN
1" = 20'-0"

REVISION #1-MAY 15, 1980

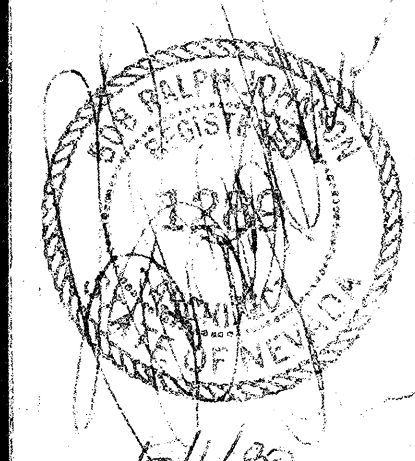

333 RANCHO ROAD
LAS VEGAS, NEVADA
MEL POWERS INVESTMENT BUILDER

PROJECT NUMBER
79-24
DATE
12-14-79
5-1-80

SHEET
A-1
OF 2

BENCH MARK:
RIVET AND PLATE AT W/SW RETURN BONANZA
AND RANCHO ROAD "C.L.V. 06129D1"
ELEVATION = 2005.06