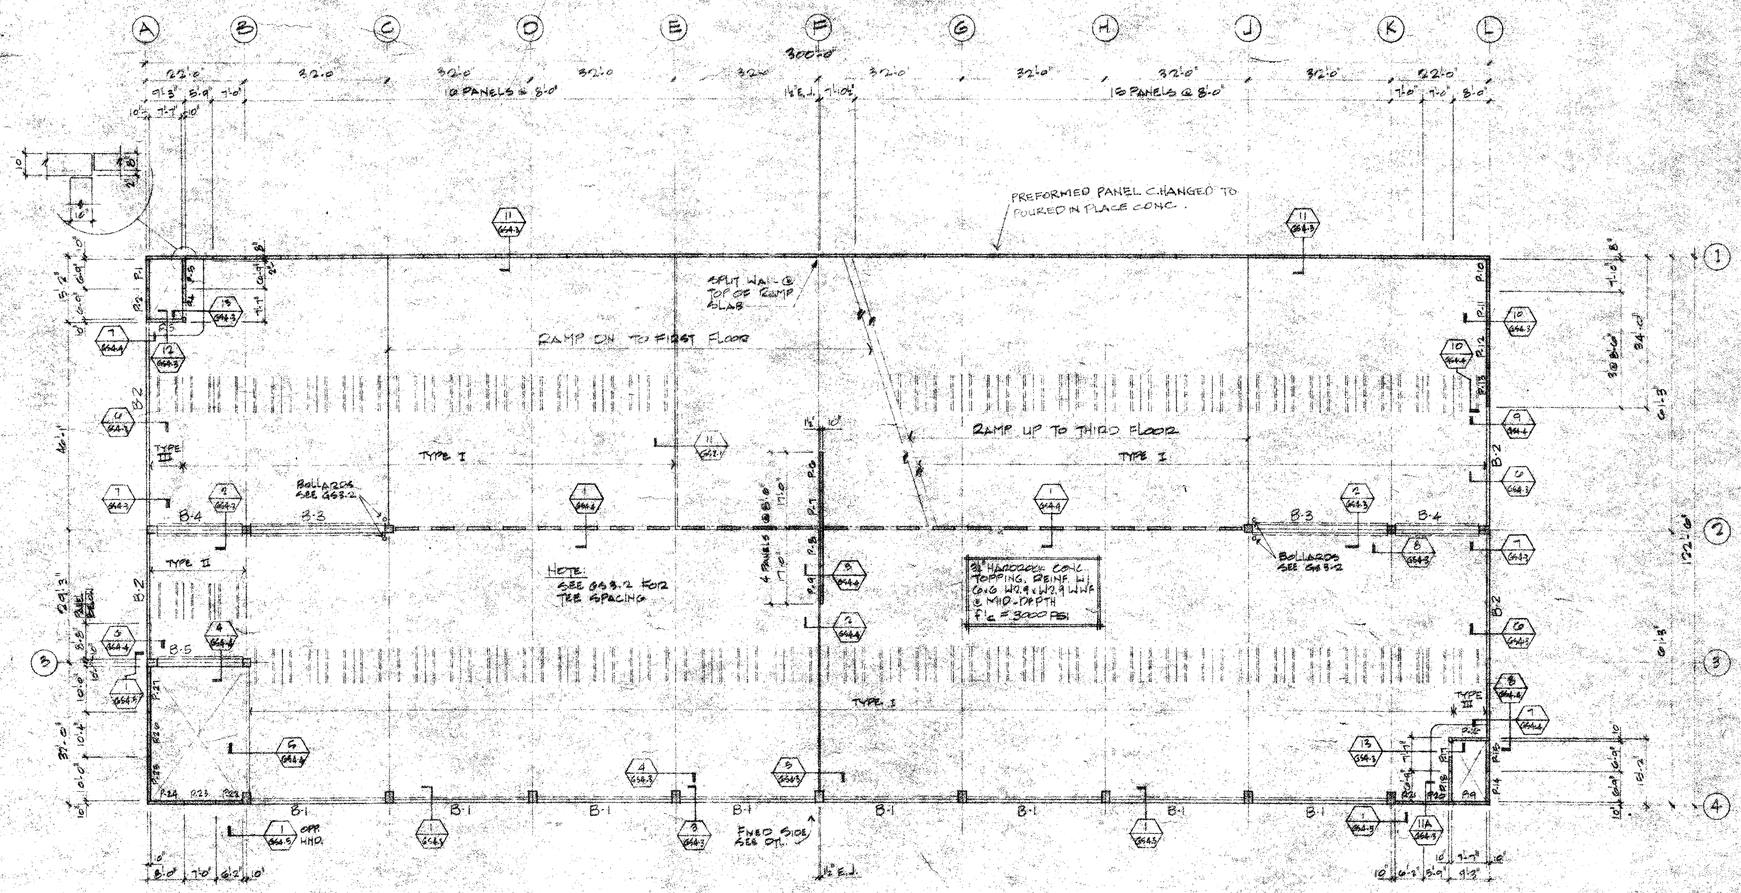

SECOND FLOOR FRAMING PLAN

1/8" = 1'-0" FIN. FLR. 94.50'

AS BUILT

333 RANCHO ROAD
LAS VEGAS NEVADA
MEL POWERS INVESTMENT BUILDER

PROJECT NUMBER
79-24

DATE
5-1-80

SHEET
G53-1
OF 13