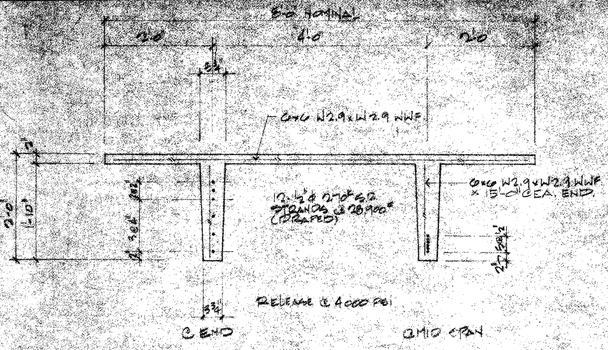

TYPE I

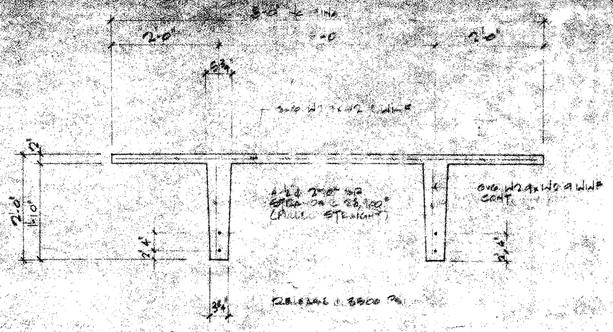

TYPE II

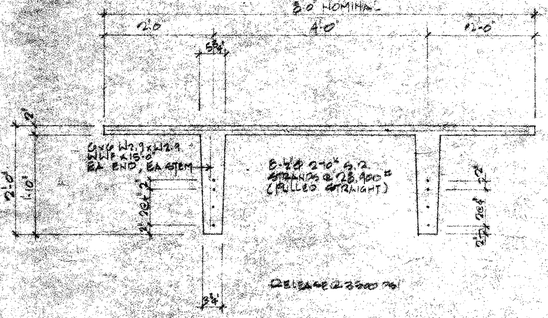

TYPE III

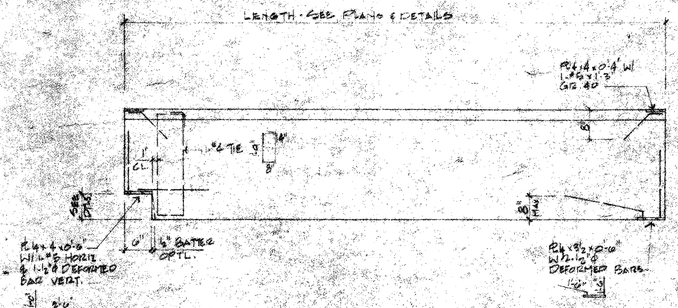

PRECAST TEE ELEVATION

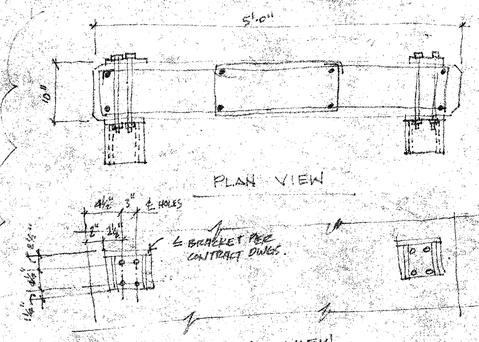

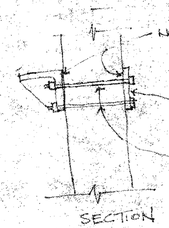

SECTION

REMEDIAL ACTION REQ'D FOR MISSING 12x12 PL'S @ 4TH WALL COLUMN NORTH OF GRID "C", TOP FLOOR.

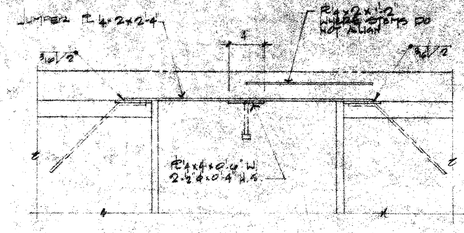

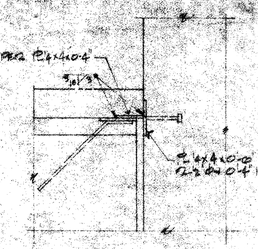

1 TEE STEM TO BEAM AND WALL CONNECTION
1½" = 1'-0"

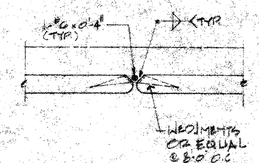

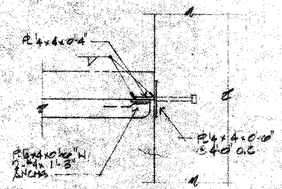

2 TEE FLANGE SHEAR CONNECTION

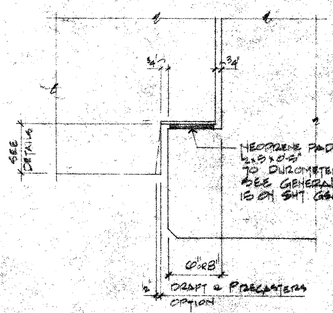

3 TEE BEARING DETAIL

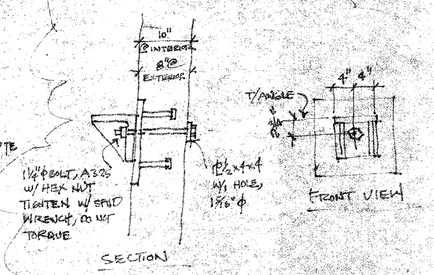

REMEDIAL REPAIRS DUE TO DEFECTIVE PL'S

NOTE: WHERE CAST-IN PL'S ARE FOUND TO BE DEFECTIVE BY ULTRASONIC TESTING THE ABOVE DETAIL SHALL APPLY. DRILL HOLES FOR BOLTS 1⅛" OVERSIZE, MAX., BOLTS SHALL BE 1'-4" LG @ 10" PANEL, 11" @ 8" PANEL.

AS BUILT

333 RANCHO
LAS VEGAS
NEL POWERS
INVESTMENT BUILDER
NEVADA

PROJECT NUMBER
79-24
DATE
5-1-80

SHEET
G54-2
OF 13