


PROFILE SCALE:  
HORIZ: 1"=40'  
VERT: 1"=4'



\*UNIT 2A  
CAMP FIRE ROAD

\*UNIT 2B  
PRAIRIE WAY

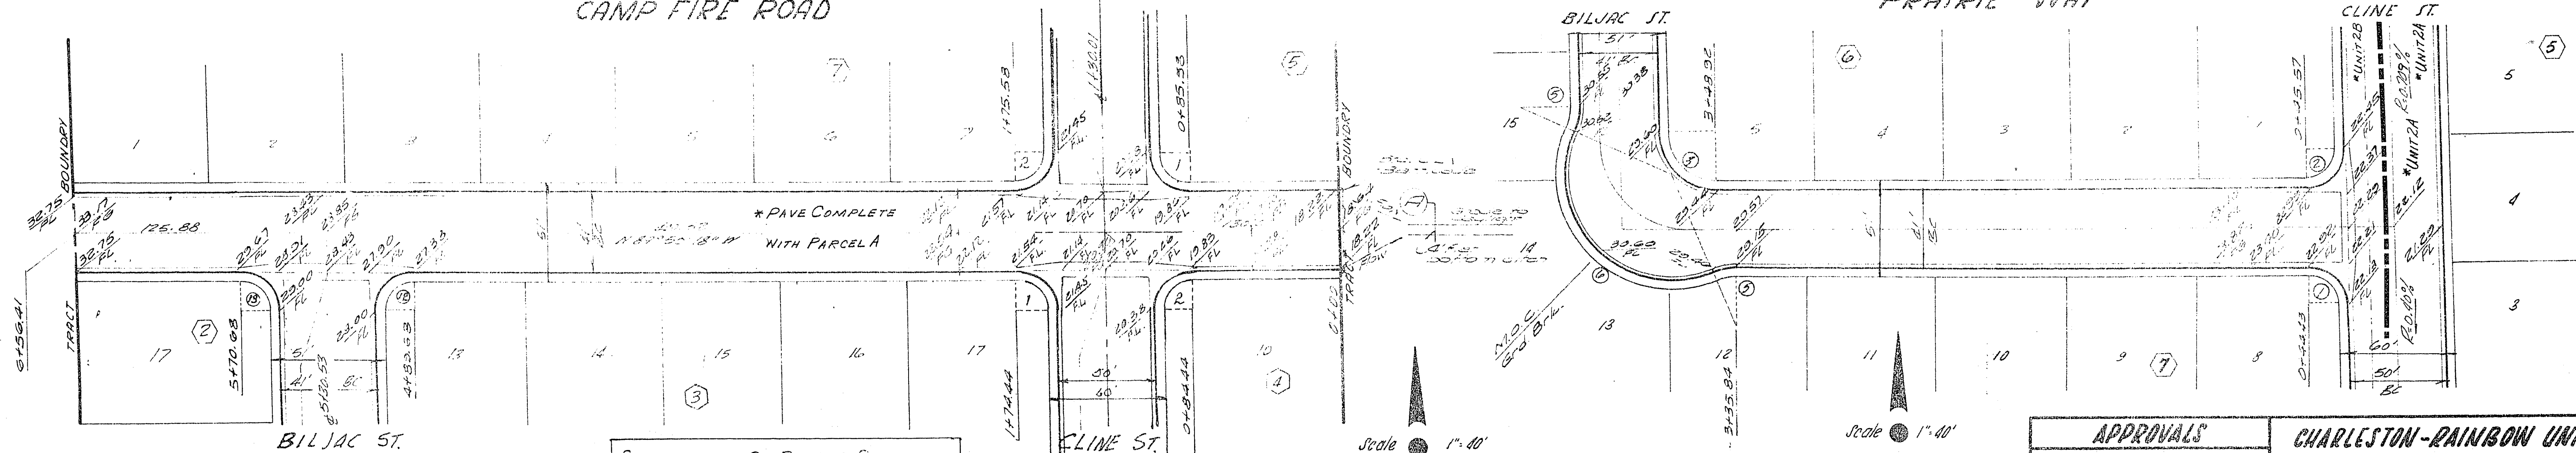

SUPERIMPOSED ON RECORD DOCUMENT:  
NOTE TO \*PAVE COMPLETE WITH PARCEL A.

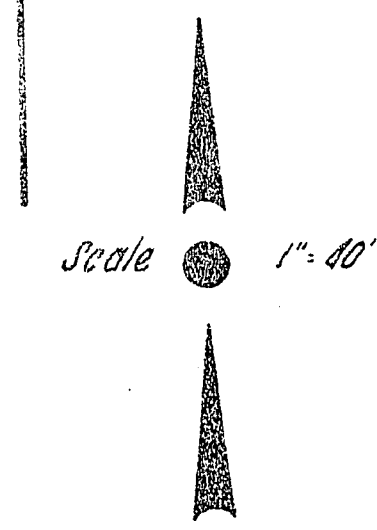

Scale 1"=40'

SECTION "A"

Divided into Units 2-A & 2-B 11-18-66

Initials  
Field Engr. City Engr.

APPROVALS		CHARLESTON-RAINBOW UNIT 2 STREET PLANS	
<i>[Signature]</i> City Engineer	Date	CAMP FIRE RD. & PRAIRIE WAY	
<i>[Signature]</i> Field Engineer	Date	Submitted by: <i>[Signature]</i> Victor G. Kramelbauer, R.C.E. N° 1571	Sheet 3 of 12
