

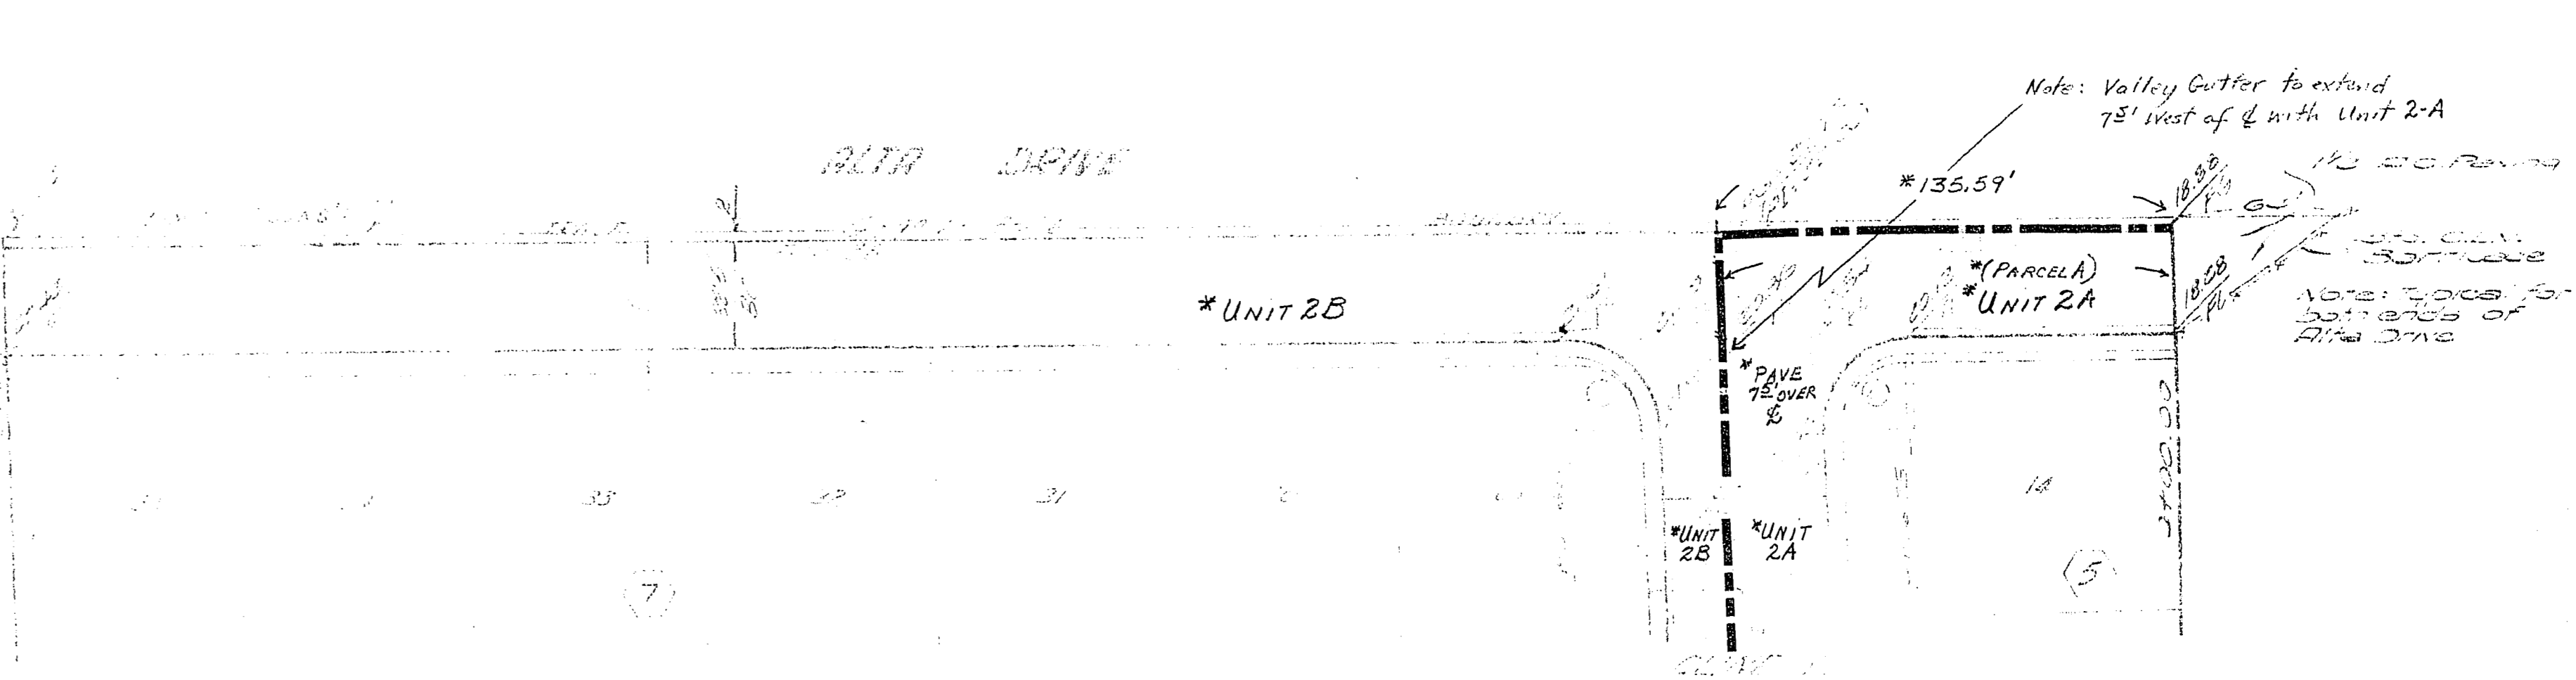
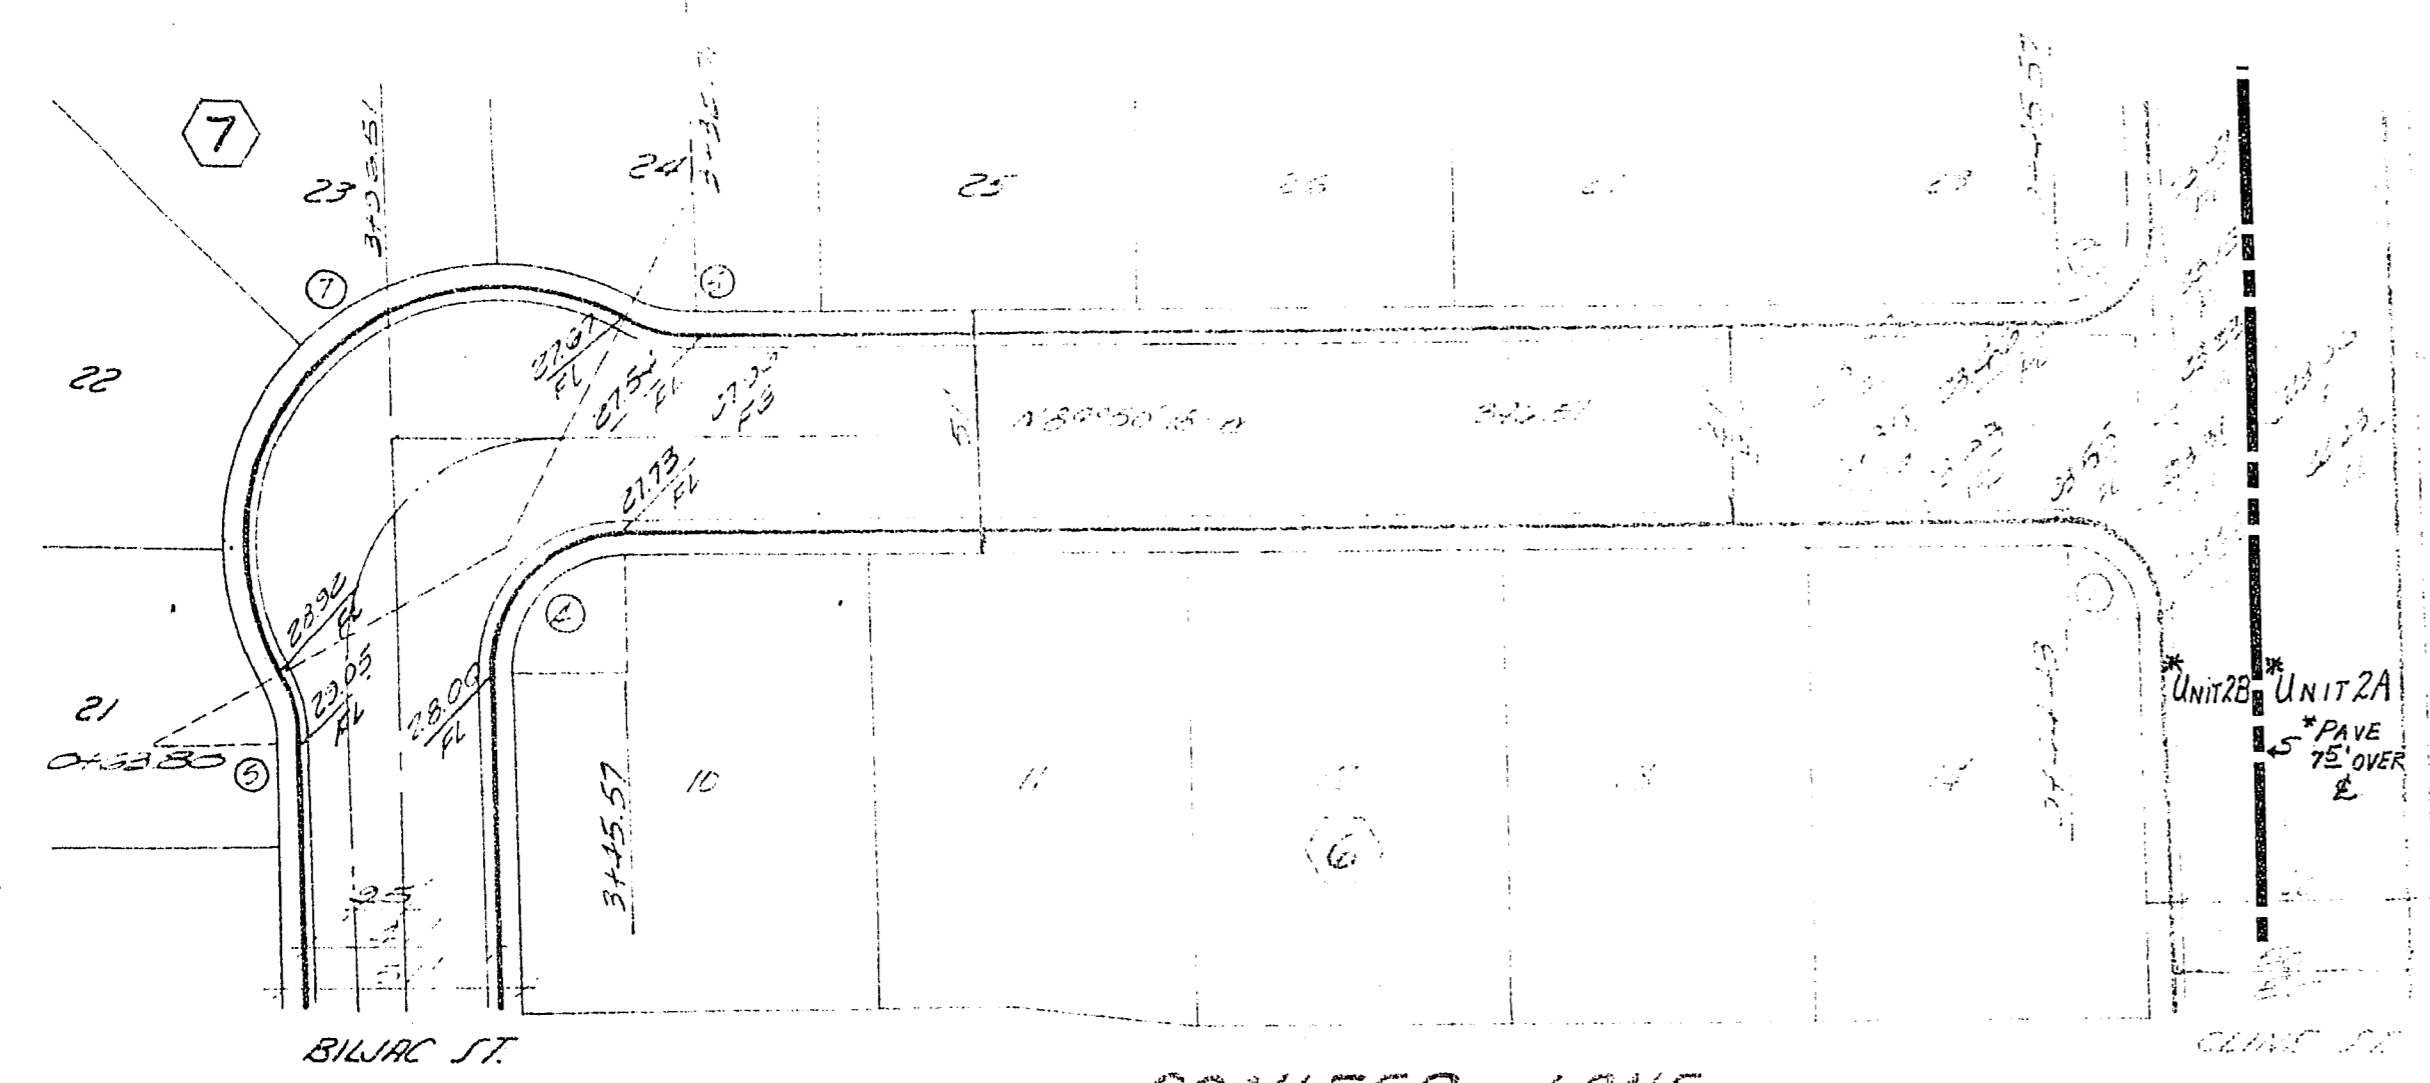


PROFILE  
SCALE  
HORIZ. 1" = 40'  
VERT. 1" = 4'

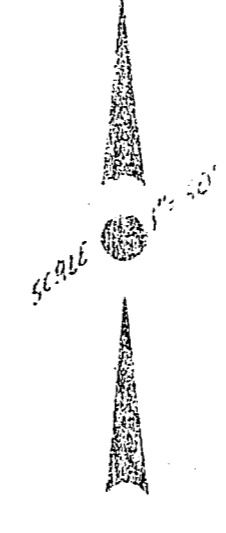

SUPERIMPOSED ON RECORD DOCUMENT:  
LINES  
DISTANCE \*135.59'  
DESIGNATION BUILT WITH PARCELA - \*(PARCELA)

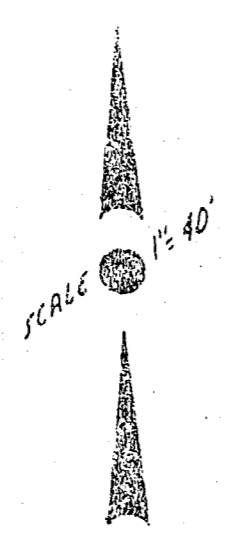

Station	Dist. to P.C.	Dist. to P.T.
0+00	20.00'	30.73'
1+00	20.00'	41.39'
2+00	20.00'	13.43'
3+00	20.00'	137.96'

Divided into Units 2-A & 2-B 11-18-66

Initials  
City Engr. City Engr.

APPROVALS		CHARLESTON-RAINBOW UNIT 2 STREET PLANS ALTA DR. & CONIFER LANE	
CITY ENGINEER	DATE	SUBMITTED BY	SHEET
		VICTOR G. FRANKENBAUER, P.E. NO 1511	1 of 13
FIELD ENGINEER	DATE	VDDORHEI-TRINDLE CO. 453 N. S. JARVIS AVE., SUITE 208, W. MEX.	
		DR. 14 A DEC. 1966	