


2420

2415

CHARLESTON RAINBOW UNIT  
N2-1 -- (Not a Part)

STAR 15700' MATCH LINE - SEE BELOW  
STAR 16100' (FOR CONTINUATION)  
SEE MATCH LINE BELOW

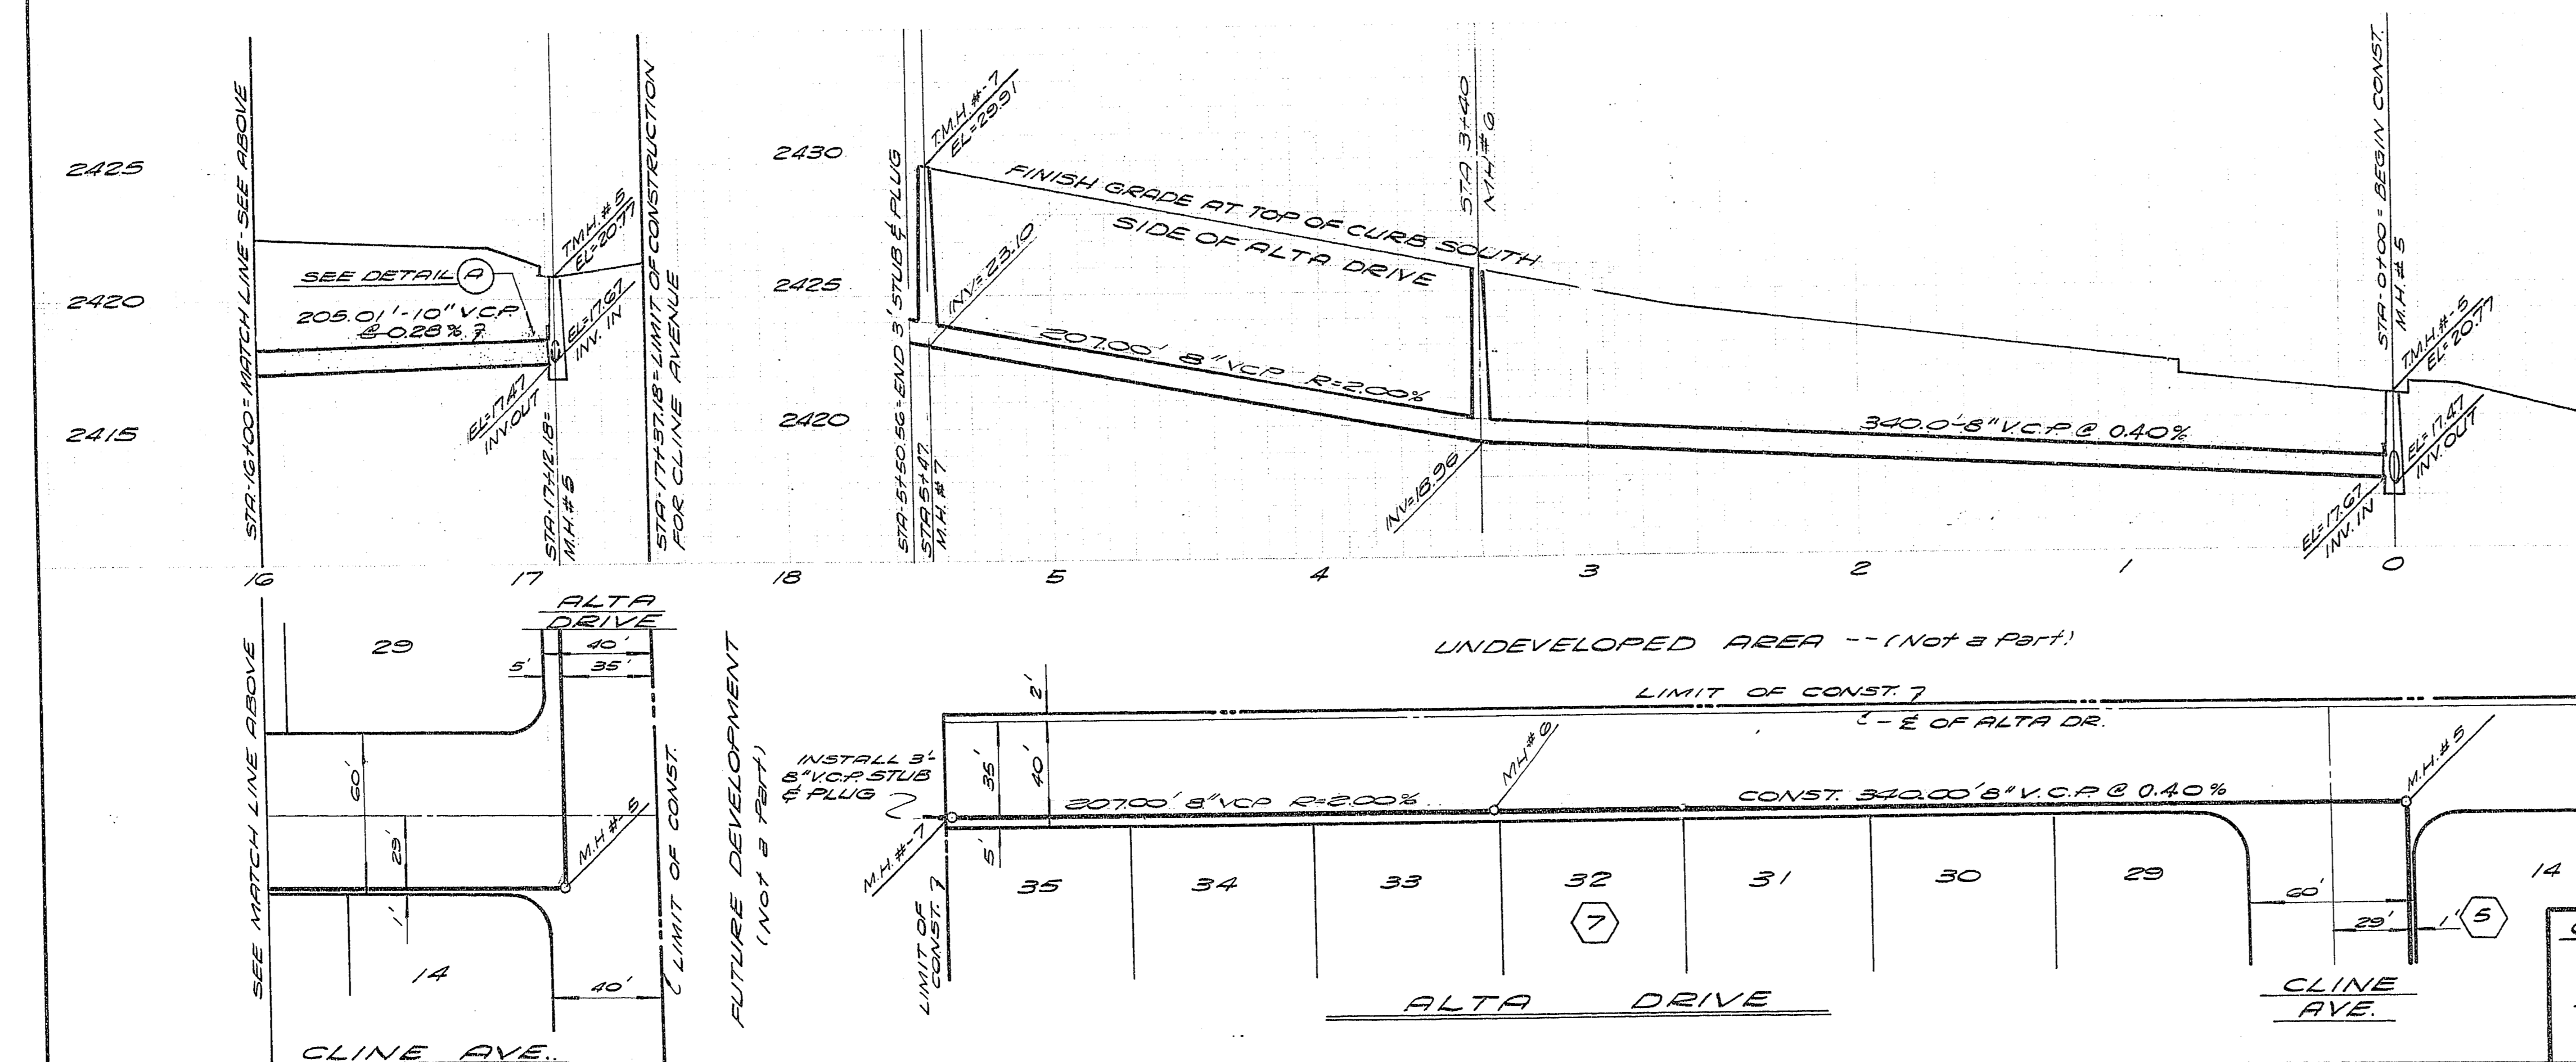

2430

2425

2420

2425

2420

2415

SEE MATCH LINE ABOVE  

SCALES  
HORIZ - 1" = 40'  
VERT - 1" = 4'

Approvals

2420 *[Signature]* 5/21/16  
City Engineer Date

Sanitation Subt. Date

A ELIMINATED CONC. ENCUMBRANCE 8-2-04

Date	Description	By	App'd
8-2-04	Elim. Concrete Encumbrance, Cline Alta	VB4	AK3

CHARLESTON RAINBOW  
UNIT N2-2  
SEWER PLAN & PROFILES  
CLINE AVENUE &  
ALTA DRIVE

SHEET 11  
OF 12