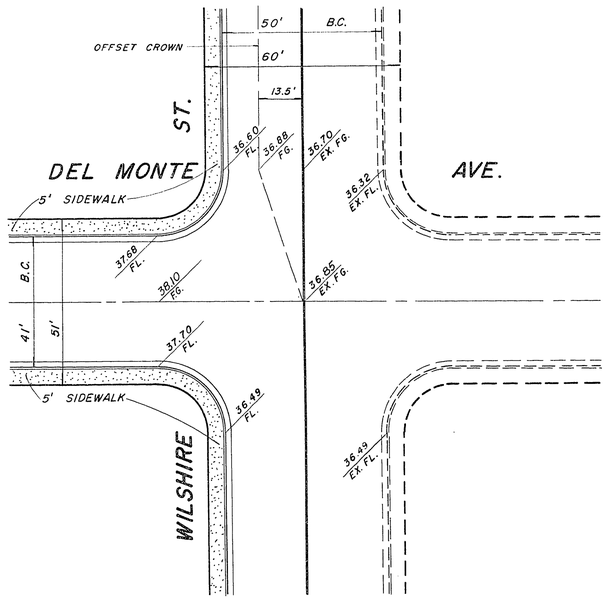

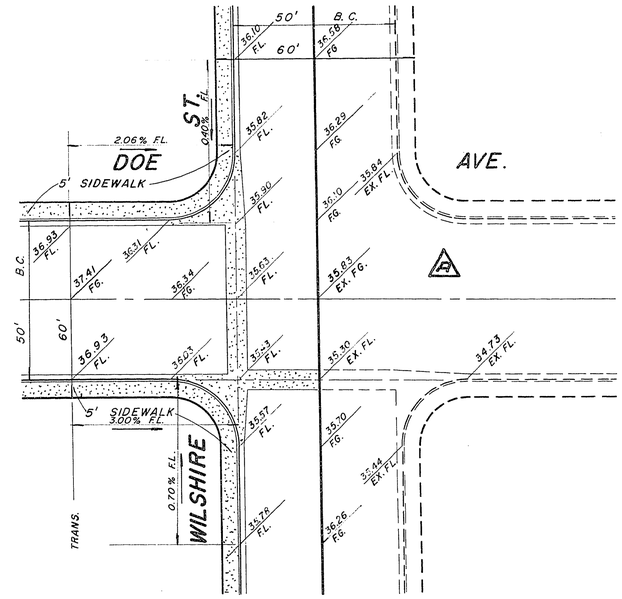

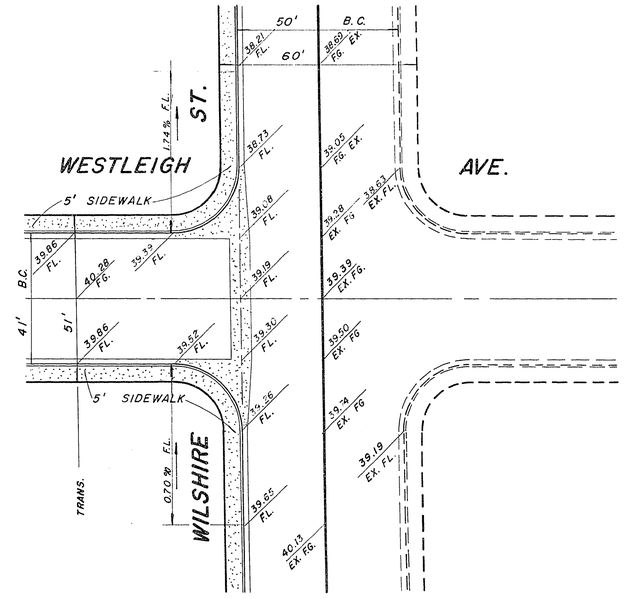

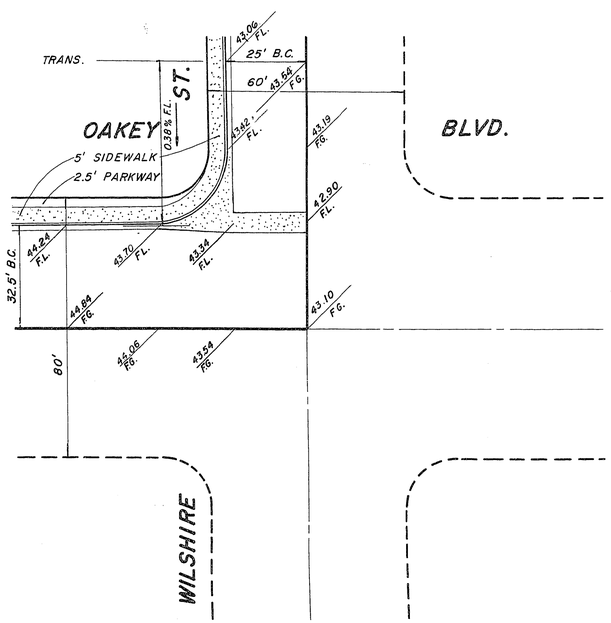

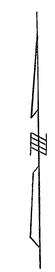

SCALE: 1" = 20'

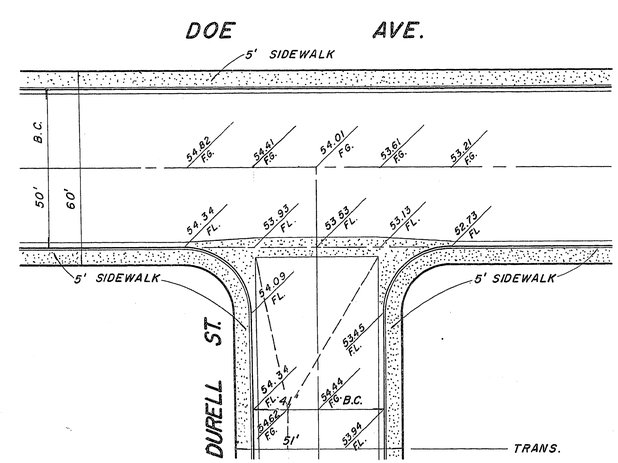

APPROVALS

CITY ENGINEER — DATE

FIELD ENGINEER — DATE 10-2-63

REV	DATE	DESCRIPTION	BY	APPROVED
E				
D				
C				
B				
A	9-25-63	CHANGE ST. GRADES	R.L.	

CHARLESTON HILLS UNIT 4

STREET INTERSECTION

SCALE 1" = 20'

DESIGNED M.R
DRAWN R.D.B
CHECKED
APPROVED DATE 7-15-63

WESTERN ENGINEERS, INC.
LAS VEGAS NEVADA

SHEET 3 OF 4

107-4-10 1/5-4