

**CURVE DATA**

N°	Δ	R	L	T
①	90° 00' 00"	20.00	21.42	20.00

SUBMITTED BY:  
*Charles R. Johnson*  
 CHARLEY R. JOHNSON R.P.E. # 3002 6-20-73 DATE



APPROVED BY:  
 UB. WILSON 4/1/74 DATE  
 LAS VEGAS CITY ENG.  
 J. D. SUTHERLAND 4-1-74 DATE  
 LAS VEGAS FIELD ENG.

4-15-74 Revised Grades on Astronaut Ave  
 Sta 9+78.25 to Sta 10+98.25 C.R. #11C

**V.T.N.** CONSULTING ENGINEERS & PLANNERS  
 2209 PARADISE ROAD, LAS VEGAS, NEVADA 89105  
 (702) 735-0227

**CHARLESTON RAINBOW**  
 UNIT N° 11-C  
**STREET PLAN & PROFILE**  
 ASTRONAUT AVENUE

SCALE:	WO NO. 1066-11C	DATE 6-20-73	SHEET	OF
HORIZ: 1"=40'	DES.	REV.	3	3
VERT: 1"=4'	CHK	REV.		

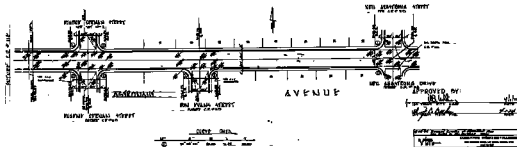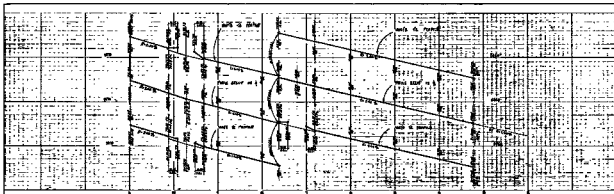

SUBMITTED BY:

*[Signature]*

APPROVED BY:  
*[Signature]*

