



JOB NO. 499.510

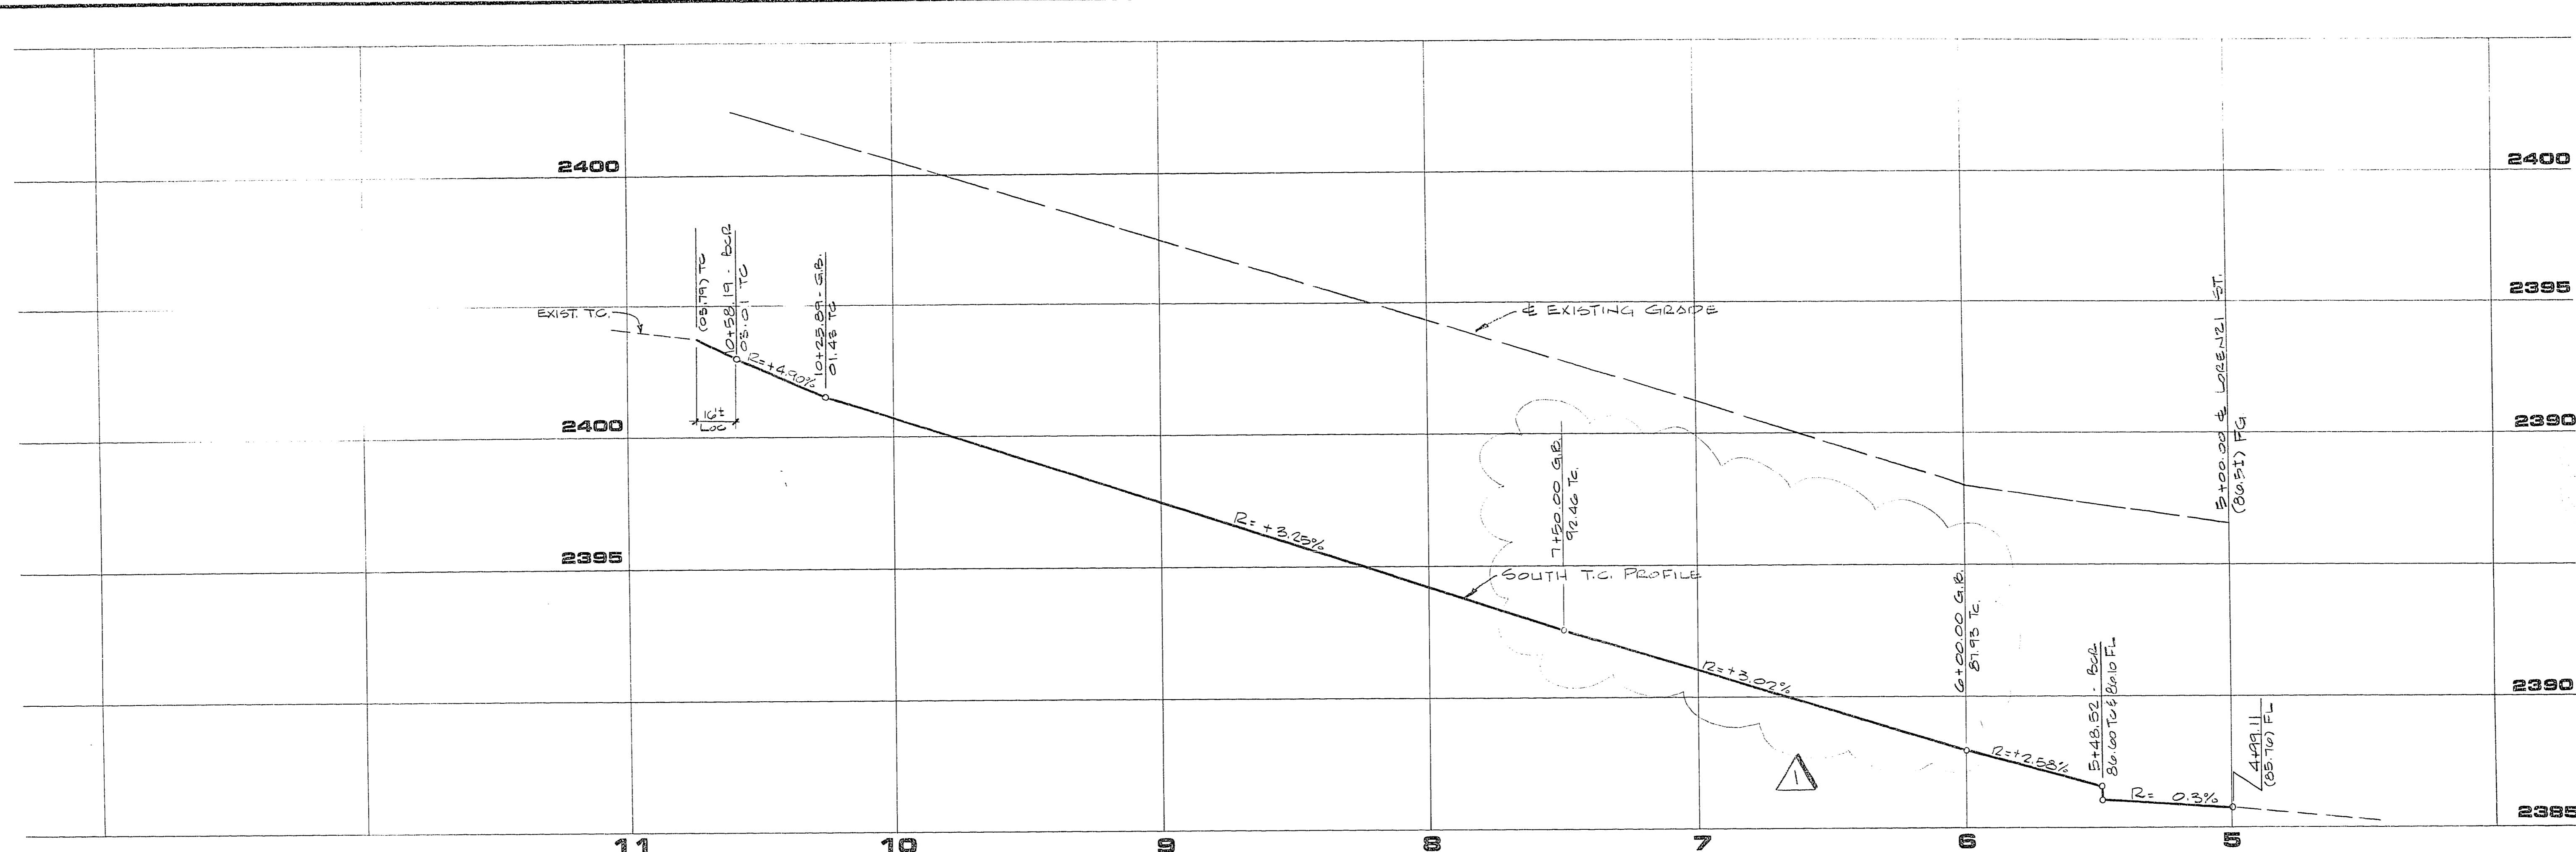

PROFILE
SCALE: HORIZ. 1"=30'
VERT. 1"=3'

LEWIS HOMES - STONEGATE NO. 2
BX 29 PG 70

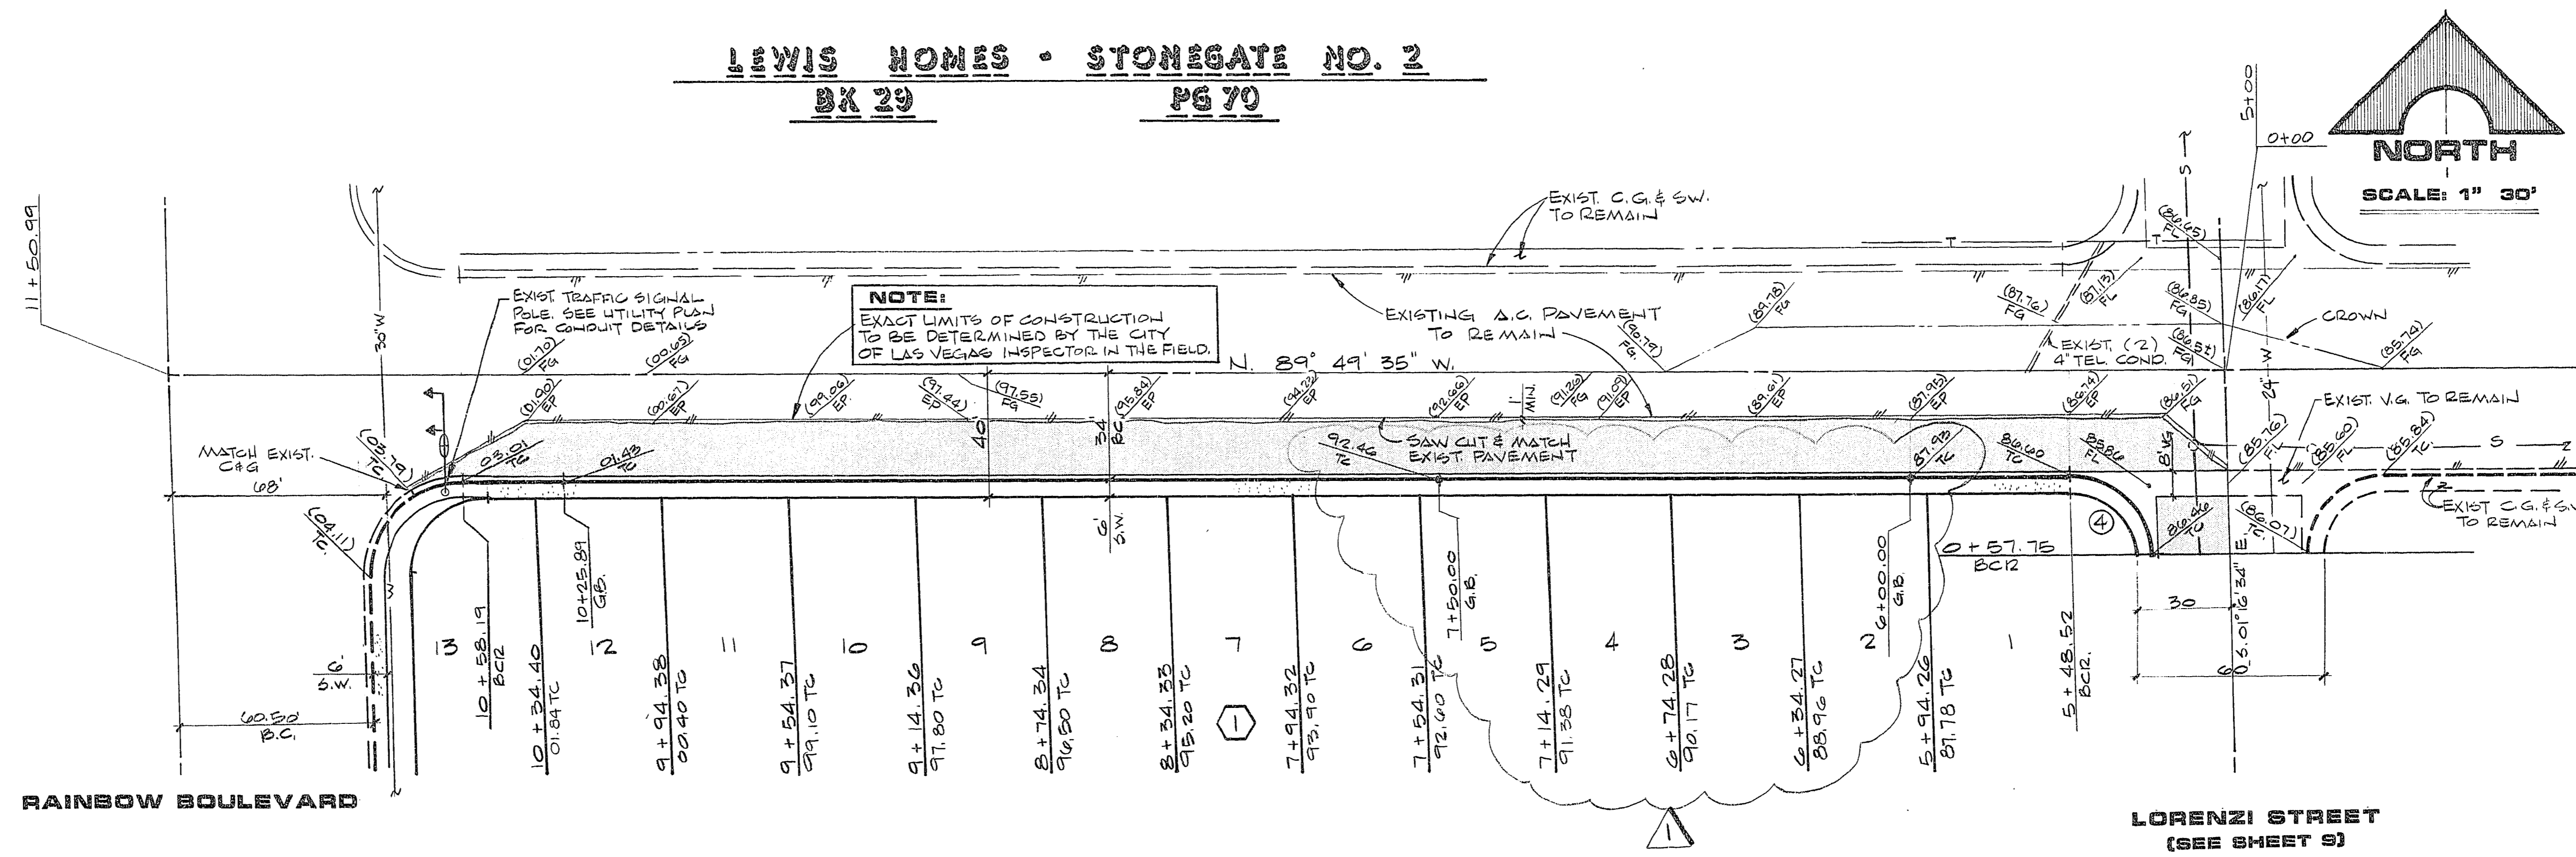

BCR CURVE DATA


| No | Δ | BCR | L | T |
|----|-------------|--------|--------|--------|
| 4 | 88° 33' 01" | 25.00' | 33.64' | 24.38' |

ALTA DRIVE

APPROVAL
CLV CHIEF LAND DEVELOPMENT AND FLOOD CONTROL
DATE 1/22/84

RECOMMENDED: *David P. Huckle*
DAVID P. HUCKLE

| REV | DATE | DESCRIPTION |
|-----|----------|---|
| 1 | 11/16/83 | 25% T.C. PROFILE FROM STA. 6+00 TO 7+50 |

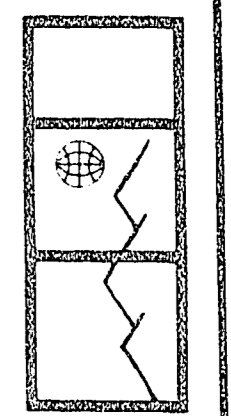

G.C. WALLACE
Consulting Engineers, Inc.
1100 East Sahara Ave. • Las Vegas, Nevada 89104 • 732-3330

METROPOLITAN DEVELOPMENT CORPORATION
METROPOLITAN'S ALTA MEADOWS UNIT NO. 1
ALTA DRIVE

SHEET
10
OF 12 SHEETS

29.7.85 1028-2159