
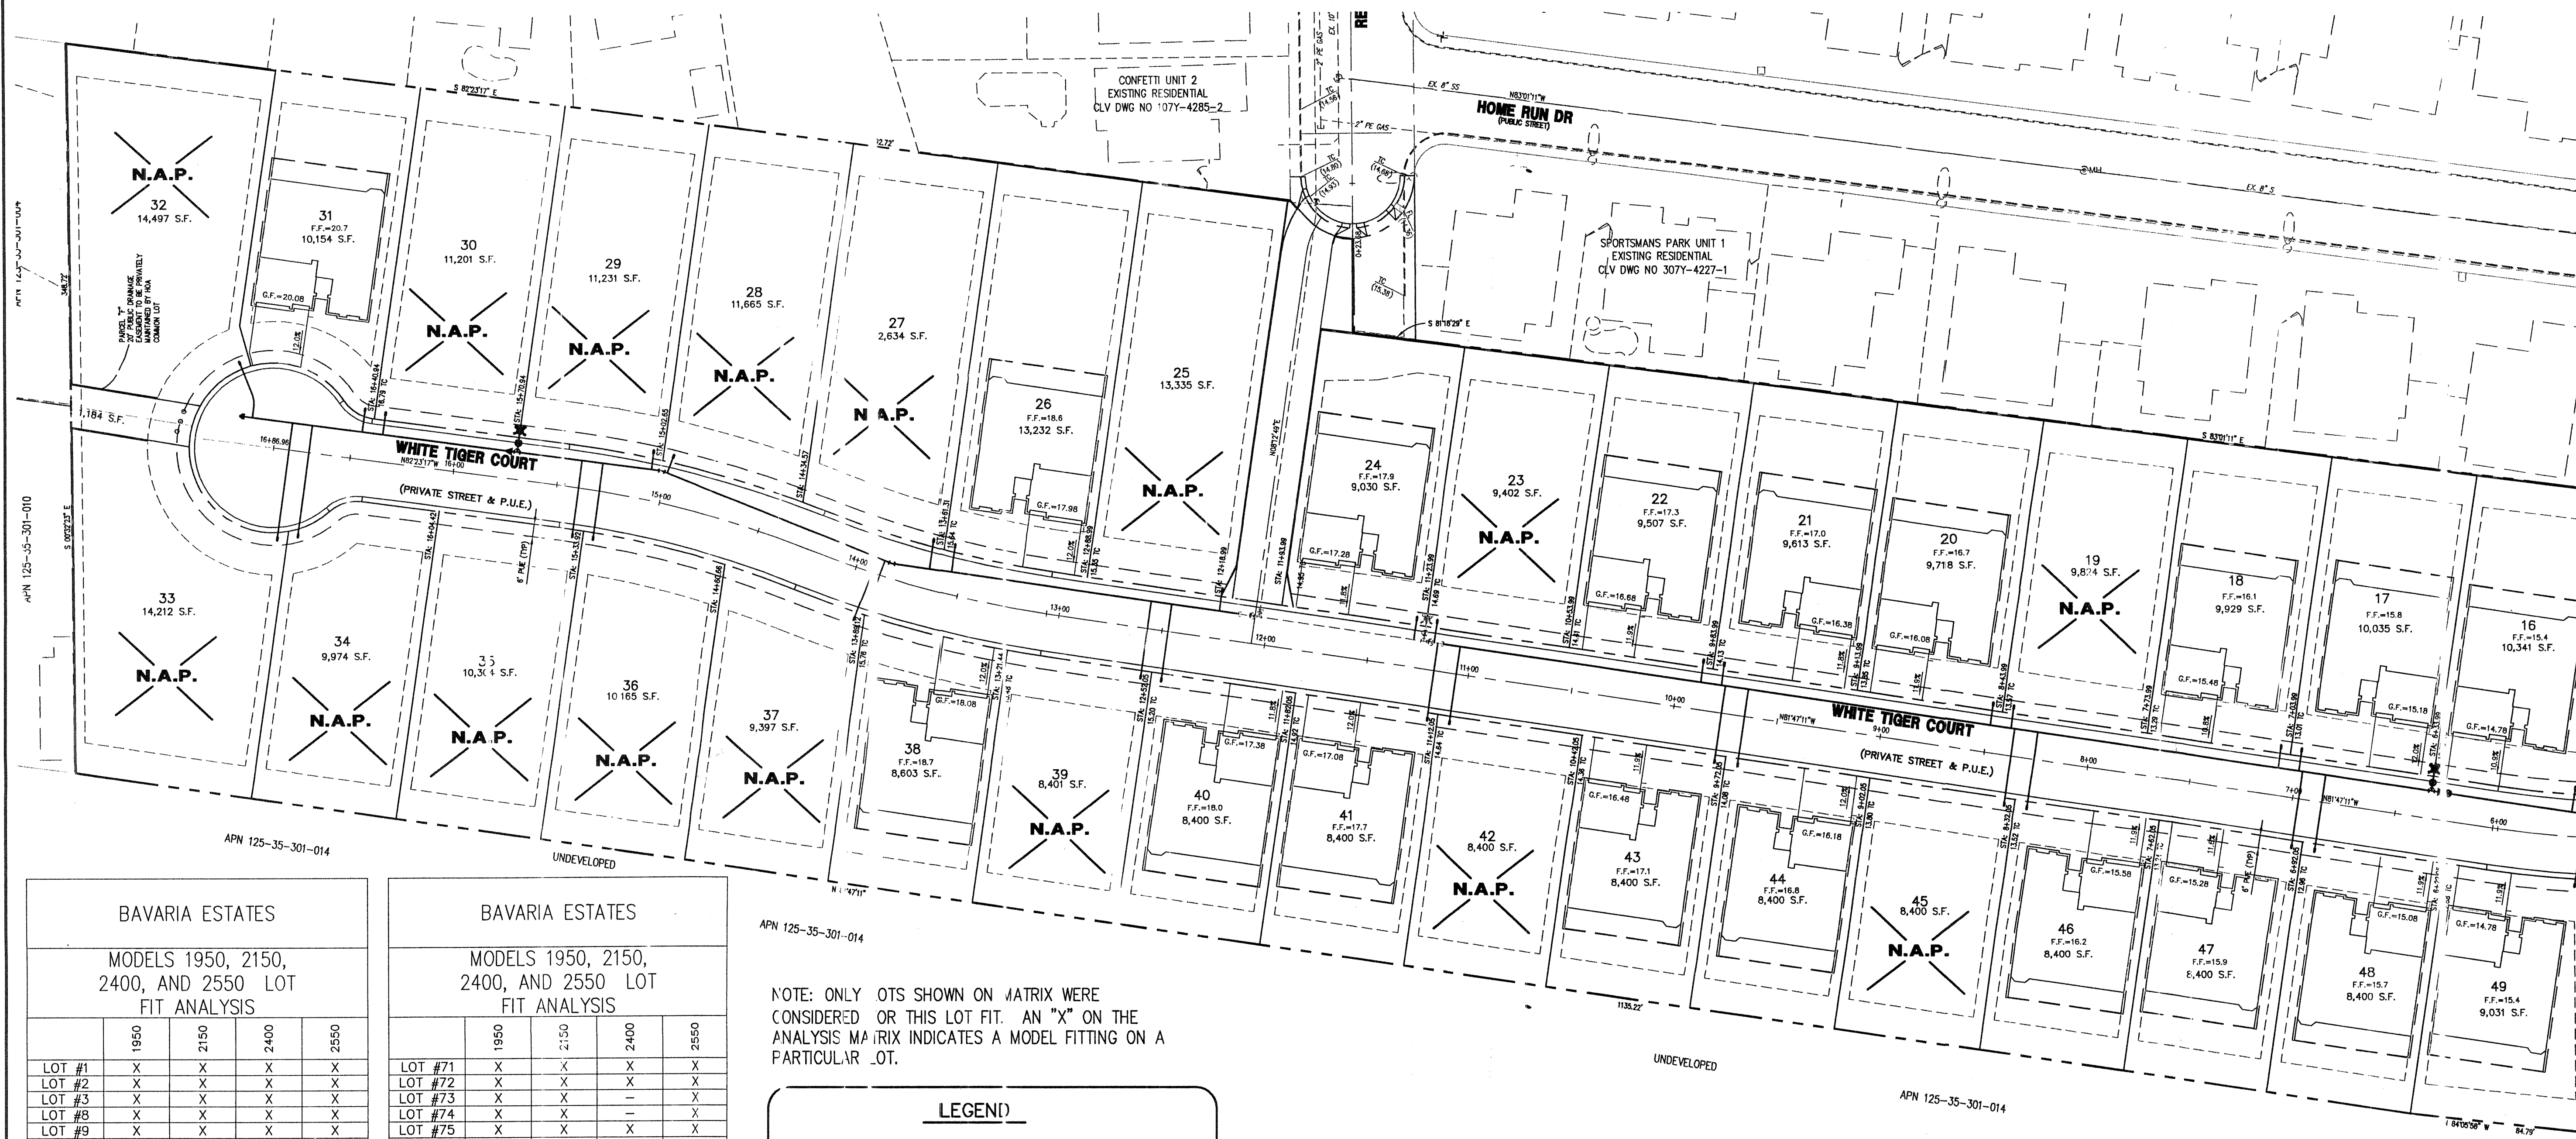
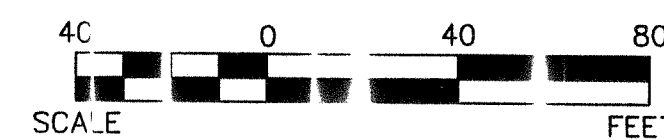


BAVARIA ESTATES

D.R. HORTON

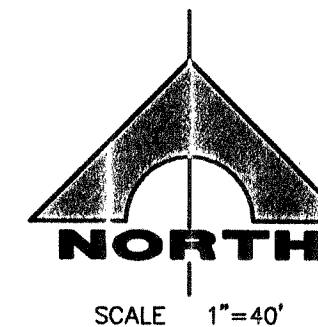

BAVARIA ESTATES

MODELS 1950, 2150, 2400, AND 2550 LOT FIT ANALYSIS

	1950	2150	2400	2550
LOT #1	X	X	X	X
LOT #2	X	X	X	X
LOT #3	X	X	X	X


BAVARIA ESTATES

MODELS 1950, 2150, 2400, AND 2550 LOT FIT ANALYSIS


	1950	2150	2400	2550
LOT #71	X	X	X	X
LOT #72	X	X	X	X
LOT #75	X	X	X	X

NOTE: ONLY LOTS SHOWN ON MATRIX WERE CONSIDERED FOR THIS LOT FIT. AN "X" ON THE ANALYSIS MATRIX INDICATES A MODEL FITTING ON A PARTICULAR LOT.

LEGEND


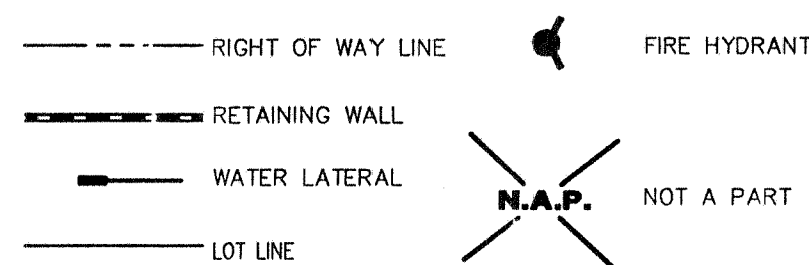


TYPICAL LOT DIMENSIONS AND SETBACKS

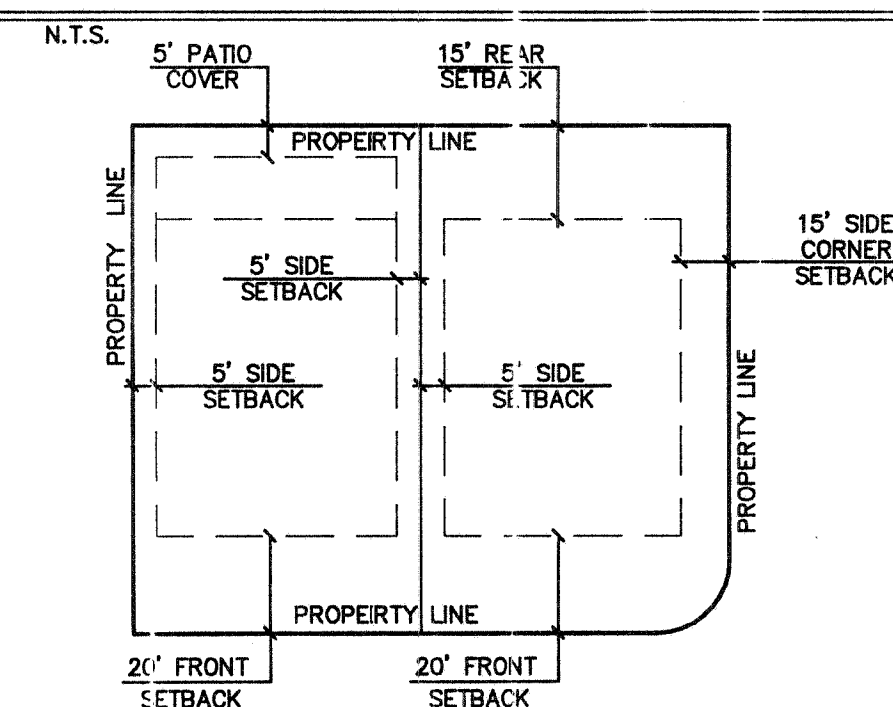

MODELS

SCALE: 1" = 40'

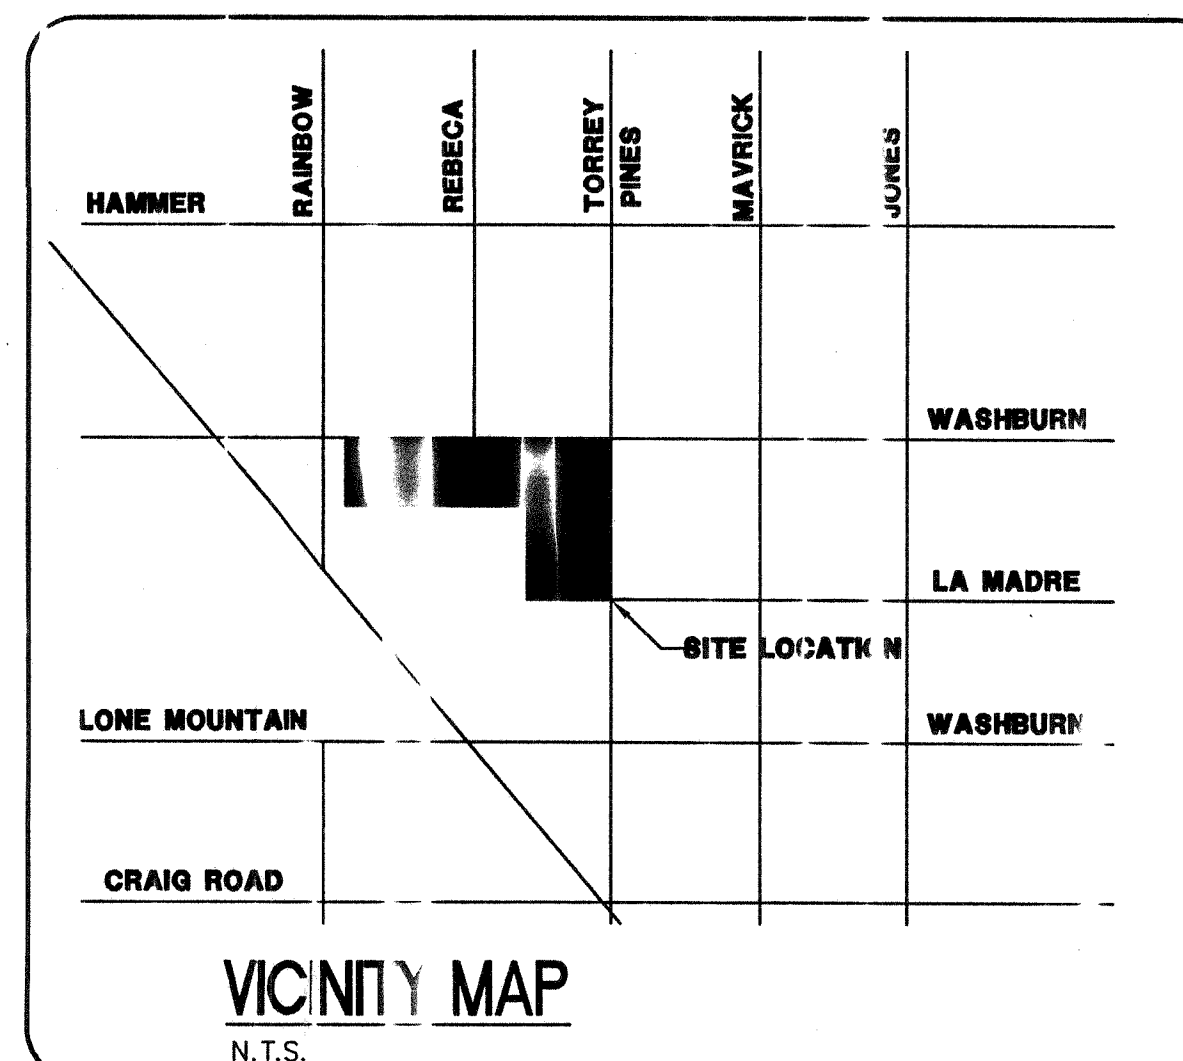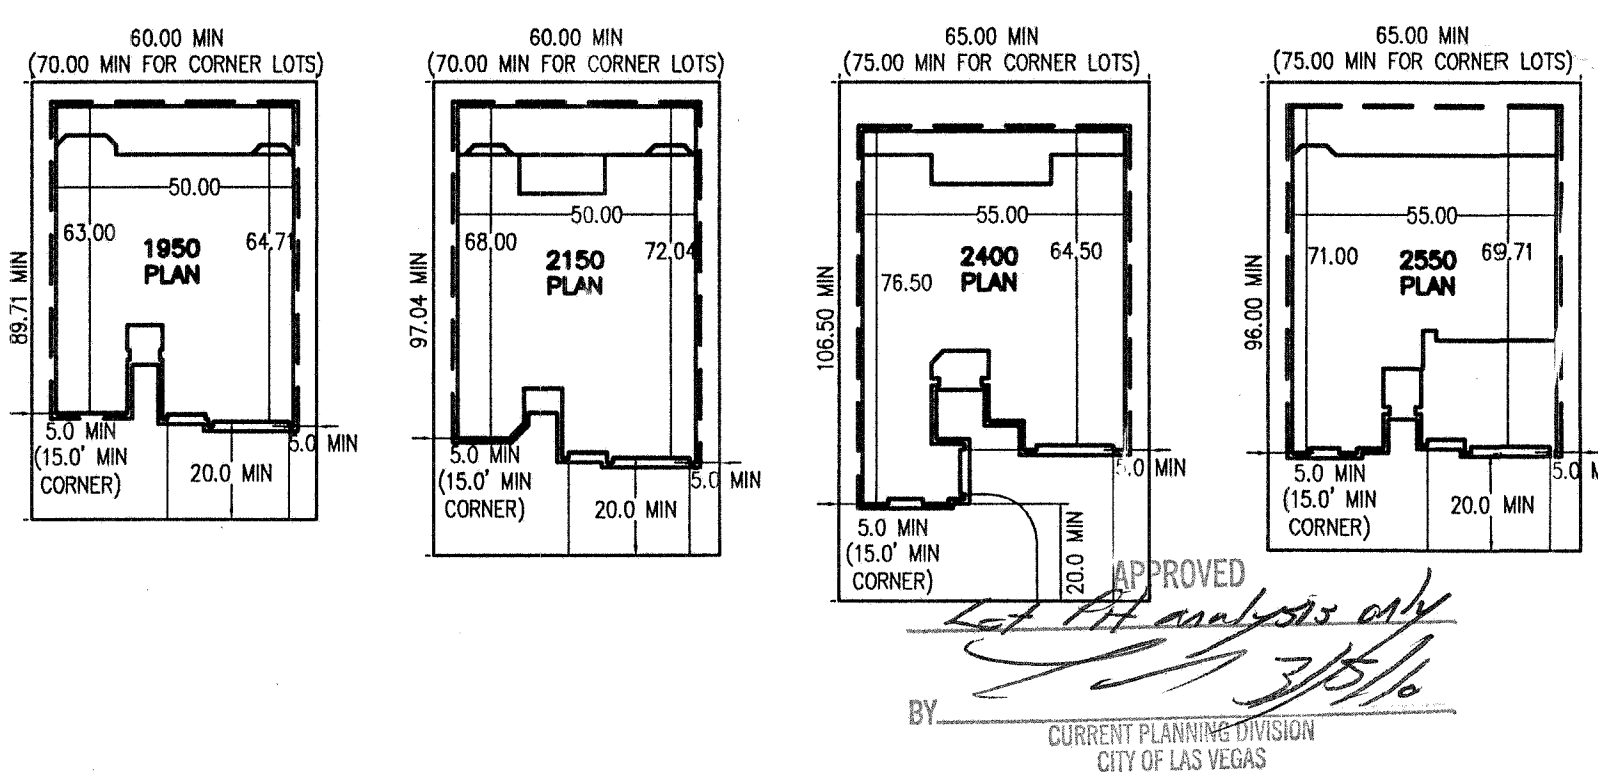

PROJECT NO. 767-053

G.C. WALLACE COMPANIES
ENGINEERS | PLANNERS | SURVEYORS
1535 S. RAINBOW BLVD., LAS VEGAS, NV 89146
T: 702.644.2000 F: 702.644.2299 GCWALLACE.COM

LAS VEGAS, NEVADA
F: Projects\700\767-053-01\Drawings\LotFit\Bavaria_Estates_LotFit.dwg
Rev. 04/10

RECEIVED

MAR 05 2010
CITY OF LAS VEGAS
PERMITS

DR. HORTON

BAVARIA ESTATES

LOT #1

WORST CASE SCENARIO - DRIVEWAY (2550 PLAN)

DRAWING

1 OF 6 SHTS

37259-37261 = C-10

TMP-8595
FMP-10965