




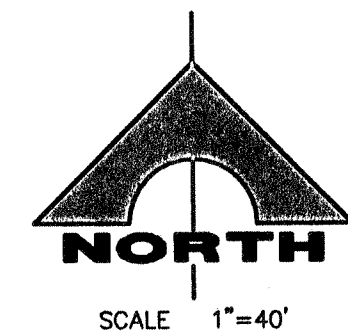


40 0 40 80
SCALE FEET

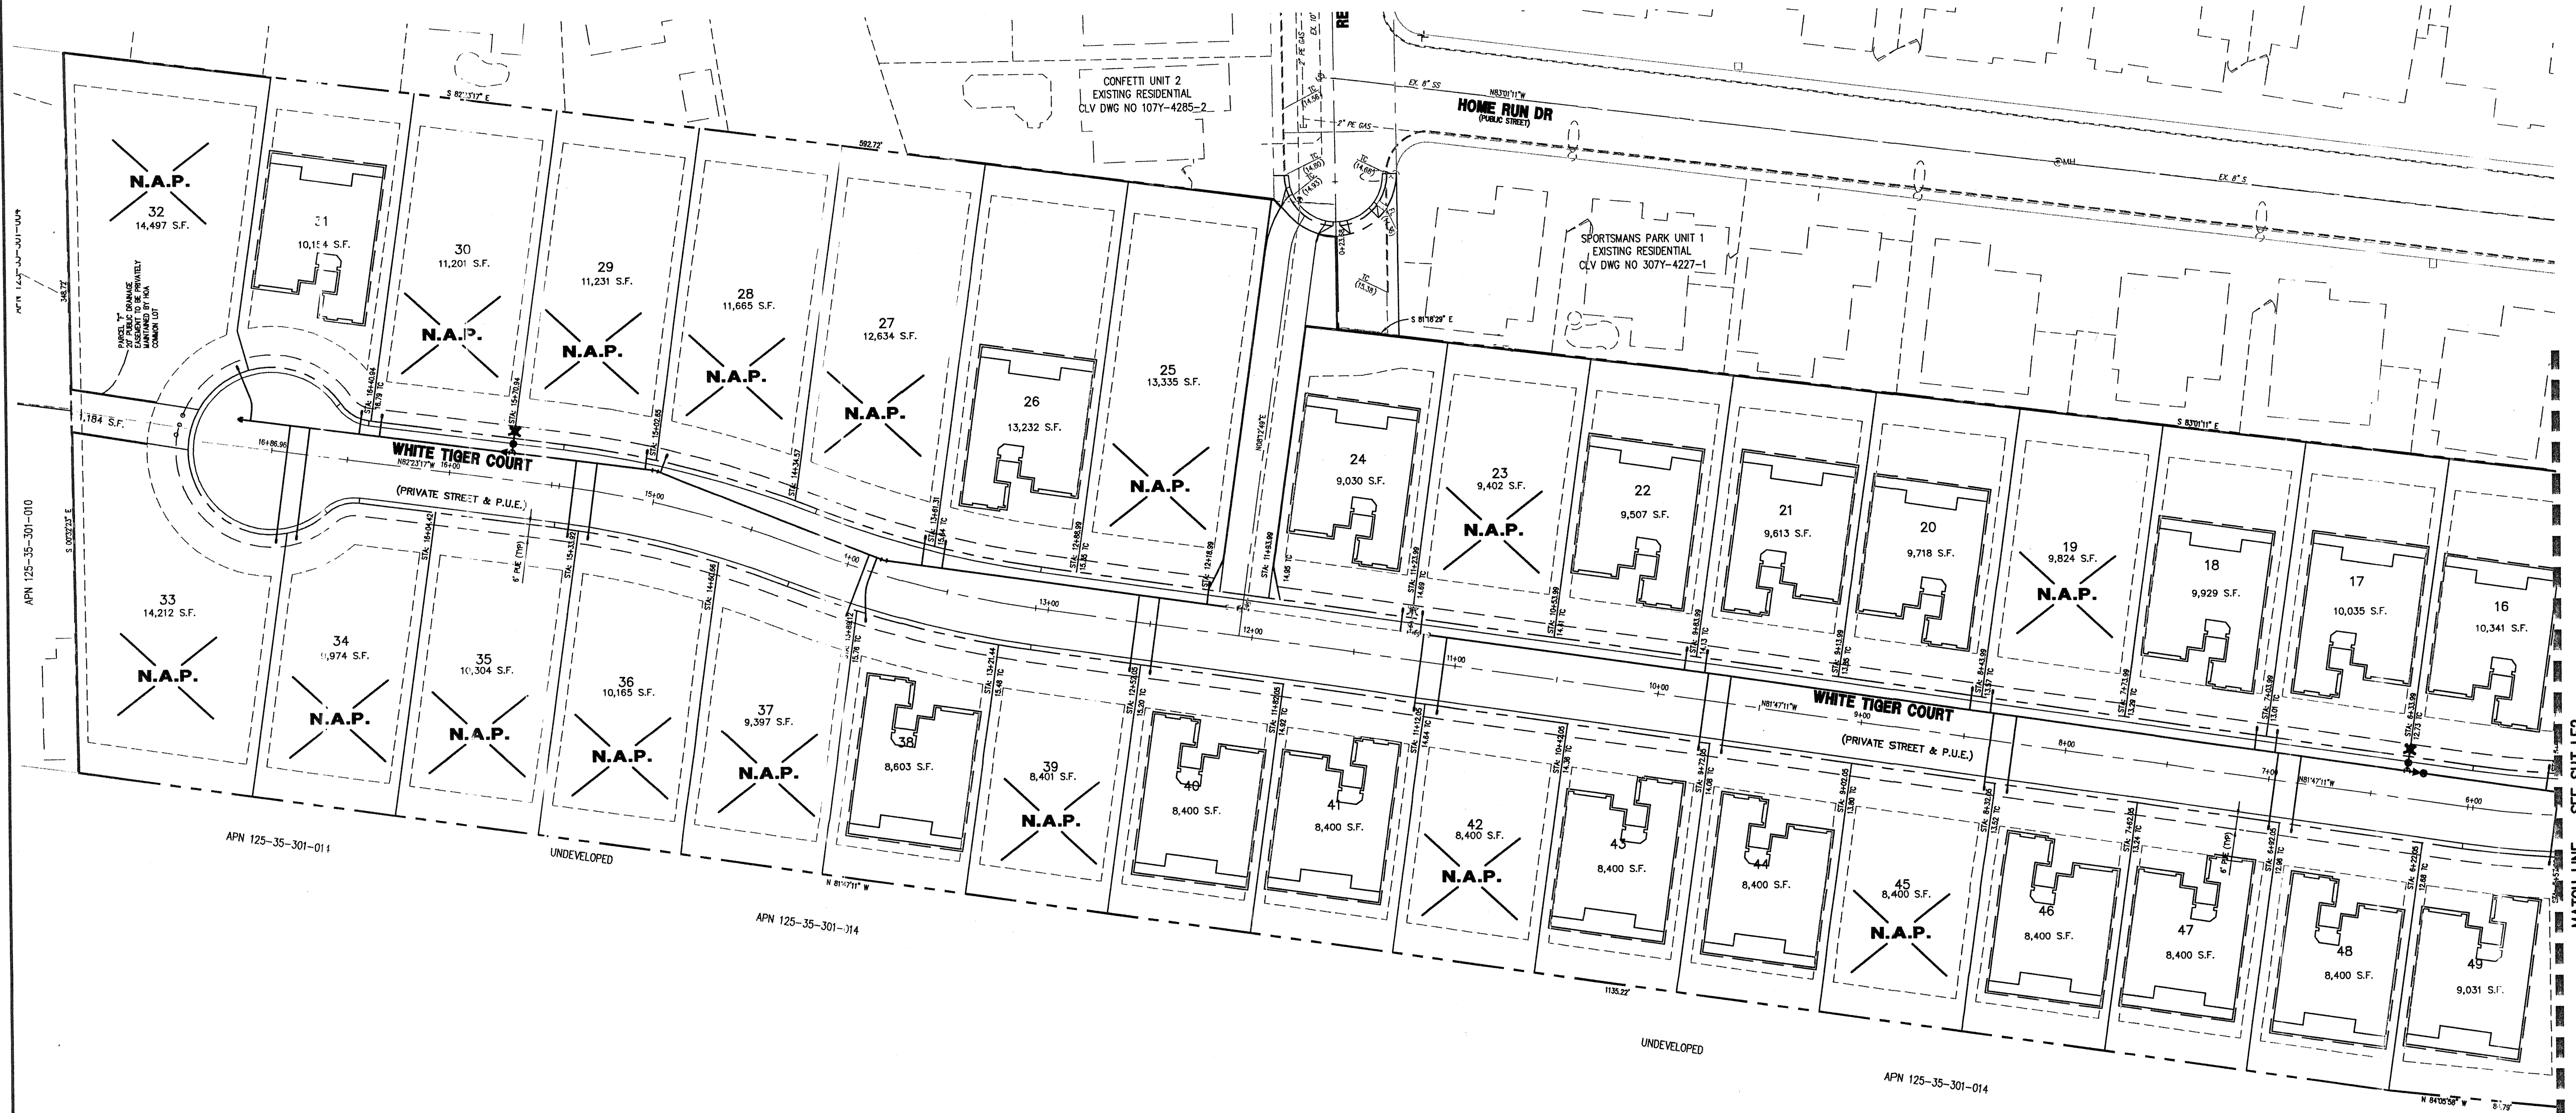

LEGEND

- RIGHT OF WAY LINE
- RETAINING WALL
- WATER LATERAL
- LOT LINE
- FIRE HYDRANT
- N.A.P. NOT A PART

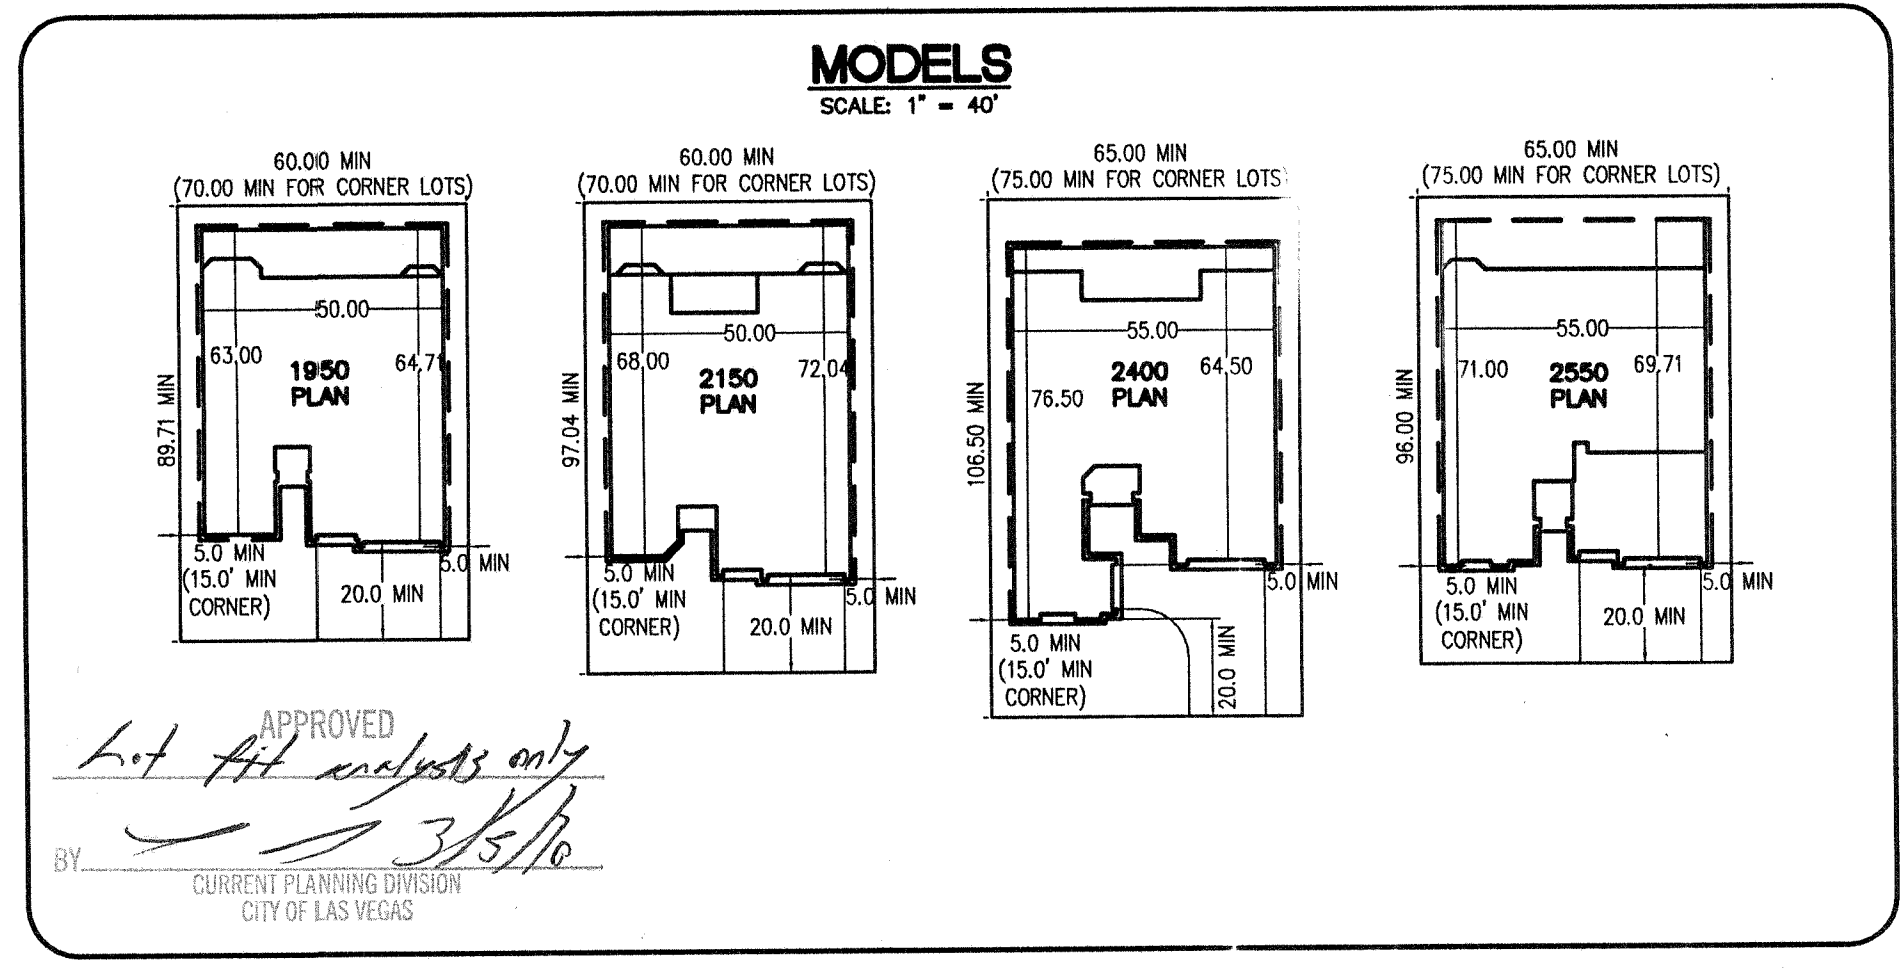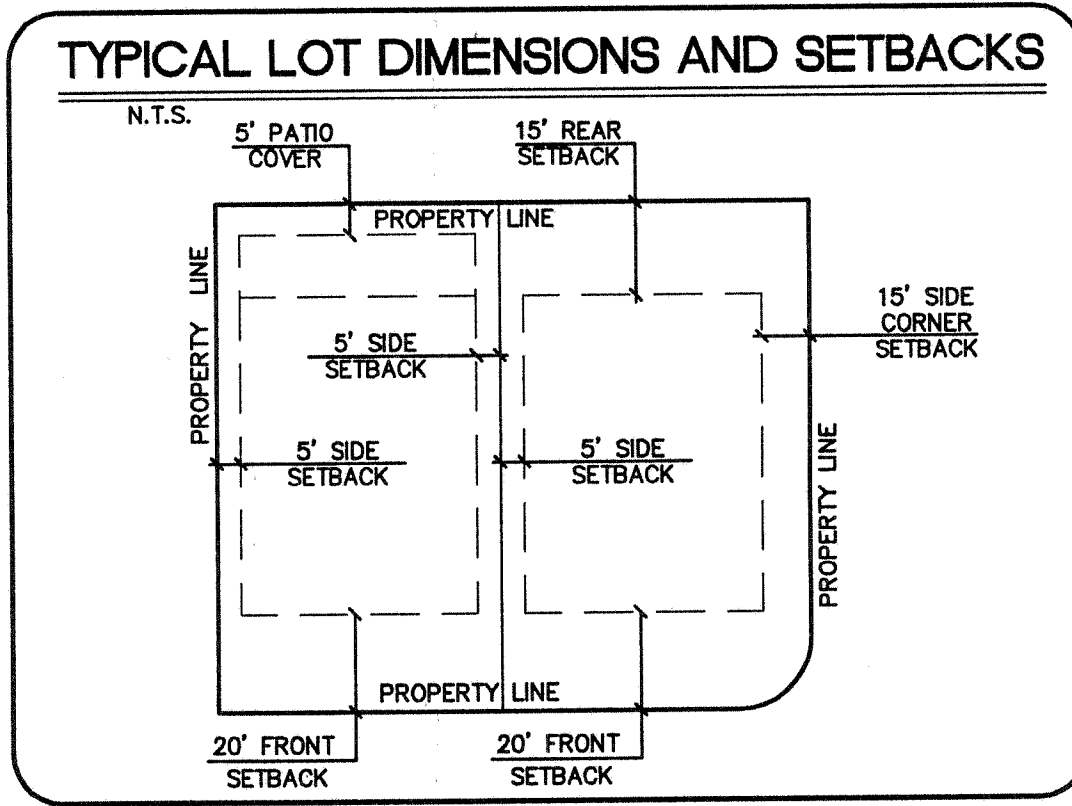

PROJECT NO. 787-053		DATE	
DESIGNER: G.C. WALLACE COMPANIES		DATE	
DRAWN: ENGINEERS PLANNERS SURVEYORS		DATE	
CHECK: 1555 S. RAINBOW BLVD. • LAS VEGAS, NV 89146		DATE	
PLOT DATE: 02-03-10		DATE	
PLOT TIME: 07:48:24		DATE	
DESCRIPTION		DATE	
DR. HORTON
BAVARIA ESTATES
LOT 4
WORST CASE SCENARIO - DEEPEST MODEL

DRAWING
LF4
4 OF 6 SHTS

37259-37261-C-10

125784
TMP-8595
FMP-10965