

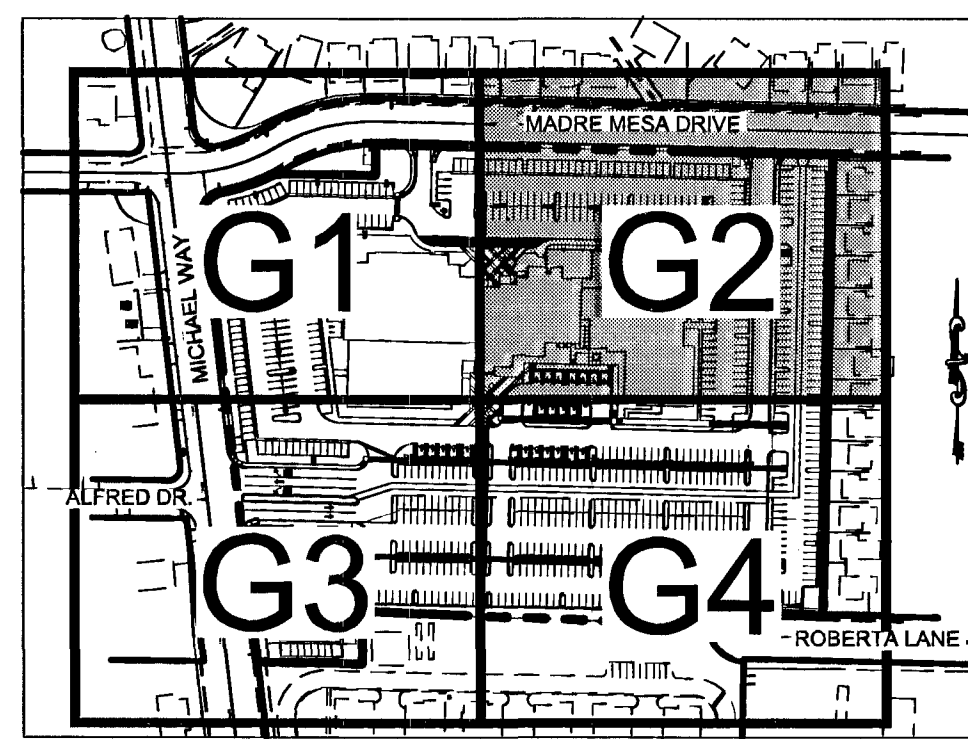


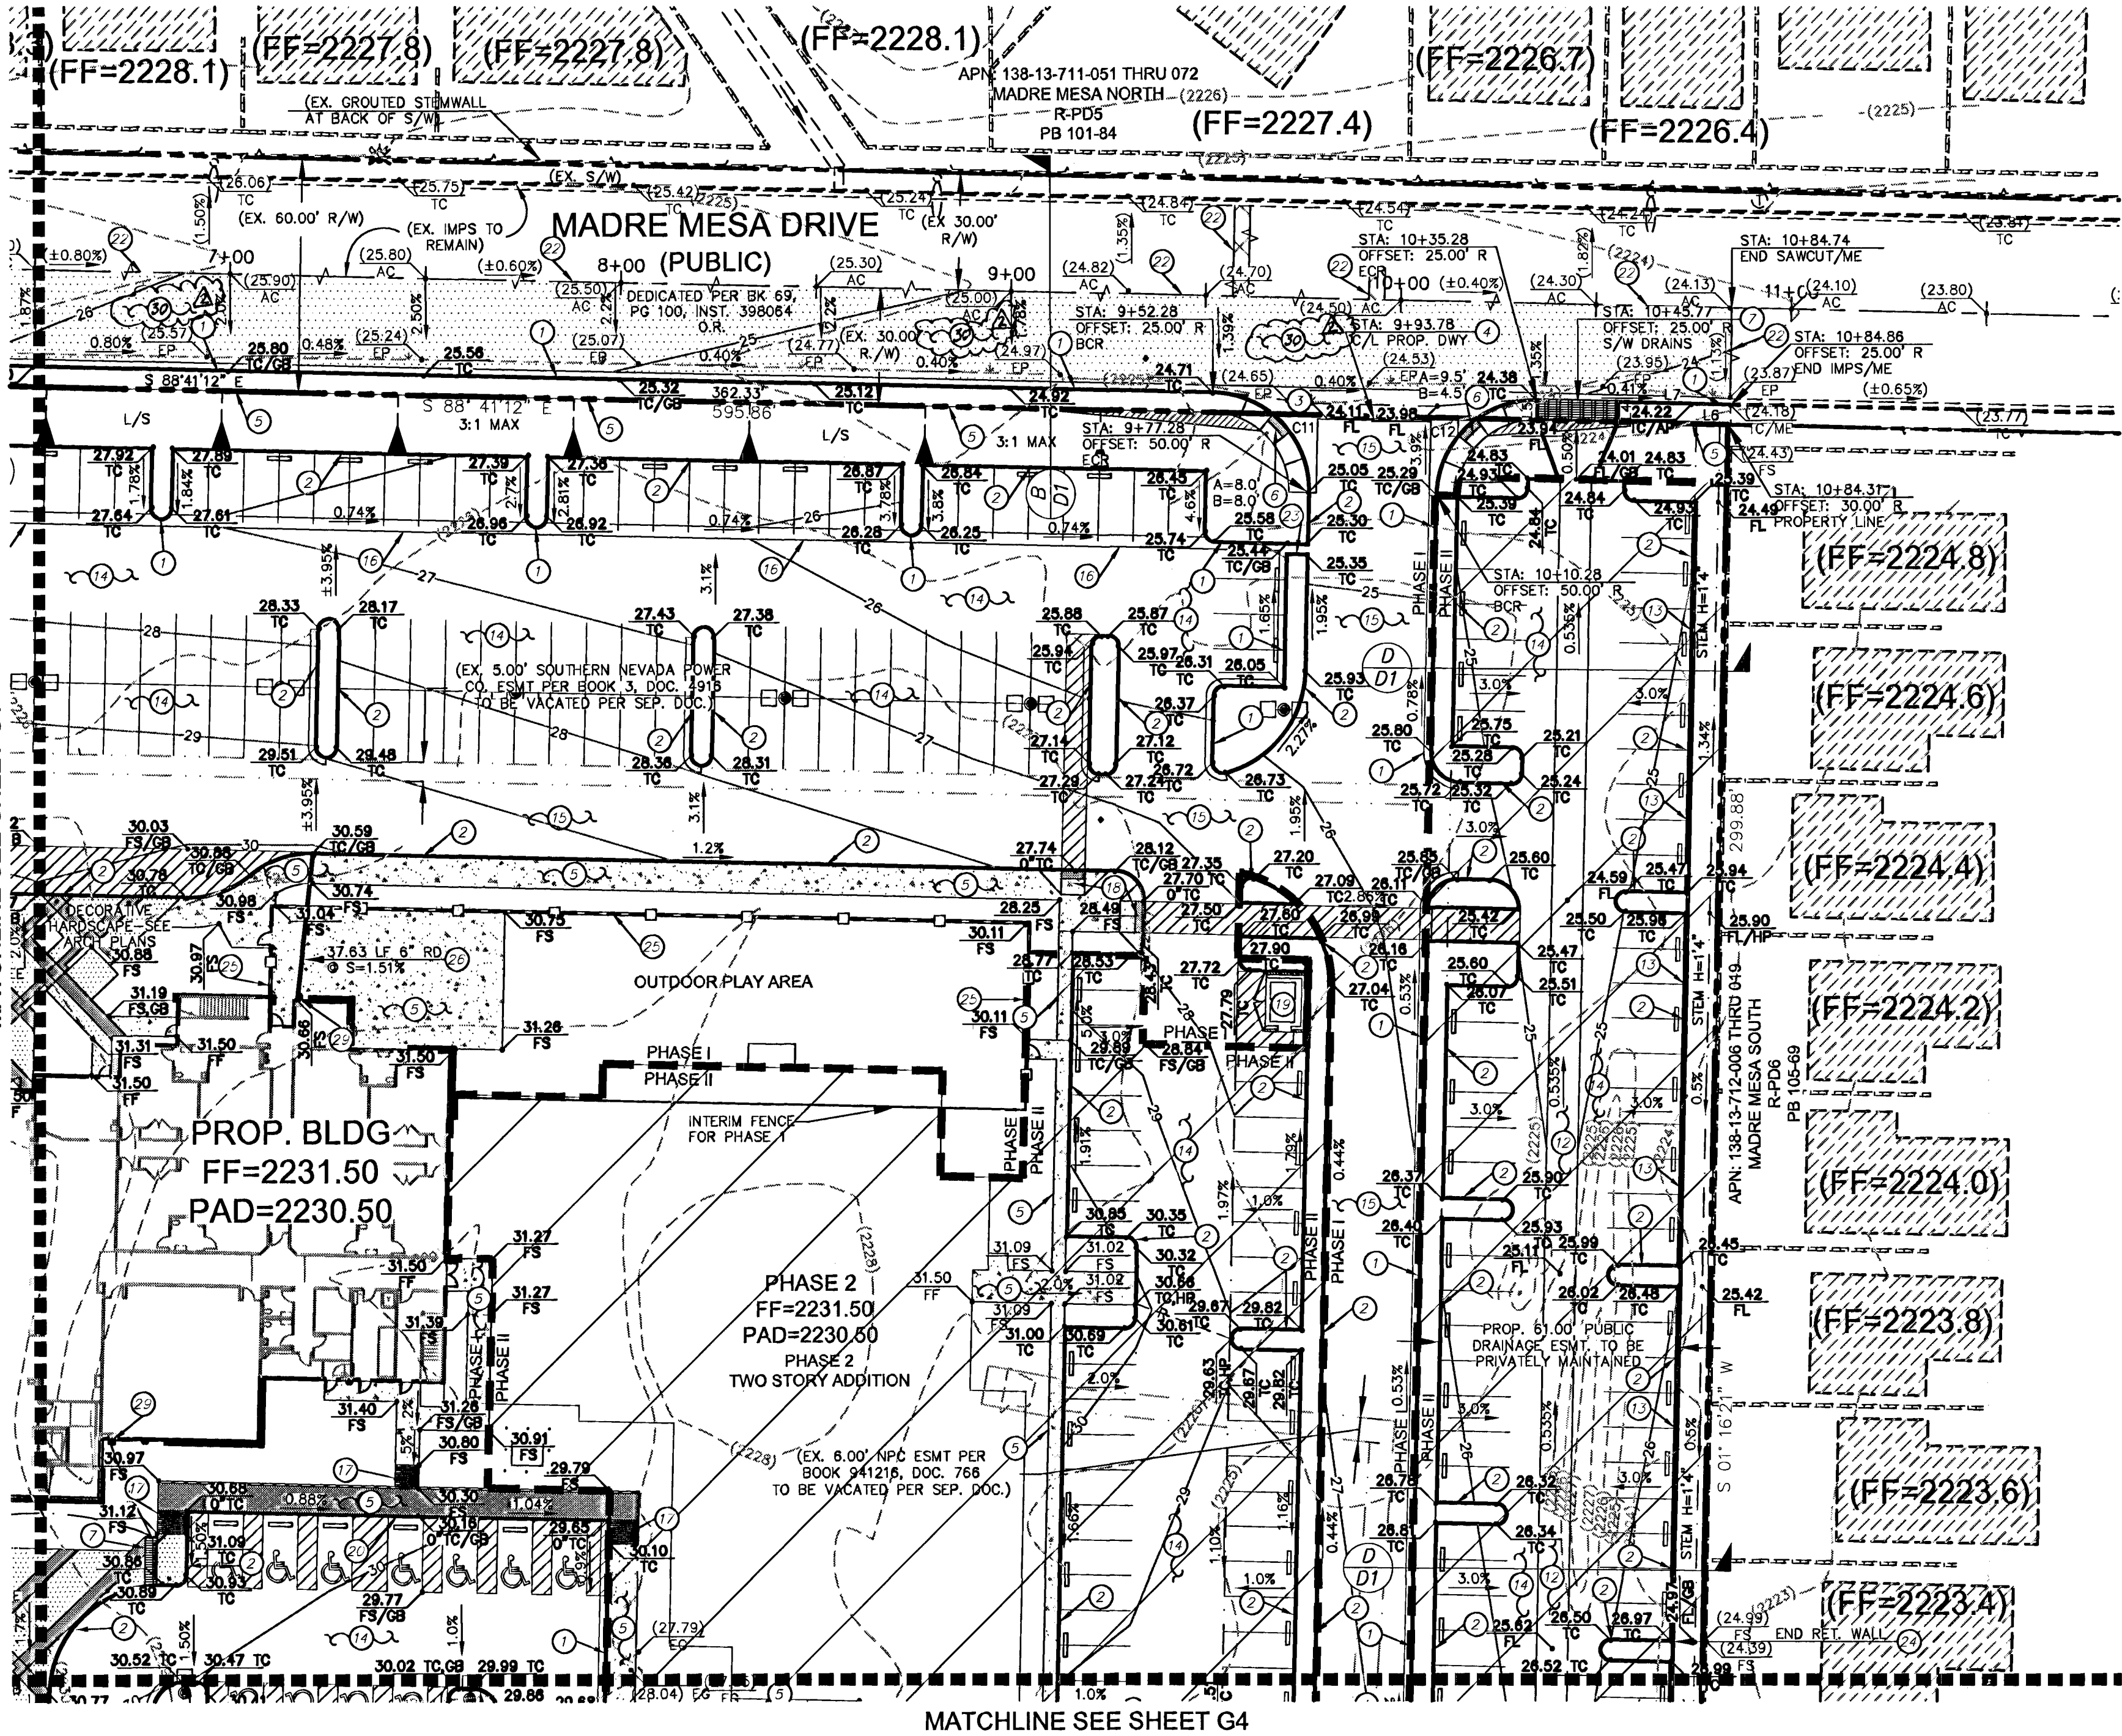

KEY MAP
N.T.S.

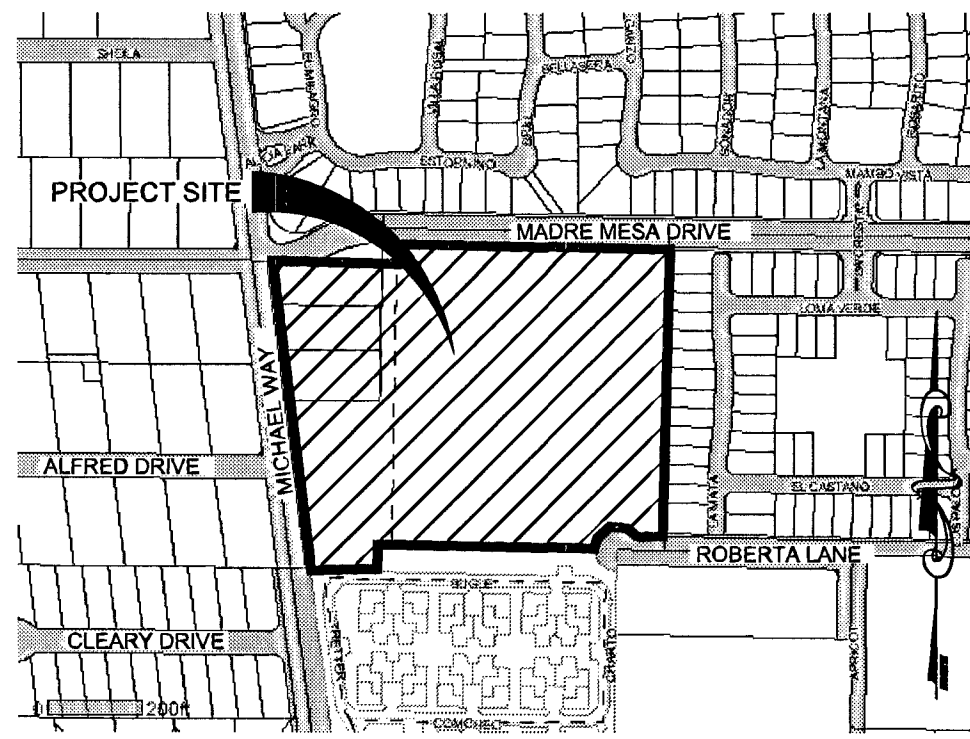

VICINITY MAP
N.T.S.

CONSTRUCTION NOTES	
NO	ITEM
1	CONSTRUCT "L" TYPE CURB AND GUTTER PER STD DWG NO. 216.
2	CONSTRUCT "A" TYPE CURB PER STD. DWG. NO. 219.
3	CONSTRUCT 8" CONCRETE CROSS GUTTER PER STD DWG NO 228
4	CONSTRUCT COMMERCIAL DRIVEWAY PER STD DWG NO 222A & 225
5	CONSTRUCT 4" SIDEWALK PER STD DWG NO. 234.
6	CONSTRUCT ADA RAMPS WITH ARMOR TILE TRUNCATED DOMES OR EQUIVALENT PER STD DWG NO 235, CASE 1
7	CONSTRUCT 2' WIDE SIDEWALK UNDERDRAIN PER STD DWG NO. 238
8	TRANSITION FROM 0" TO 6" CURB IN 10 FEET
9	TYPE I GRAVEL
10	TYPE II GRAVEL
11	CONSTRUCT 3.5" MIN AC OVER 8" TYPE II AGG. BASE PER LETTER BY JA CESARE DATED 9/26/11
12	CONSTRUCT 8" WIDE CROSS GUTTER PER DETAIL 7 ON SHEET D1
13	CONSTRUCT 1/2" SLOPED GROUTED STEM WALL WITH TOP CURB & TOP PERMIT BY OTHERS - SEE ARCHITECTURAL PLANS FOR DETAILS
14	CONSTRUCT 2" MIN AC OVER 8" TYPE II AGG. BASE PER SOILS REPORT BY JA CESARE. SEE DETAIL 1 ON SHEET D1
15	CONSTRUCT 2.5" MIN AC OVER 9" TYPE II AGG. BASE PER SOILS REPORT BY JA CESARE. SEE DETAIL 2 ON SHEET D1
16	CONSTRUCT 3" WIDE VALLEY GUTTER PER DETAIL 3 ON SHEET D1
17	CONSTRUCT ON-SITE RAMP PER DETAIL 4 ON SHEET D1.
18	CONSTRUCT ON-SITE RAMP PER DETAIL 5 ON SHEET D1.
19	CONSTRUCT TRASH ENCLOSURE PER ARCHITECTURAL PLAN (BY OTHERS)
20	CONSTRUCT 0" CURB
21	CONSTRUCT HALF OF CUL-DE-SAC PER STD DWG NO. 212
22	SAWCUT AND MATCH EXISTING PAVEMENT.
23	CONSTRUCT 2' WIDE CONCRETE FLUME PER DETAIL 6 ON SHEET D1
24	CONSTRUCT RETAINING WALL (H MAX=3'4") PER SEP. PERMIT BY OTHERS
25	CONSTRUCT SCREEN WALL PER SEP. PERMIT BY OTHERS
26	INSTALL 8" PVC ROOF DRAIN PIPE. TRANSITION TO 3"x12 1/2" RECTANGULAR PIPE THROUGH CURB. ALHAMBRA A-480 ADAPTOR OR EQUAL
27	INSTALL 4" PVC ROOF DRAIN PIPE. TRANSITION TO 3"x5" RECTANGULAR PIPE THROUGH CURB. ALHAMBRA A-480 ADAPTOR OR EQUAL
28	INSTALL 3" PVC ROOF DRAIN PIPE THROUGH CURB
29	ROOF DRAIN TO SPILL TO GRADE-SEE ARCH. PLANS FOR SPASH BLOCK DETAILS
30	CONSTRUCT 3.5" MIN AC OVER EXISTING 8" MIN. TYPE II AGG. BASE PER LETTER BY JA CESARE DATED 9/26/11

STORM DRAIN CONSTRUCTION NOTES			
NO	ITEM	DATE	INITIALS
1	INSTALL 24" BEEHIVE INLET WITH CONCRETE APRON PER CC STD. DWG. NO. 416. SEE DETAIL 1 ON SHEET D2.	9/13/11	TS
2	INSTALL 18" CLASS III RCP STORM DRAIN PIPE		
3	INSTALL 18" RCP END SECTION PER NDOT DETAIL R-2.3.1. SEE DETAIL 2 ON SHEET D2.		
4	INSTALL CLEAN OUT		

DRAINAGE FACILITIES BONDABLE QUANTITIES LIST				
ITEM	UNIT	PHASE I	PHASE II	
24" BEEHIVE INLET	EA	1	-	
18" STORM DRAIN	EA	294	-	
2" S/W DRAINS	EA	7	-	
"L" CURB	LF	448	158	
"A" CURB	LF	453	1373	
8" CROSS GUTTER	SF	4276	3791	
1'4" STEM WALL	LF	403	456	
4" SIDEWALK	SF	858	-	

EARTHWORK QUANTITIES

*NOTE: THESE QUANTITIES ARE APPROXIMATE AND ARE RAW VOLUMES ONLY. OVEREXCAVATION SUBSIDENCE, SHRINKAGE, & BULKING FACTORS ARE NOT TAKEN INTO ACCOUNT.

CUT = 15,418 CY
FILL = 15,609 CY

*NOTE: THESE QUANTITIES ARE FOR ULTIMATE BUILD OUT.

SIGHT VISIBILITY ZONES NOTE

NO WALLS, FENCES, TREES, SHRUBS, UTILITY APPURTENANCES OR ANY OTHER OBJECT, OTHER THAN TRAFFIC CONTROL DEVICES AND STREET LIGHT POLES, MAY BE CONSTRUCTED OR INSTALLED WITHIN THE SIGHT VISIBILITY ZONE UNLESS SAID OBJECT IS MAINTAINED AT LESS THAN 24 INCHES IN HEIGHT, MEASURED FROM THE TOP OF CURB.

NOTE

ALL DIMENSIONS ARE TO BACK OF CURB UNLESS OTHERWISE NOTED.

NOTE

OWNER RESPONSIBLE TO PROVIDE SURVEY MONUMENTATION AS SHOWN AND TO REPLACE ALL SURVEY MONUMENTATION DAMAGED, DISTURBED, DESTROYED, OR OBSOLETE DURING CONSTRUCTION.

I CERTIFY THAT THIS GRADING PLAN IS IN CONFORMANCE WITH THE APPROVED DRAINAGE STUDY ON FILE WITH CITY OF LAS VEGAS FOR THIS PROJECT, CLV# D54380.
TREASEA WOLF, P.E. No. 17879
DATE: 2/14/11


ENGINEER'S NOTES

- ALL WORK SHALL CONFORM TO THE SOILS REPORT PREPARED BY JA CESARE DATED OCTOBER 13, 2009, PROJECT NO. 09.1180, ADDENDUM DATED JUNE 22, 2010 & UPDATE DATED FEBRUARY 16, 2011.
- ALL OFF-SITE IMPROVEMENT CONSTRUCTION SHALL CONFORM TO THE "UNIFORM STANDARD SPECIFICATIONS FOR PUBLIC WORKS CONSTRUCTION, OFF-SITE IMPROVEMENTS, CLARK COUNTY AREA, NEVADA", LATEST EDITION. (IF APPLICABLE)
- FINAL ASPHALTIC CONCRETE (AC) PAVEMENT SURFACES SHALL BE ONE-HALF INCH ABOVE THE TOP OF THE GUTTER (INCLUDING OPEN GRADE).
- SEE ARCHITECTS PLANS FOR ALL HANDICAP ACCESSIBILITY INFORMATION, RAMP DETAILS, TRANSFORMERS, AND TRASH ENCLOSURE DETAILS. VERIFY BUILDING LAYOUTS AND DIMENSIONS WITH ARCHITECTURAL PLANS.
- CONTRACTOR IS RESPONSIBLE FOR DUST AND EROSION CONTROL DURING CONSTRUCTION.
- SEE LANDSCAPE PLANS FOR LANDSCAPING AND ONSITE IRRIGATION.
- THIS PLAN SHALL NOT, IN PART OR IN WHOLE, BE USED FOR CONSTRUCTION UNTIL APPROVED AND SIGNED BY ALL APPLICABLE GOVERNMENT AGENCIES.
- ENGINEER TO BE NOTIFIED OF ANY DISCREPANCIES IMMEDIATELY.
- ALL MATCH ELEVATIONS SHOWN TO BE VERIFIED BY CONTRACTOR PRIOR TO CONSTRUCTION.

LEGEND

PROPERTY LINE	SCARP
STREET CENTERLINE	SLOPE
PROPOSED RETAINING WALL	FLOW LINE
PROPOSED BUILDING	EASEMENT LINE
EXISTING CONTOUR	HANDICAP PARKING
PROPOSED CONTOUR	FINISHED SURFACE
PROPOSED CURB & GUTTER	CURB FACE
PROPOSED CURB	CURB BACK
EXISTING CURB & GUTTER	EDGE OF PAVEMENT
EXISTING CURB	TOP OF GRATE
CONSTRUCTION NOTE	PROPOSED GRADE
CUT FILL TRANSITION	EXISTING GRADE
SAWCUT LIMITS	
PHASE LIMITS	NEW AC PAVEMENT
AGENCY JURISDICTIONAL LIMITS	PHASE II

GRAPHIC SCALE

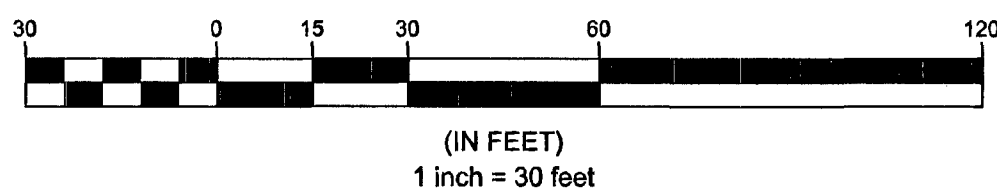

FLOODZONE

THIS PROJECT IS LOCATED IN (NON-SHADED) FLOOD ZONE X PER FEMA FLOOD INSURANCE MAP NUMBER 32003C2155E, REVISED TO REFLECT LOMR DATED DECEMBER 31, 2003. FLOOD ZONE X IS DEFINED AS AN AREA BEING OUTSIDE THE 0.2% ANNUAL CHANCE FLOODING OR AN AREA OF 1% ANNUAL CHANCE FLOODING WITH AVERAGE DEPTHS OF LESS THAN 1 FOOT OR WITH DRAINAGE AREAS LESS THAN 1 SQUARE MILE.

BENCHMARK

THE ELEVATION DATA SHOWN HEREON ARE U.S. SURVEY FEET REFERENCED TO THE NORTH AMERICAN VERTICAL DATUM OF 1988. CLARK COUNTY VERTICAL CONTROL, 2003, BASED UPON BENCHMARK NO. 75, STATION "5LV00 1356" BEING A CITY OF LAS VEGAS PIN AND PLATE IN THE TOP OF CURB AT THE NORTHWEST CORNER OF MICHAEL WAY AND CLEARLY COURT, NEAR THE PT OF MICHAEL WAY.

ELEVATION 679.849 METERS - PUBLISHED
ELEVATION 2,230.47 U.S. SURVEY FEET - COMPUTED

LEGAL DESCRIPTION

THAT PORTION OF THE NORTHWEST QUARTER (NW 1/4) OF THE SOUTHEAST QUARTER (SE 1/4) OF SECTION 13, TOWNSHIP 20 SOUTH, RANGE 60 EAST, M.D.M., CLARK COUNTY, NEVADA,

BASIS OF BEARINGS

THE BASIS OF BEARINGS FOR THIS RECORD OF SURVEY IS NORTH 06° 42' 12" WEST AS DEFINED BY THE MONUMENTS SHOWN HEREON, BEING THE NORTH-SOUTH CENTER SECTION LINE OF SECTION 13, TOWNSHIP 20 SOUTH, RANGE 60 EAST, MOUNT DIABLO MERIDIAN, CITY OF LAS VEGAS, CLARK COUNTY, NEVADA, ESTABLISHED BY STRAIGHT LINE INTERSECTION BETWEEN OPPOSING ONE-QUARTER CORNERS PER FILE 02, PAGE 23 OF SURVEYS, SAME BEING THE CONTROL LINE OF MICHAEL WAY AS DERIVED BY FILE 02, PAGE 23 OF SURVEYS.


CURVE & LINE DATA

PROPERTY LINE LINE TABLE		
LINE	LENGTH	BEARING
L1	39.63	S01°27'20"W
L2	52.99	S87°37'05"E

BACK OF CURB LINE TABLE		
LINE	LENGTH	BEARING
L3	28.99	N88°38'13"W
L4	5.00	S01°14'28"W
L5	5.00	S01°28'18"W
L6	9.99	S88°44'13"E
L7	18.61	S88°41'12"E
L8	5.01	S70°21'54"E
L9	5.00	S70°21'54"E
L10	5.00	S01°18'48"W
L11	5.00	S01°18'48"W
L12	10.00	S86°55'51"E
L13	18.32	S87°37'05"E
L14	24.05	S87°37'05"E
L15	10.00	N08°53'37"W


PROPERTY LINE CURVE TABLE				
CURVE	LENGTH	RADIUS	DELTA	TANGENT
C1	76.43	280.00	15°38'22"	38.45
C2	37.49	25.00	85°58'09"	23.28
C3	115.12	45.50	144°57'54"	144.15
C4	13.91	14.50	54°57'54"	7.54

BACK OF CURB CURVE TABLE				
CURVE	LENGTH	RADIUS	DELTA	TANGENT
C5	42.77	25.00	98°01'00"	28.77
C6	35.77	25.00	81°59'00"	21.73
C7	44.99	30.00	85°58'09"	27.94
C8	73.29	275.00	15°18'11"	36.86
C9	39.23	25.00	85°58'09"	24.98
C10	39.27	25.00	90°00'00"	25.00
C11	39.27	25.00	90°00'00"	25.00
C12	39.25	25.00	89°57'33"	24.98
C13	18.71	19.50	54°57'54"	10.14
C14	0.05	40.50	0°04'23"	0.03
C15	25.01	40.50	35°27'14"	12.92
C16	87.27	40.50	123°27'51"	75.32

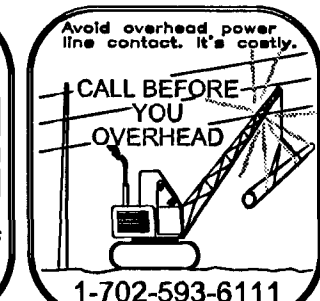

WIE

WALKER ENGINEERING, LLC
5765 S. RAINBOW BLVD.
SUITE 101
LAS VEGAS, NV 89118
TEL: 702.873.5197
FAX: 702.873.5346

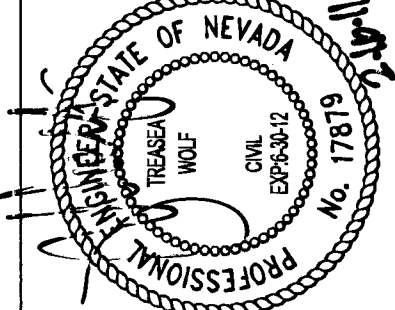

APPROVAL
DATE: 9/13/11
INITIALS: TS

REVISIONS
DATE: 9/13/11
REV: 1
DESCRIPTION: REVISE PAVEMENT SECTIONS FOR MICHAEL & MADRE MESA

CATALYST CONSULTING COMPANY
AGUILAS CFC CHURCH

PRECISE GRADING PLAN
SHEET 2 OF 4
H37715

CC HTE: 10-10763
SUBMITTAL NO. FINAL
DATE: FEBRUARY 16, 2011
WE PROJECT NO.

1167.00
AGENCY NO.
CLV:37715

SHEET NO.:
G2

11 OF 27 SHEETS

CLV DRAWING NO. 107V 5608-1