
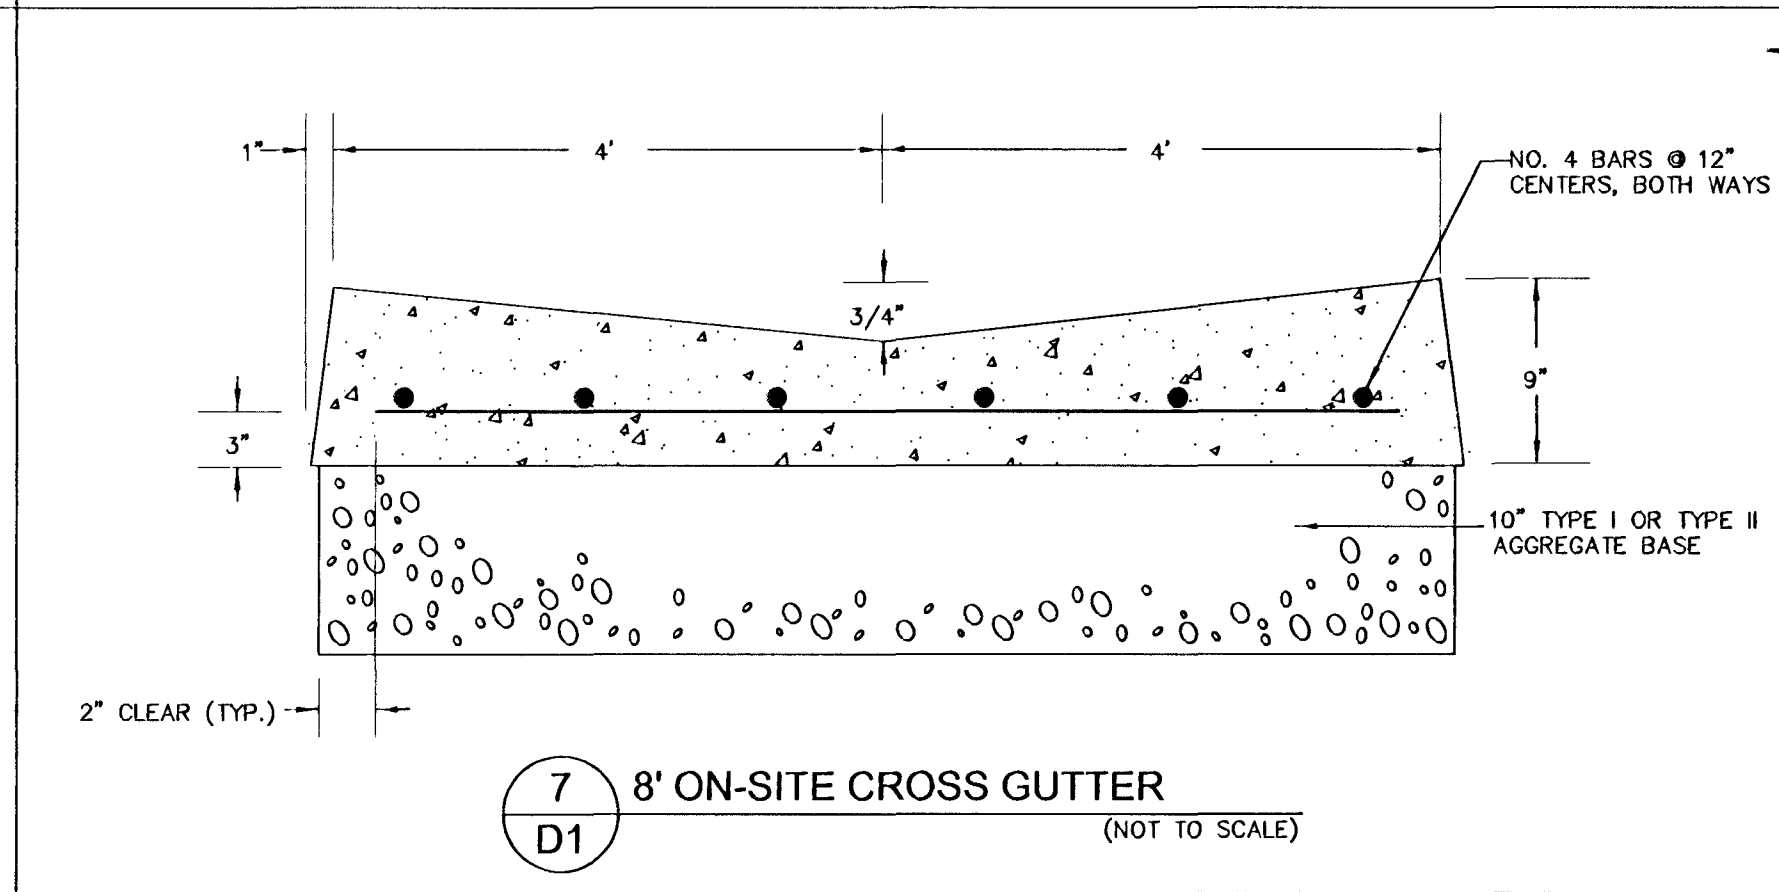
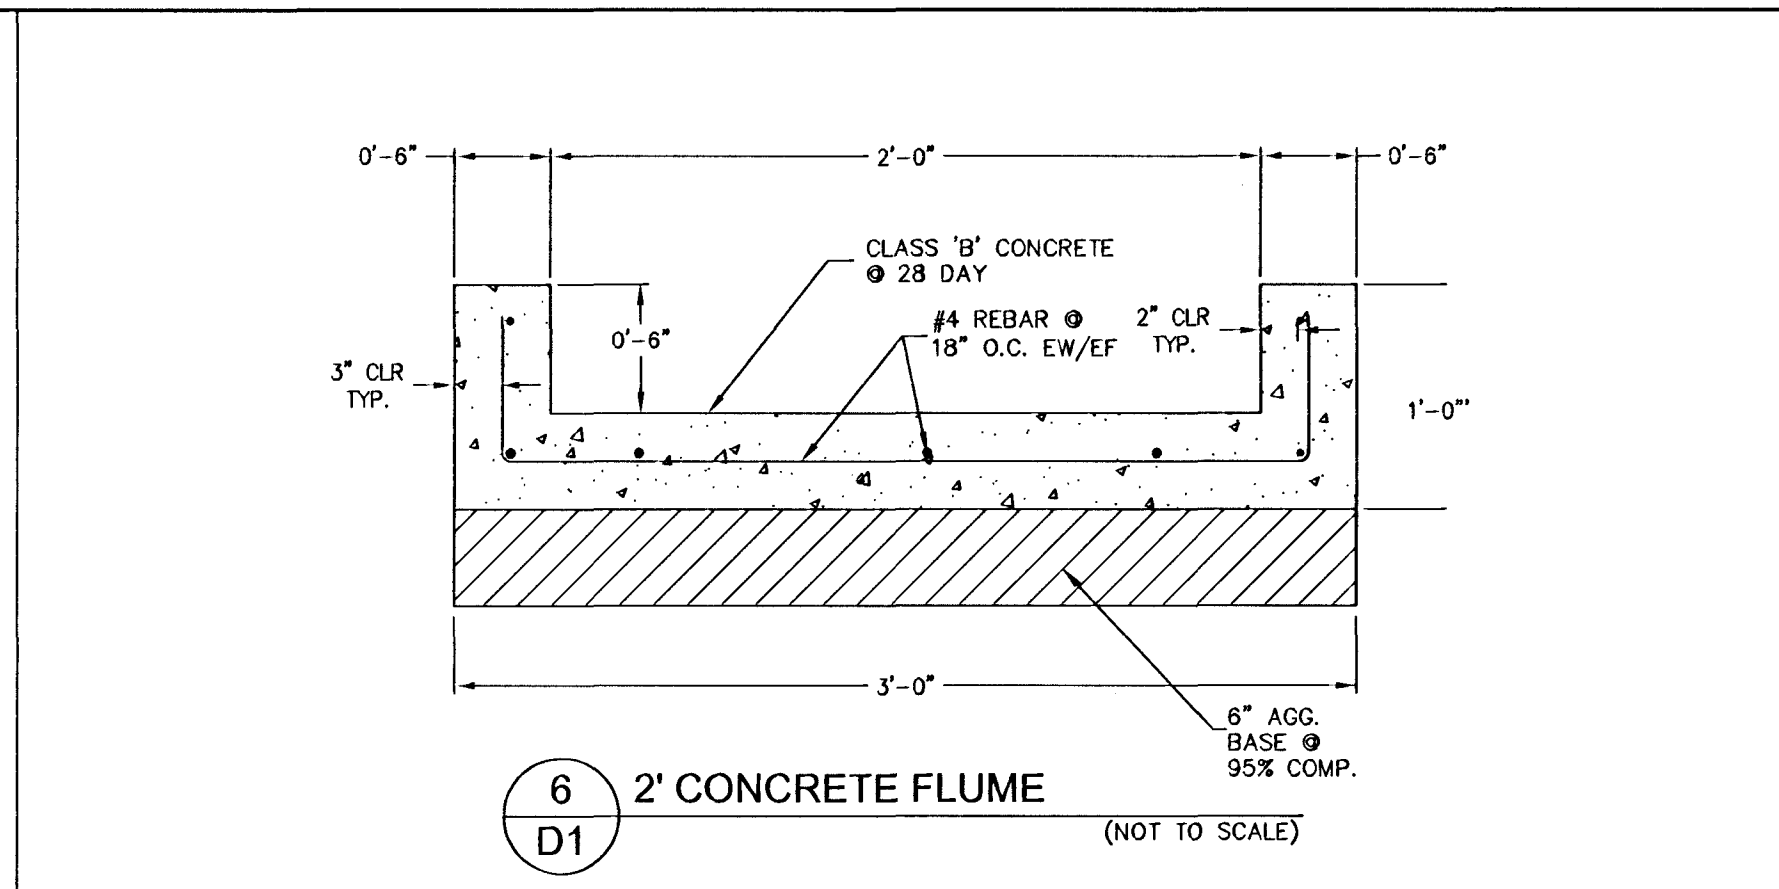
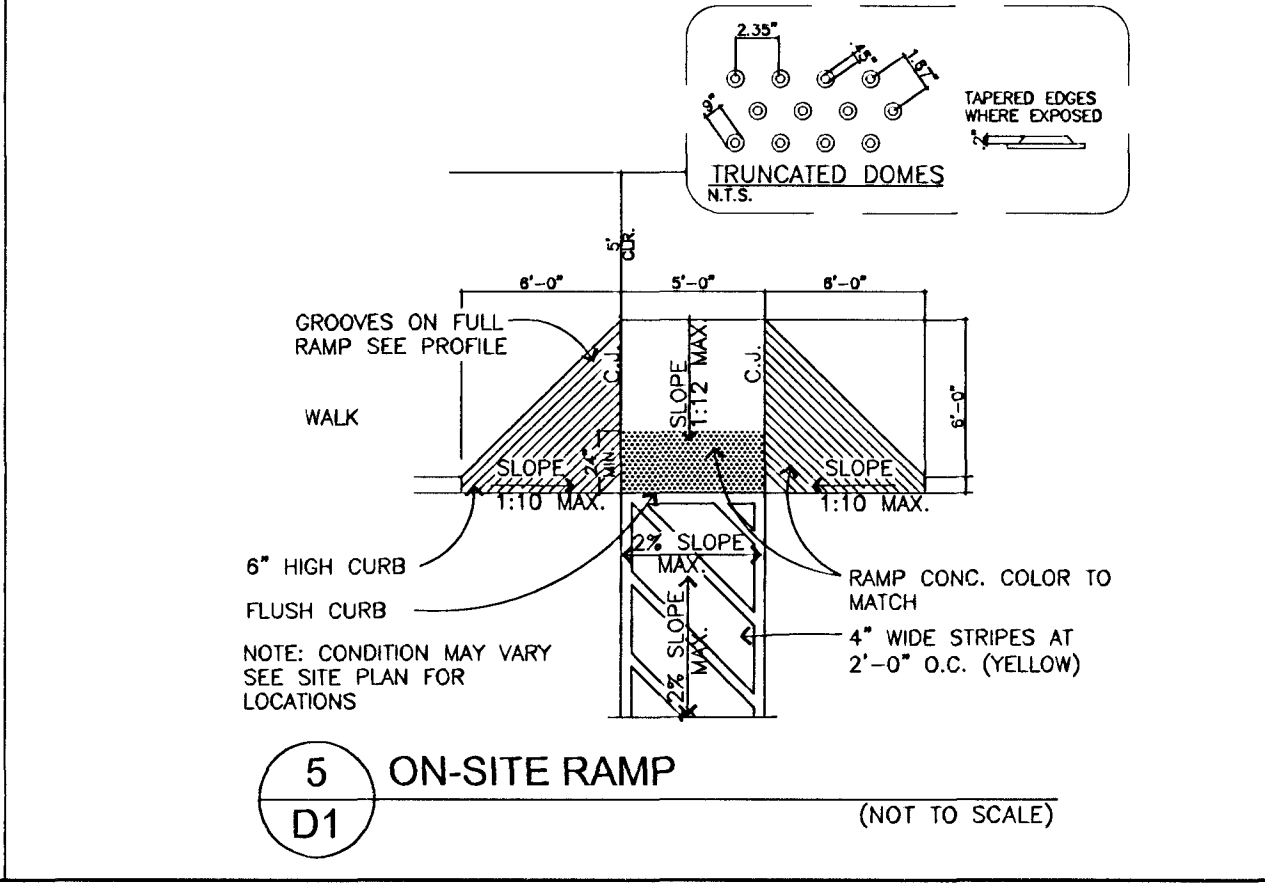
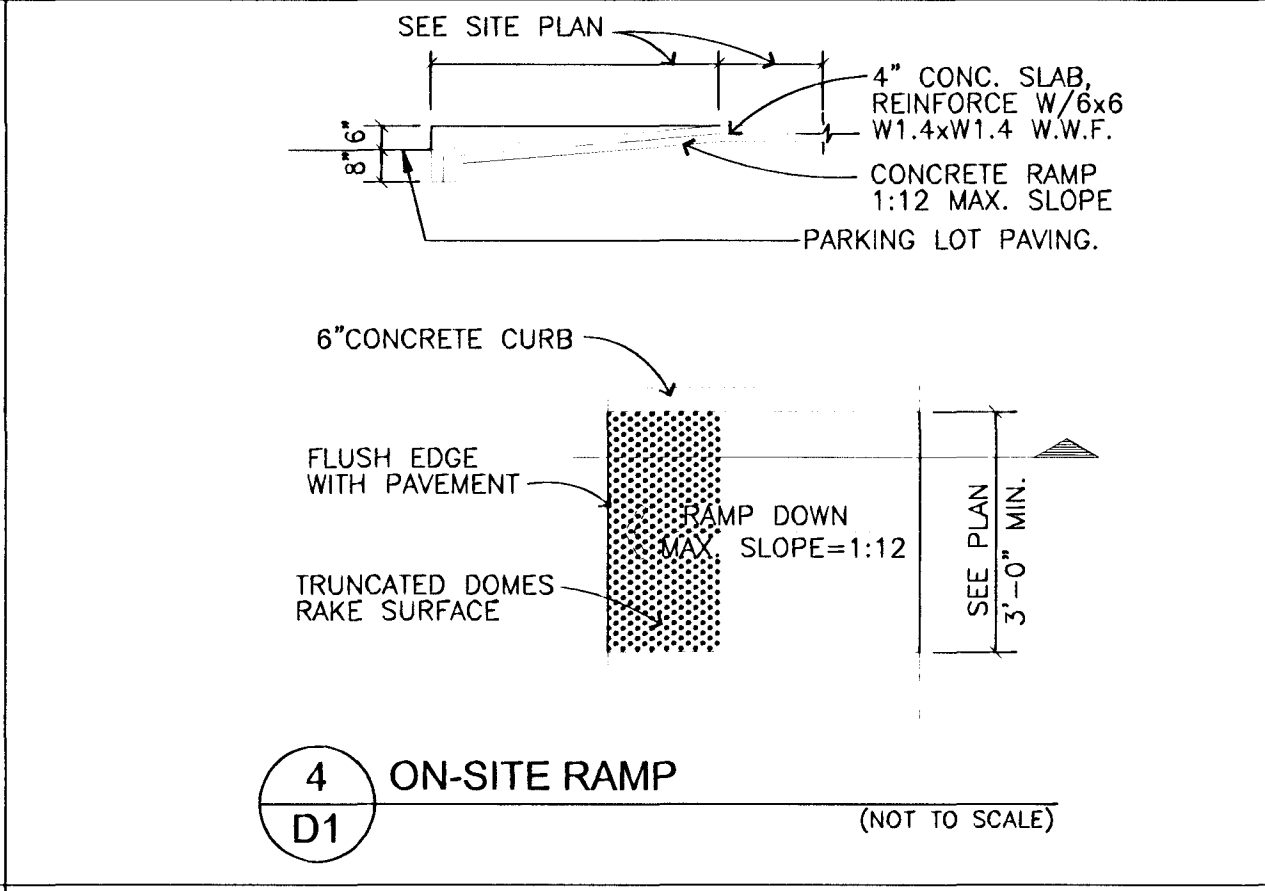
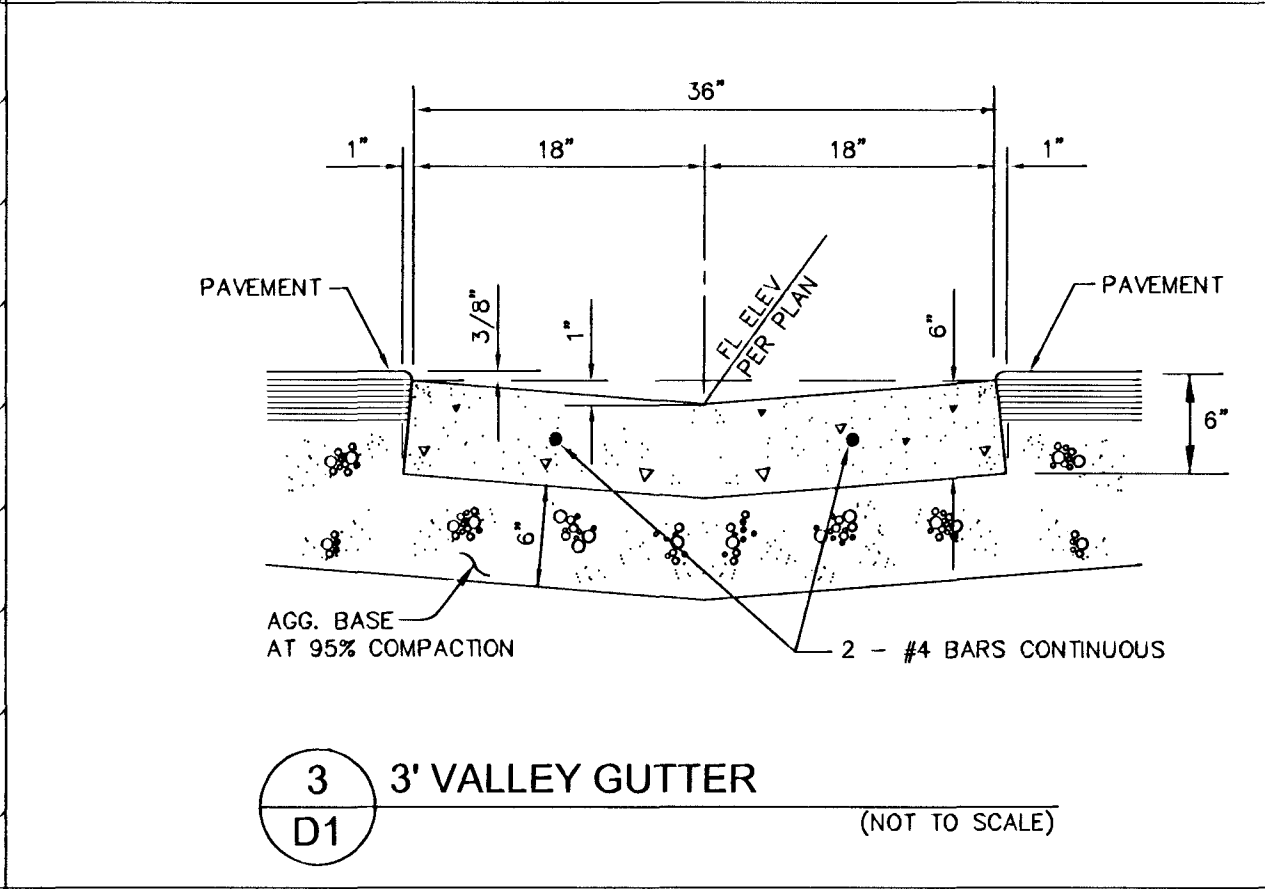
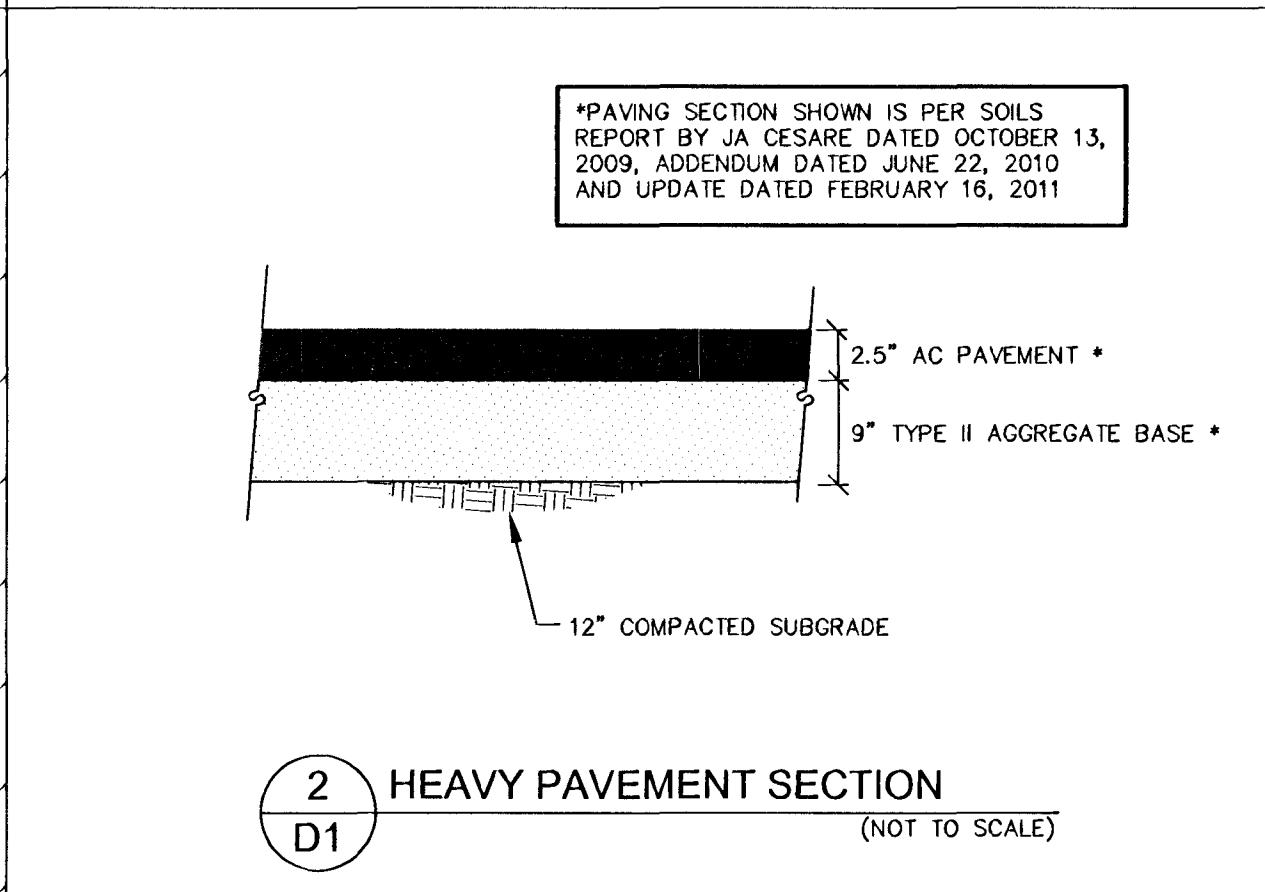
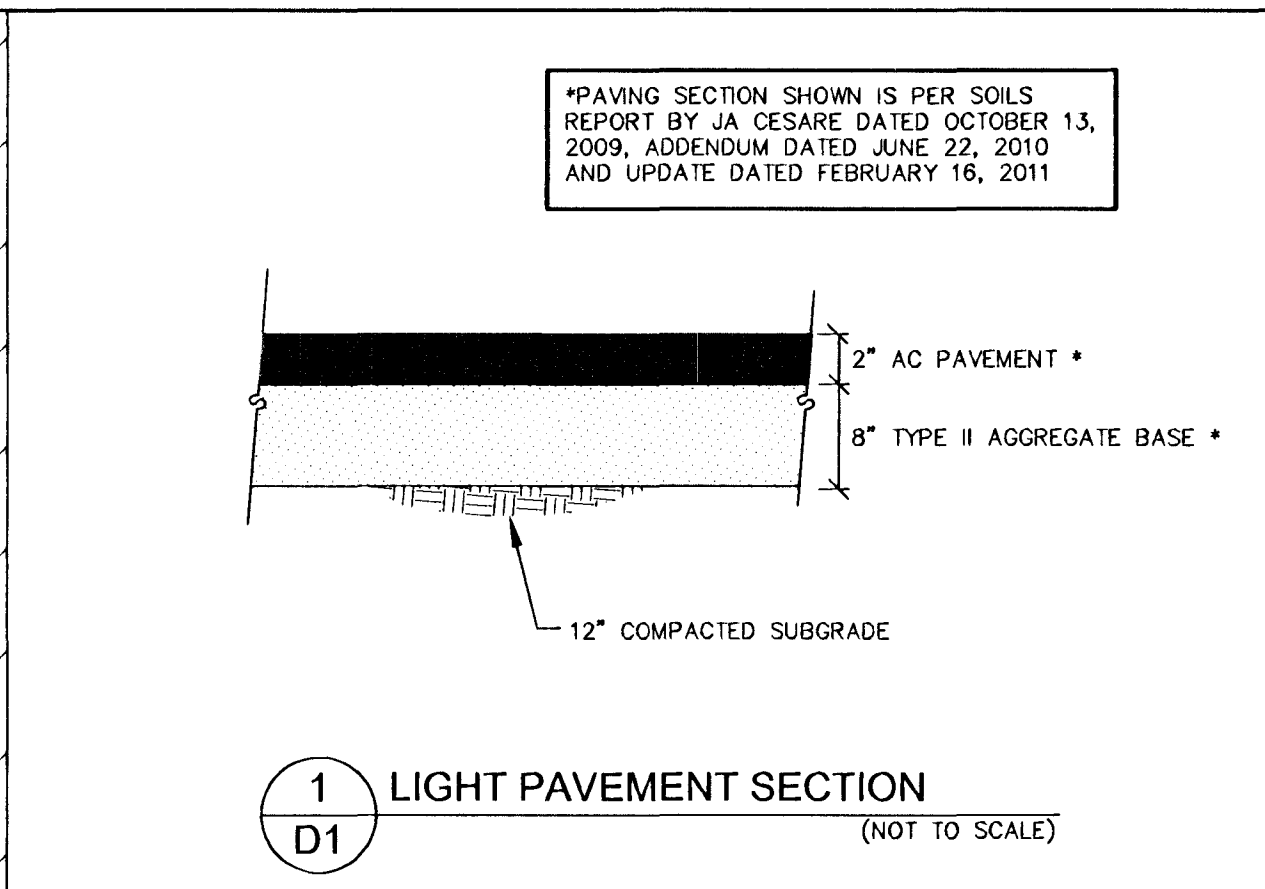
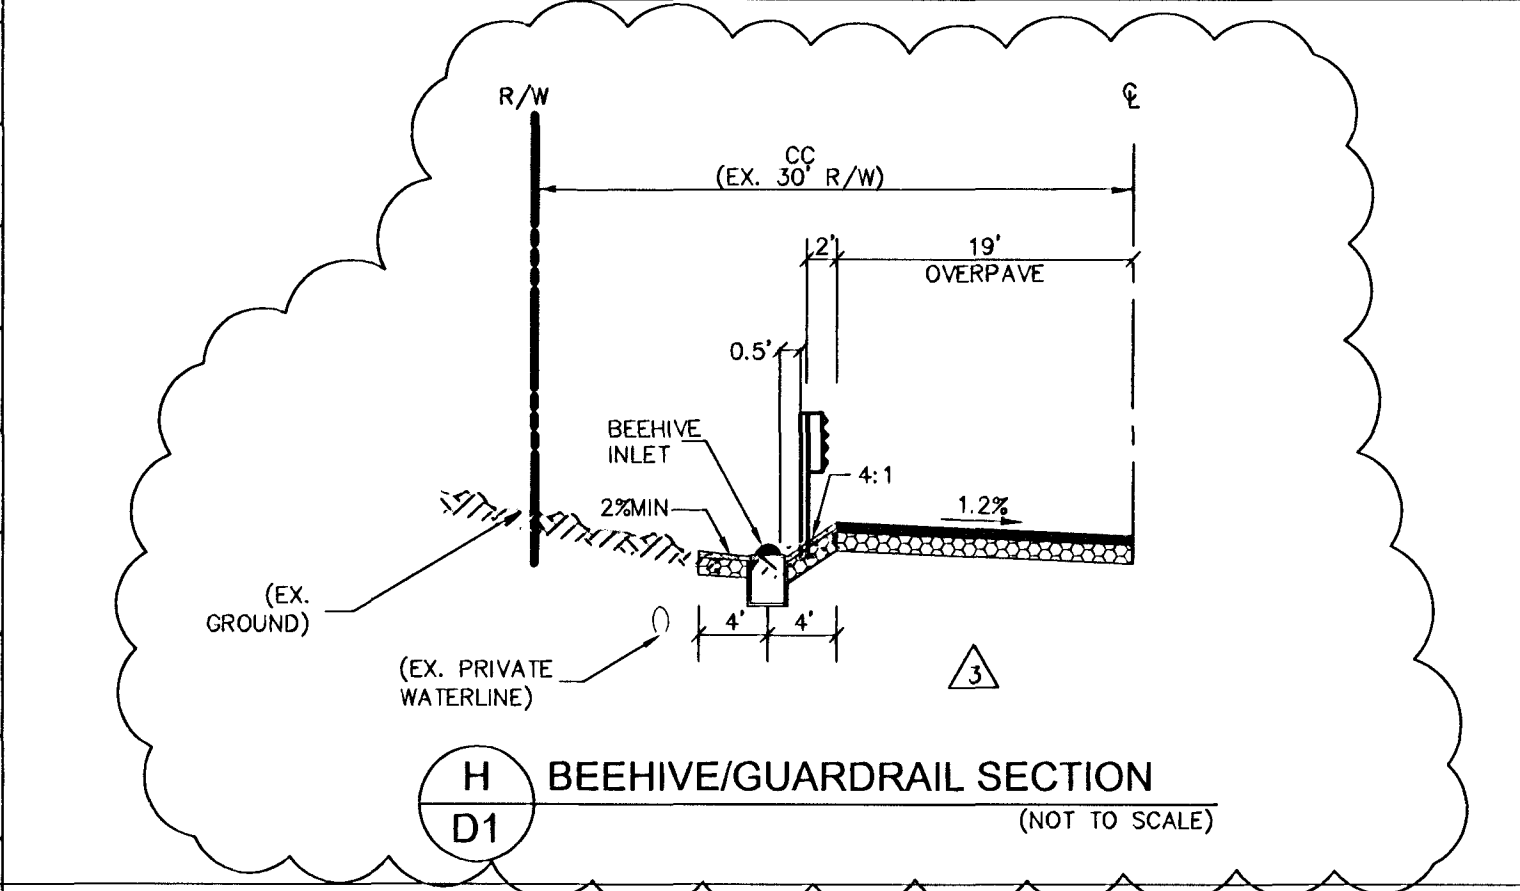
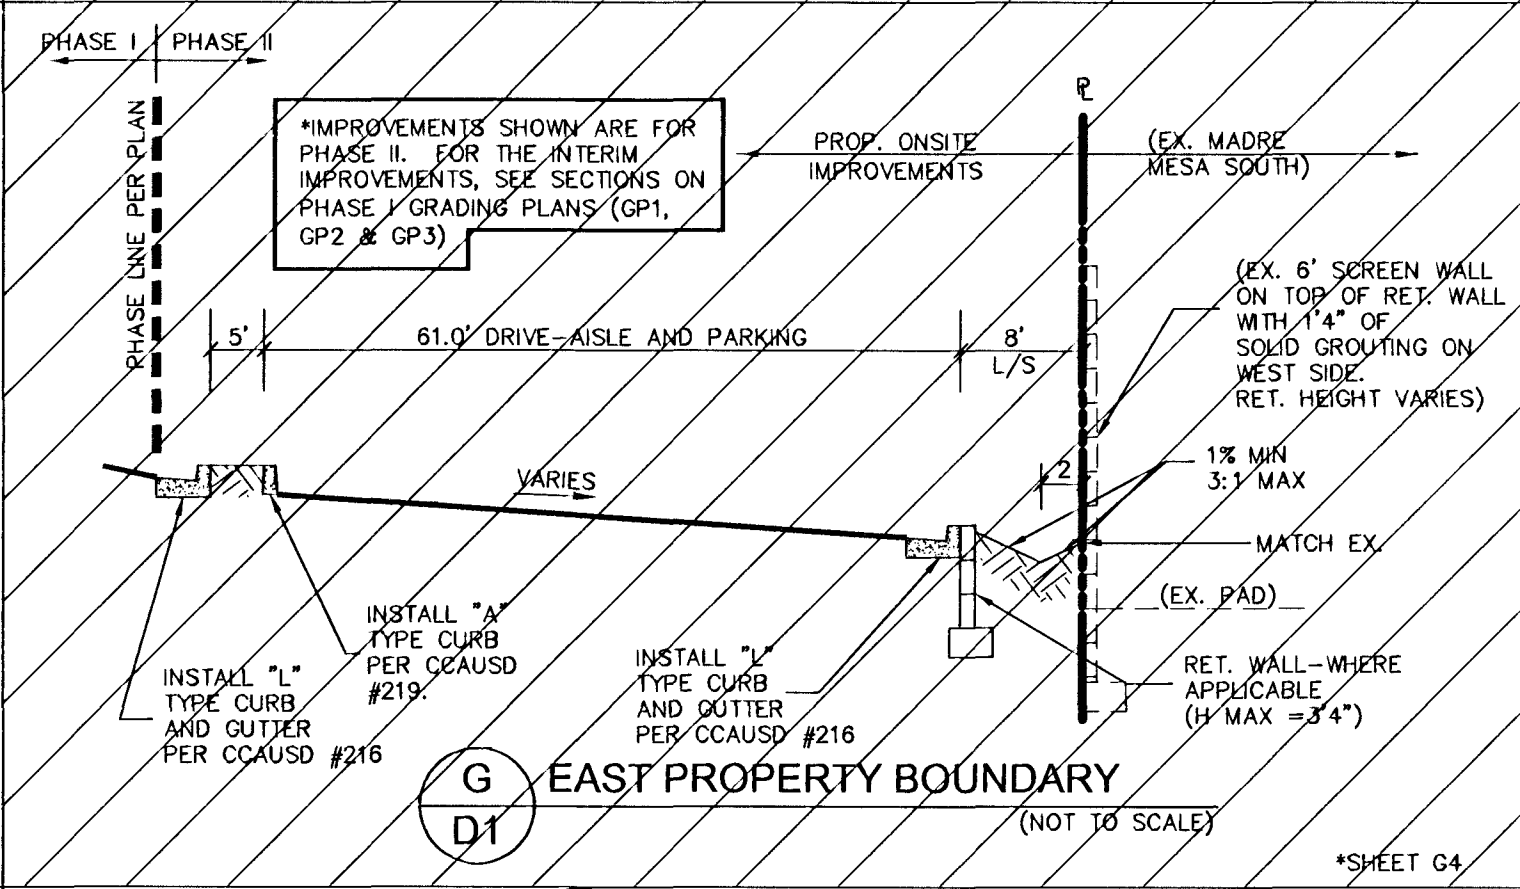
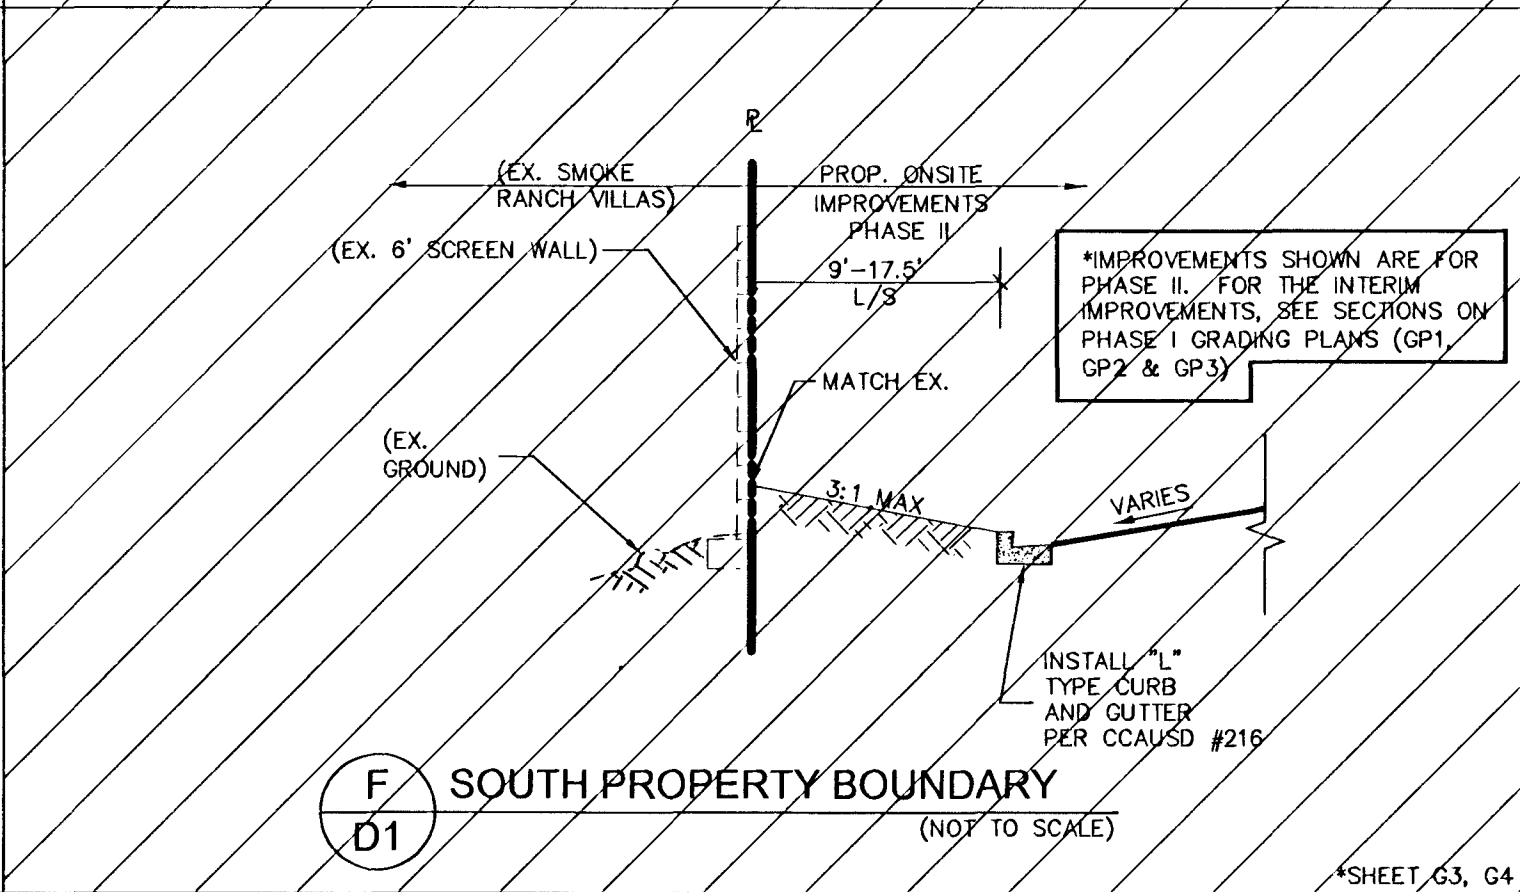
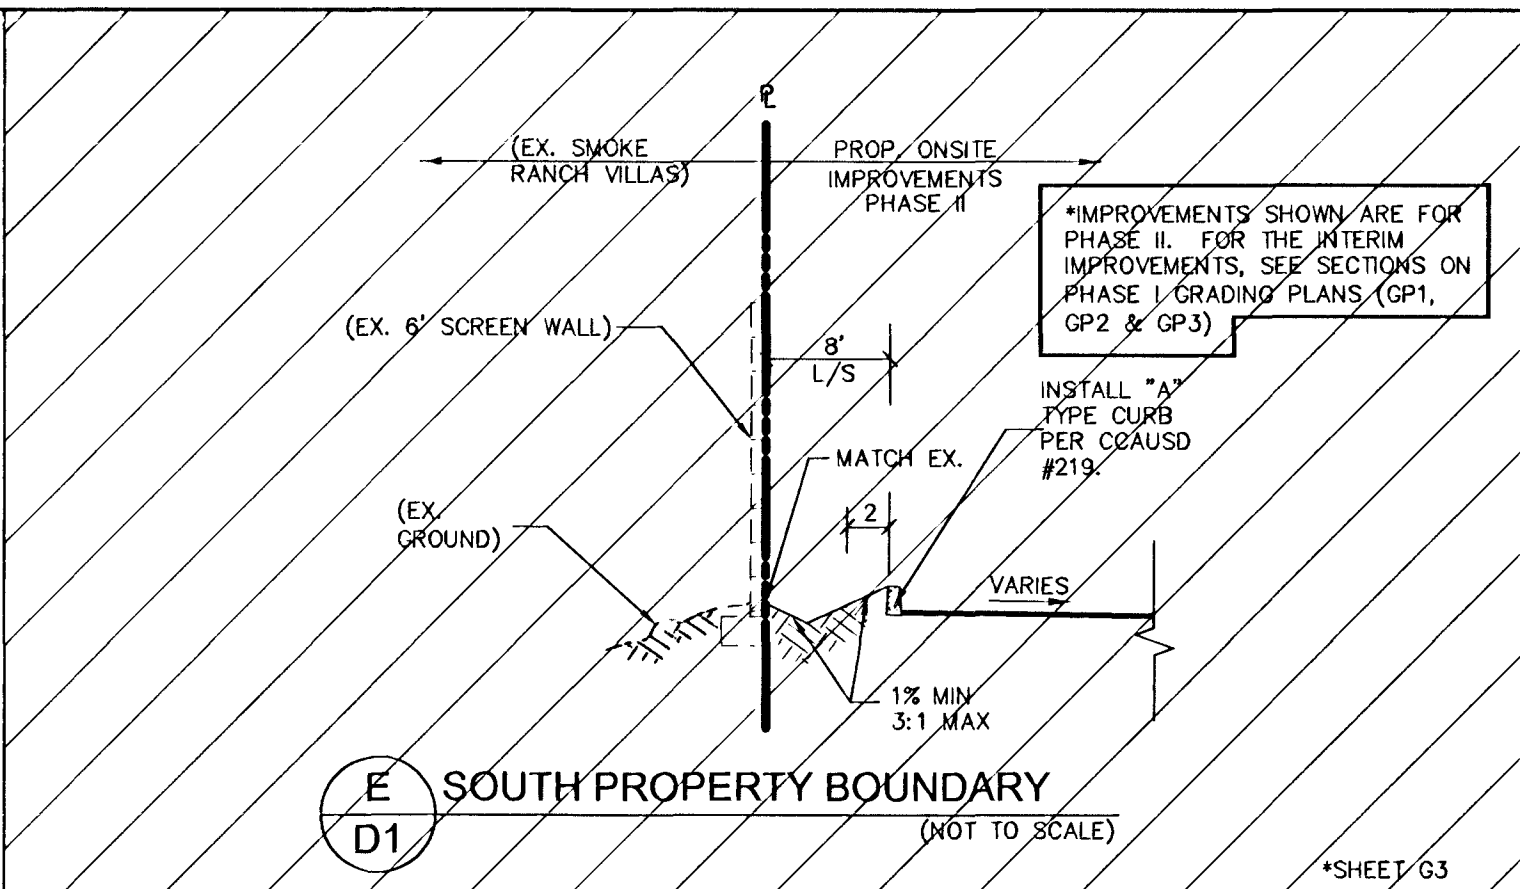
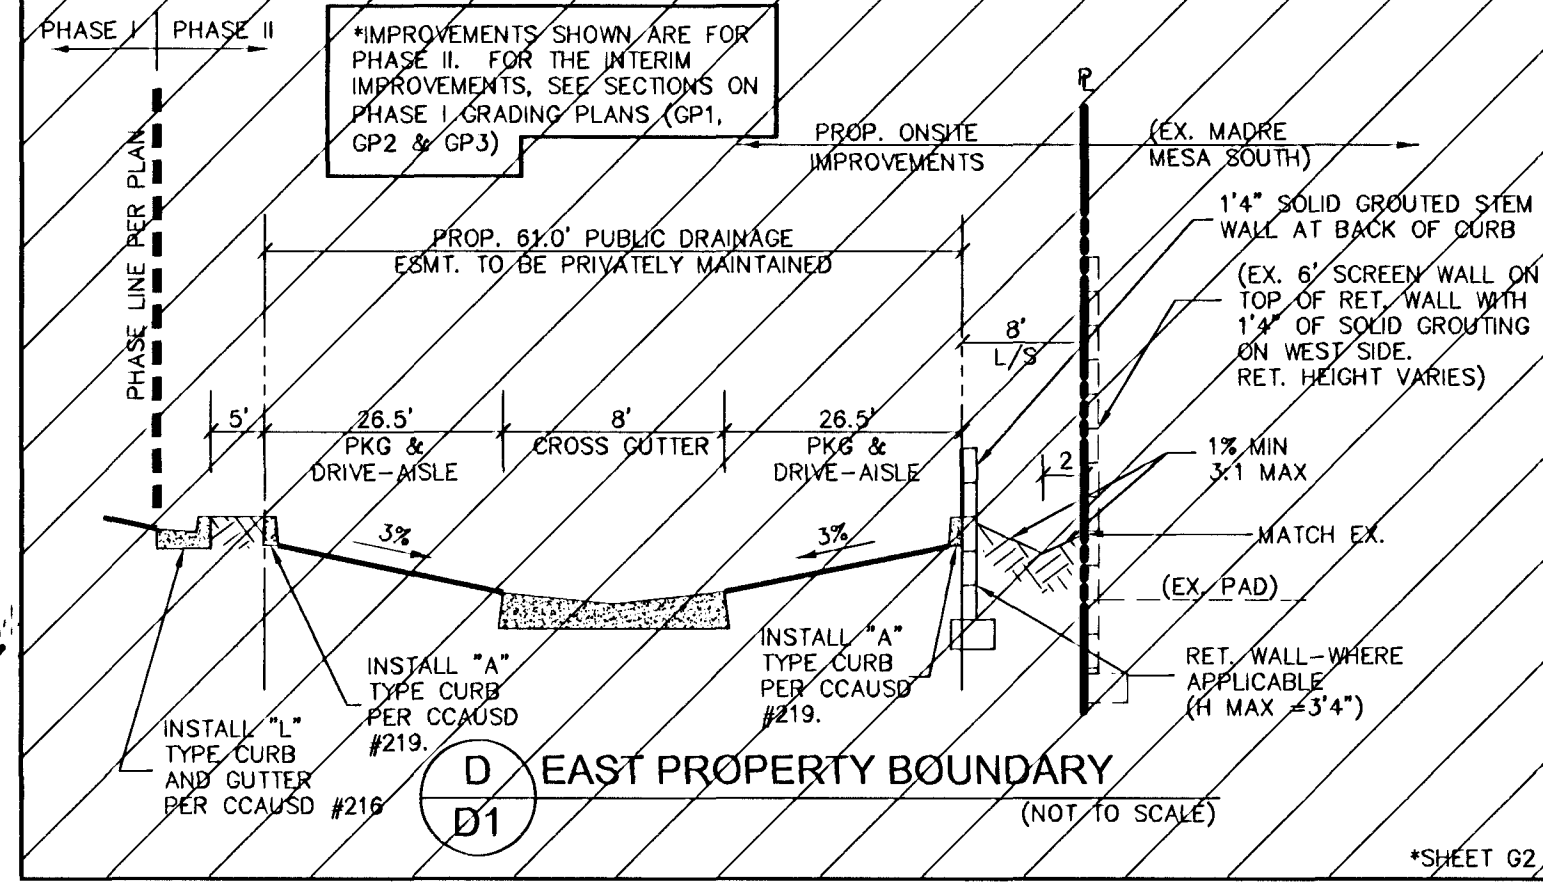
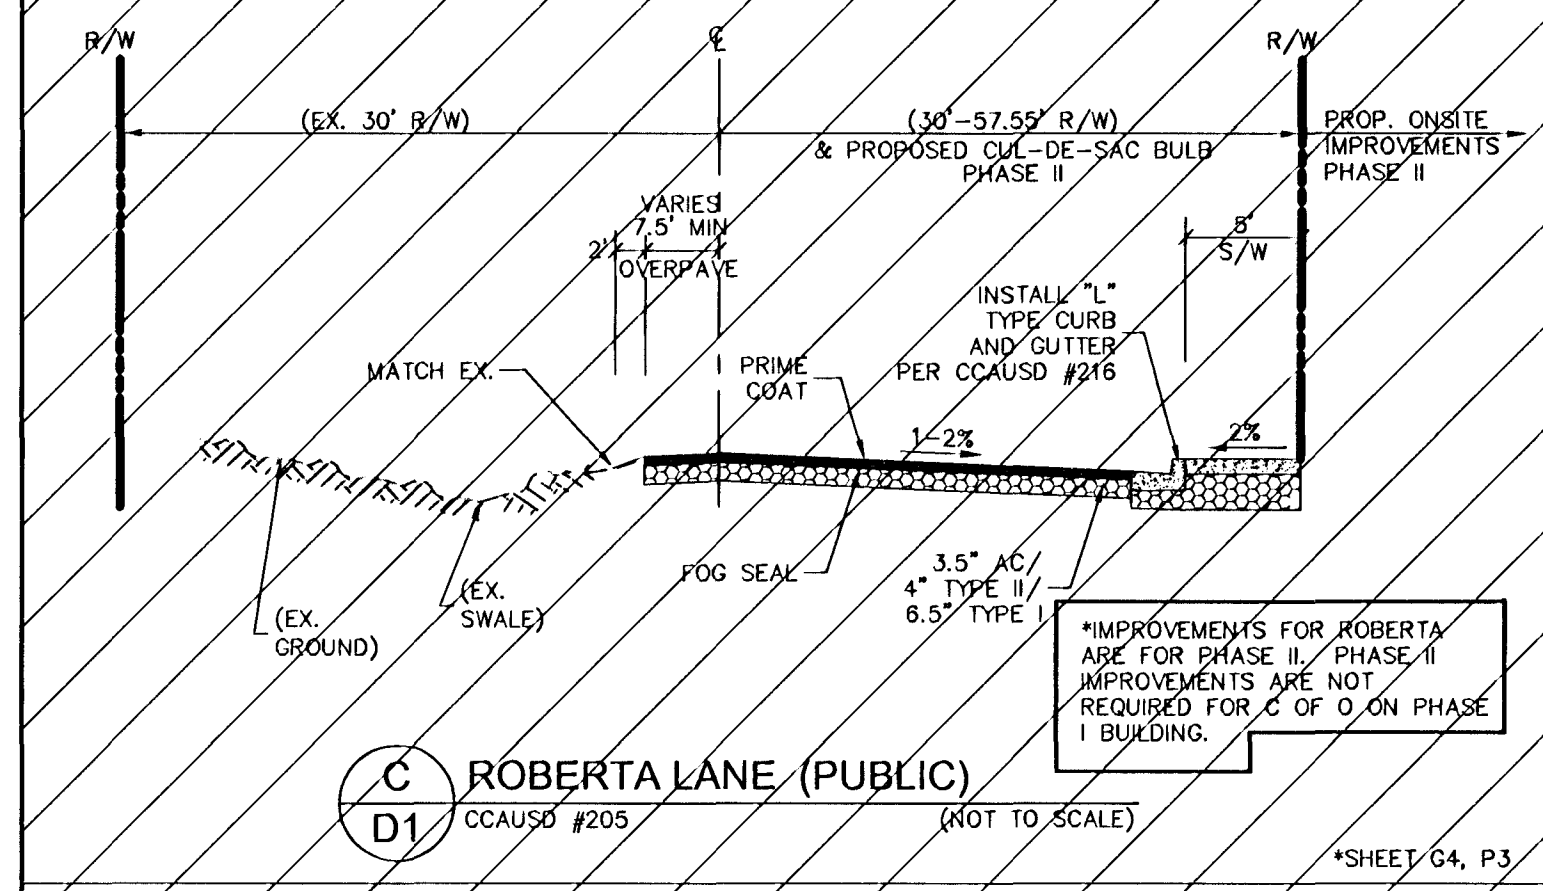
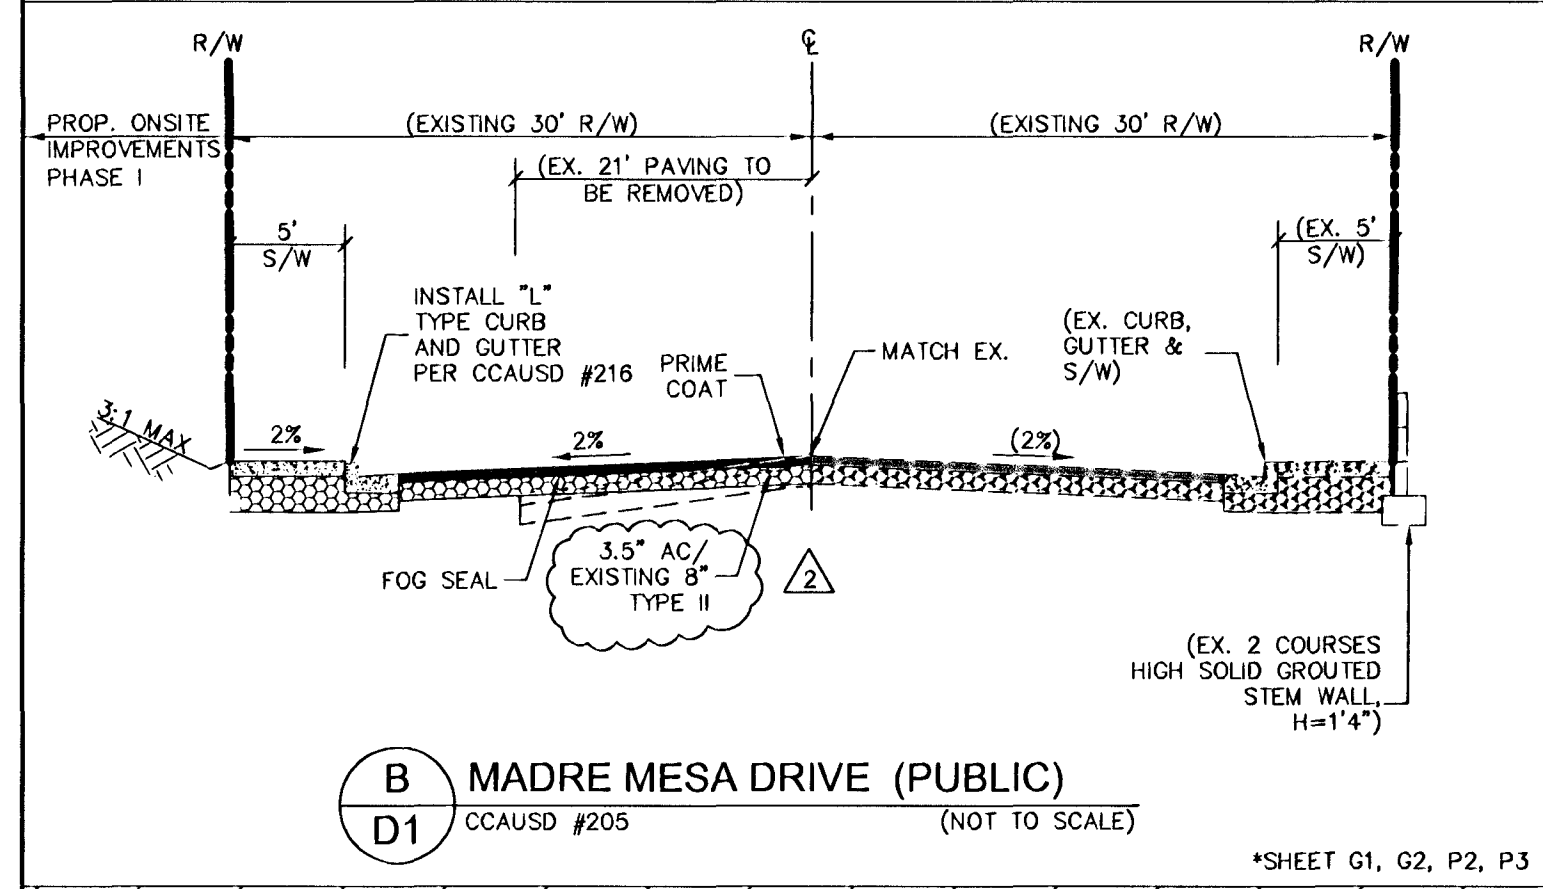
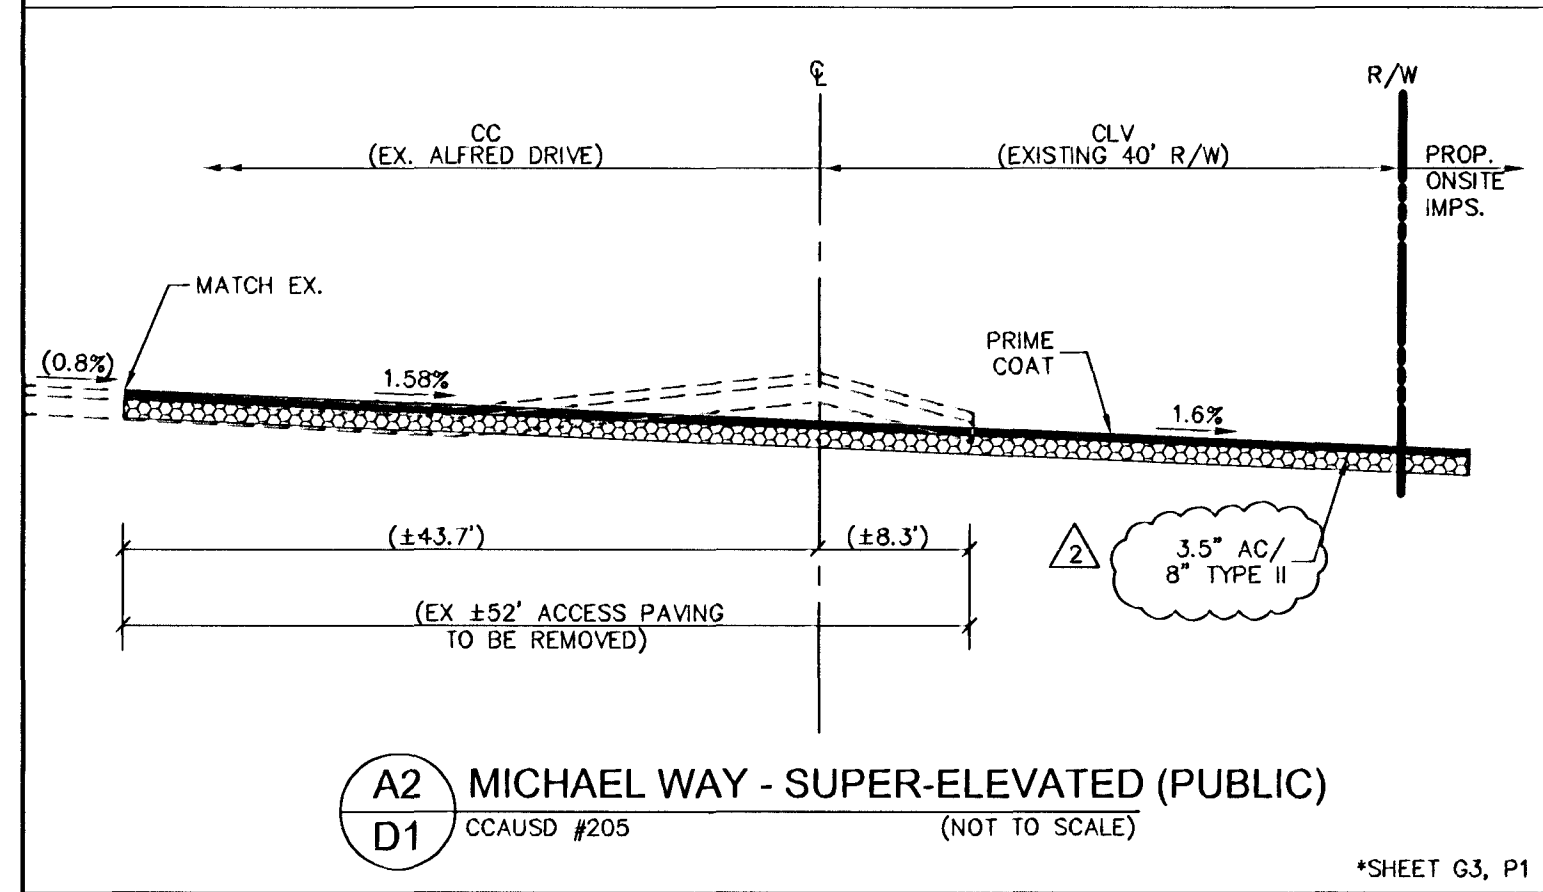


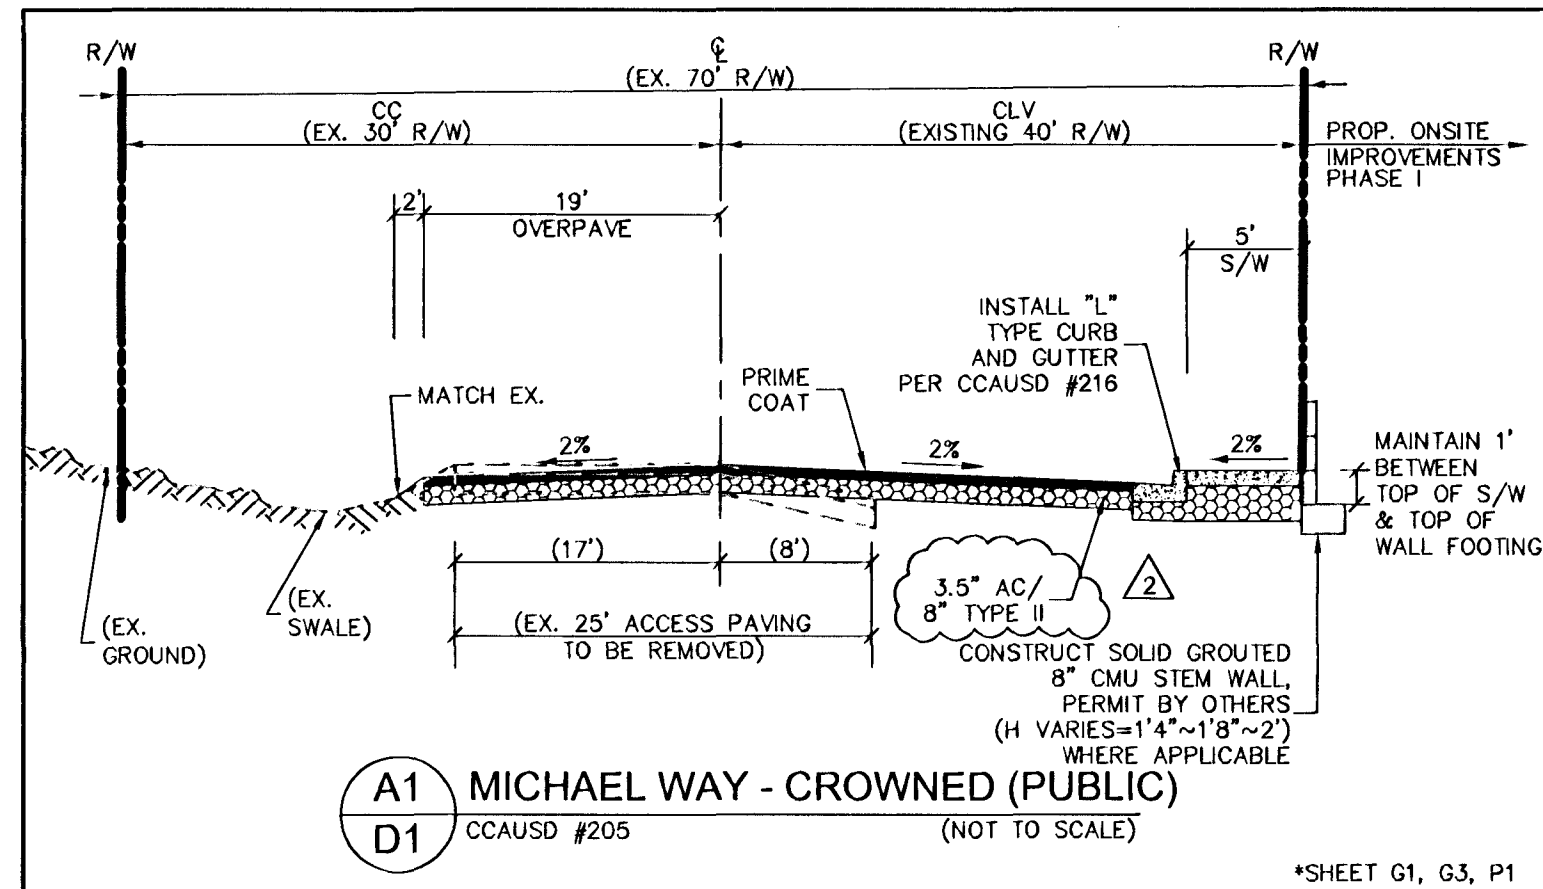

WIE

WALKER ENGINEERING, LLC
5765 S. RAINBOW BLVD.
SUITE 101
LAS VEGAS, NV 89118
TEL: 702.873.5197
FAX: 702.873.5346

STATE OF NEVADA
Professional Engineer
No. 12491
Civil
BPE-337

APPROVAL
DATE
INITIALS

CATALYST CONSULTING COMPANY
AGUILAS CFC CHURCH

DETAIL SHEET
SHEET 1 OF 2
PHASE I

CC HTE: 10-10763
SUBMITTAL NO. R3
DATE: DECEMBER 19, 2011
WE PROJECT NO.
1167.00
AGENCY NO.
CLV:37715
SHEET NO.:
D1

4 OF 27 SHEETS

Call before you Dig
Avoid cutting underground
utility lines. It's costly.
Call 811

Call before you Dig
Avoid cutting underground
utility lines. It's costly.
Call 811

Call before you Dig
Avoid cutting underground
utility lines. It's costly.
Call 811

1-800-227-2600
OR
1-702-455-7544

1-800-227-2600
OR
1-702-455-7511
CLV COUNTY TRAFFIC OPERATIONS
LAS VEGAS AREA COMPUTERIZED
TRAFFIC SYSTEM

1-702-432-5300
OR
1-702-227-2929