


NOTES:
SEE SHEET HS1 FOR HARDSCAPE LEGEND AND NOTES.




MATCH LINE STA 32+00 SEE THIS SHEET

MATCH LINE STA 36+50 SEE THIS SHEET

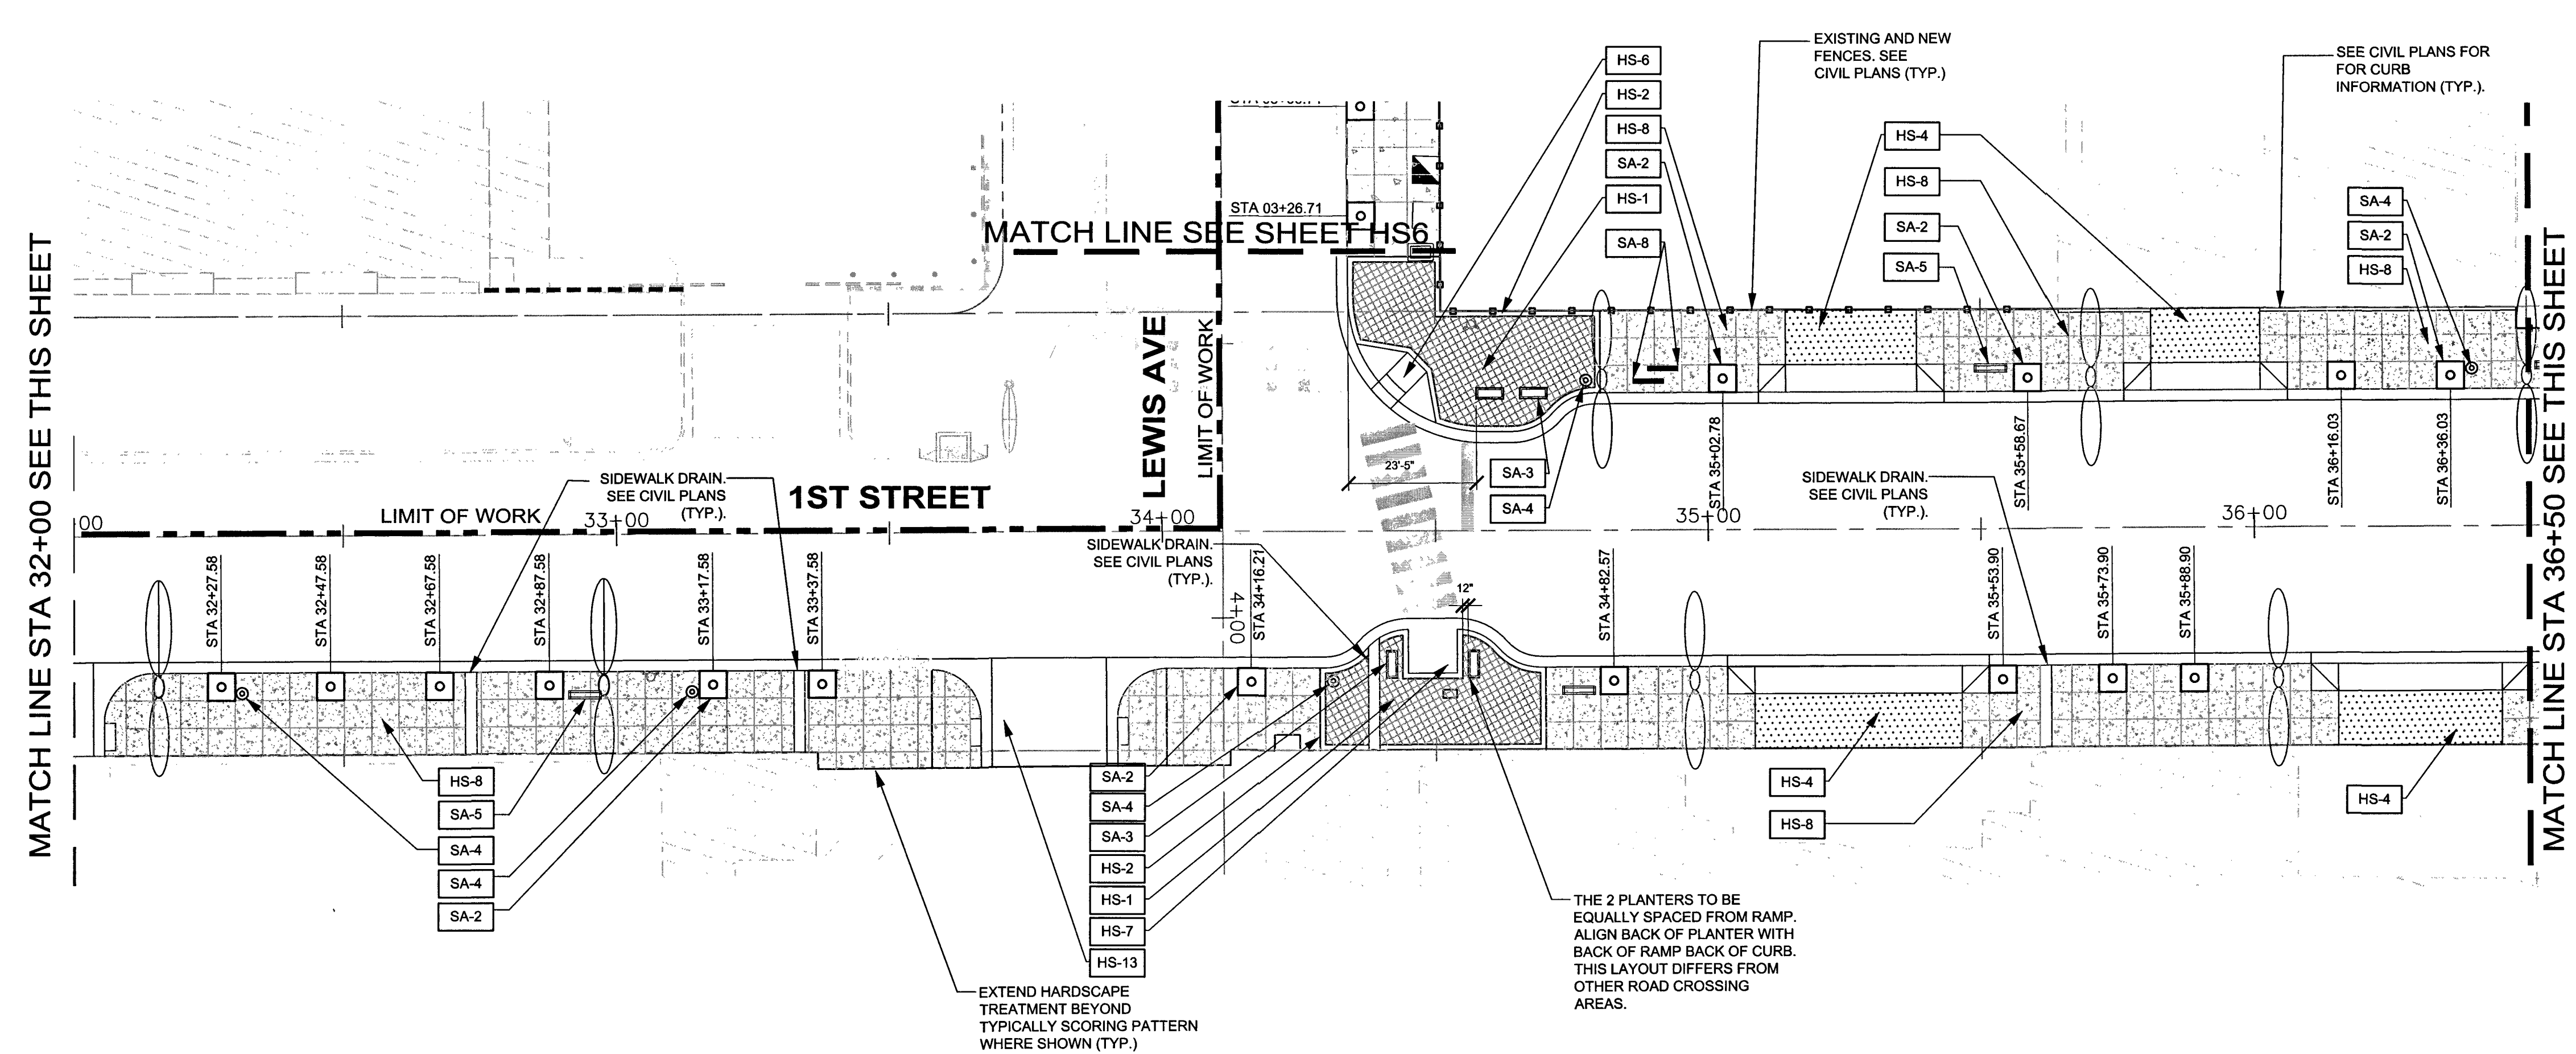

MATCH LINE STA 36+50 SEE THIS SHEET

MATCH LINE STA 40+00 SEE THIS SHEET

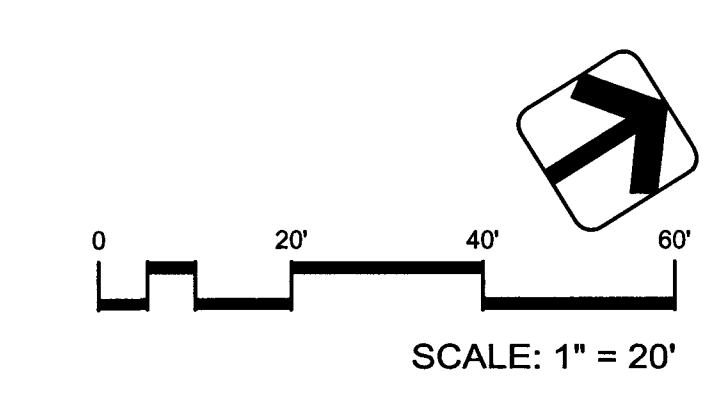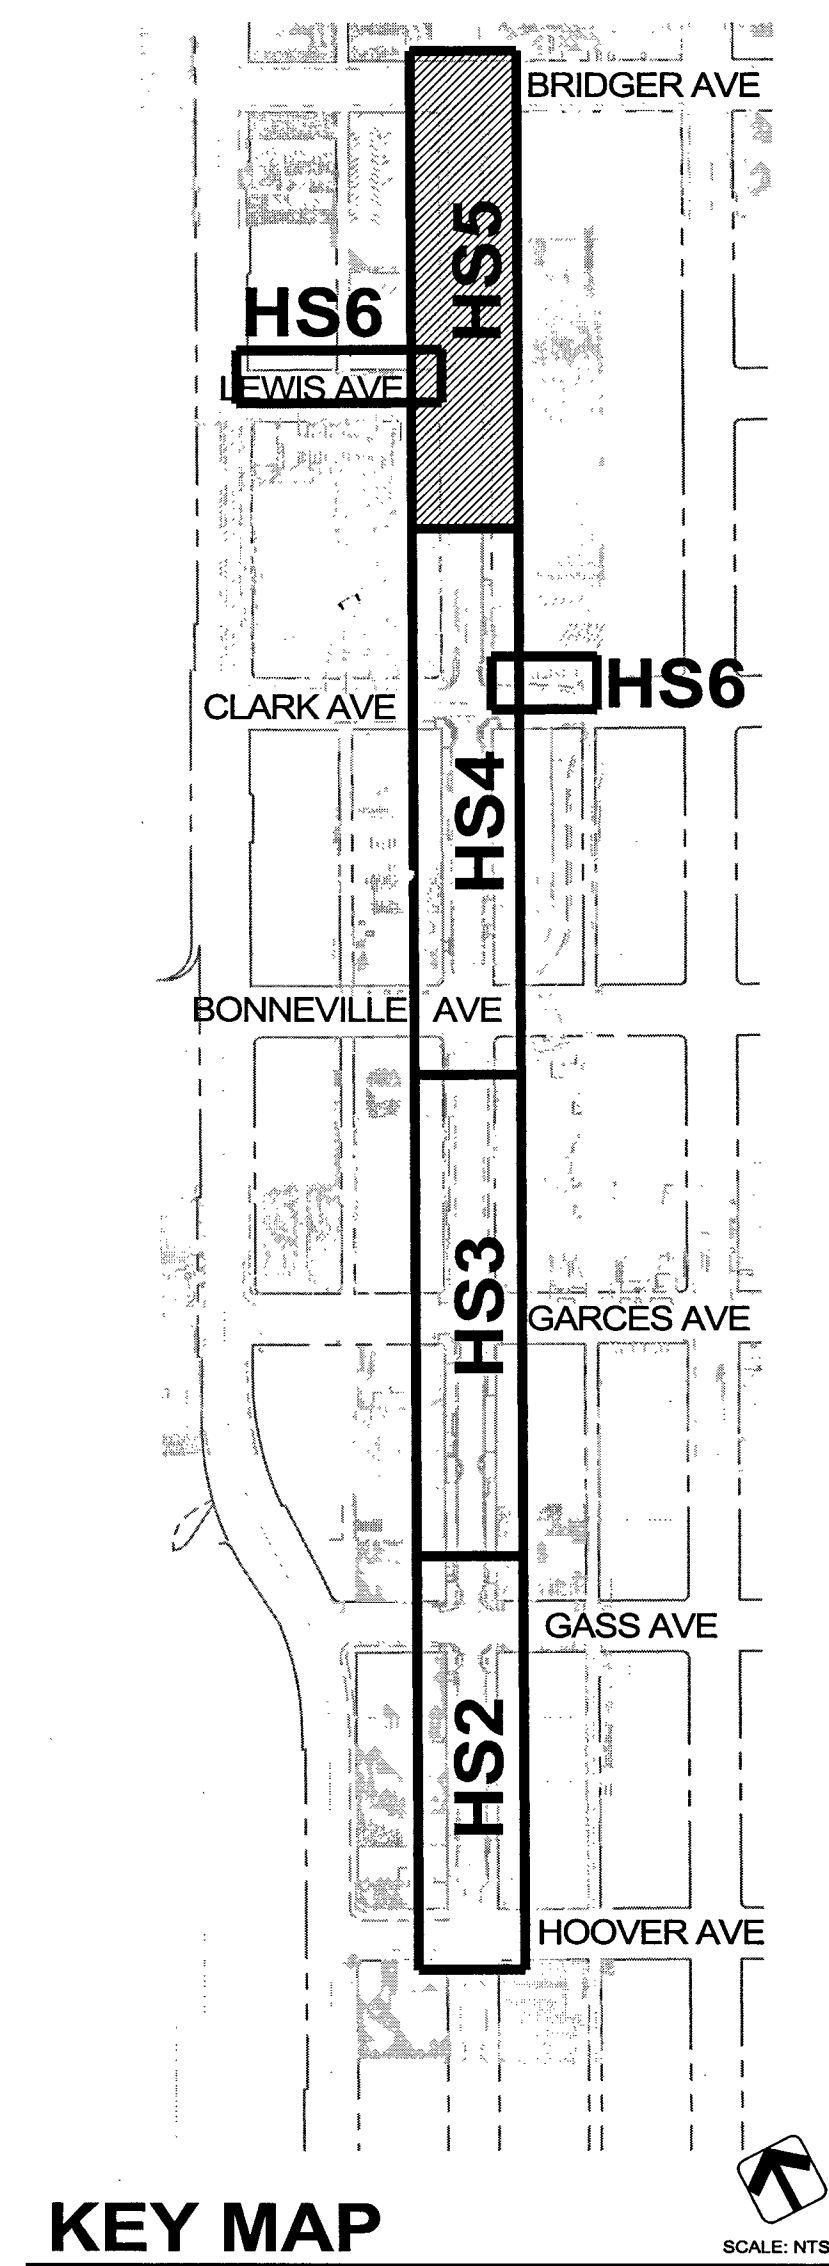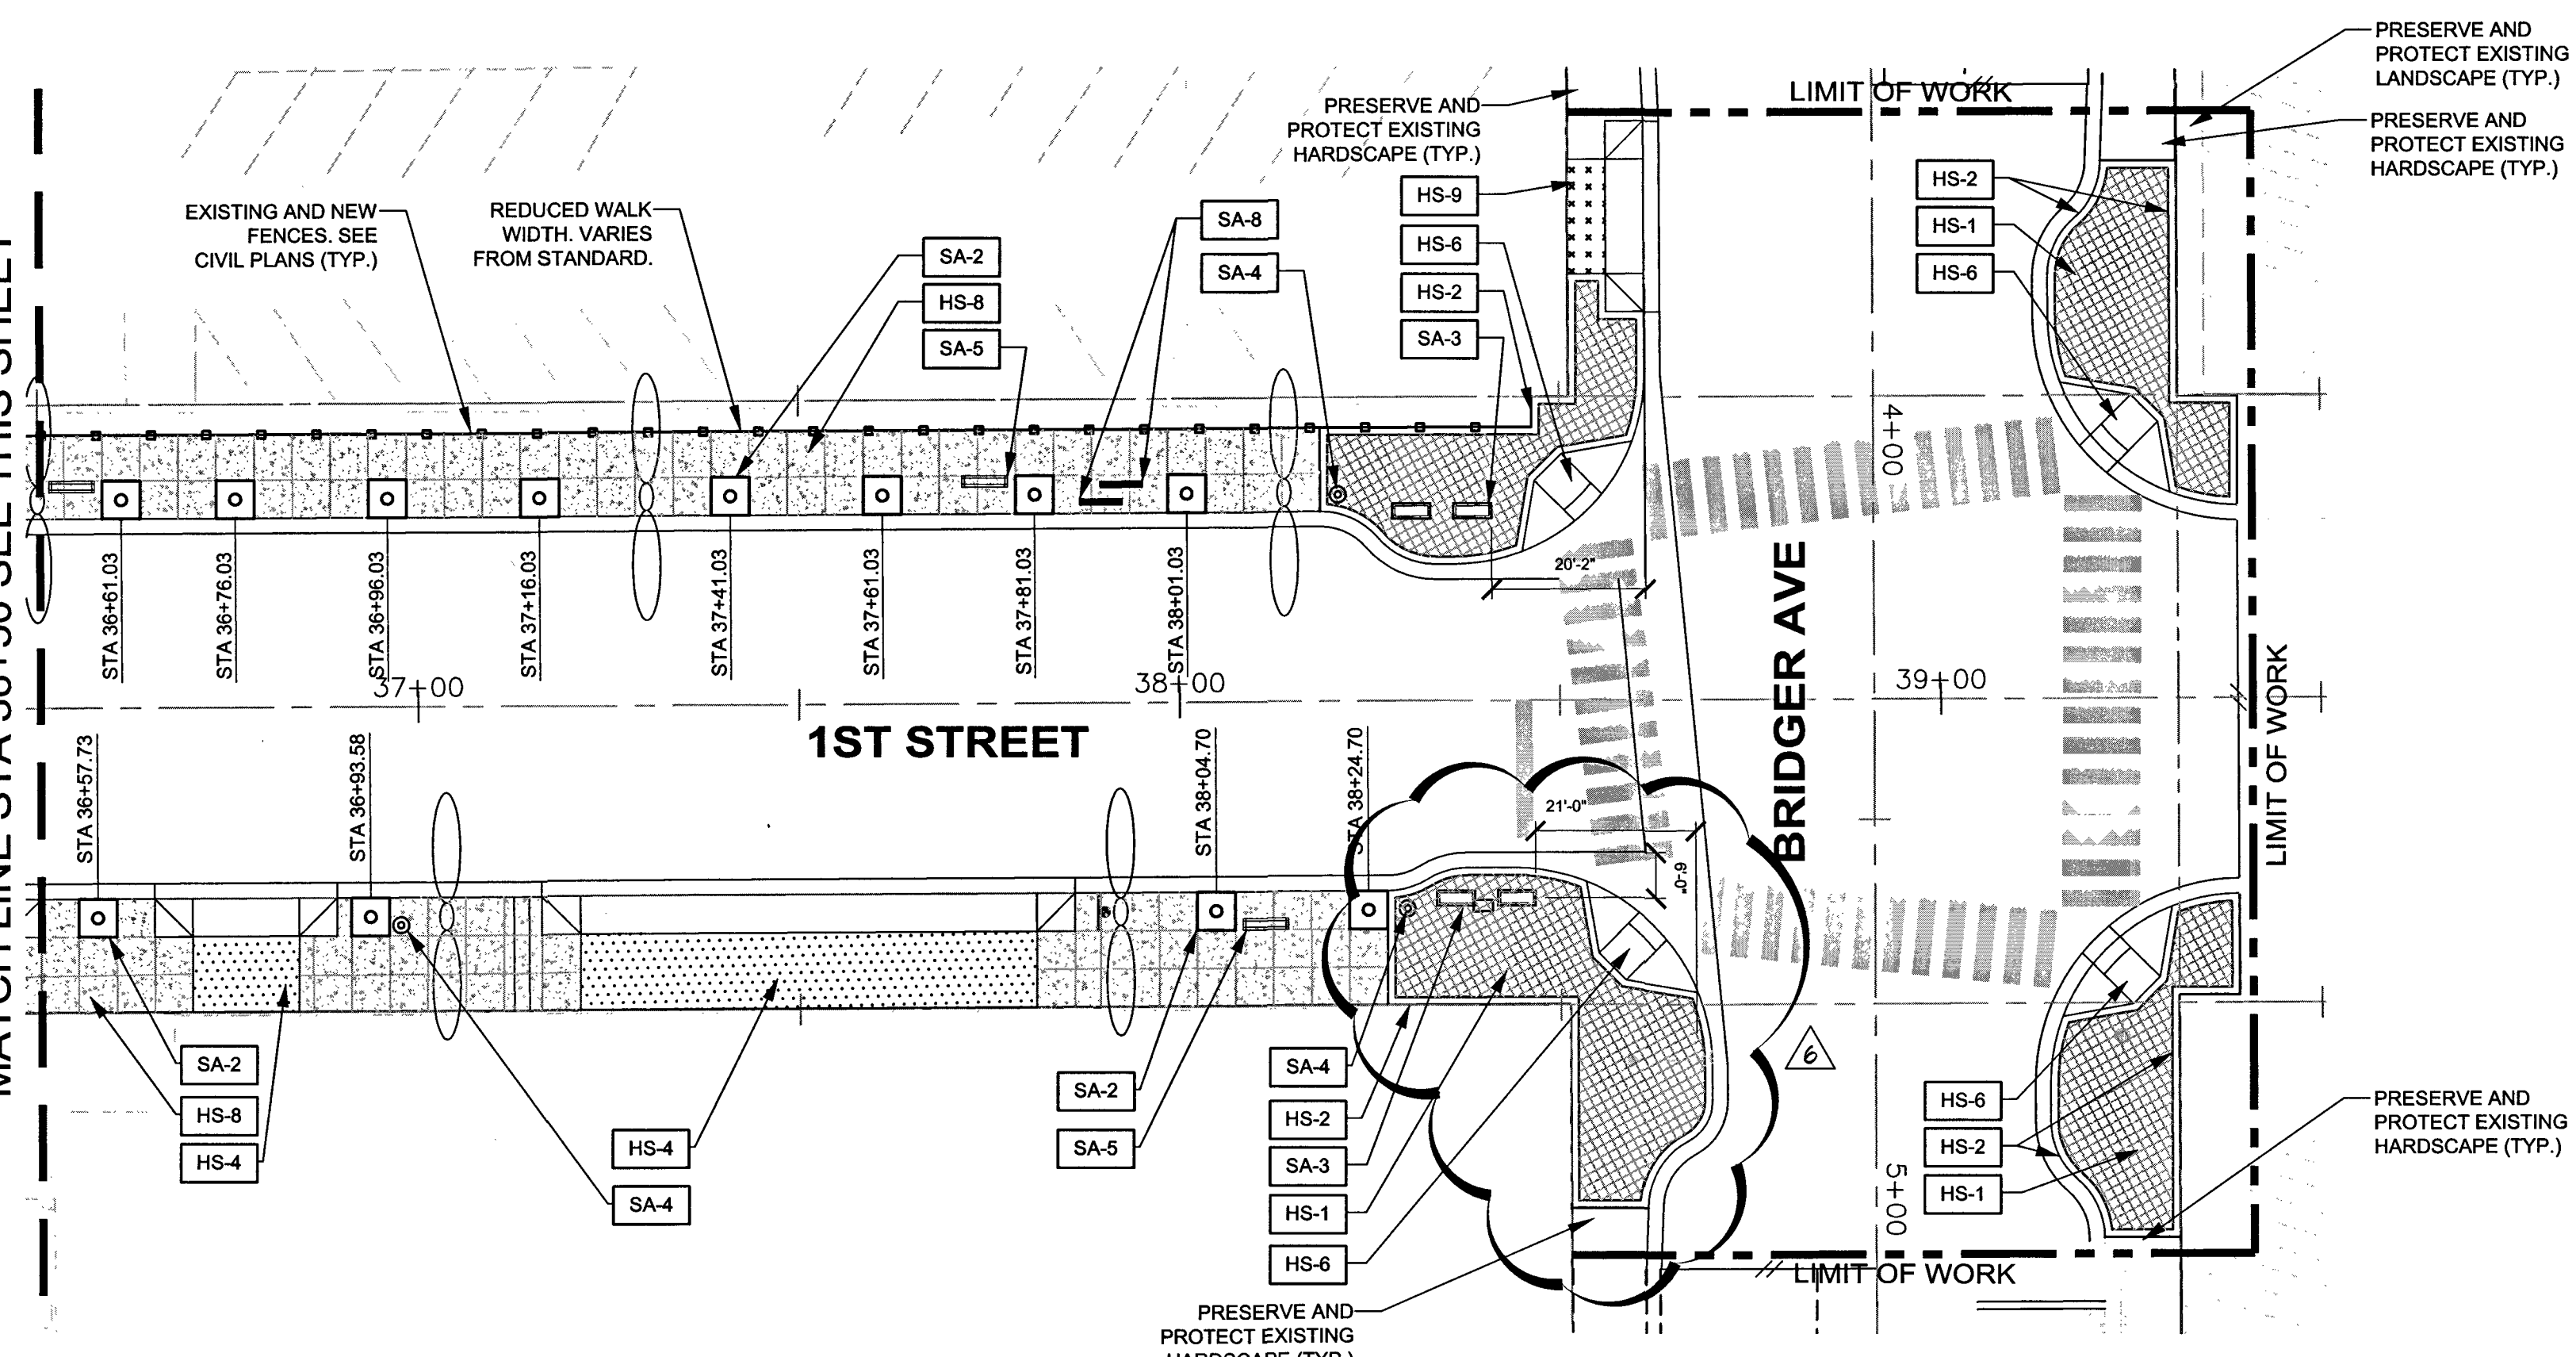

southwick
LANDSCAPE ARCHITECTS
12 Commerce Center Drive
Henderson NV 89014
www.southwickla.com
702.597.3108

FAST
Call before you Dig
Underground
1-702-432-5300
FREIGHTWAY AND ARTERIAL
SYSTEM OF TRANSPORTATION

AVOID HITTING OVERHEAD
POWER LINES. IT'S COSTLY.
CALL BEFORE YOU DO
OVERHEAD
1-702-227-2929

Call before you Dig
Avoid cutting underground
utility lines. It's costly.
Call 811

PUBLIC WORKS DEPARTMENT 333 N. RANCHO DRIVE LAS VEGAS, NV 89106 702-229-6272		2727 SOUTH RAINBOW BOULEVARD PH. (702) 873-7550 FAX (702) 362-2597 WWW.VINNV.COM	
HARDSCAPE PLAN STA 32+00.00 TO STA 40+00.00 1ST STREET		DOWNTOWN PEDESTRIAN & BICYCLE IMPROVEMENTS 1ST STREET HOOVER AVENUE TO BRIDGER AVENUE	
DRAWN BY: CD	01/22/13	CHECKED BY: SMS	01/22/13
DESIGNED BY: CD	01/22/13	PROJECT NO: 11-038	SCALE: AS NOTED
SHEET HS5 65 OF 83 SHEETS		DRAWING NO. 107V5664-1ST	
REV	DATE	BY	REVISION
6	01/02/14	CD	REVISE BULB-OUT FOR TRAFFIC SIGNAL POLE CLEARANCE