

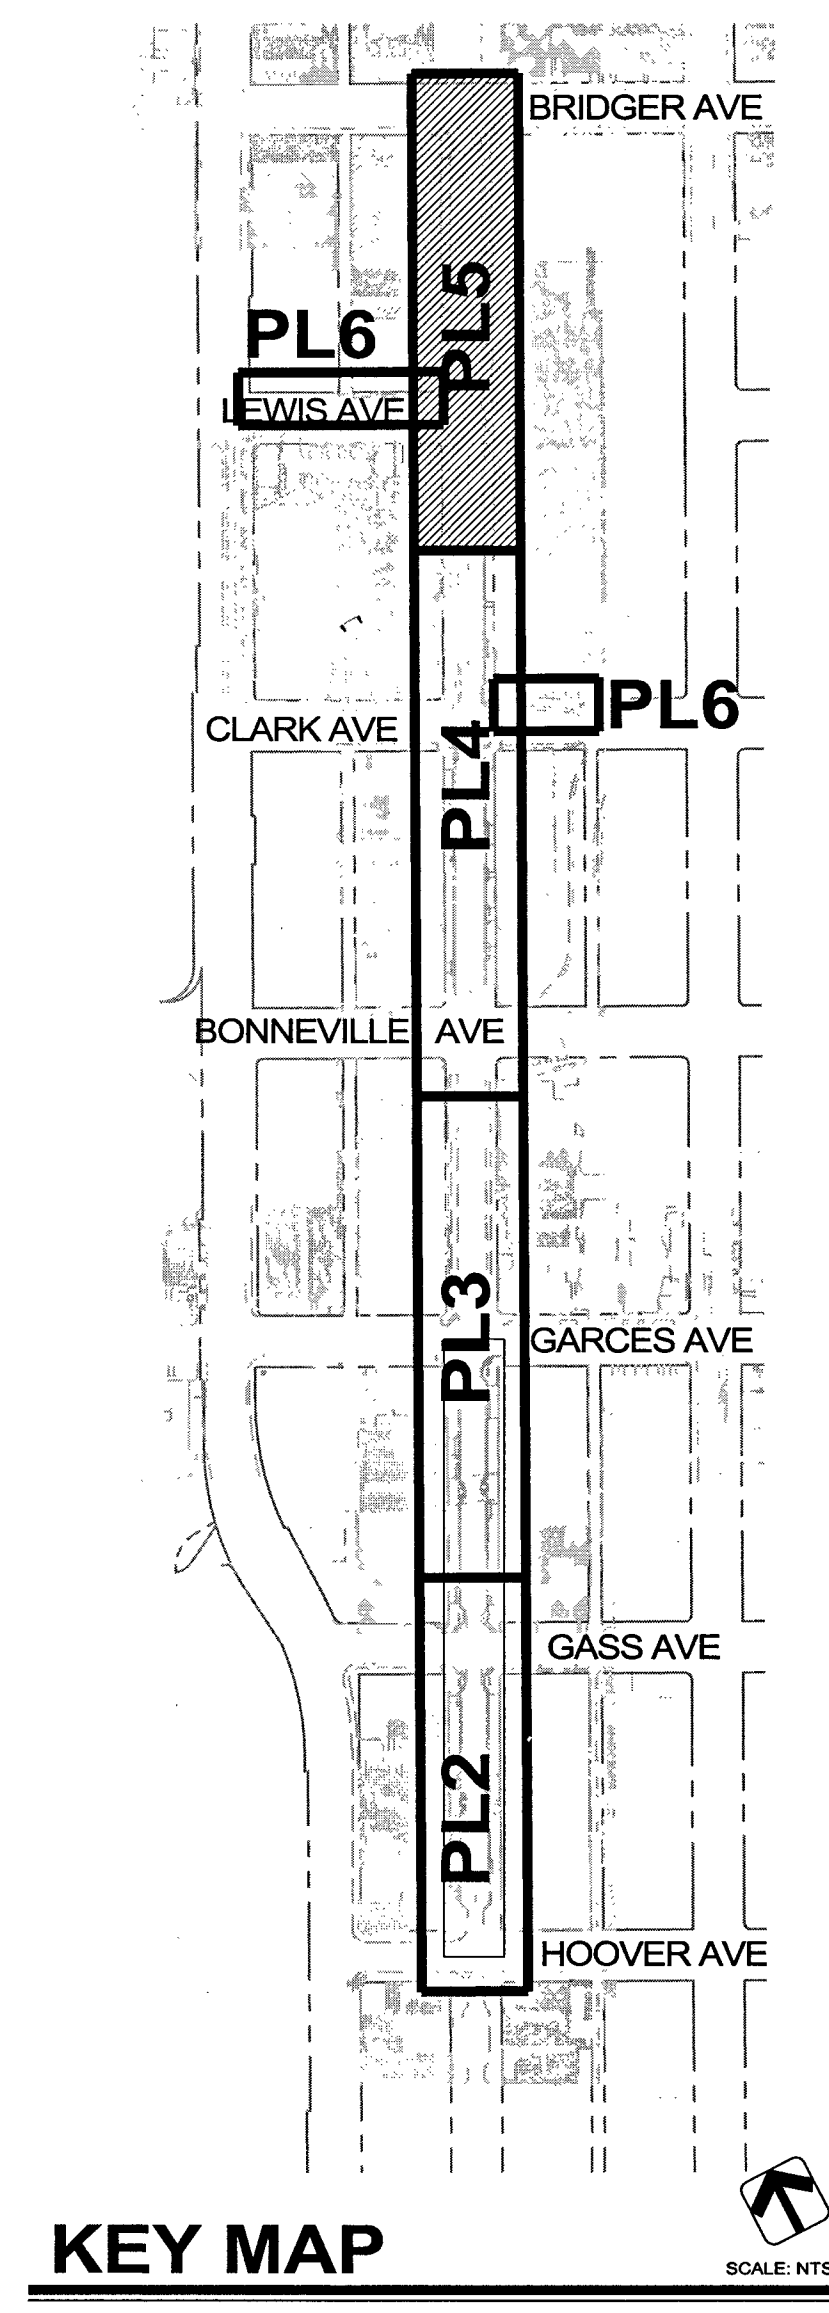


NOTES:
SEE SHEET PL1 FOR PLANTING LEGEND AND NOTES.

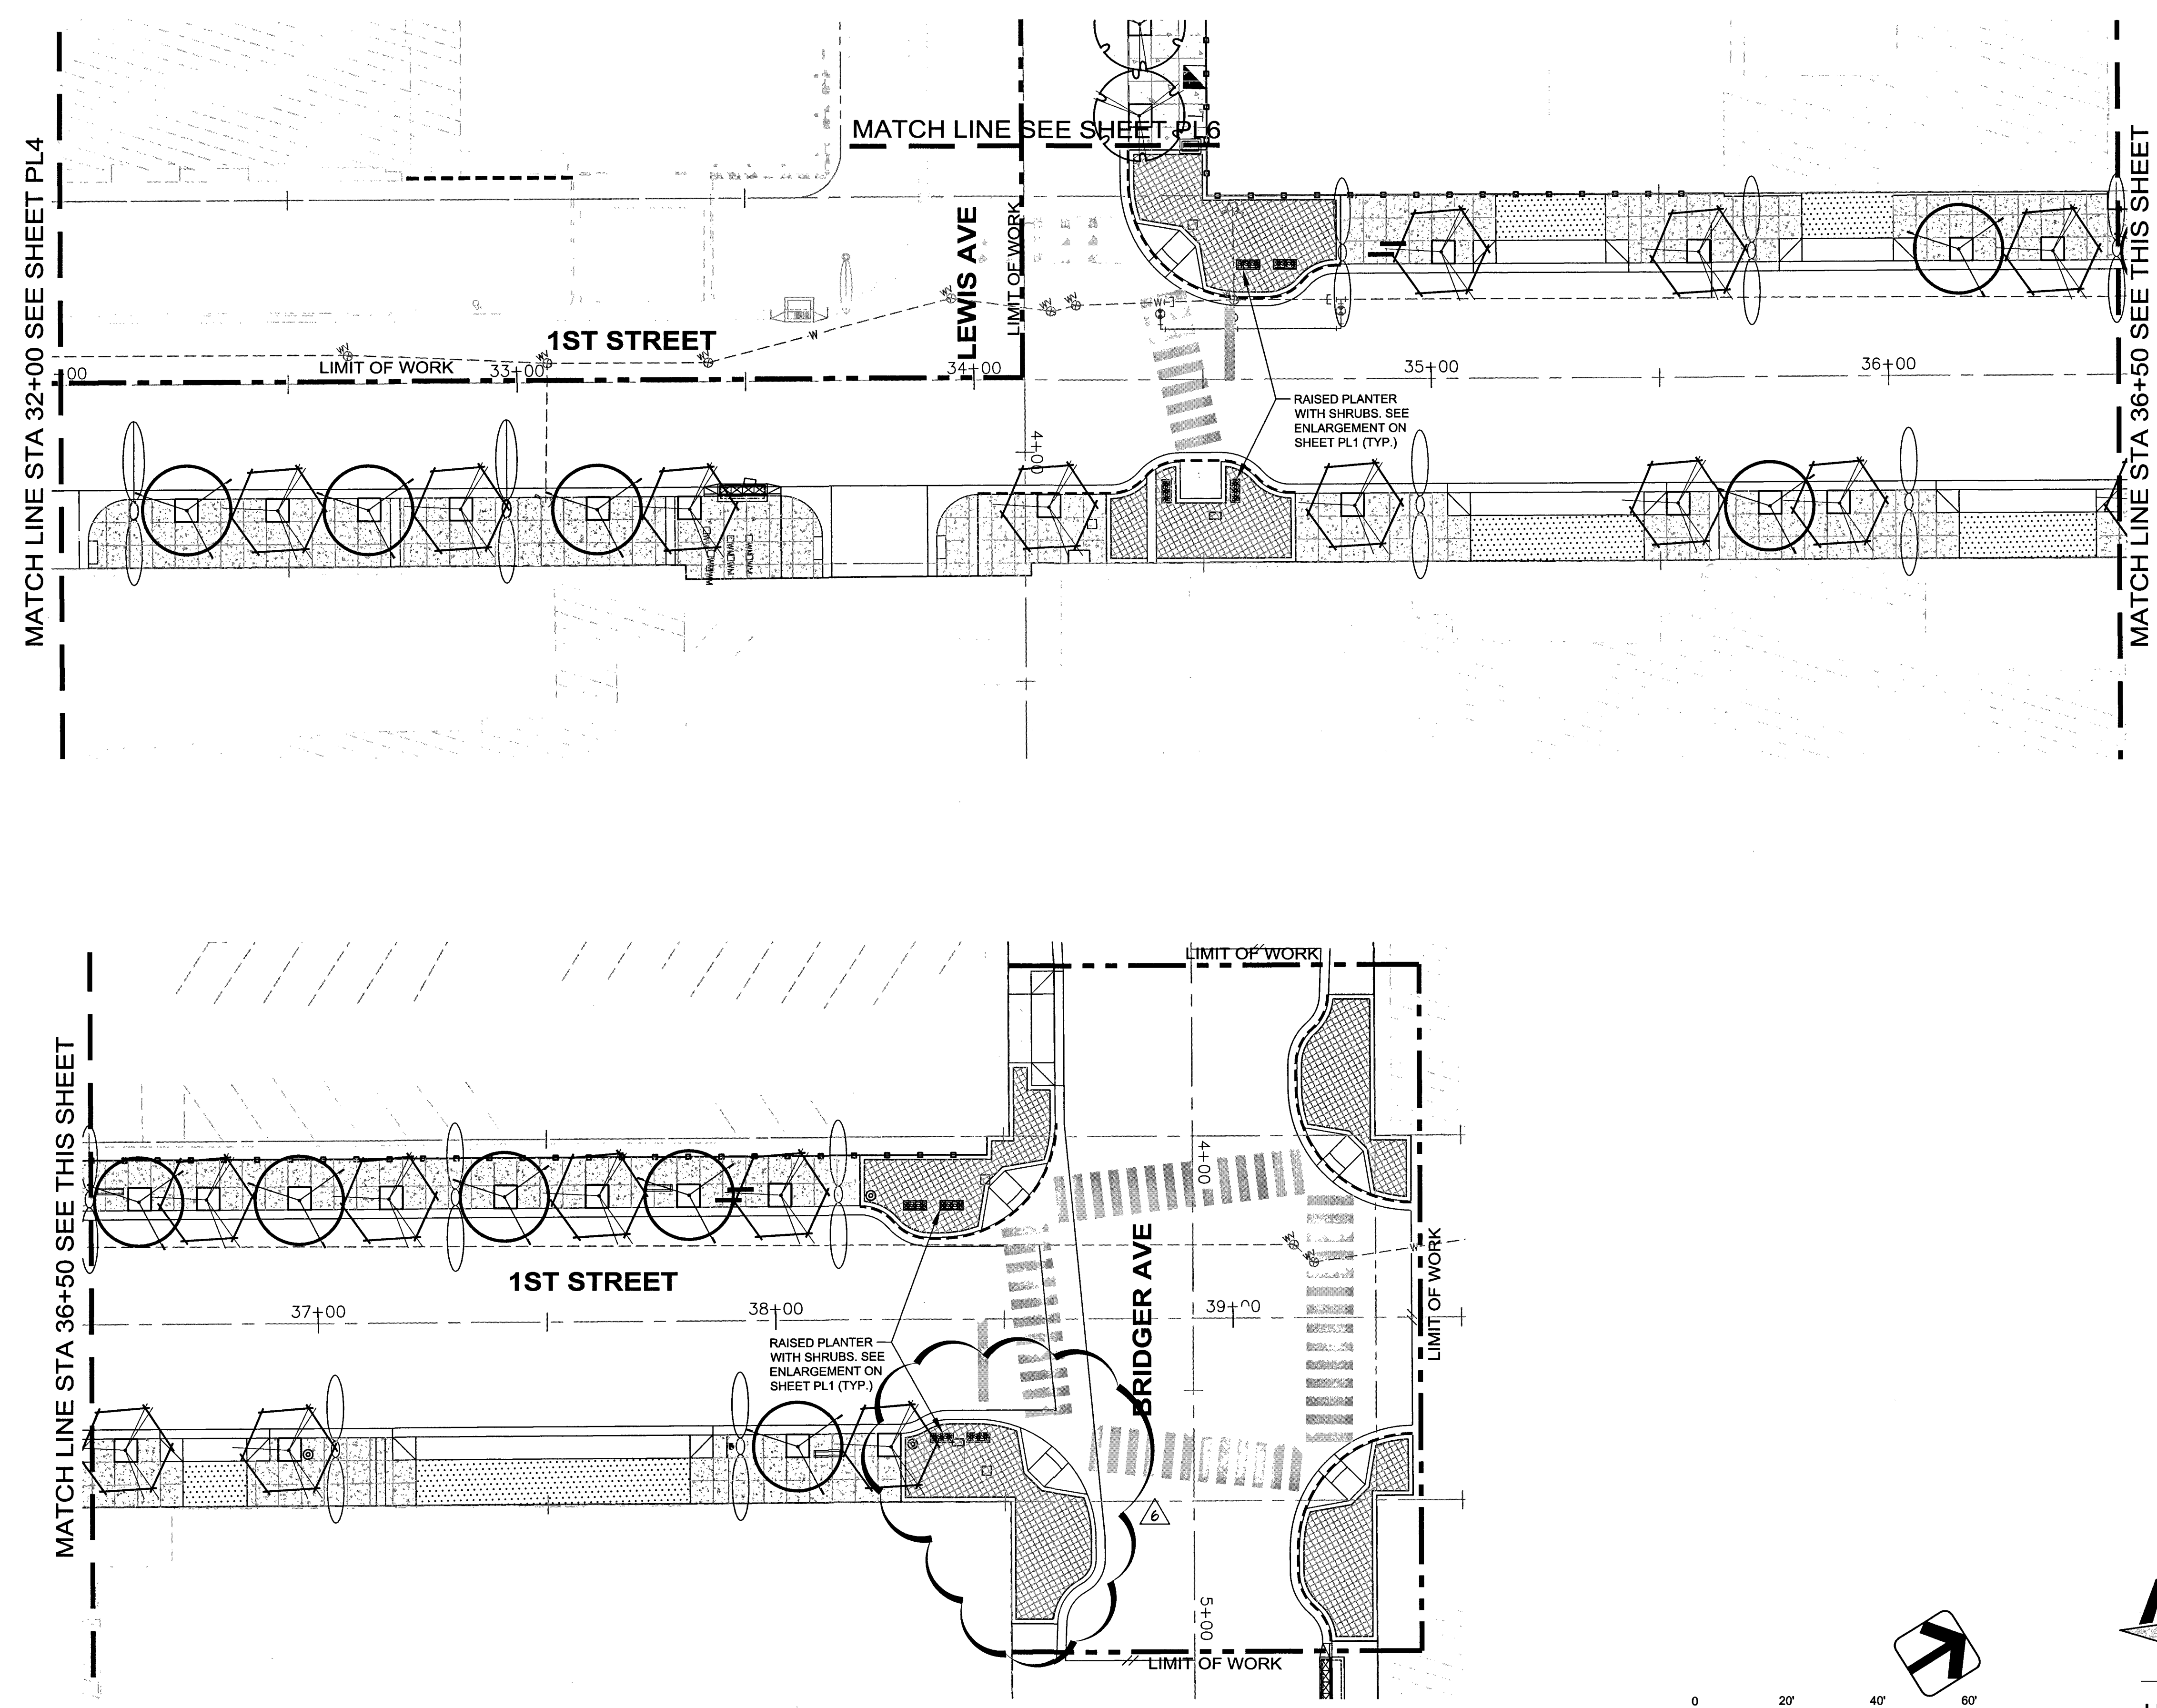

MATCH LINE STA 36+50 SEE THIS SHEET

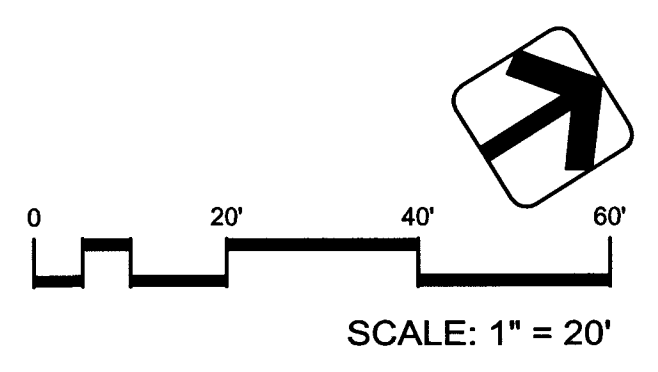

southwick
LANDSCAPE ARCHITECTS

12 Commerce Center Drive
Henderson NV 89014

www.southwickla.com
702.597.3108

FAST

Call before you Dig
before you UnderGround

1-702-432-5300

FREWAY AND ARTERIAL SYSTEM OF TRANSPORTATION

AVOID HITTING OVERHEAD POWER LINES. IT'S COSTLY.

CALL BEFORE YOU DO OVERHEAD

1-702-227-2929

Call before you Dig

Avoid cutting underground utility lines. It's costly.

Call 811

PUBLIC WORKS DEPARTMENT 1115 RANCHO DRIVE LAS VEGAS, NV 89105 702-229-6272		2727 SOUTH RAINBOW BOULEVARD SUITE 100 LAS VEGAS, NV 89168 PH (702) 873-2550 FAX (702) 362-2597 WEB SITE WWW.VINNV.COM	
DATE	BY	REVISION	REVISION
6/01/2014	CD	REVISE BULB-OUT FOR TRAFFIC SIGNAL POLE CLEARANCE	
<p>PLANTING PLAN STA 32+00.00 TO STA 40+00.00 1ST STREET</p> <p>DOWNTOWN PEDESTRIAN & BICYCLE IMPROVEMENTS 1ST STREET HOOVER AVENUE TO BRIDGER AVENUE</p>			
DRAWN BY:	DESIGNED BY:	CHECKED BY:	PROJECT NO. / SCALE
CD	CD	SMS	11-038 / AS NOTED
01/22/13	01/22/13	01/22/13	
<p>REGISTERED LANDSCAPE ARCHITECT STATE OF NEVADA 579 01/29/14</p>			
<p>SHEET PL5 74 OF 83 SHEETS DRAWING NO. 107V5864-1ST</p>			