


NOTES:
SEE SHEET IR1 FOR IRRIGATION LEGEND AND NOTES.

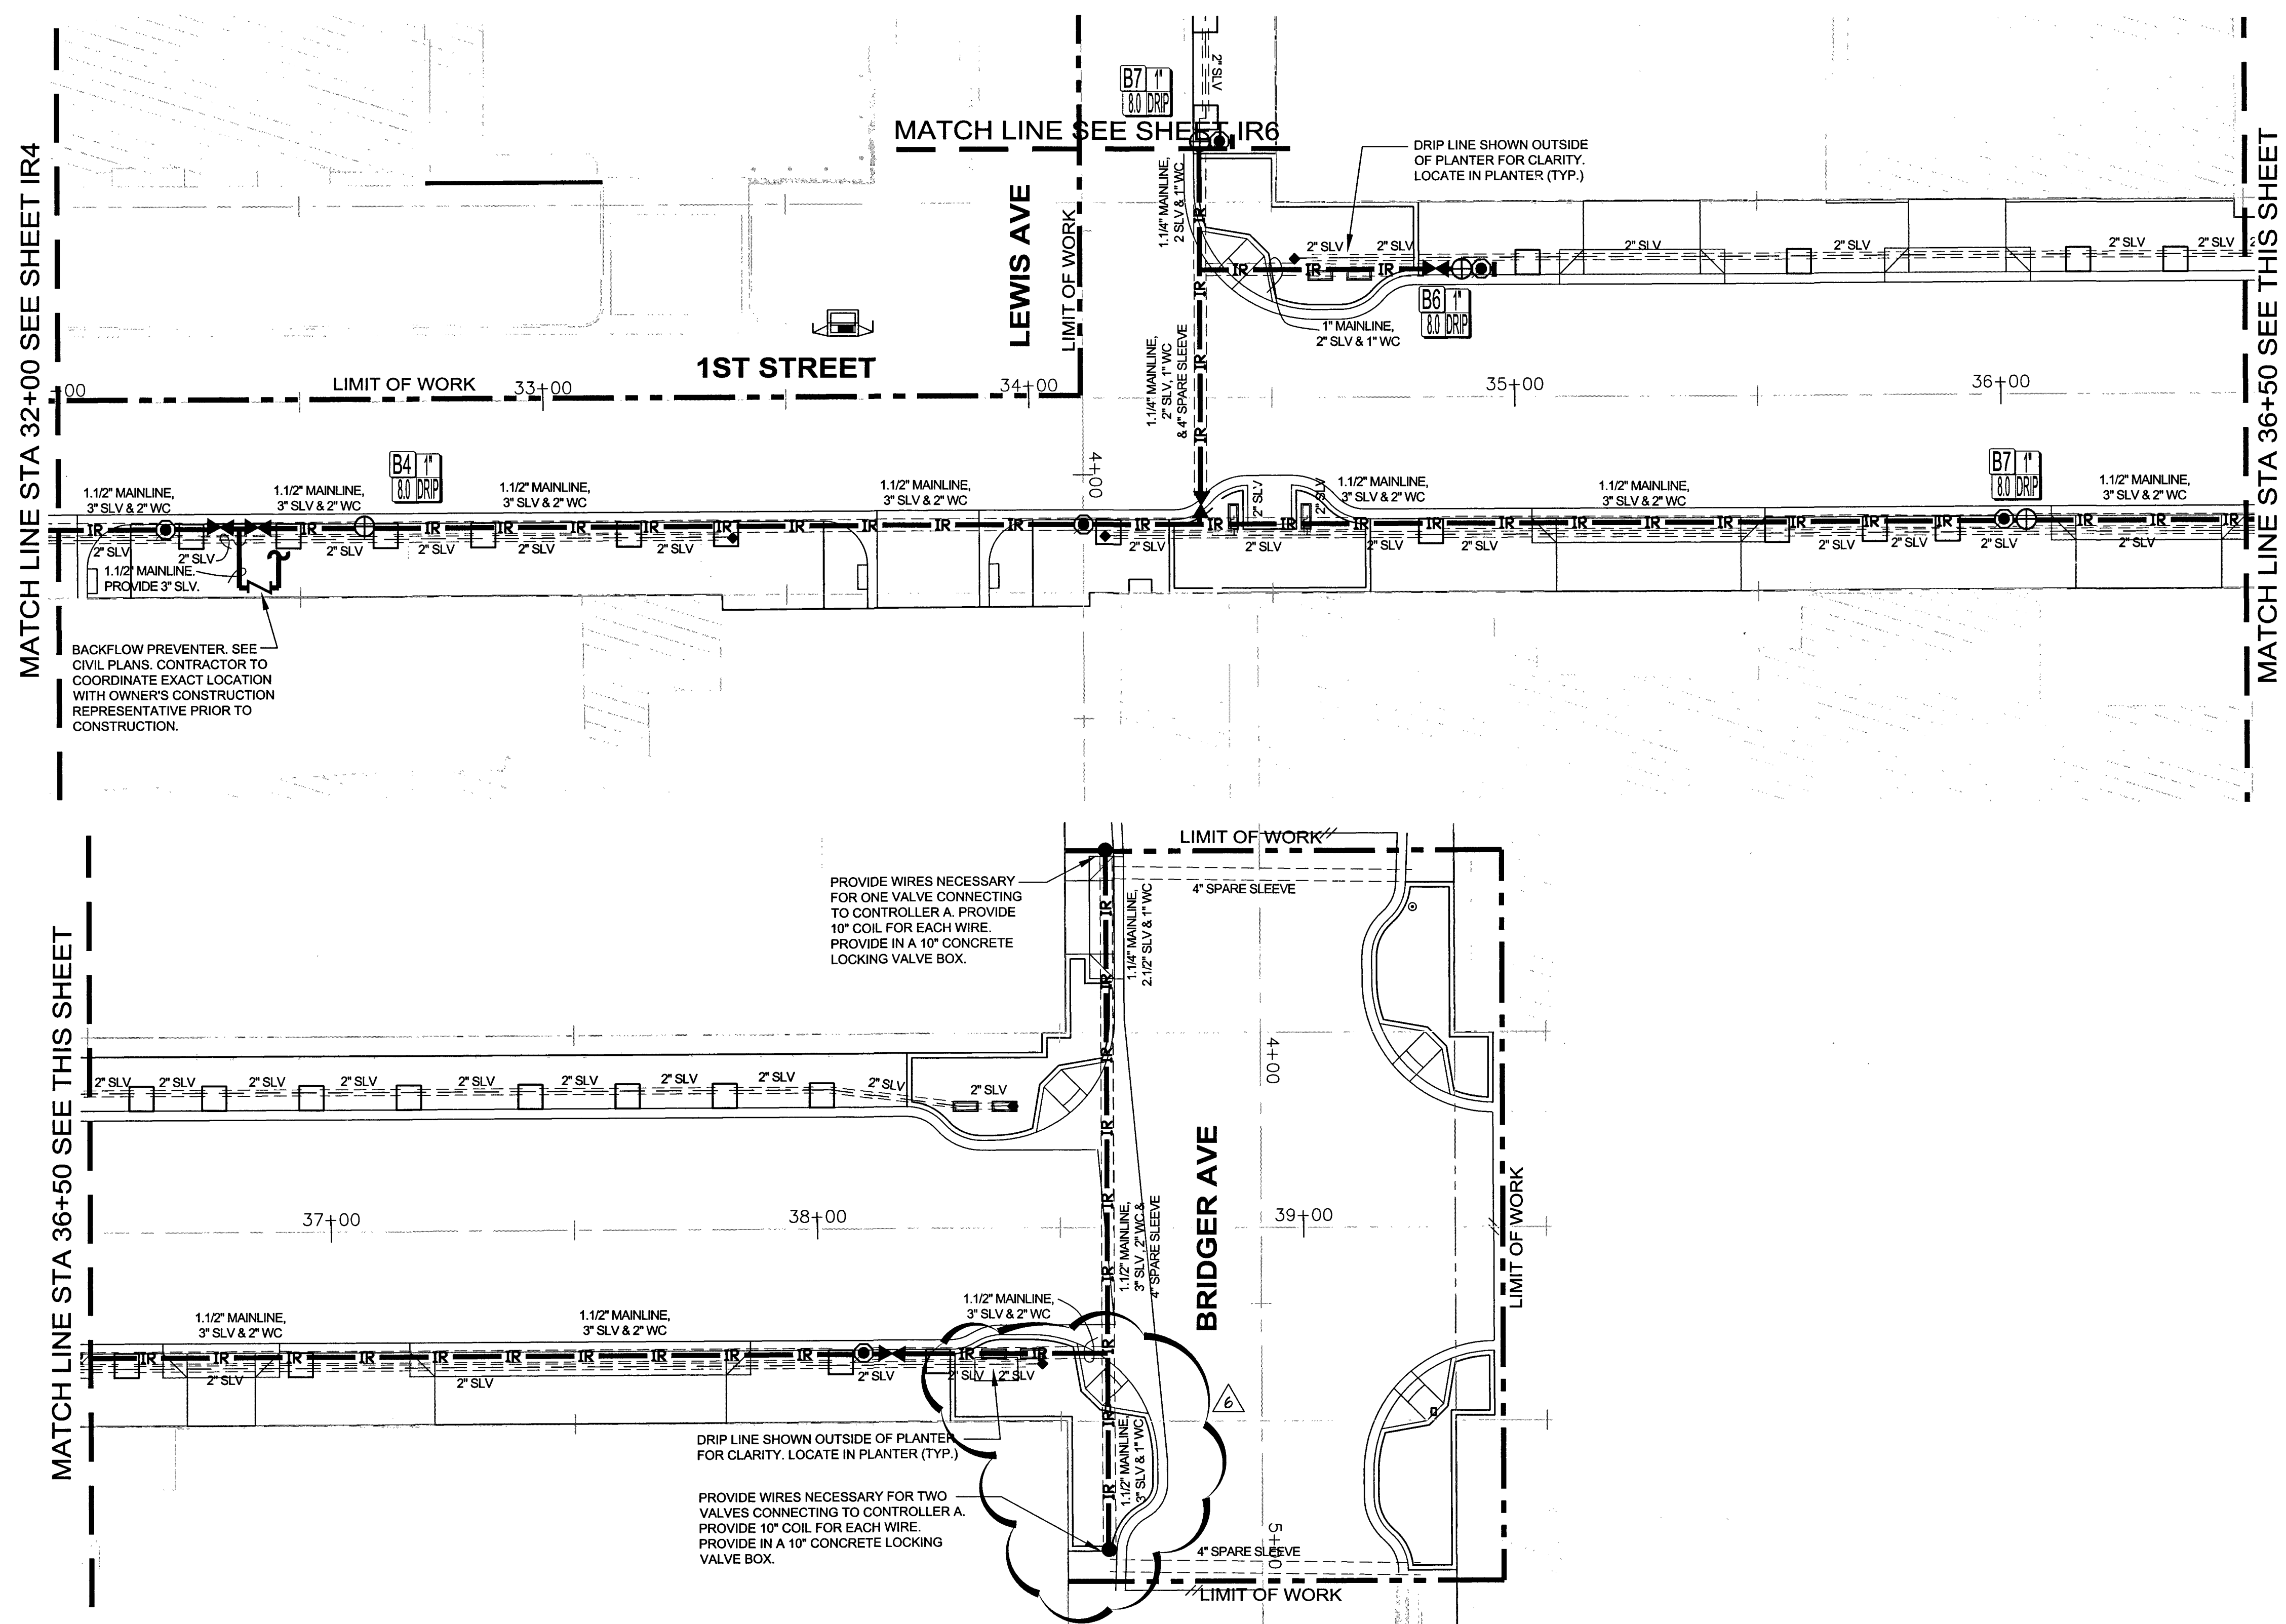



MATCH LINE STA 32+00 SEE SHEET IR4

MATCH LINE STA 36+50 SEE THIS SHEET

MATCH LINE SEE SHEET IR6

MATCH LINE STA 36+50 SEE THIS SHEET

KEY MAP

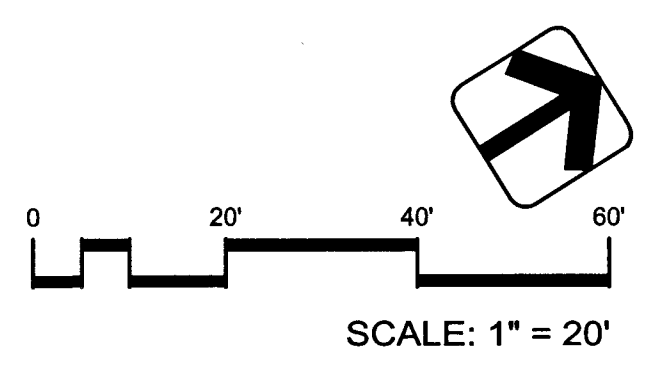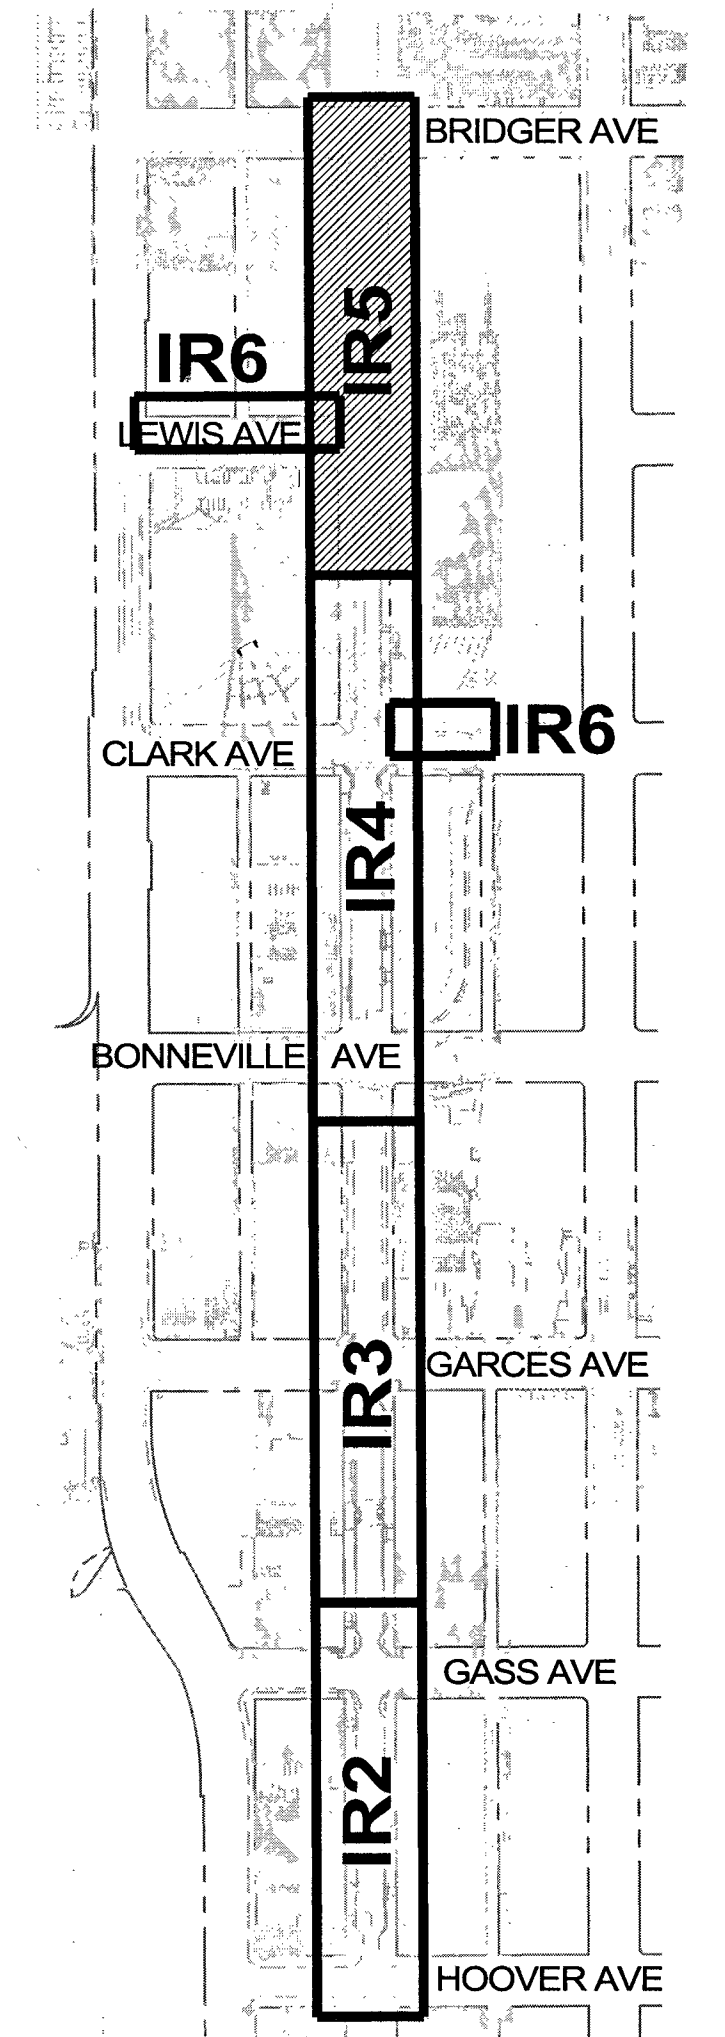

southwick
LANDSCAPE ARCHITECTS

12 Commerce Center Drive
Henderson NV 89014
www.southwickla.com
702.597.3108

FAST
Call before you Dig
UnderGround
1-702-432-5300
FREIGHTWAY AND ARTERIAL
SYSTEM OF TRANSPORTATION

AVOID HITTING OVERHEAD
POWER LINES. IT'S COSTLY.
CALL BEFORE
YOU DO
OVERHEAD
1-702-227-2929

Call before you Dig
Avoid cutting underground
utility lines. It's costly.
Call 811

PUBLIC WORKS DEPARTMENT 1115 W. RANCHO DRIVE LAS VEGAS, NV 89106 702-229-6772		2227 SOUTH RAINBOW BOULEVARD LAS VEGAS, NV 89146 PH (702) 873-2550 FAX (702) 362-2597 WEB SITE WWW.VNIV.COM	
IRRIGATION PLAN STA 32+00.00 TO STA 40+00.00 1ST STREET		DOWNTOWN PEDESTRIAN & BICYCLE IMPROVEMENTS 1ST STREET HOOVER AVENUE TO BRIDGER AVENUE	
DRAWN BY: CD	01/22/13	CHECKED BY: SMS	01/22/13
DESIGNED BY: CD	01/22/13	PROJECT NO.:	11-038
SCALE: AS NOTED		SCALE: AS NOTED	
SHEET 81 OF 83 SHEETS		DRAWING NO. 107V5664-1ST	
REV	DATE	BY	REVISION
6	01/02/14	CD	REVISE BULB-OUT FOR TRAFFIC SIGNAL POLE CLEARANCE