


ENGINEER'S SEAL DATE: 3/22/13 SCALE: 1"=50' JOB NO: WLL-10-068 DESIGNED BY: MC CHECKED BY: RDC SHEET NAME: SWR ASBLT SHEET: 1 OF 1		ANN AND GRAND CANYON - UNIT 2 (SERENITY RIDGE) A RESIDENTIAL SUBDIVISION		SEWER FINAL LOCATION MAP		TANEY ENGINEERING 6090 S. JONES BLVD STE# 100 LAS VEGAS, NV 89118 (702) 362-8844 FAX: (702) 362-5233		WILLIAM LYON HOMES 3900 BLOOMINGDALE ST. #4-G LAS VEGAS, NV 89119 (702) 263-8200 FAX: (702) 263-8220		NO. DESCRIPTION BY DATE APPRO REVISIONS	
--	--	---	--	---------------------------------	--	--	--	---	--	--	--

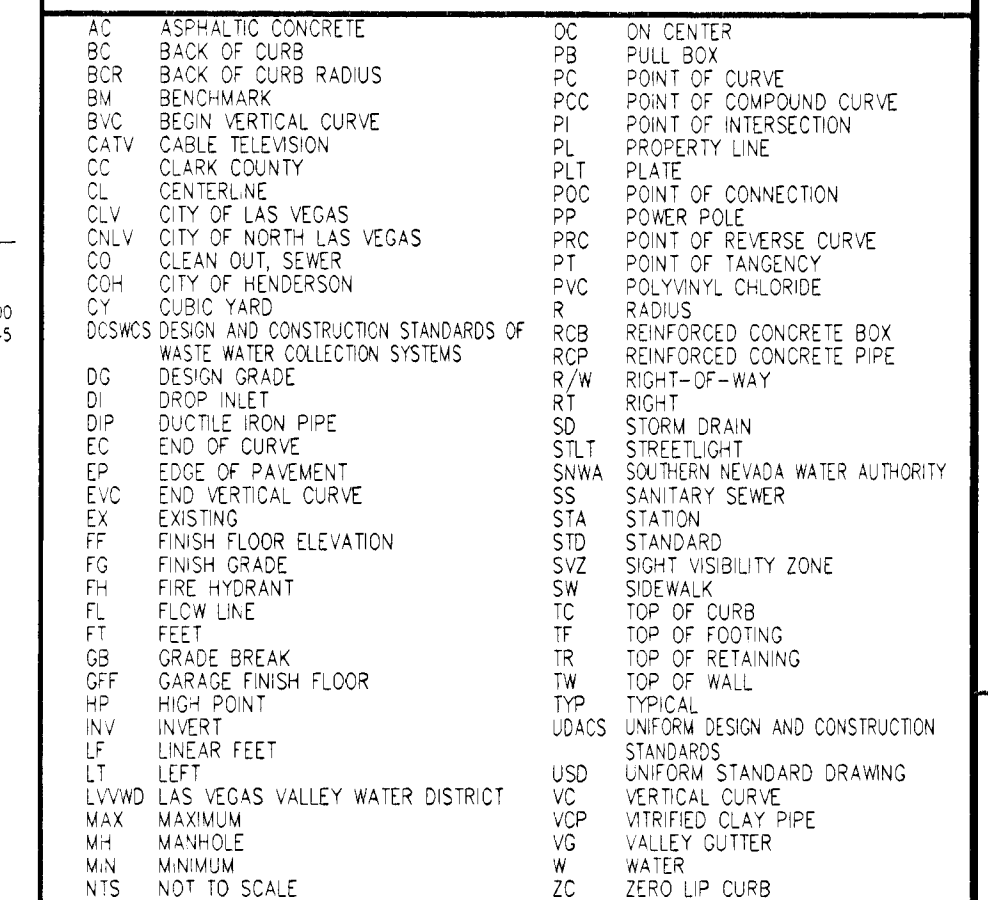

TANEY ENGINEERING
6030 S. JONES BLVD STE# 100
LAS VEGAS, NV 89118
(702) 362-8844 FAX: (702) 362-5233

ENGINEER'S SEAL	
DATE:	3/22/13
SCALE:	1"=50'
JOB NO:	WLL-10-068
DESIGNED BY:	MC
CHECKED BY:	RDC
SHEET NAME:	
SWR ASBLT	
SHEET:	
1	OF 1

RECEIVED
MAR 25 2013
CITY OF LAS VEGAS
SURVEY

Call Before You Dig
AVOID CUTTING UNDERGROUND
UTILITY LINES. IT'S COSTLY.
CALL
811
OR
1-800-227-2600
AND
CLARK COUNTY TRAFFIC OPERATIONS



AVOID HITTING UNDERGROUND
TRAFFIC SIGNAL SYSTEMS
AND STREET LIGHT SYSTEM
CONDUITS ITS COSTLY

Call
1-800-455-7511

UnderGround

CLARK COUNTY TRAFFIC OPERATIONS

1-702-229-6611

LAS VEGAS AREA COMPUTERIZED

HANSEN # 39682

FILE NAME: W1068IMP.DWG

1149
CLV HANSEN # - 39682 / CLV DRAWING # 307V1051-2