


FOUND CLARK COUNTY
GIS CONTROL NO. 826
N 89°40'14" E
(BASIS OF BEARINGS)

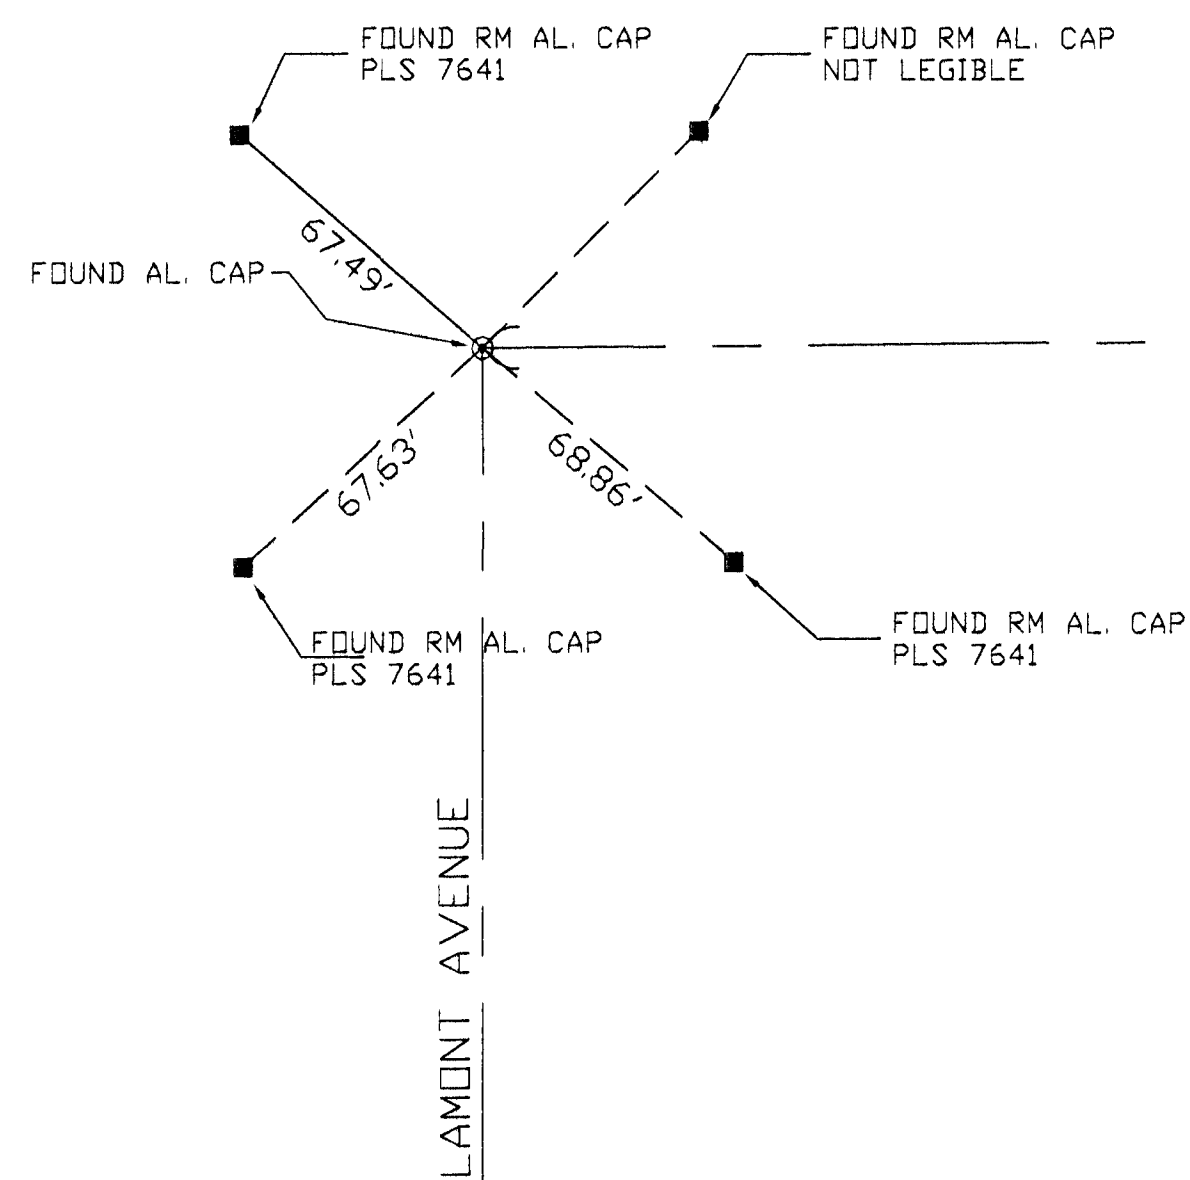

14,311.89'

S 89°26'30" W

CHARLESTON BOULEVARD

666.34'

FOUND RM AL. CAP
PLS 7641
NOT FOUND
SET BRASS CAP
REFERENCE MONUMENT
PLS 14186


YEW AVENUE

FRANK AVENUE

S00°19'46"E
11015'

1647.10'

FOUND CLARK COUNTY
GIS CONTROL NO. 827
15,958.99'

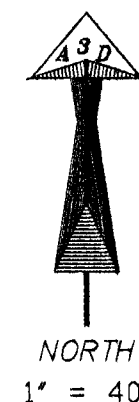

FOUND CLARK COUNTY
GIS CONTROL NO. 826
N 89°40'14" E
(BASIS OF BEARINGS)

FOUND BRASS CAP
REFERENCE MONUMENT
PLS 5094
FOUND AL. CAP
PLS 10598
POINT REMOVED
BY OTHERS
HANDICAP RAMP
CONSTRUCTION

JUNE AVENUE

FOUND BRASS CAP
REFERENCE MONUMENT
PLS 5094

CHARLESTON BOULEVARD

N 89°45'07" E

FOUND BRASS CAP
REFERENCE MONUMENT
PLS 5094

FOUND BRASS CAP
REFERENCE MONUMENT
PLS 5094

MAY AVENUE

S00°19'46"E
165.60'



FOUND BRASS CAP
REFERENCE MONUMENT
PLS 5094

FOUND AL. CAP
PLS 10598

POINT REMOVED
BY OTHERS
HANDICAP RAMP
CONSTRUCTION

10,713.23'

FOUND CLARK COUNTY
GIS CONTROL NO. 827
15,958.99'

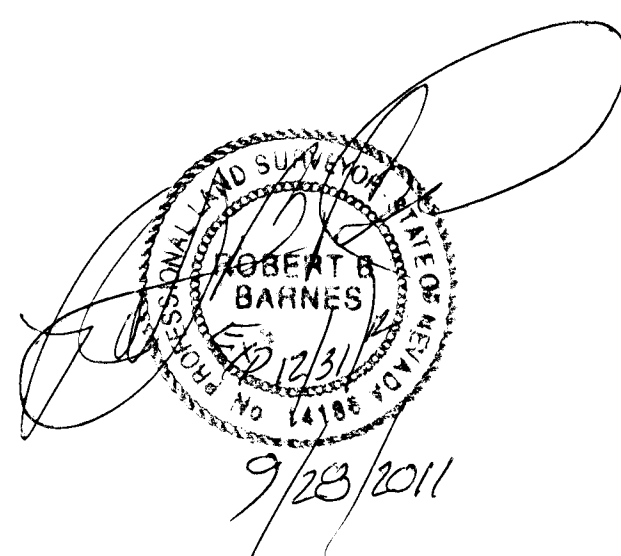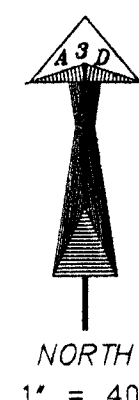

SURVEYOR'S NOTE

Based upon the current configuration of bus turnouts being constructed for this project only one location was affected by new construction of this project for bus turn outs as noted. Distances shown by record may or may not reflect the distances measured in the field at time of survey. Surveyor shall not be held liable for distances shown and stamped by other professional surveyors. Only points set and noted by this map. All other monuments located during the control survey were found to be located outside any proposed improvements. Distances shown or set are what each reference monument reads in the field unless noted as not legible.

BASIS OF BEARINGS

North 89°40'14" East, being the bearing of the line between Clark County GIS Control Monuments 826 & 827 as calculated from the Record of Survey, File 88, Page 53 of Surveys, on file in the Office of the Clark County Recorder, Clark County, Nevada.

A3D SURVEYS
292 BEN JOHNSON COURT
LAS VEGAS, NEVADA 89183
PHONE (702) 456-7226
FAX (888) 236-6889

DESIGNED BY: RBB

DRAWN BY: ACAD2004

CHECKED BY: RBB

MONUMENT TIE SHEET FOR BUS TURNOUT PROJECT FY 2005
CHARLESTON BOULEVARD FROM NELLIS TO FREMONT STREET
CG & B ENTERPRISES

NEVADA

CLARK COUNTY

LAS VEGAS

SCALES

HORIZ: 1" = 40'

VERT: NONE

JOB NO:

SHEET

1

OF

1

NOV 07 2011

CG&B ENTERPRISES, INC.

OCT 03 2011

RECEIVED

107V4763-T12