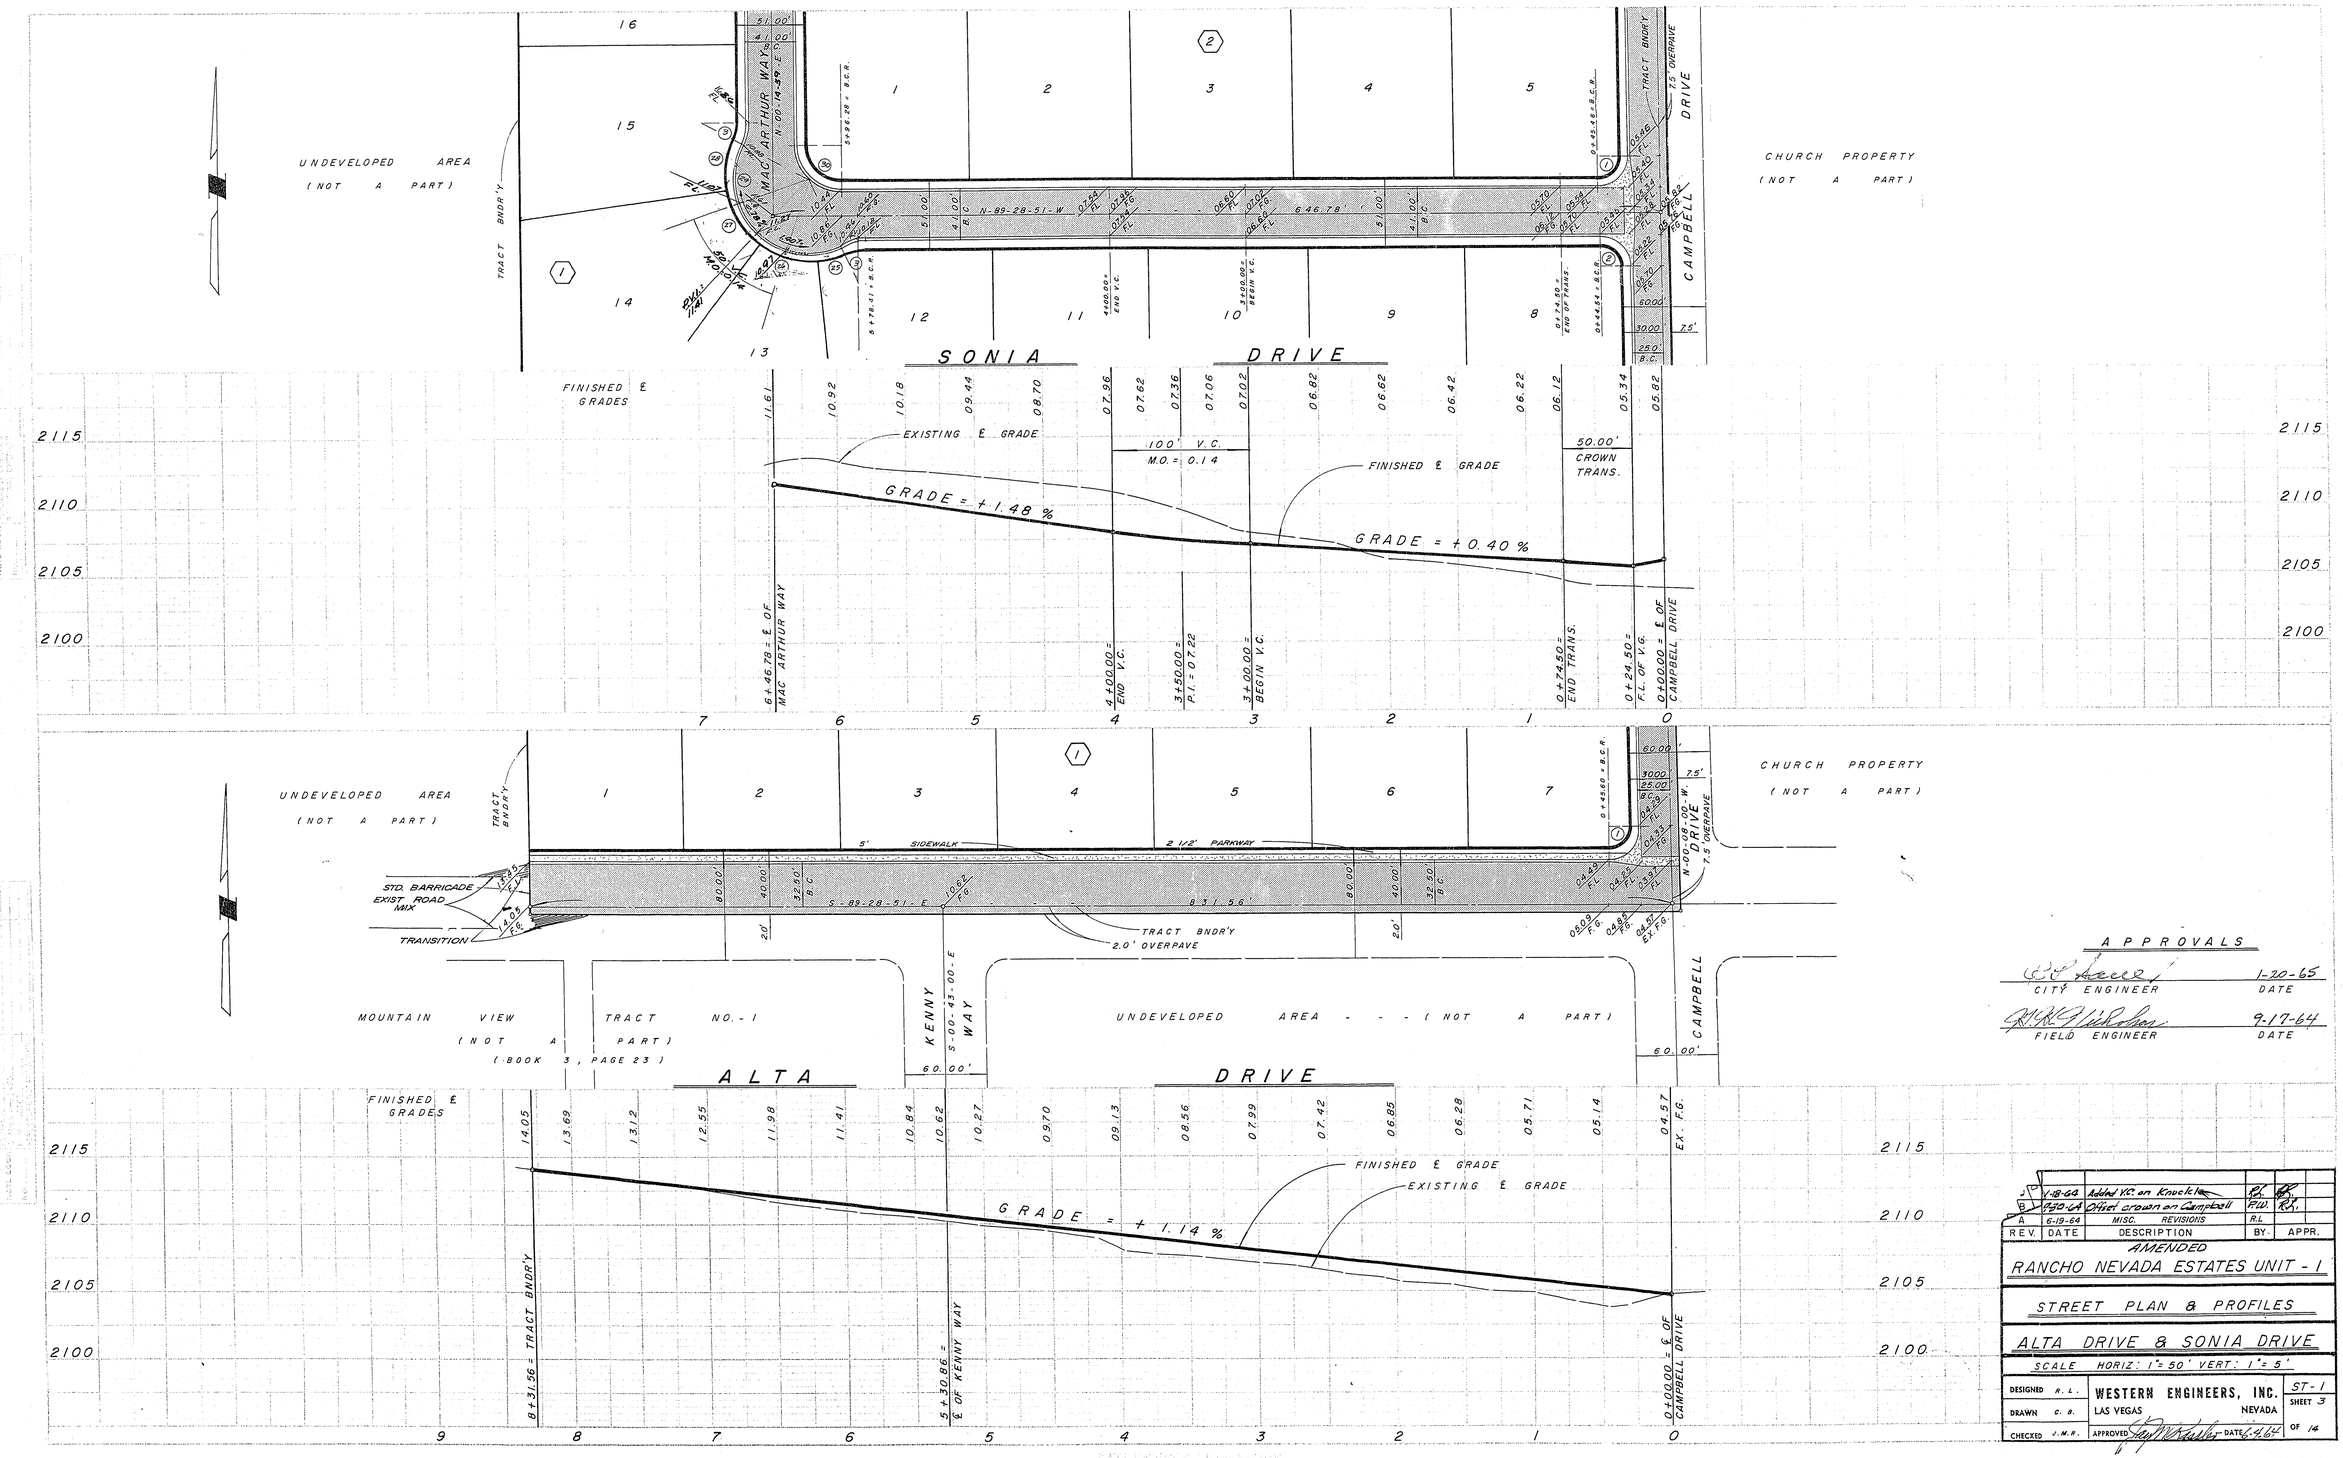

APPROVALS

CITY ENGINEER	1-20-65 DATE
FIELD ENGINEER	9-17-64 DATE

REV.	DATE	DESCRIPTION	BY	APPR.
J	1-18-64	Added V.C. on Knuckle	R.L.	
B	1-30-64	Offset crown on Campbell	F.W.	
A	6-19-64	MISC. REVISIONS	R.L.	

AMENDED

RANCHO NEVADA ESTATES UNIT - 1

STREET PLAN & PROFILES

ALTA DRIVE & SONIA DRIVE

SCALE HORIZ: 1" = 50' VERT: 1" = 5'

DESIGNED R.L. | DRAWN C.B. | CHECKED J.M.R.

WESTERN ENGINEERS, INC.
LAS VEGAS NEVADA

APPROVED DATE 6-4-64

ST-1 SHEET 3 OF 14

1079-2575-1