


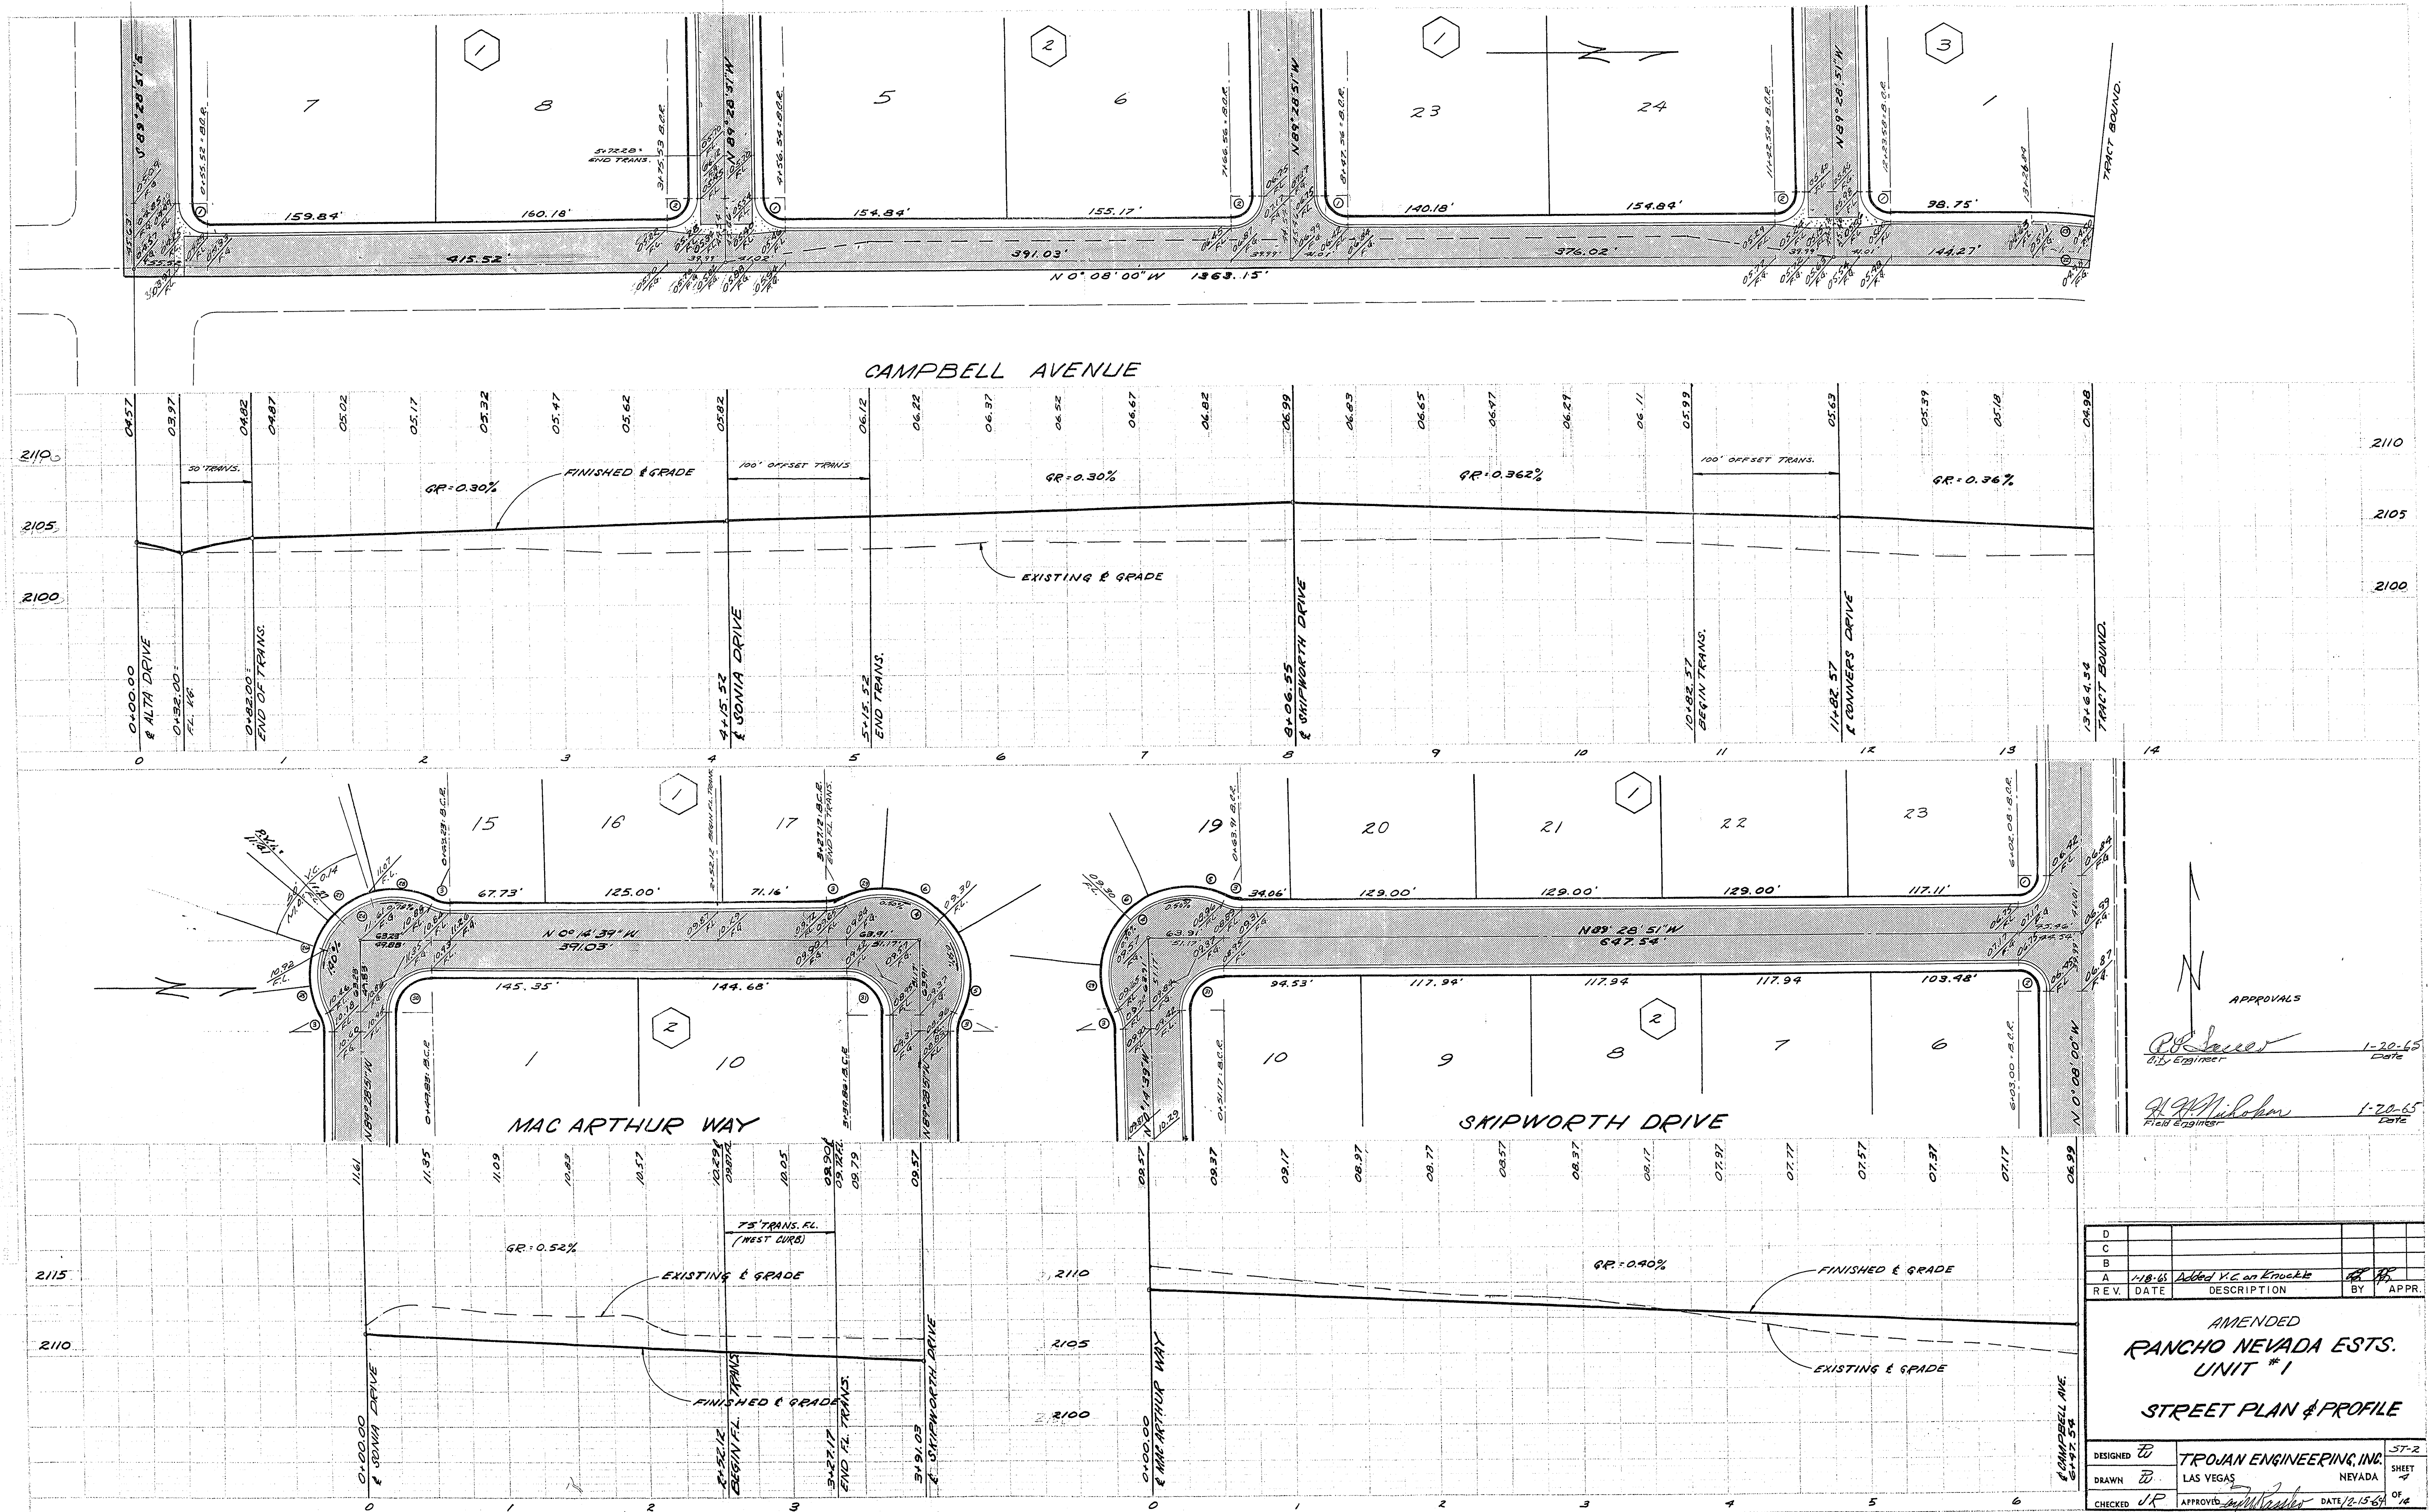

D					
C					
B					
A	1-18-65	Added V.C. on Kneels	BY	APPR.	
REV.	DATE	DESCRIPTION	BY	APPR.	
AMENDED					
RANCHO NEVADA ESTS.					
UNIT #1					
STREET PLAN & PROFILE					
DESIGNED	TD	TROJAN ENGINEERING, INC.	57-2		
DRAWN	TD	LAS VEGAS	NEVADA		
CHECKED	JP	APPROVED	DATE 12-15-65		

1074-2575-1