

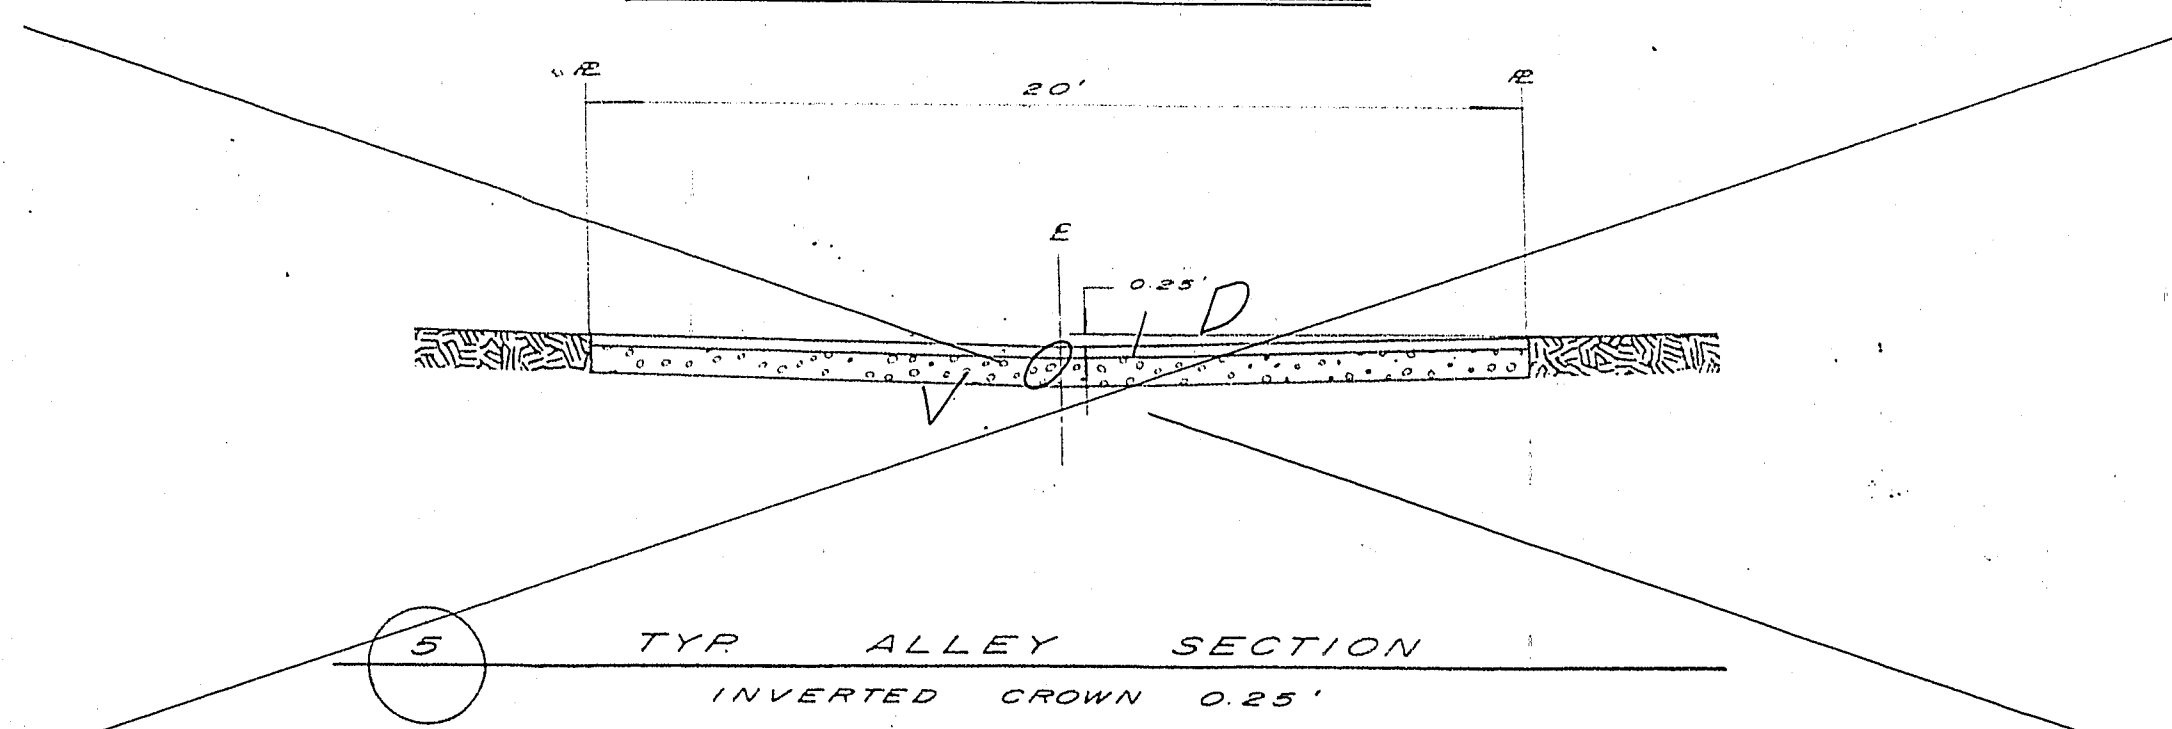
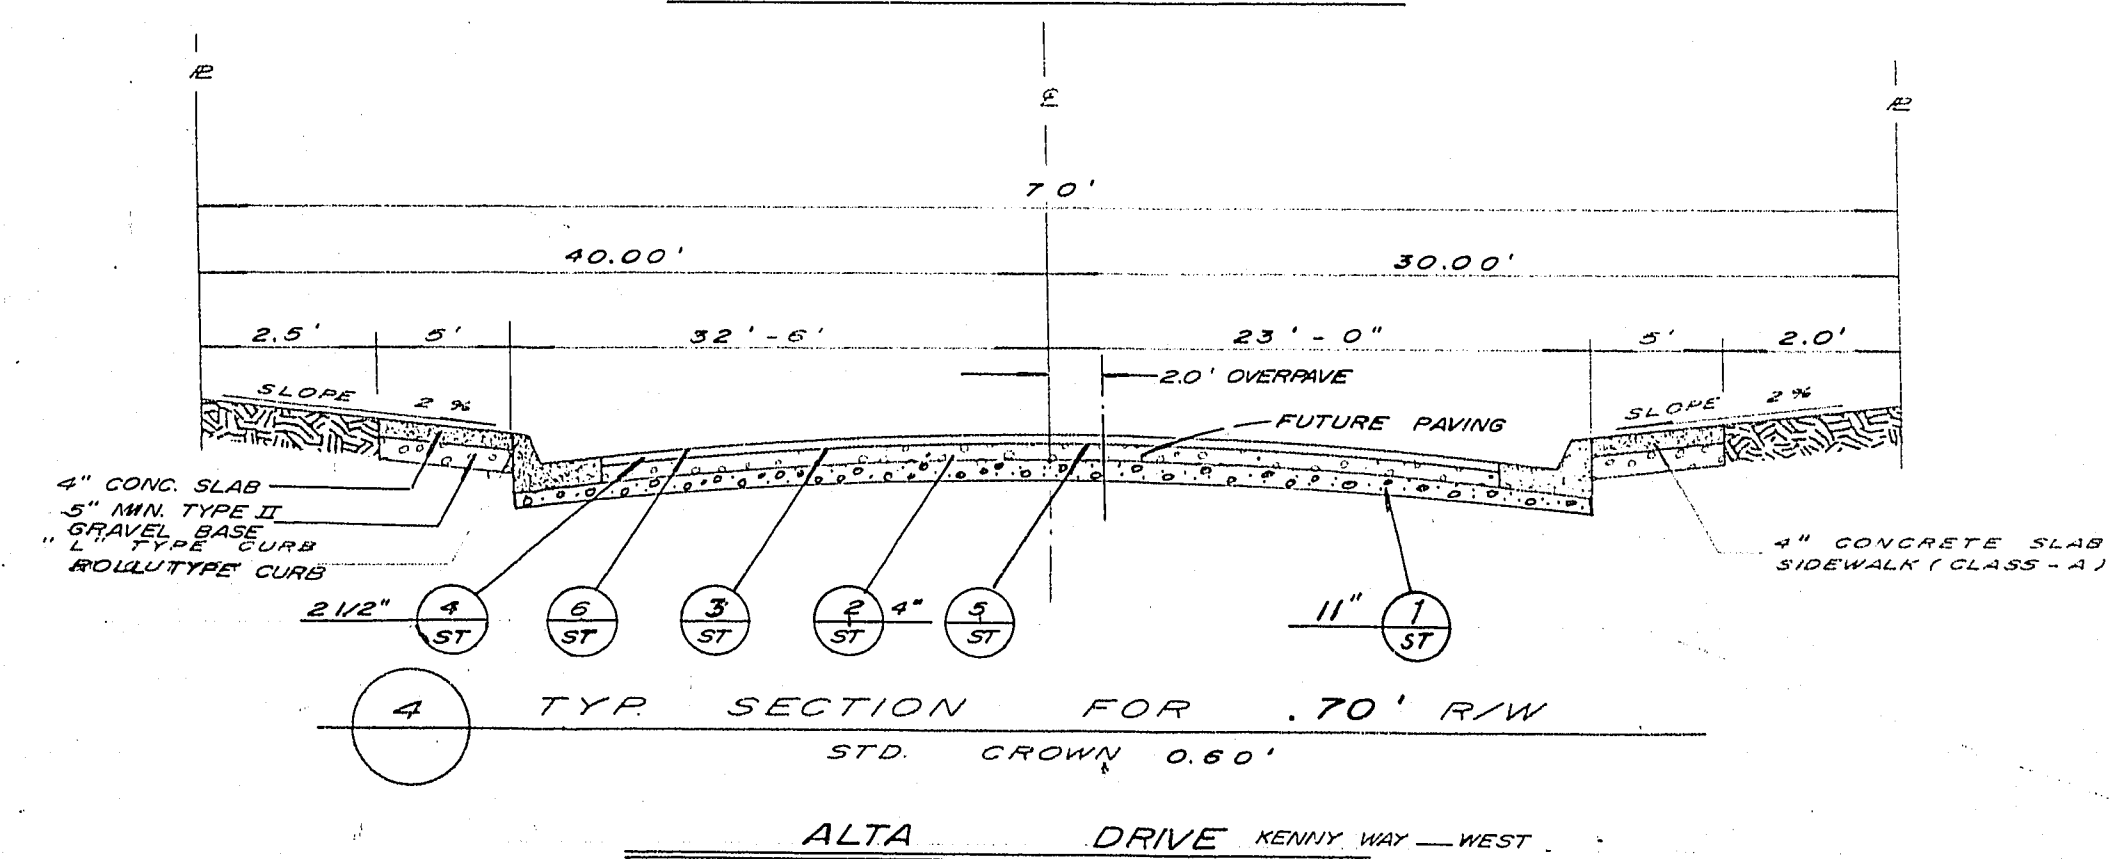
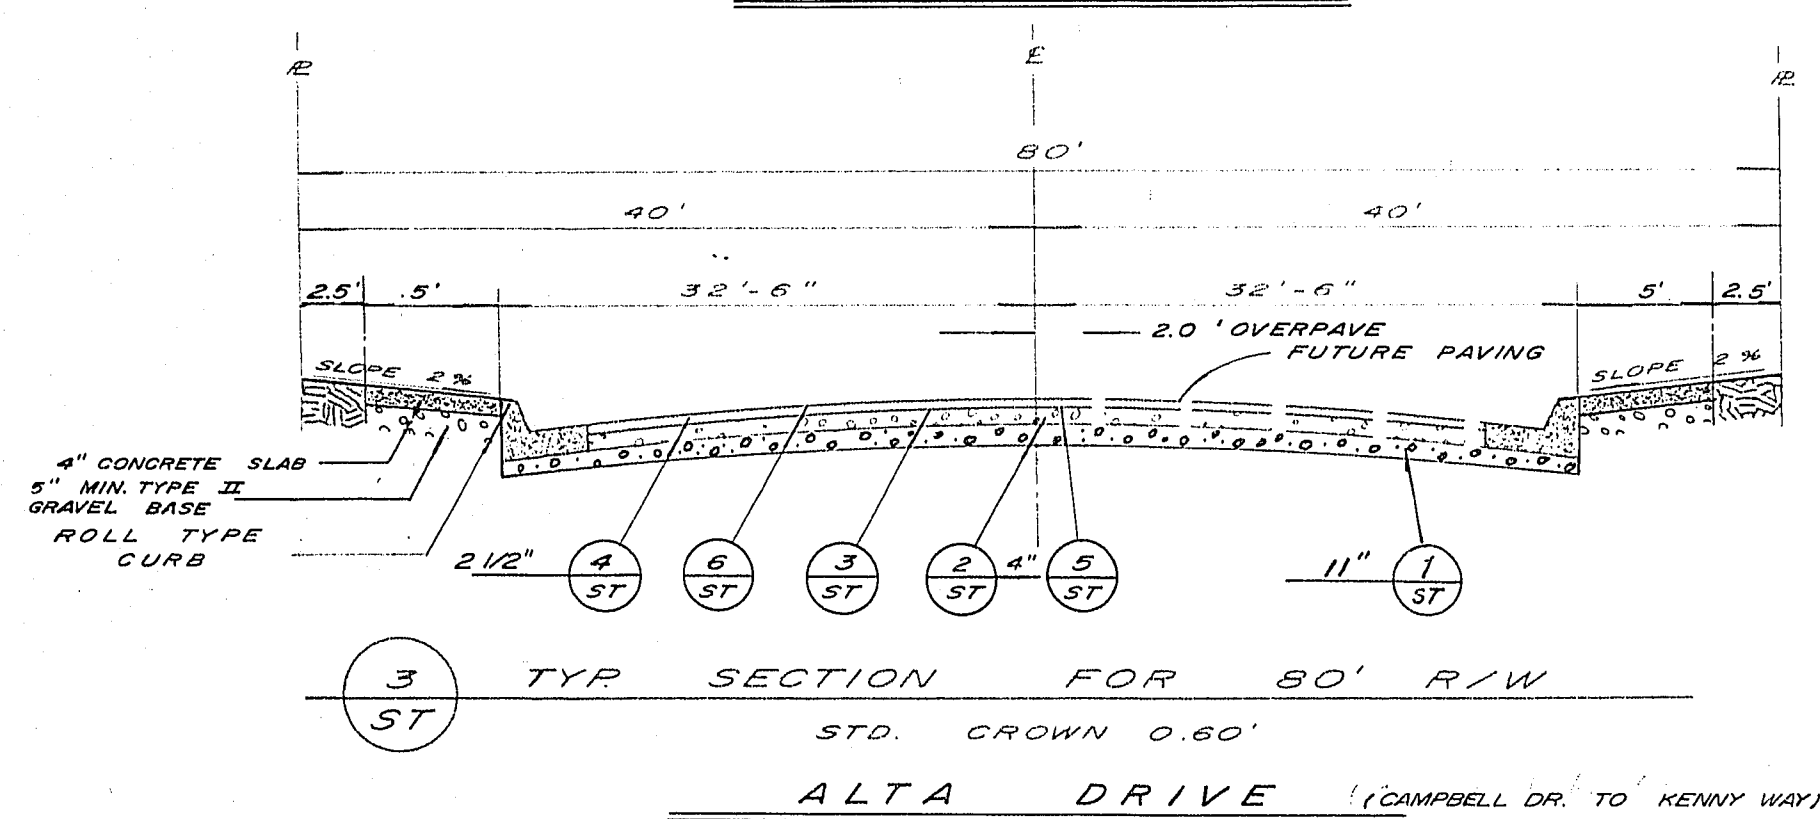
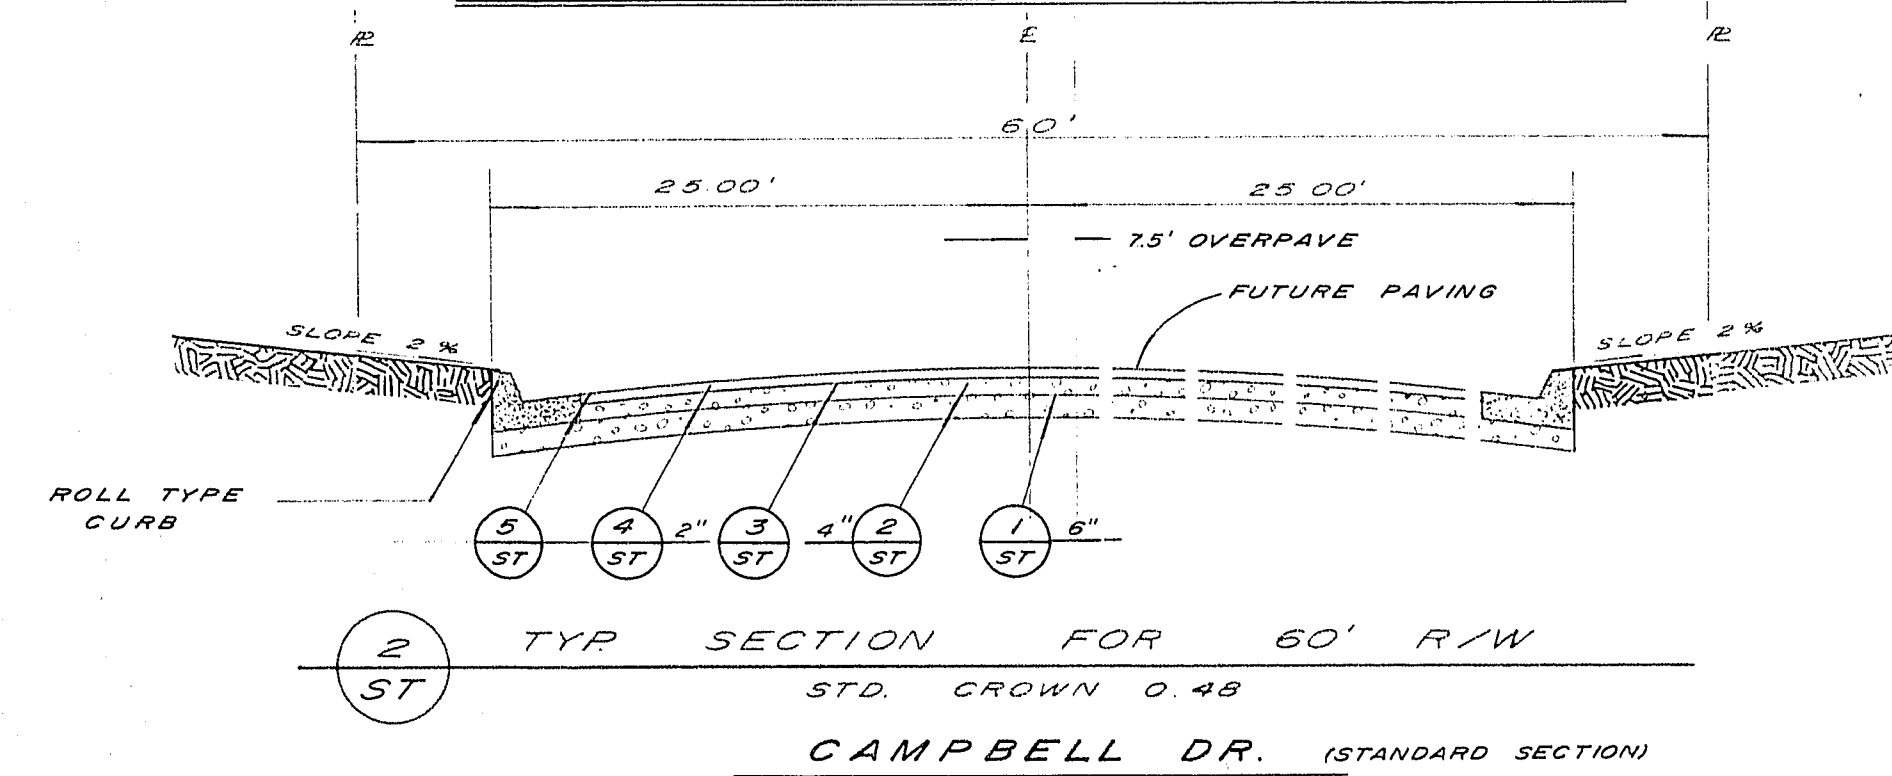
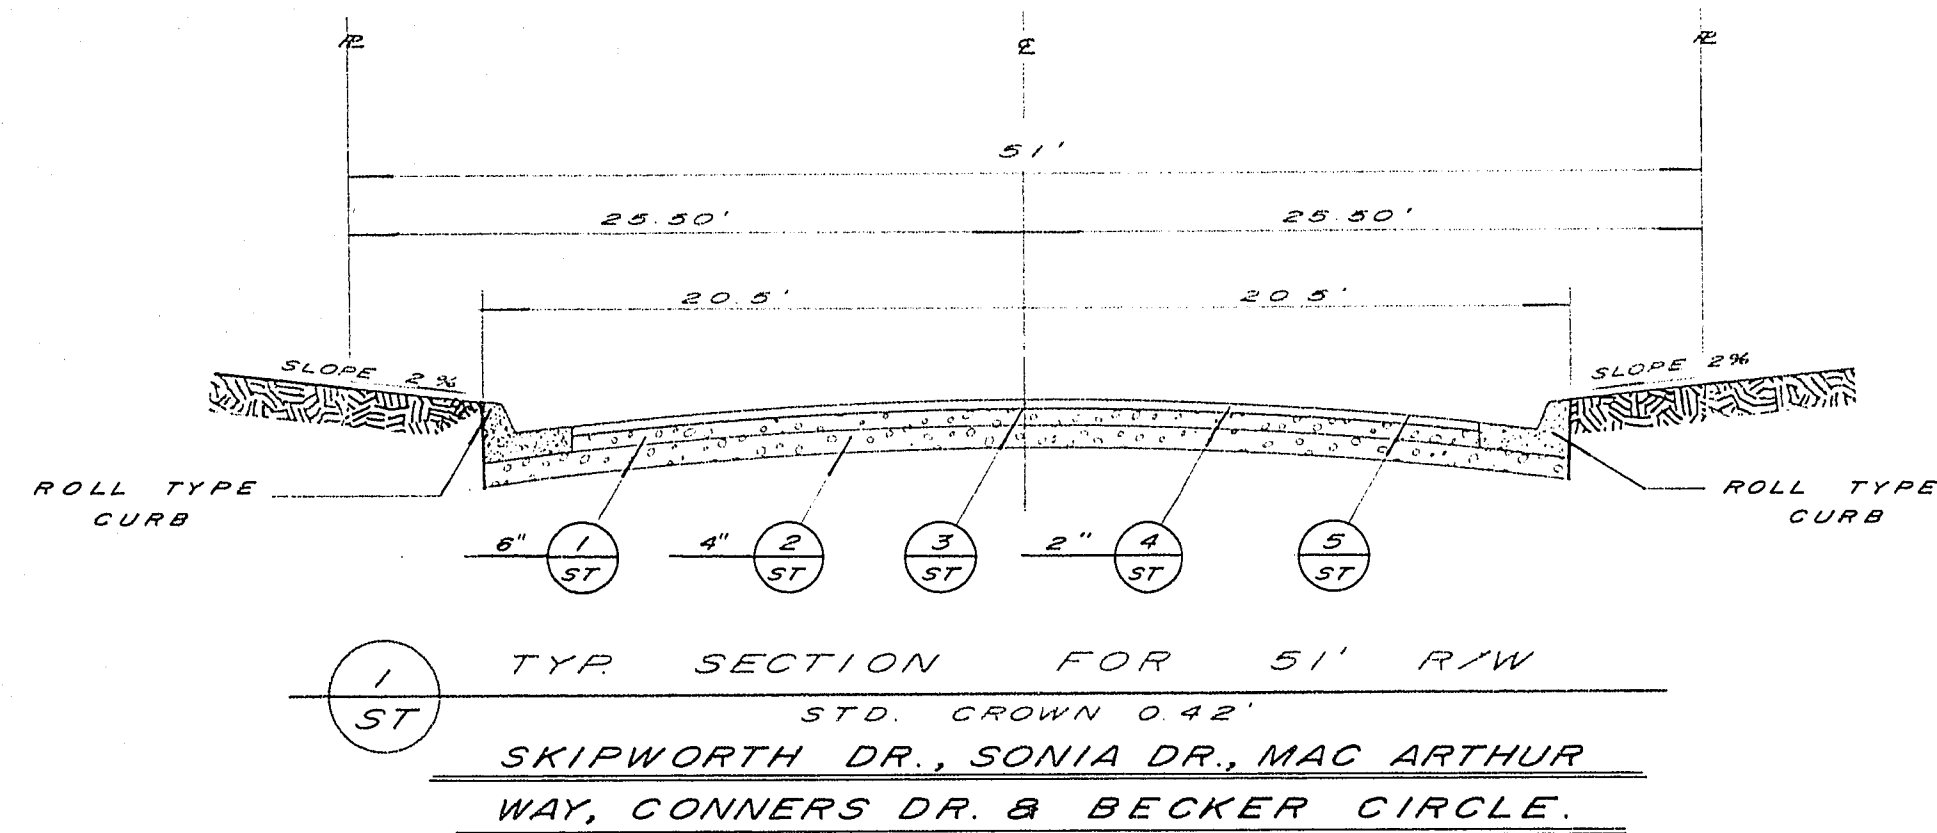
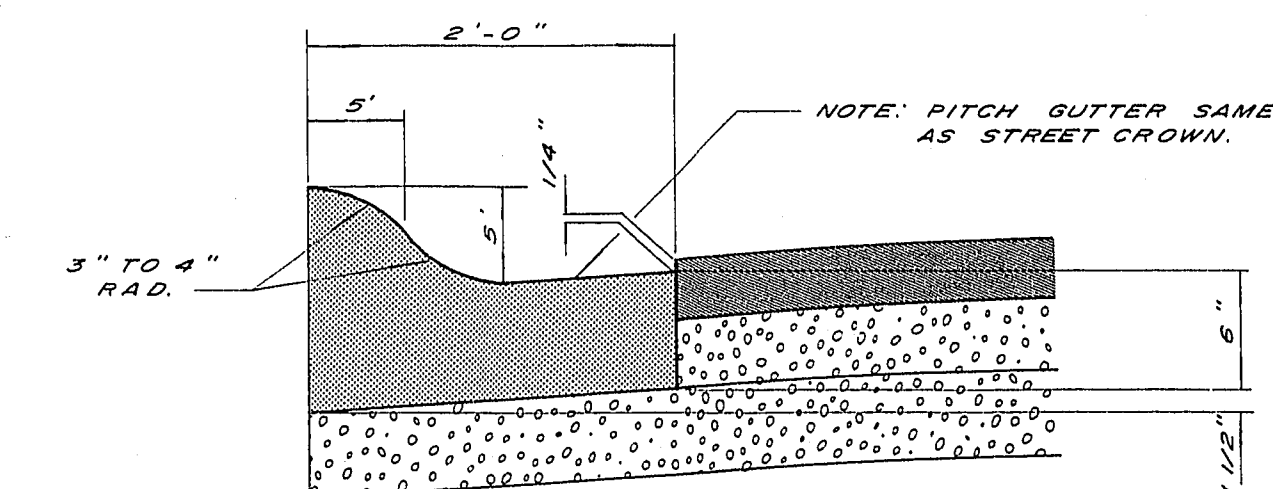
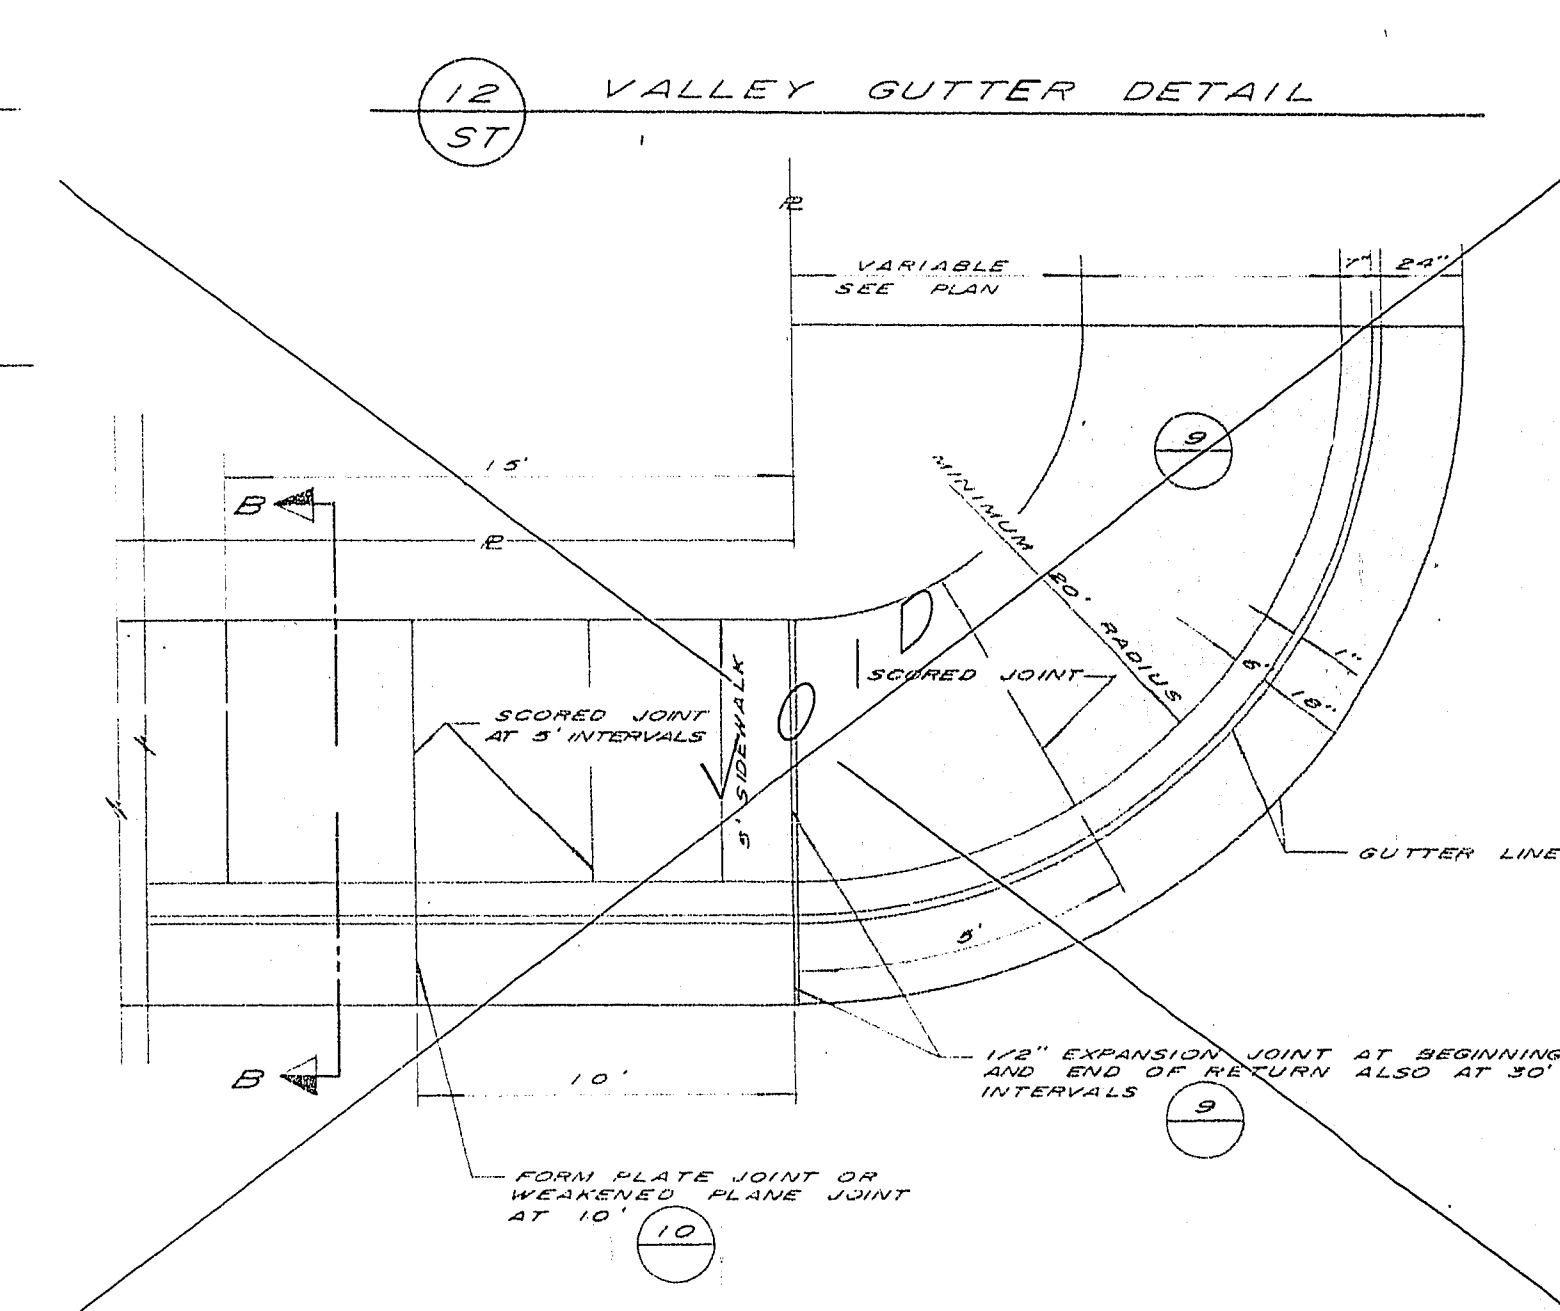
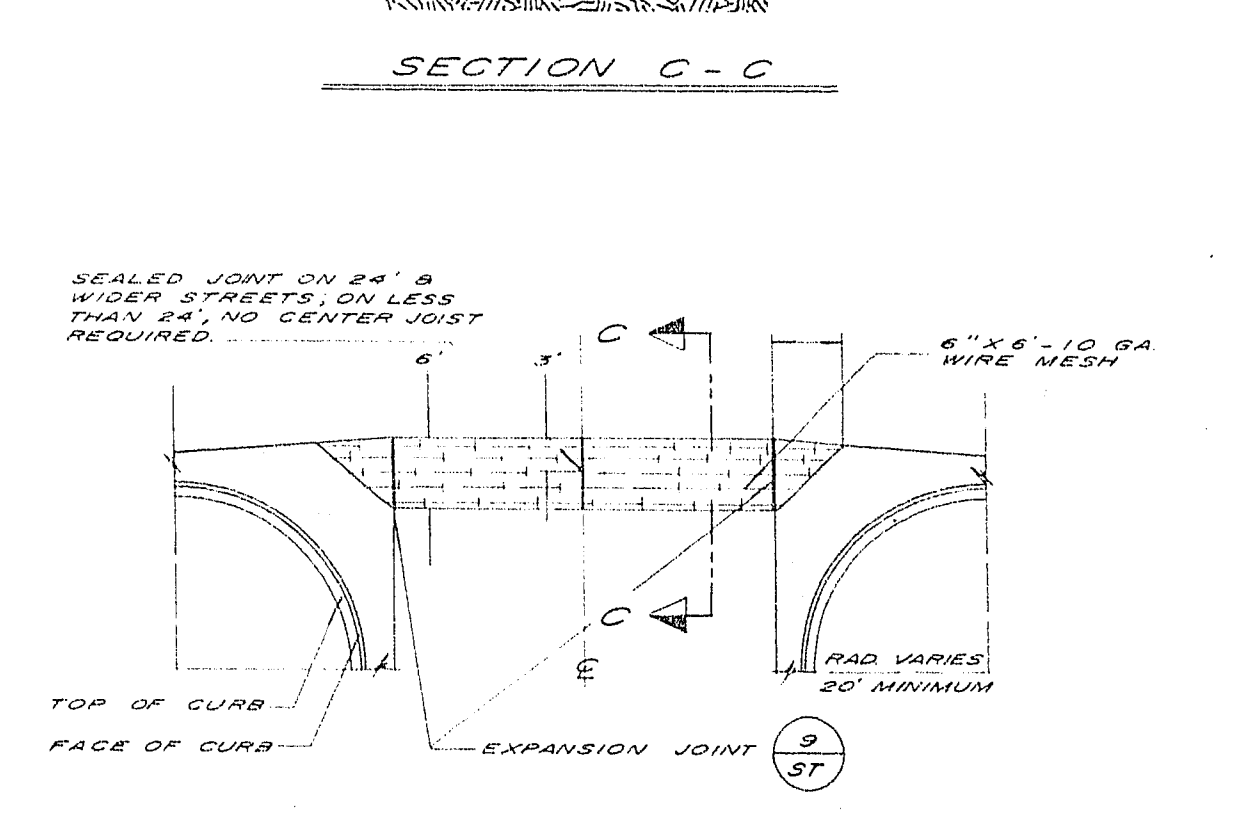
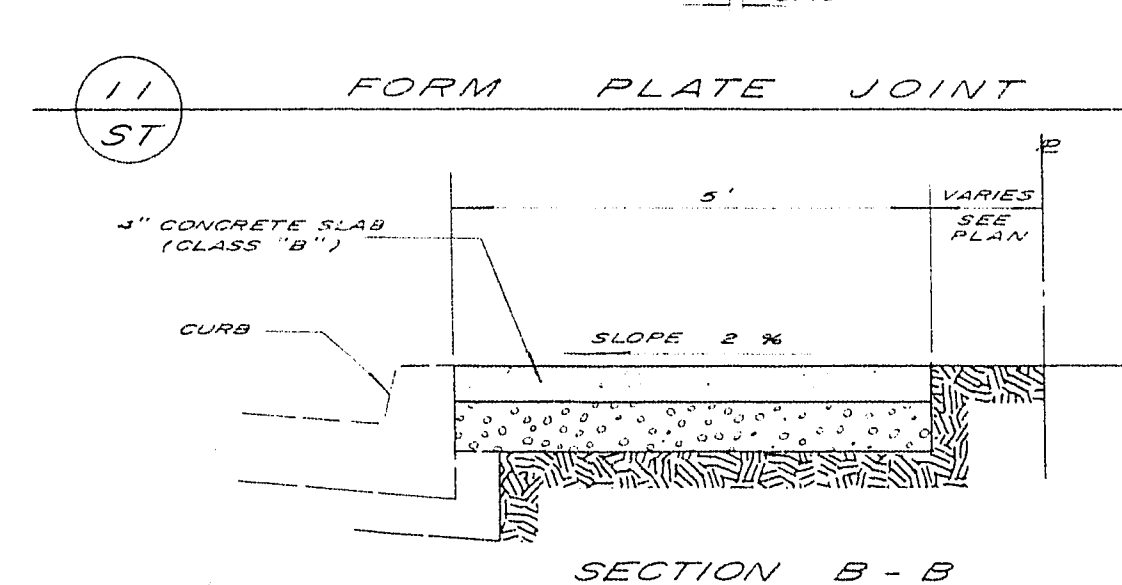
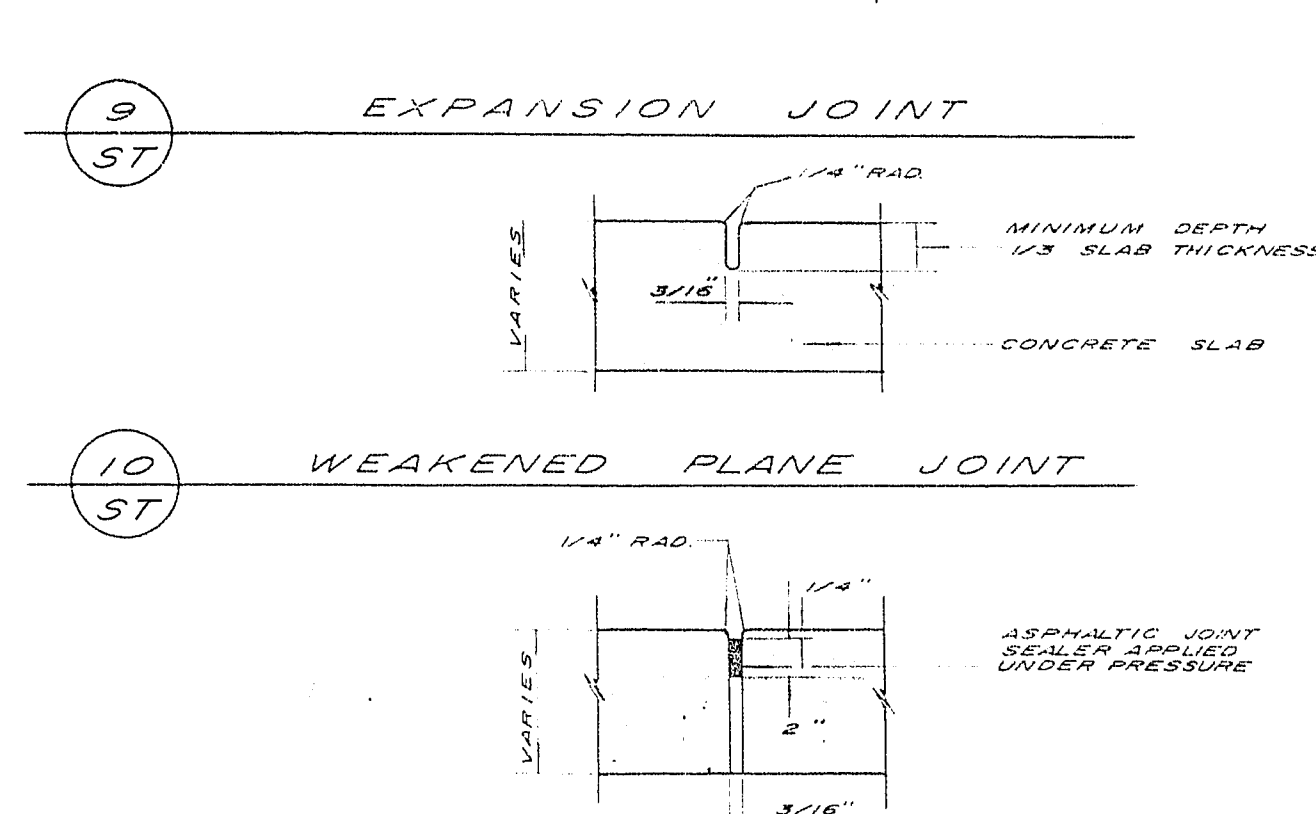
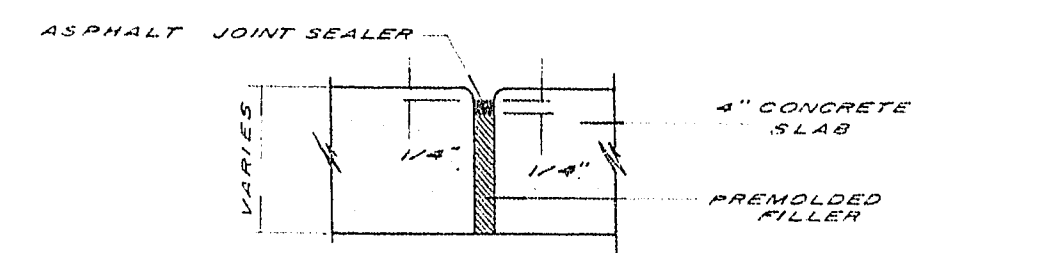
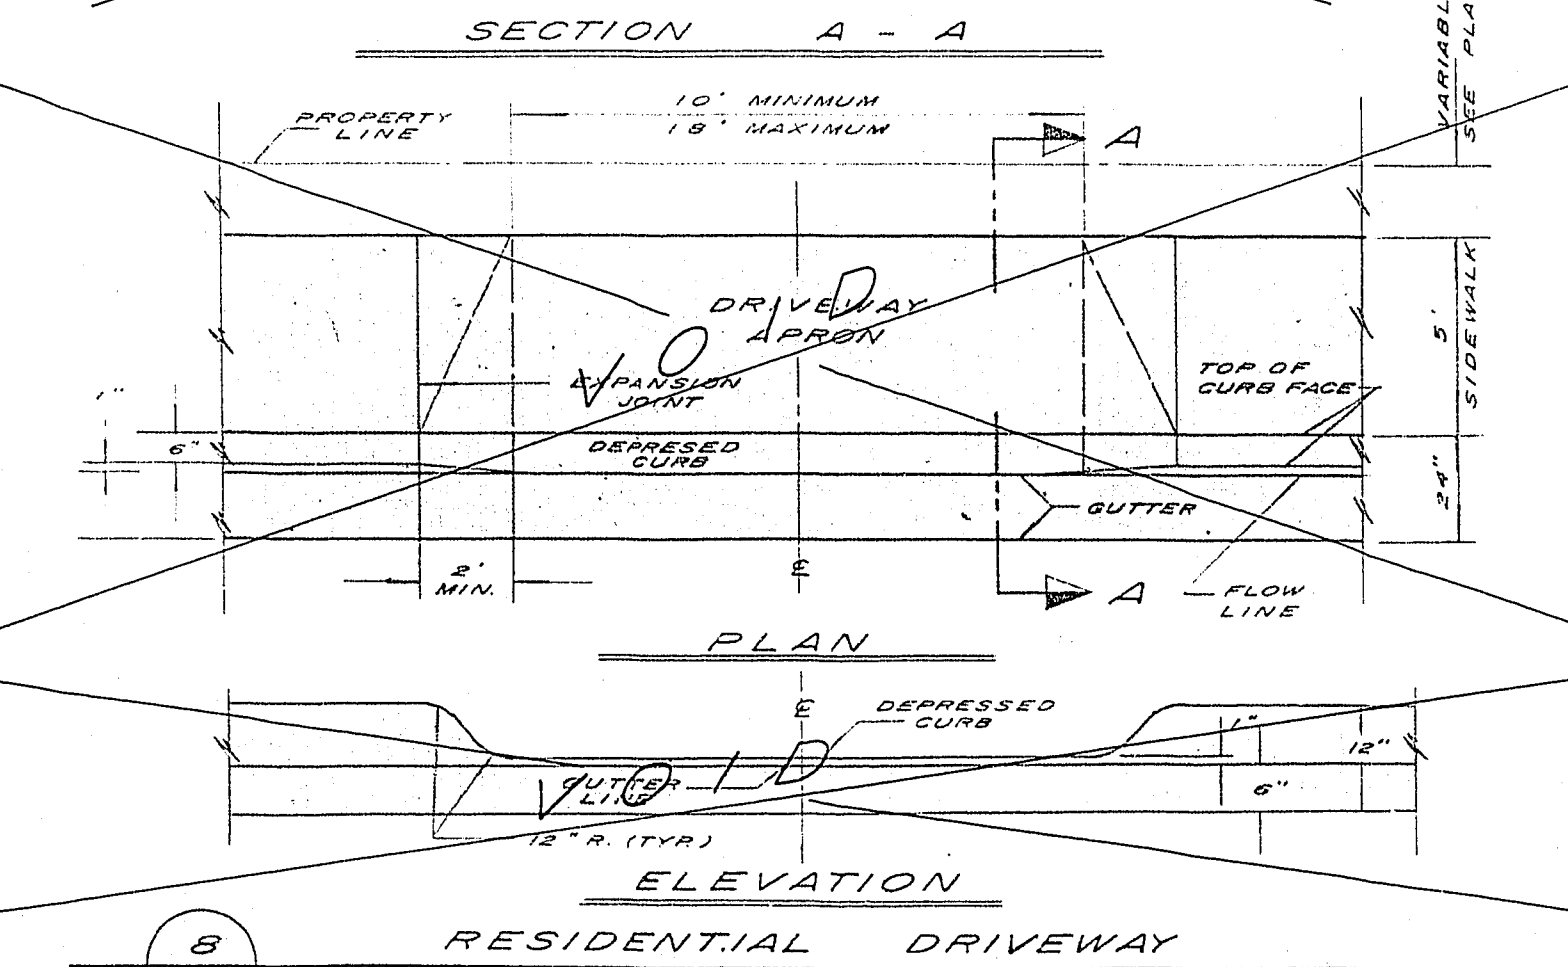


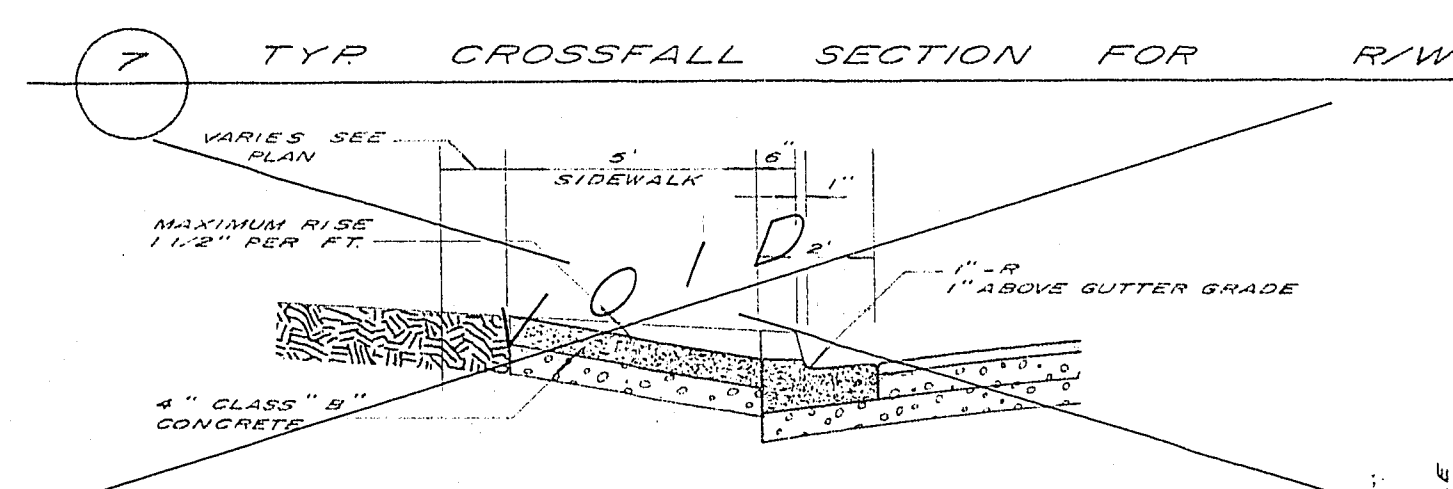

- LEGEND**
- ① TYPE I GRAVEL BASE
 - ② TYPE II GRAVEL BASE
 - ③ BITUMINOUS PRIME COAT
 - ④ BITUMINOUS ASPHALTIC CONCRETE
 - ⑤ BITUMINOUS FOG SEAL COAT
 - ⑥ BITUMINOUS SEAL COAT & CHIPS
 - ⑦ SECTION OR DETAIL NUMBER
 - ⑧ SHEET NUMBER OF SHEET ON WHICH DETAIL IS SHOWN

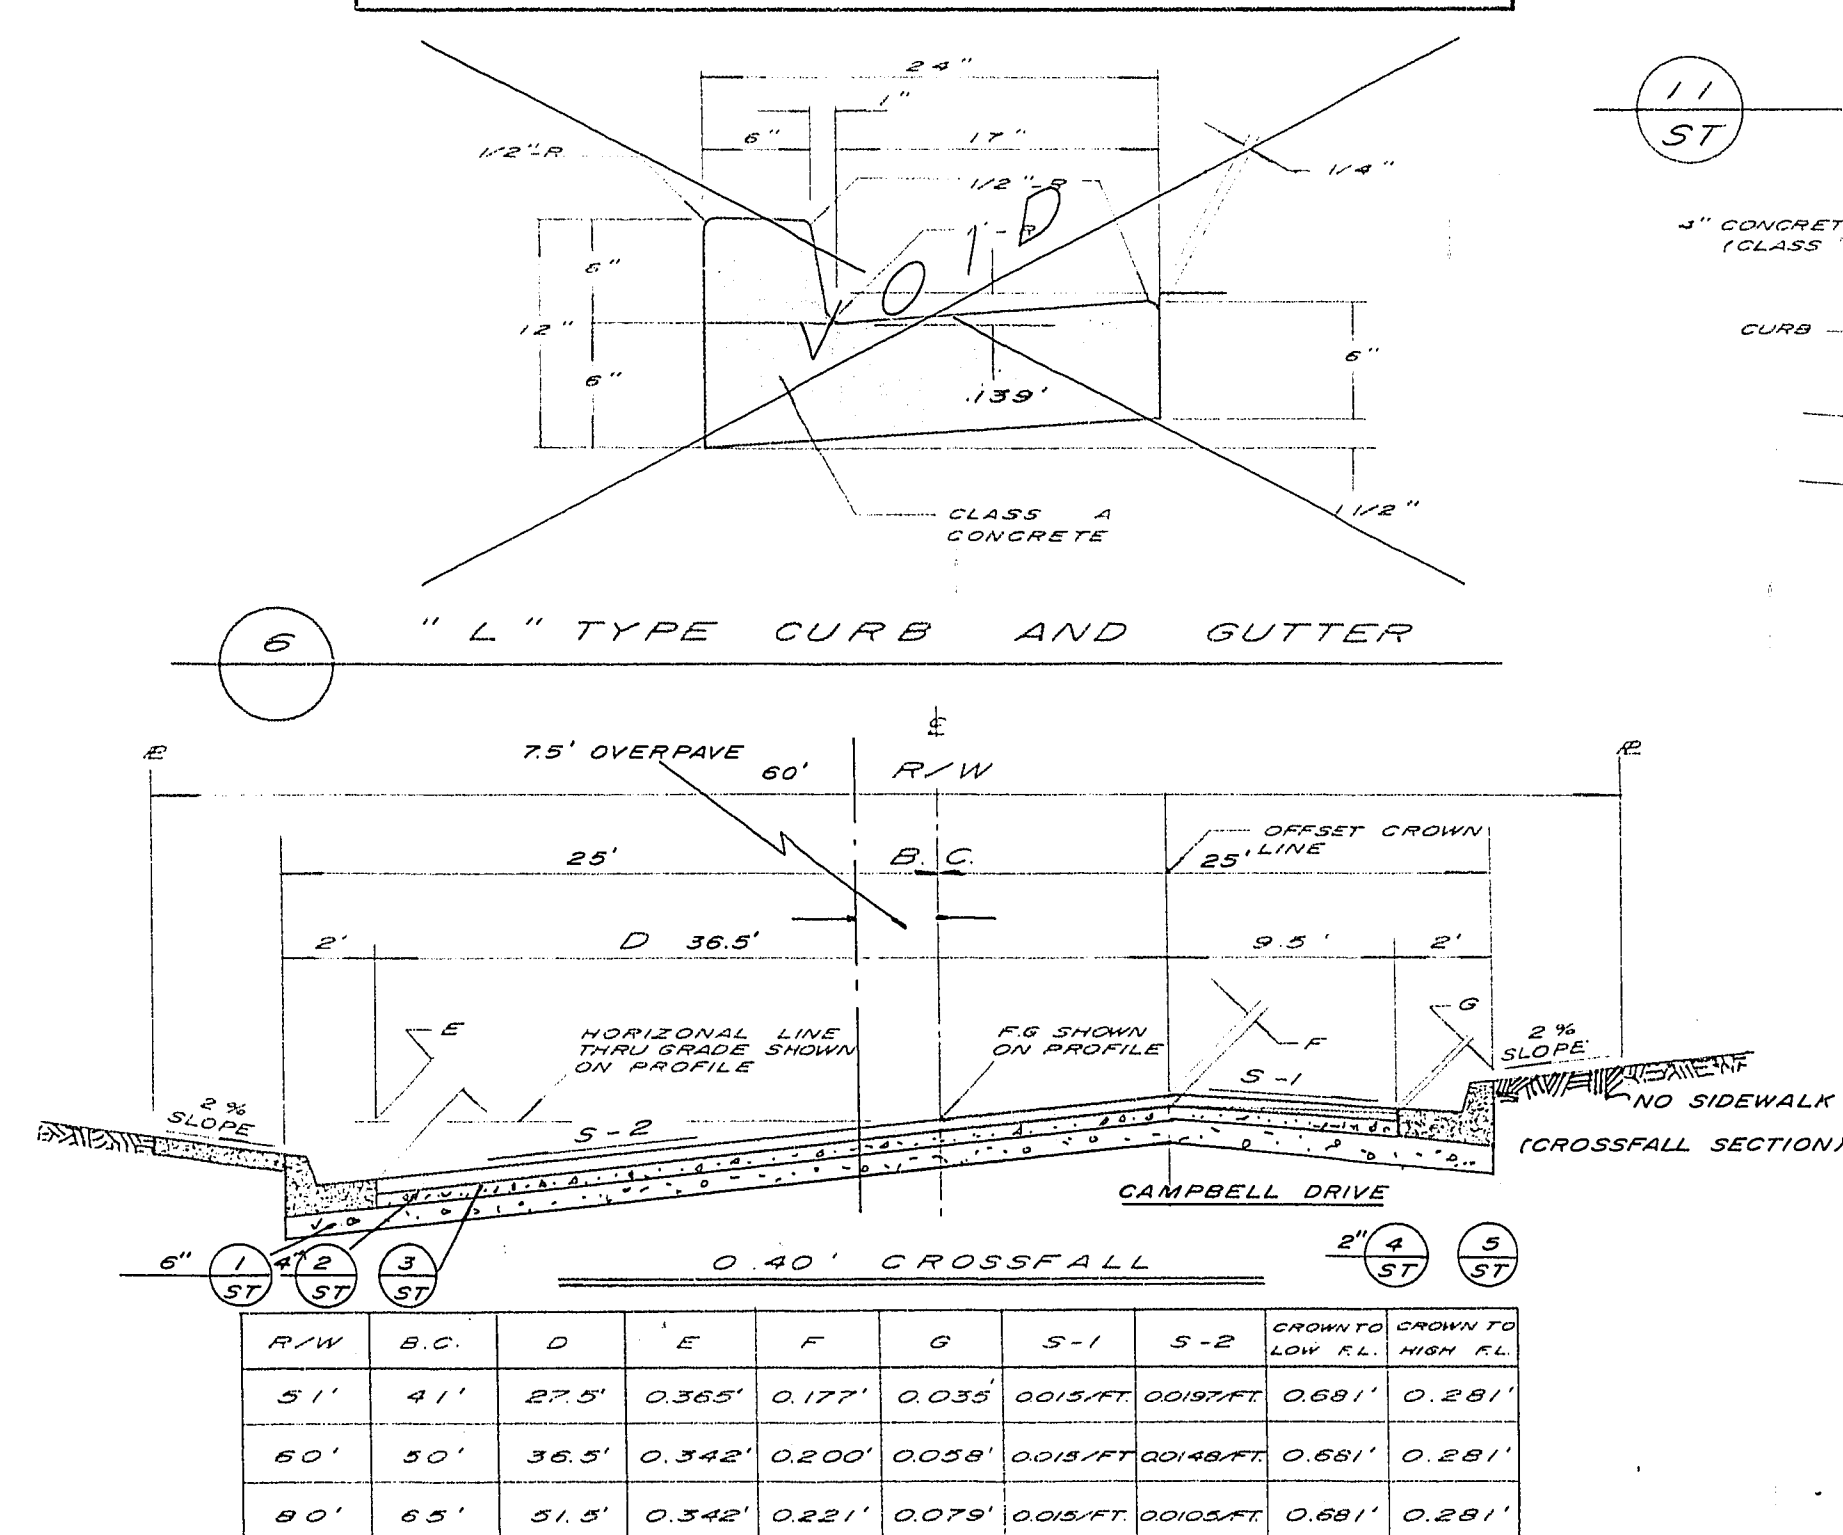

APPROVALS

CITY ENGINEER: 1-20-65
FIELD ENGINEER: 9-17-64

REV	DATE	DESCRIPTION	BY	APPR
D	1-20-64	Offset crown on Campbell	RW	RL
C	9-9-64	TYP 1/2 SECTION TO ALTA	RL	
B	9-9-64	TYP 1/2 SECTION TO ALTA	RL	
A	6-19-64	ADDED SIDEWALK - ALTA DR.	RL	

AMENDED
RANCHO NEVADA
ESTATES UNIT-1

TYPICAL STREET DETAILS
NO SCALE

DESIGNED	DRAWN	CHECKED	APPROVED	DATE
WESTERN ENGINEERS, INC.	C.B.			6-4-64

10-6-64 1004-2575-1