


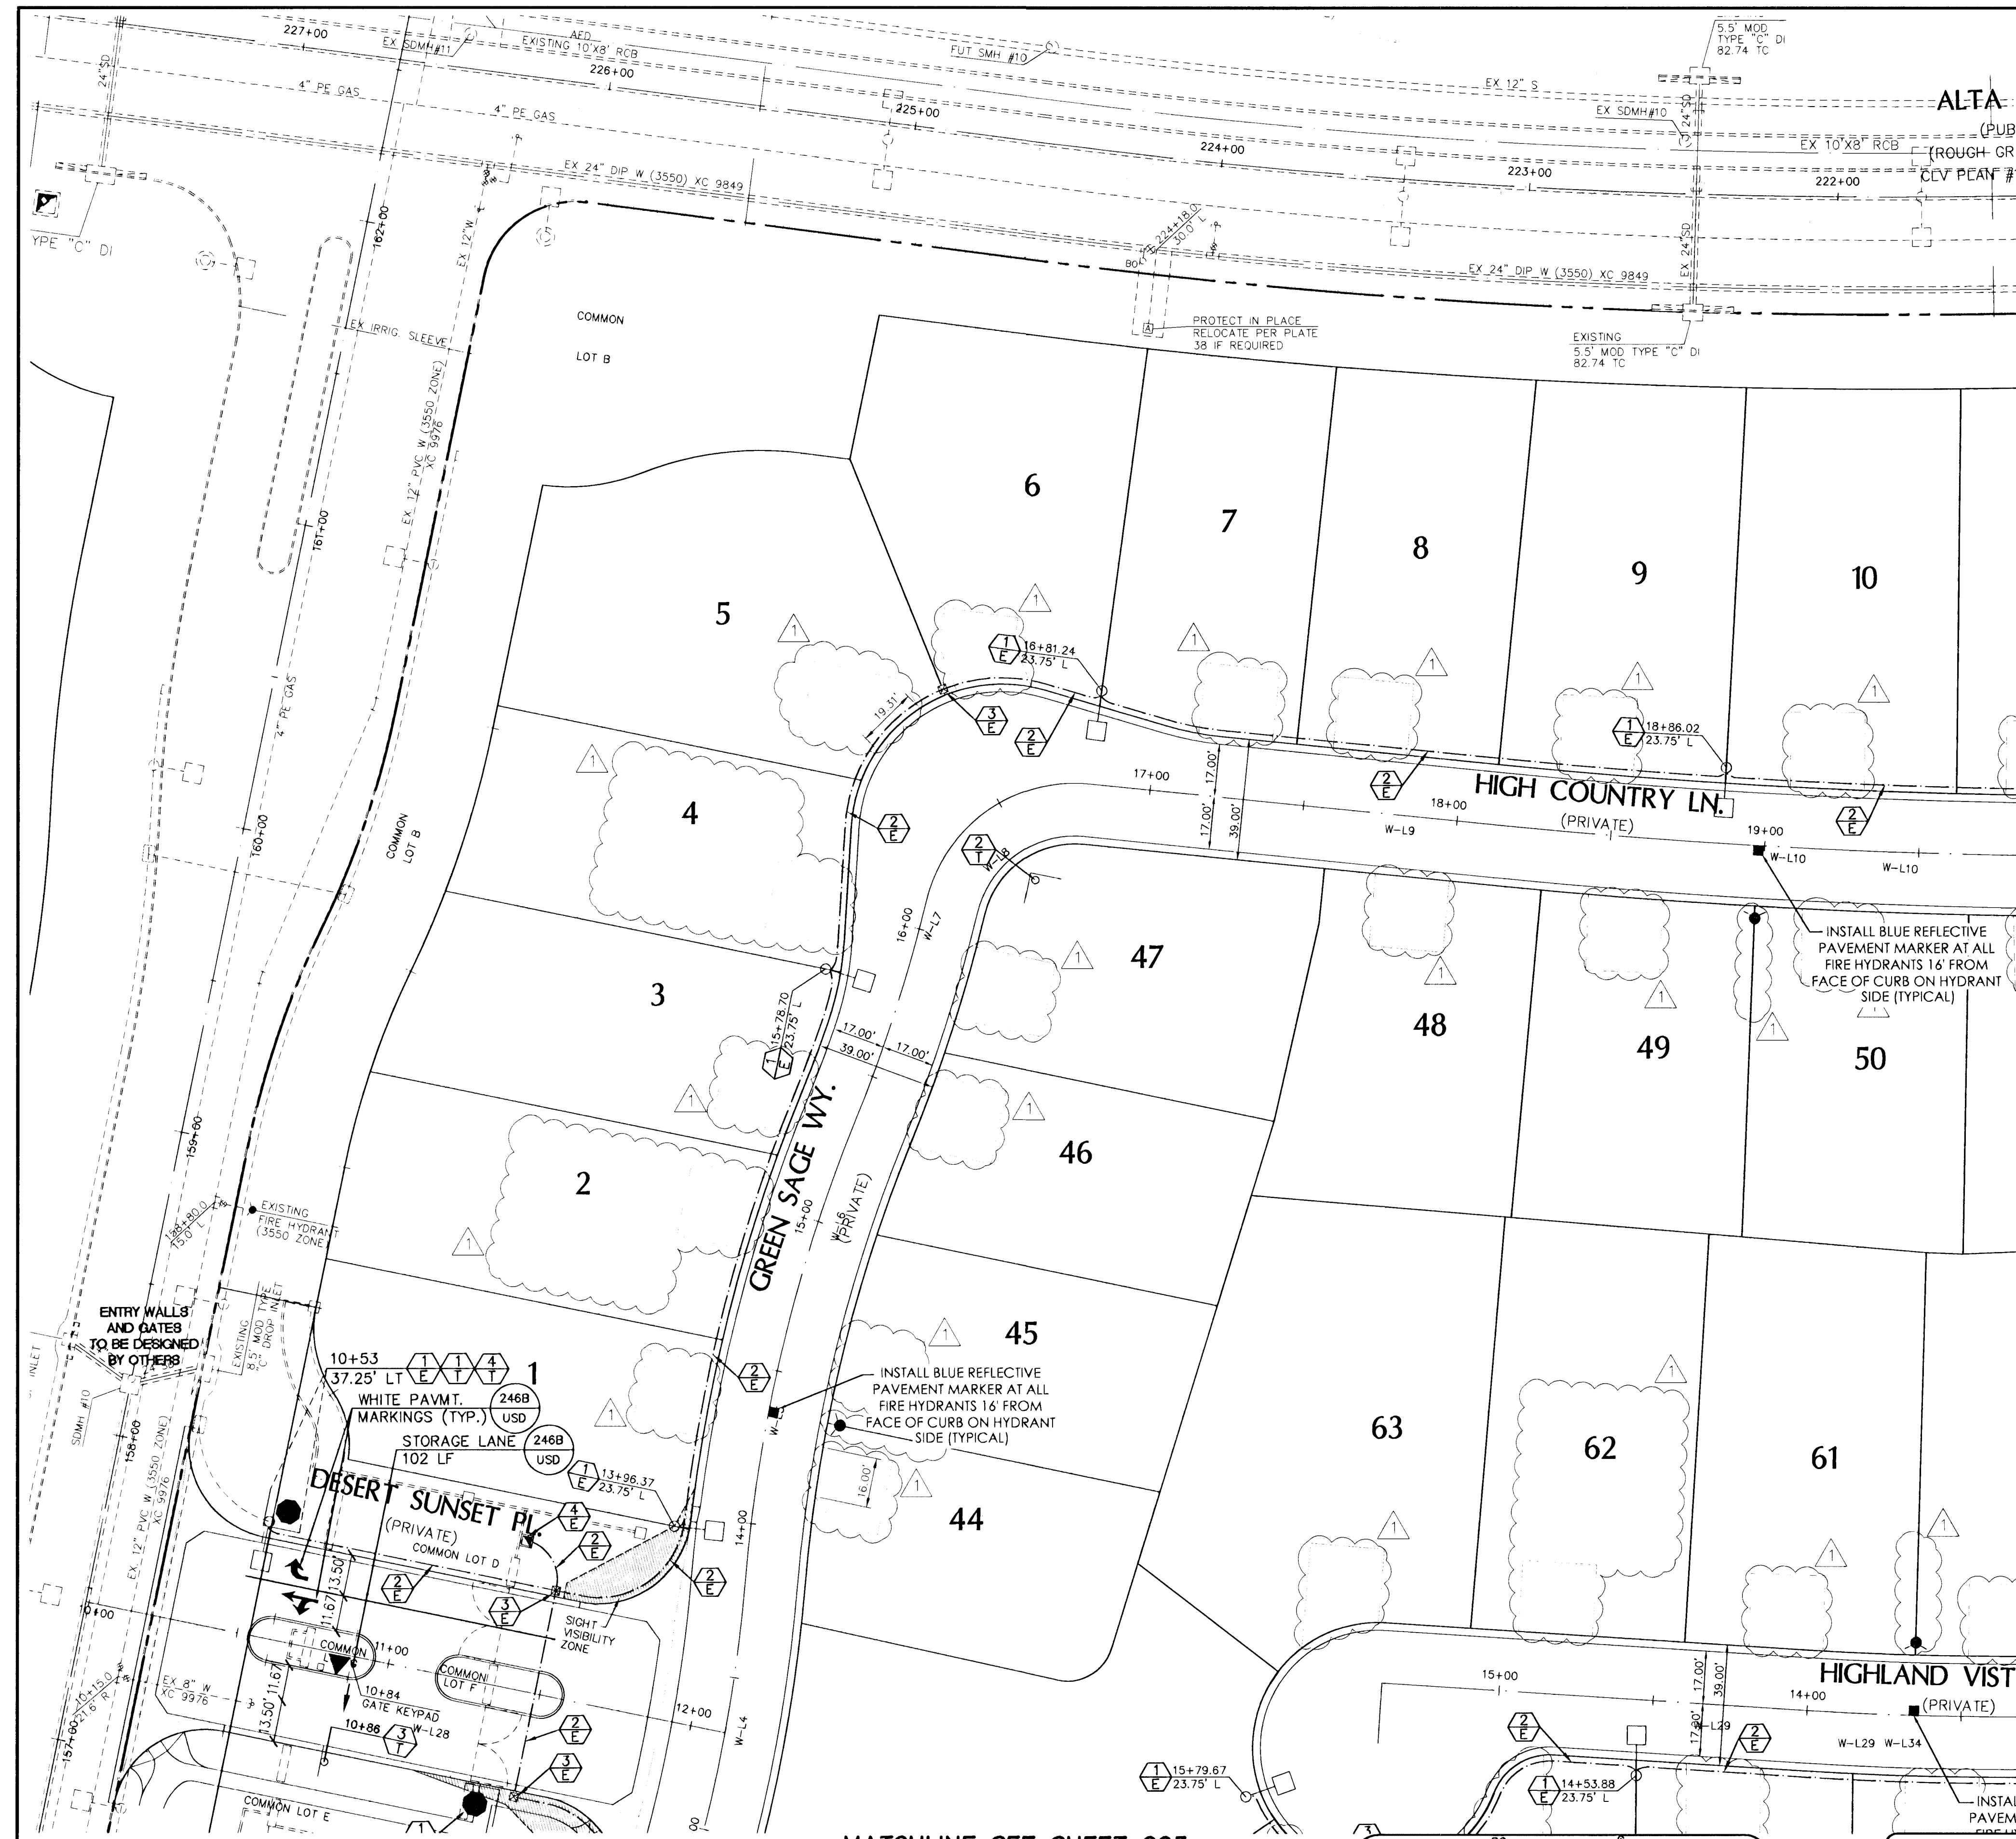

LEGEND

- NEW STREETLIGHT CONDUIT
- EX. STREETLIGHT CONDUIT
- NEW STREETLIGHT SERVICE PESTAL
- EX. STREETLIGHT SERVICE PESTAL
- NEW SINGLE STREETLIGHT
- NEW DOUBLE STREETLIGHT
- EXISTING STREETLIGHT
- FUTURE STREETLIGHT
- NEW PULL BOX
- EXISTING PULL BOX
- SVZ
- SIGHT VISIBILITY ZONE
- STOP
- R1-1 (30")
- R7-1APR (24"x30")
- R2-1 (18"x18")
- 0" LIP DRIVEWAY

METERED SERVICE PESTAL SP1: 125A, 240/120V, 1Ø


NOTE:
THE DESIGN PROFESSIONAL HAS PERFORMED ALL THE REQUIRED VOLTAGE DROP CALCULATIONS FOR ALL BRANCH CIRCUITS AND FEEDERS PER 2005 NATIONAL ELECTRICAL CODE ARTICLE 210.19(A)(1) FPN No. 4.

GENERAL ELECTRICAL NOTES:

- ALL UNDERGROUND CONDUIT SHALL BE TYPE RMC (RIGID NONMETALLIC CONDUIT), SCHEDULE 40 PVC AND SHALL BE INSTALLED PER USD 404.1419 AND 501. ABOVE GRADE CONDUIT SHALL BE TYPE RMC (RIGID METALLIC CONDUIT). CONDUIT RISERS SHALL BE TYPE RMC WITH PVC COATING OR TAPE WRAP. ALL CONDUIT WHICH WOULD OTHERWISE BE EMPTY SHALL INCLUDE A NYLON PULLSTRING AND 1#8 FOR LOCATING PURPOSES.
- ALL CONDUCTORS SHALL BE STRANDED, 600-VOLT, TYPE THW INSULATED COPPER.
- THE ELECTRICAL CONTRACTOR SHALL FURNISH AND INSTALL ALL ELECTRICAL COMPONENTS AND HARDWARE AS REQUIRED BY THE NATIONAL ELECTRICAL CODE, LATEST EDITION AND SHALL COMPLY WITH THE REQUIREMENTS OF THE INSPECTING AUTHORITY HAVING JURISDICTION.

DATE: 7/6/2011
FOR ELECTRICAL COMPONENTS ONLY

SERVICE PESTAL CIRCUIT CAPACITY VERIFICATION	
CIRCUIT NAME:	SP1-1
CIRCUIT TYPE:	STREET LIGHTING (PROPOSED)
VOLTAGE:	240
CIRCUIT CAPACITY:	60
MAXIMUM CONTINUOUS CURRENT DRAW IS 80% OF CIRCUIT CAPACITY:	48
EXISTING CIRCUIT LOAD AMPS =	0
PROPOSED LOAD TO CIRCUIT:	PROPOSED
100 WATT SINGLE LUMINAIRES AT 240V = 0.50 AMPS	QTY. AMPS
150 WATT TWIN LUMINAIRES AT 240V = 0.75 AMPS	21 10.50
250 WATT SINGLE LUMINAIRES AT 240V = 1.25 AMPS	0 0.00
250 WATT TWIN LUMINAIRES AT 240V = 2.50 AMPS	0 0.00
TOTAL PROPOSED LOAD AMPS =	10.50
EXISTING PLUS PROPOSED LOAD AMPS =	10.50
REMAINING AVAILABLE LOAD AMPS: MAXIMUM-EXISTING-PROPOSED=	37.50

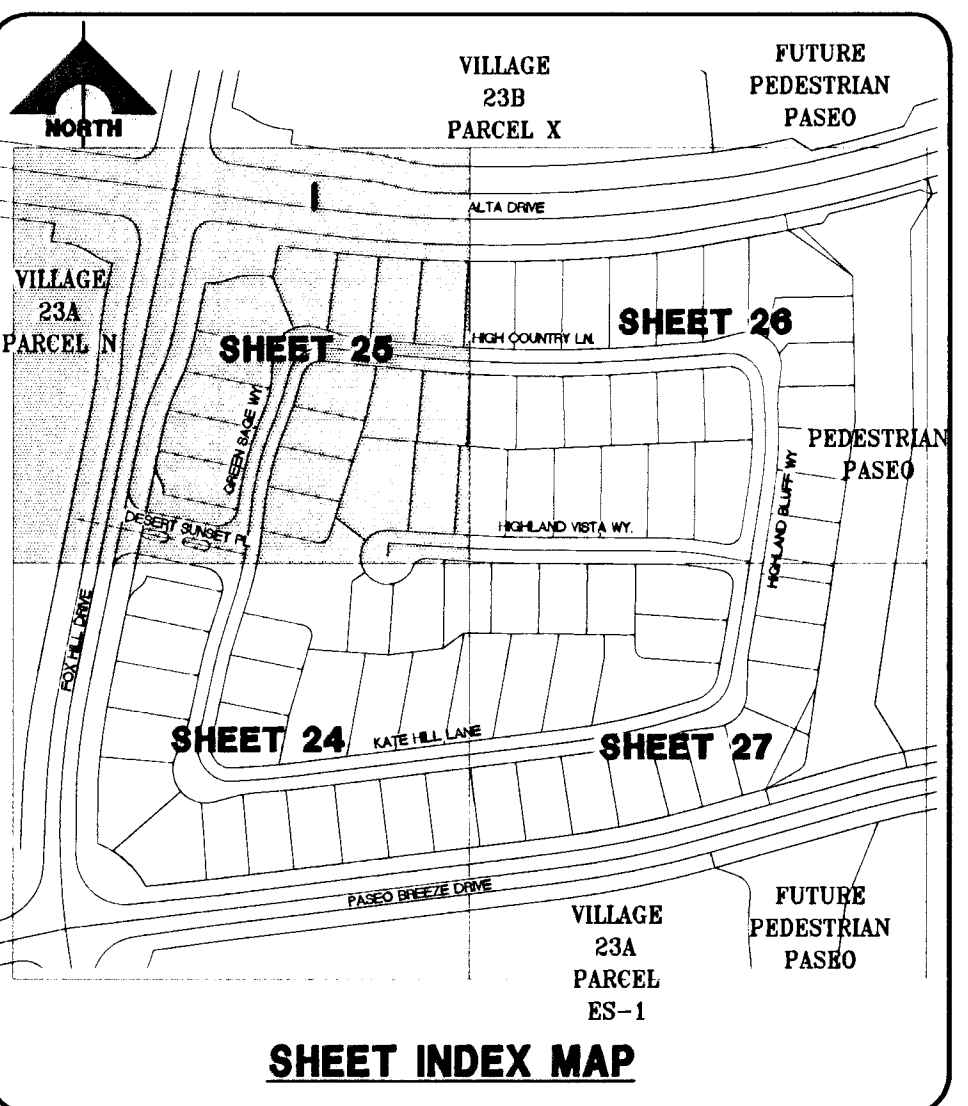

SIGHT ZONE NOTE
NOTHING OVER 24" IN HEIGHT IN SIGHT ZONE EXCEPT TRAFFIC CONTROL DEVICES.


BENCHMARK	
BM #	BENCHMARK
CLV BM No. D368 3	U.S.C. & G.S. BRASS DISC SET IN ROCK ON THE EAST SIDE OF CHARLESTON BOULEVARD AND SOUTH OF THE RED ROCK DETENTION BASIN.
NAVD 88 DATUM	3246.71 (FEET)
NAVD 88 DATUM	989.599 (METERS)

BASIS OF BEARINGS
NORTH 05° 59' 55" WEST BEING THE BEARING OF THE WEST LINE OF SECTION 34, T 20 S, R 59 E, M.D.M., CITY OF LAS VEGAS, CLARK COUNTY, NEVADA, AS SHOWN BY MAP THEREOF ON FILE IN FILE 91, PAGE 28 OF PARCEL MAPS IN THE CLARK COUNTY RECORDERS OFFICE, CLARK COUNTY, NEVADA.

LEGAL DESCRIPTION
LOT 7, 8, & COMMON LOT "G" OF BLOCK B OF "SUMMERLIN VILLAGE 23A UNIT NO. 2" ON FILE IN BOOK 121, PAGE 12 OF PLATS IN THE COUNTY RECORDER'S OFFICE, CLARK COUNTY, NEVADA LYING WITHIN SECTION 34, TOWNSHIP 20 SOUTH, RANGE 59 EAST, M.D.M., CITY OF LAS VEGAS, CLARK COUNTY, NEVADA.

- STREETLIGHT CONSTRUCTION NOTES**
- SUMMERLIN TYPE 3B STREETLIGHT PER SSD E-1
 - PROPOSED 1-1/4" CONDUIT CONTAINING 2#4, 1#8 GND
 - PROPOSED NO. 3-1/2" PULLBOX PER USD 326
 - SERVICE PESTAL SP1. REFER TO ELECTRICAL SERVICE NOTES
 - 1-1/4" CONDUIT ONLY

- TRAFFIC CONSTRUCTION NOTES**
- INSTALL 2-9" STREET NAME SIGNS (D3) PER USD 250 AND 30" STOP SIGN (R1-1)
 - INSTALL 2-9" STREET NAME SIGNS (D3) PER USD 250
 - INSTALL 25 MPH SPEED LIMIT SIGN (R2-1)
 - SERVICE PESTAL SP-1. REFER TO ELECTRICAL SERVICE NOTES

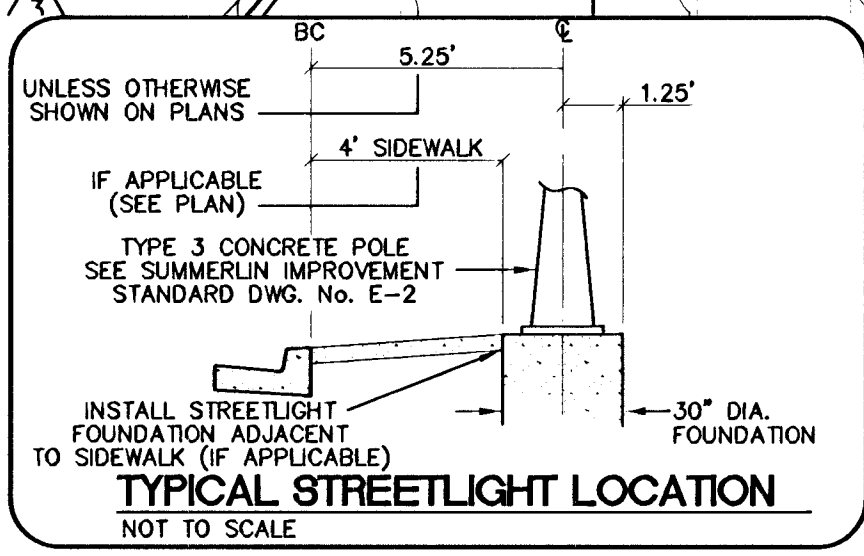

Call before you Dig
Underground
1-702-456-7611
1-702-229-6611

Call before you Dig
Overhead
1-702-227-2929

Call before you Dig
Call 811
1-800-227-2600
1-702-455-7544

PROJECT NO. 62023-980

DESIGN: G.C. WALLACE COMPANIES

DRAWN: ENGINEERS | PLANNERS | SURVEYORS

CHECK: 1555 S. RAINBOW BOULEVARD, LAS VEGAS, NV 89146

DATE: 7/6/2011

FOR ELECTRICAL COMPONENTS ONLY

THE HOWARD HUGHES COMPANY, LLC

SUMMERLIN VILLAGE 23A PARCEL L

ANDALUSIA

STREETLIGHT AND TRAFFIC CONTROL PLAN II

DRAWING C25

25 OF 31 SHTS