



123023
126781


CLV 10/10/2023

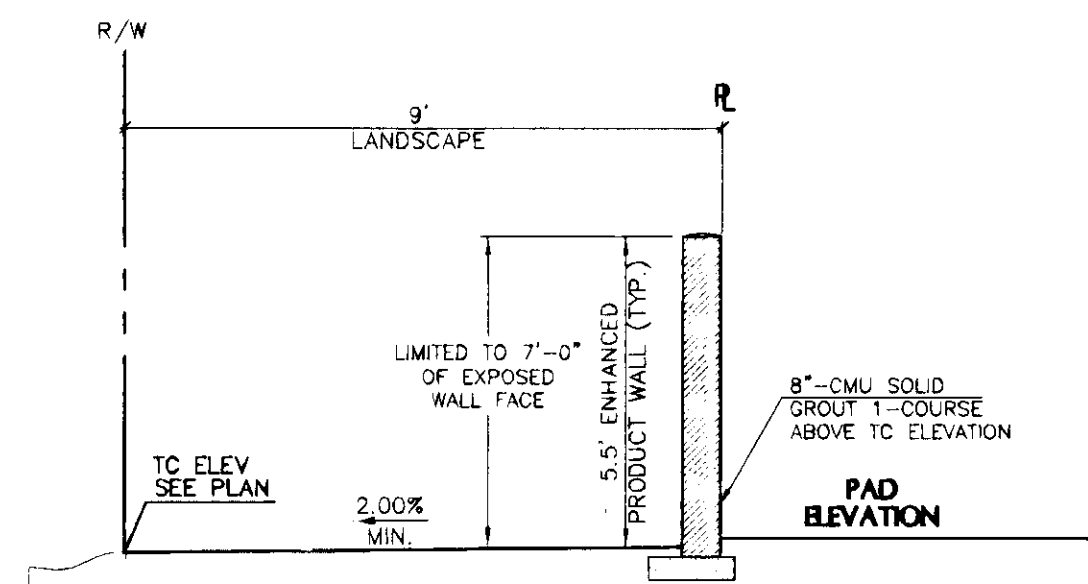


TYPICAL CORNER LOT GRADING (L)
NOT TO SCALE

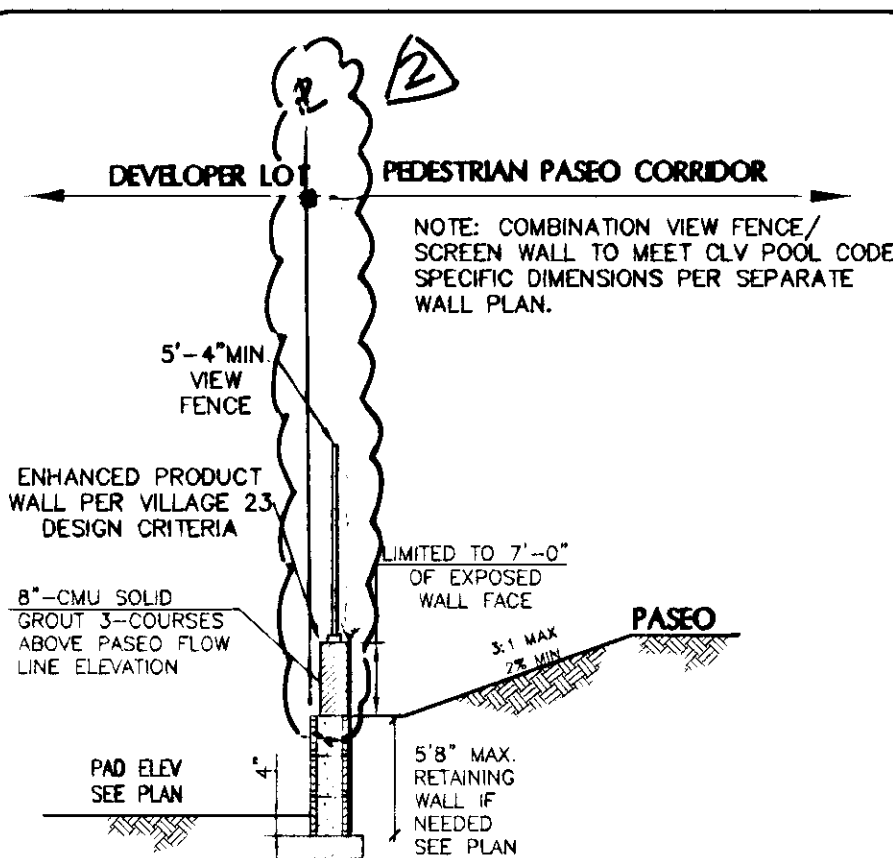


FUTURE PEDESTRIAN PASEO VILLAGE WALL DETAIL (M)
NOT TO SCALE

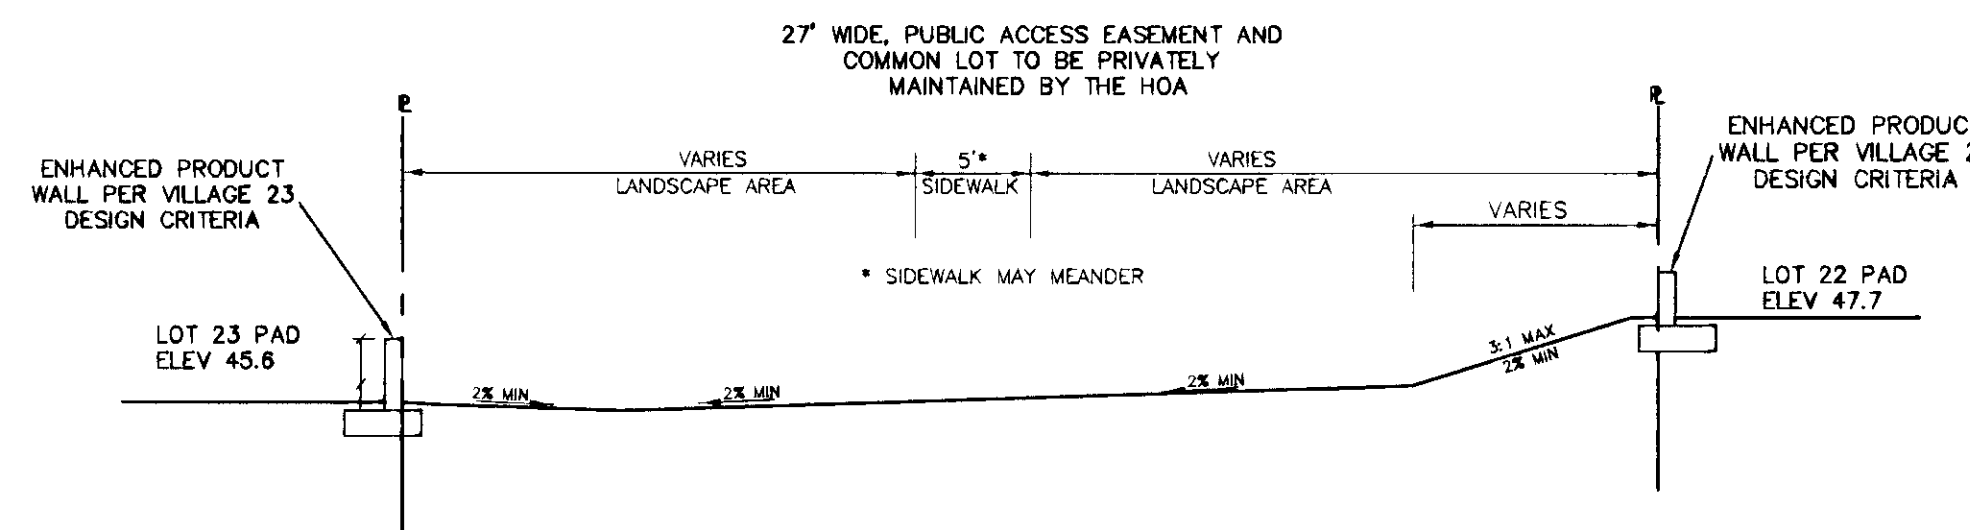


PUBLIC ACCESS EASEMENT (I)
NOT TO SCALE

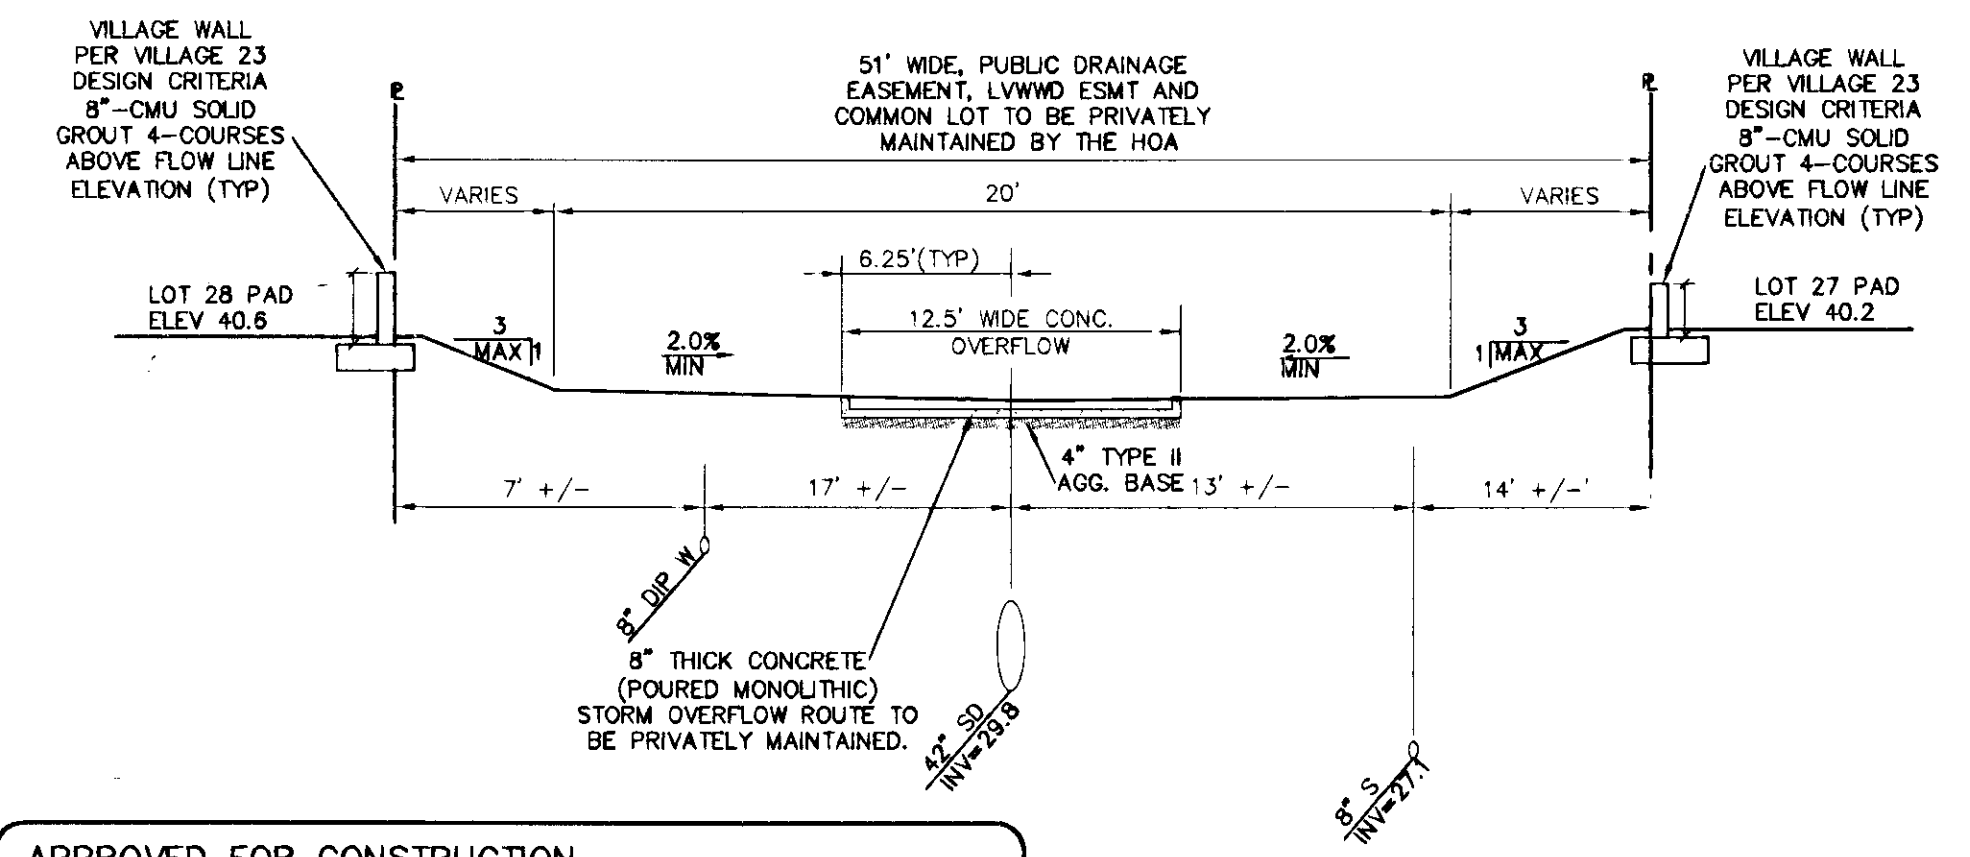


LVVWD & DRAINAGE EASEMENT (J)
NOT TO SCALE

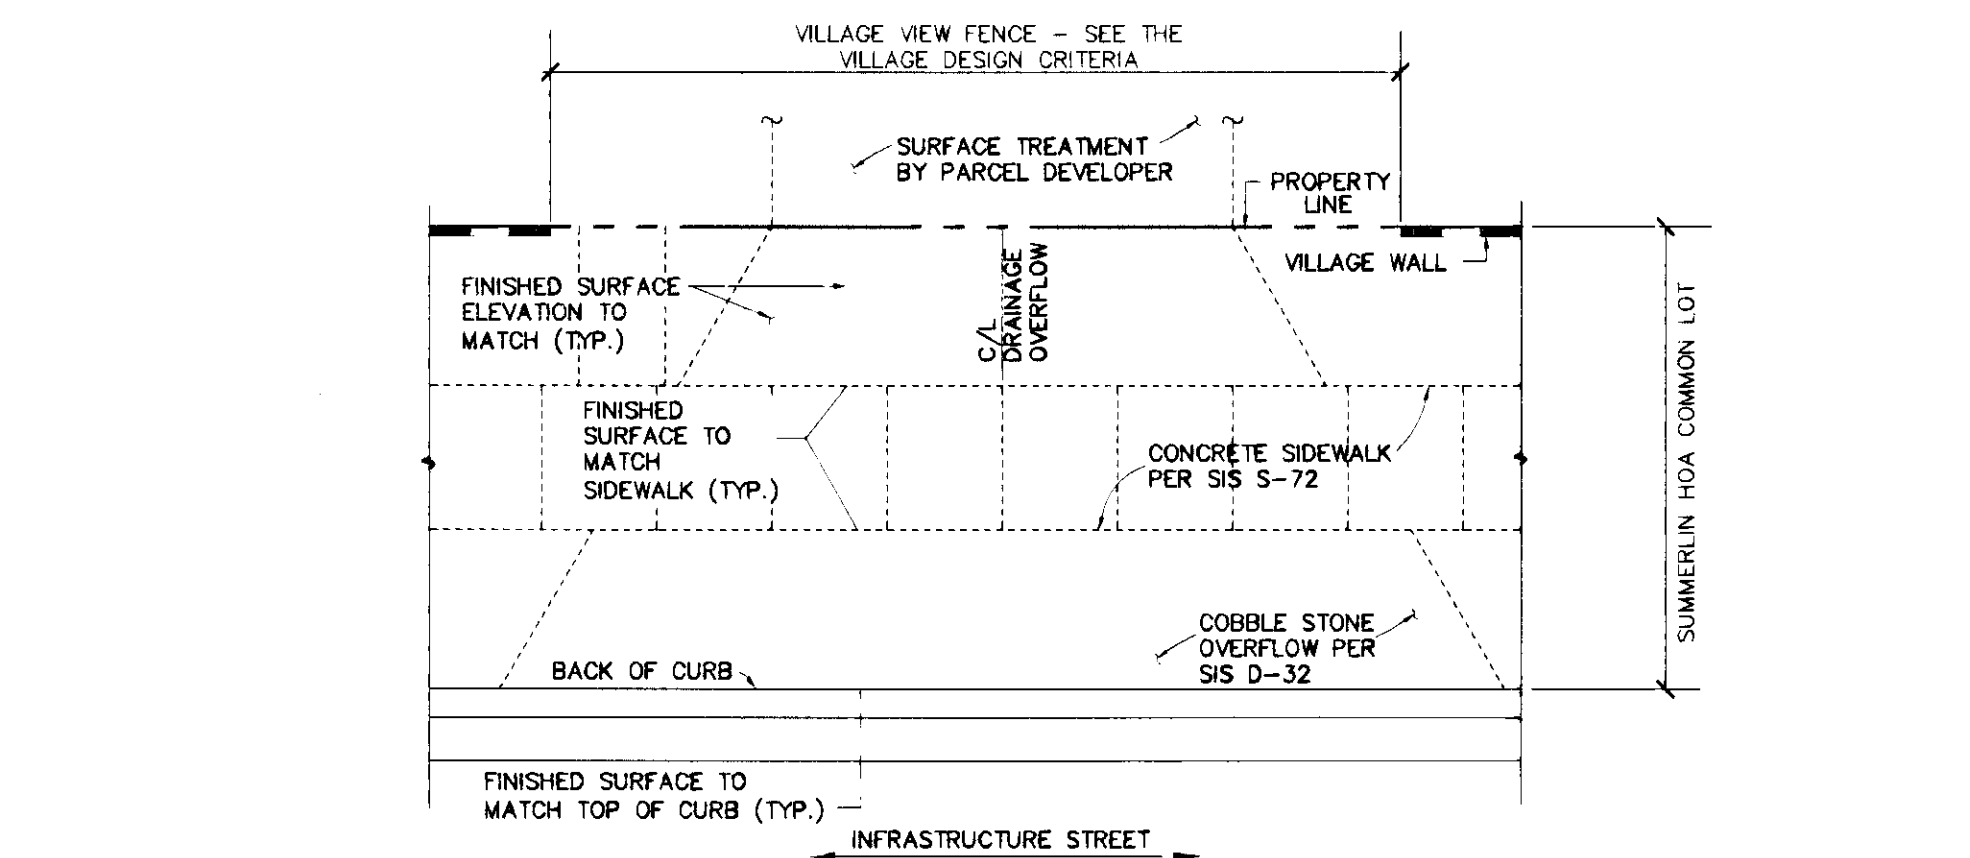


STORM WATER OVERFLOW DETAIL (K)
NOT TO SCALE

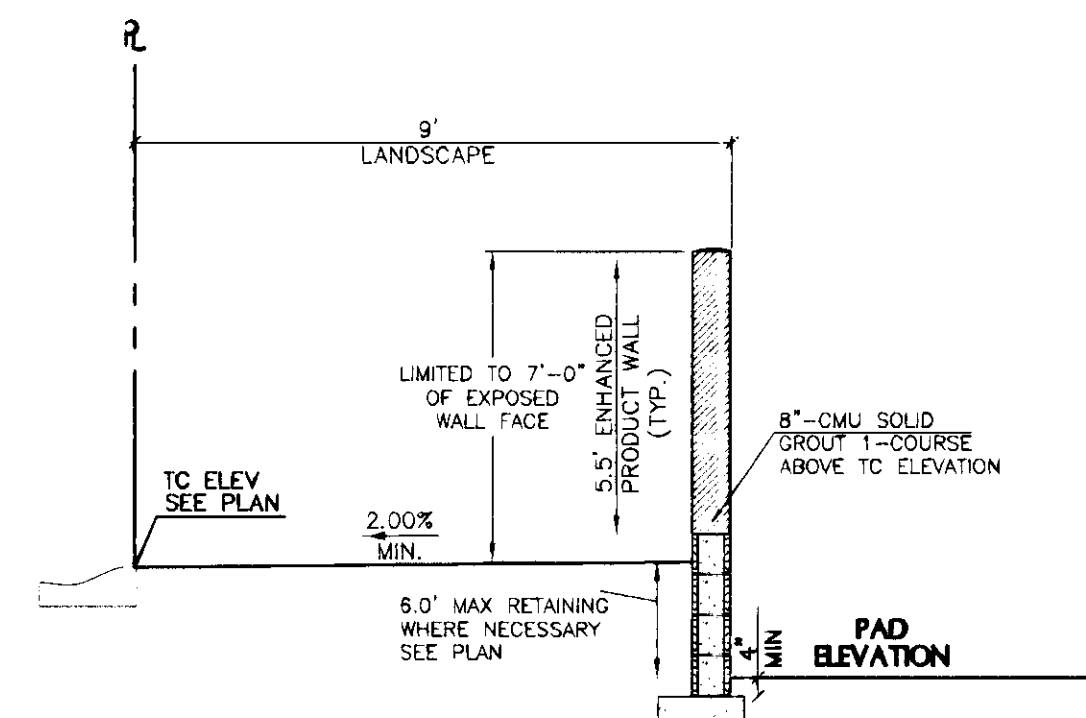


TYPICAL CORNER LOT GRADING with RETAINING WALL (H)
NOT TO SCALE

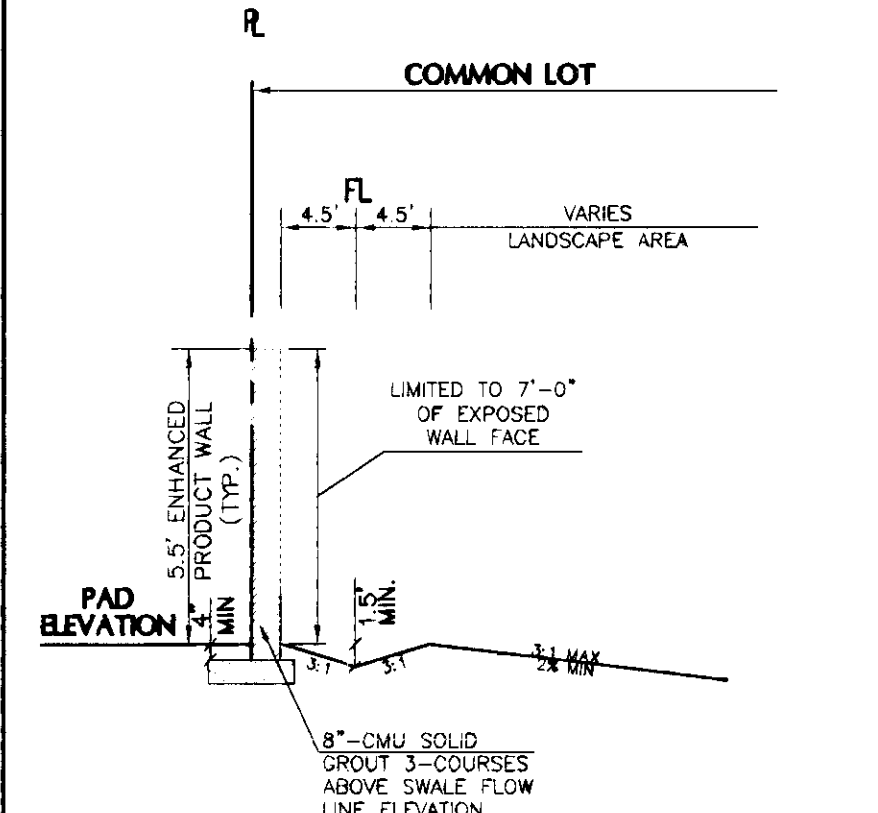


DETAIL (G)
NOT TO SCALE

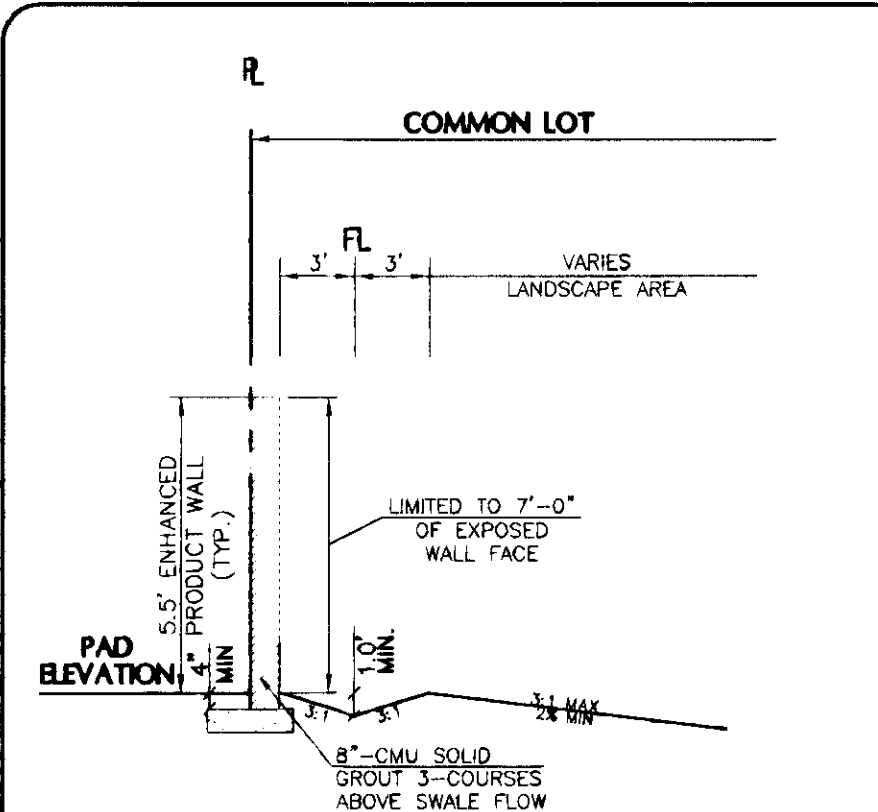


DETAIL (F)
NOT TO SCALE

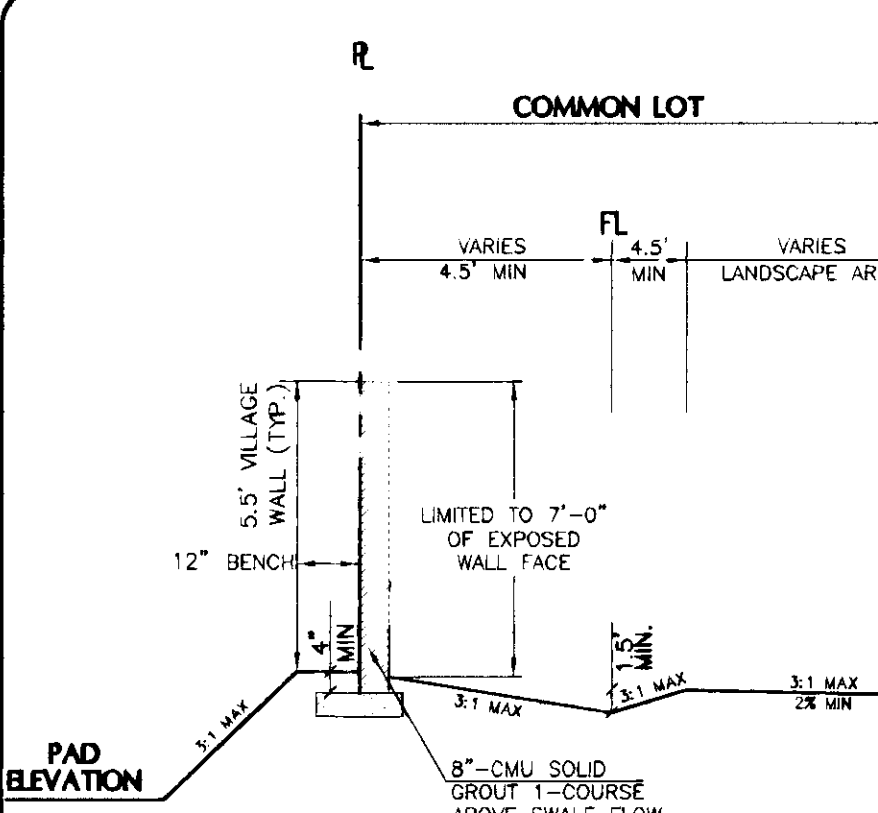


DETAIL (E)
NOT TO SCALE

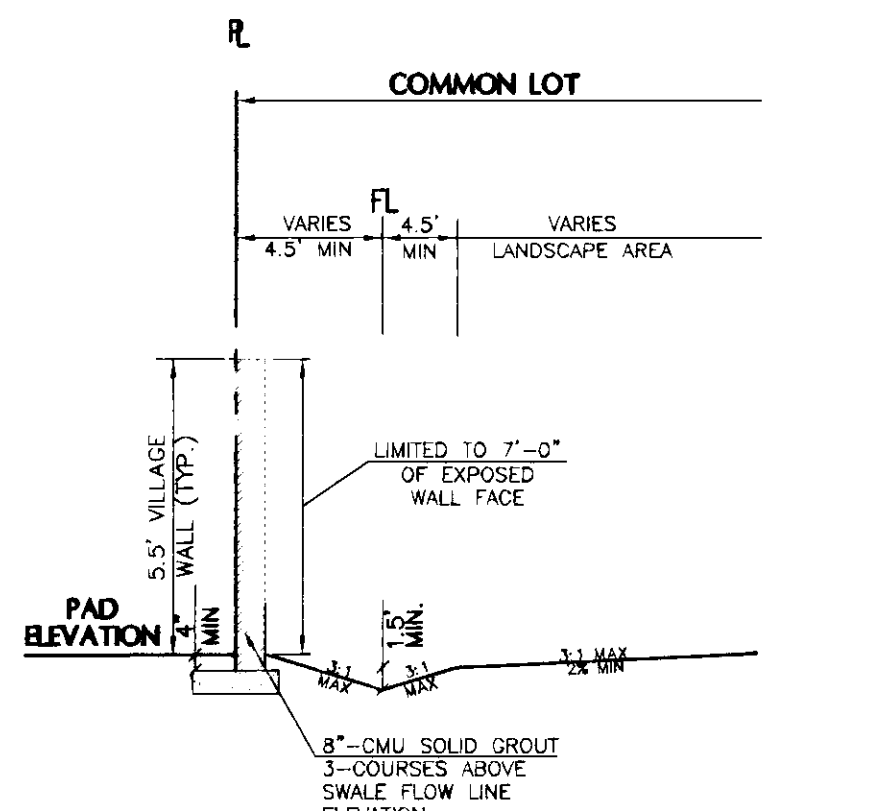



DETAIL (D)
NOT TO SCALE

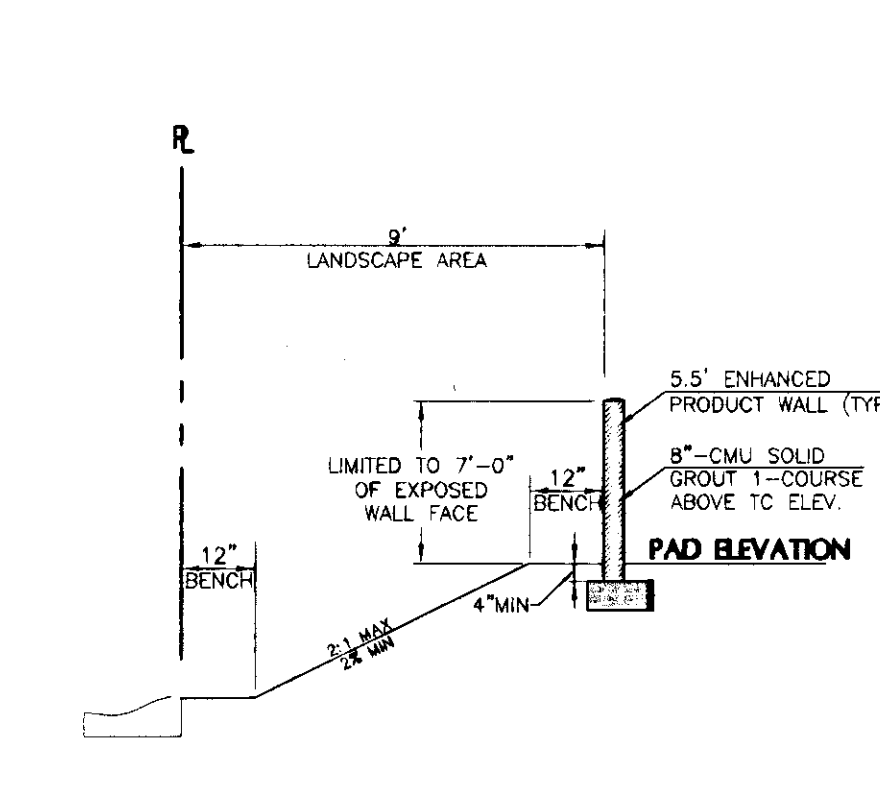

CORNER LOT DETAIL (B)
NOT TO SCALE

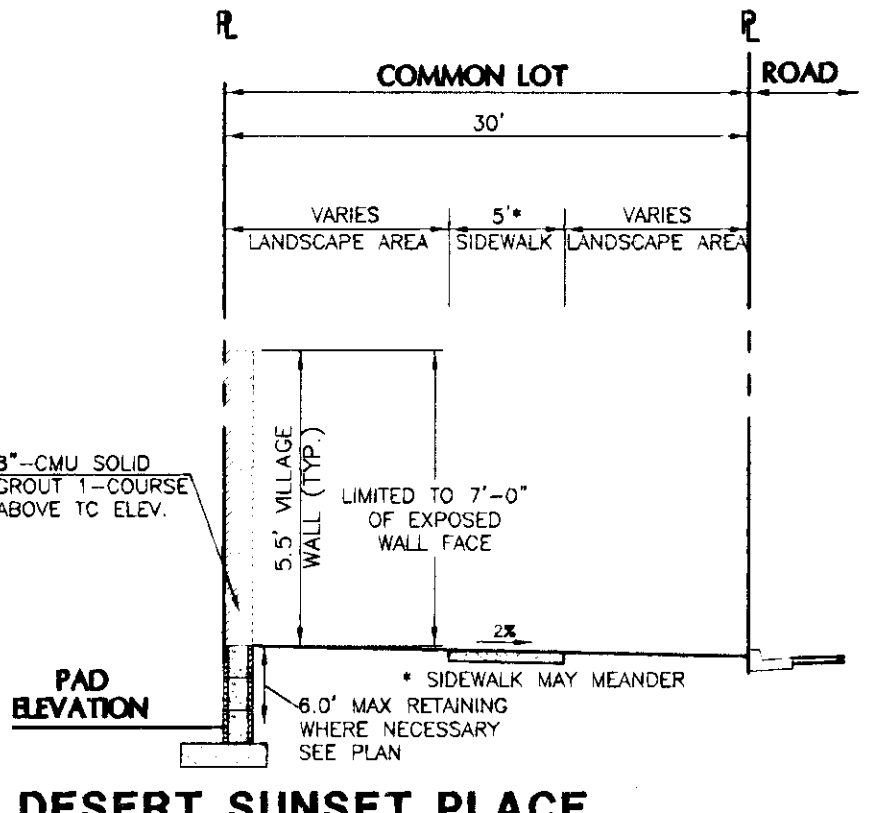

DESERT SUNSET PLACE WALL DETAIL (A)
NOT TO SCALE

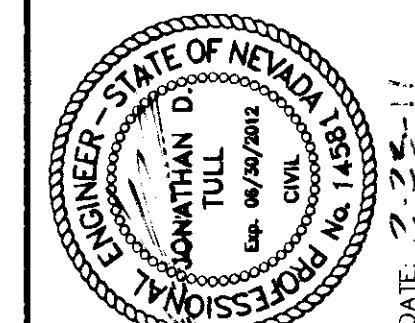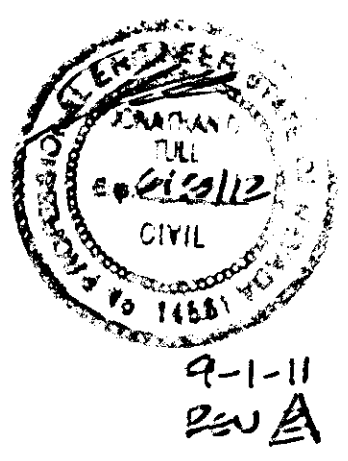

PROJECT NO.	62023-980
DESIGN	DRAWN
CHECK	9-1-11
DATE	9-1-11
REVISION	2/1/11
DESCRIPTION	Revised Wall Location


