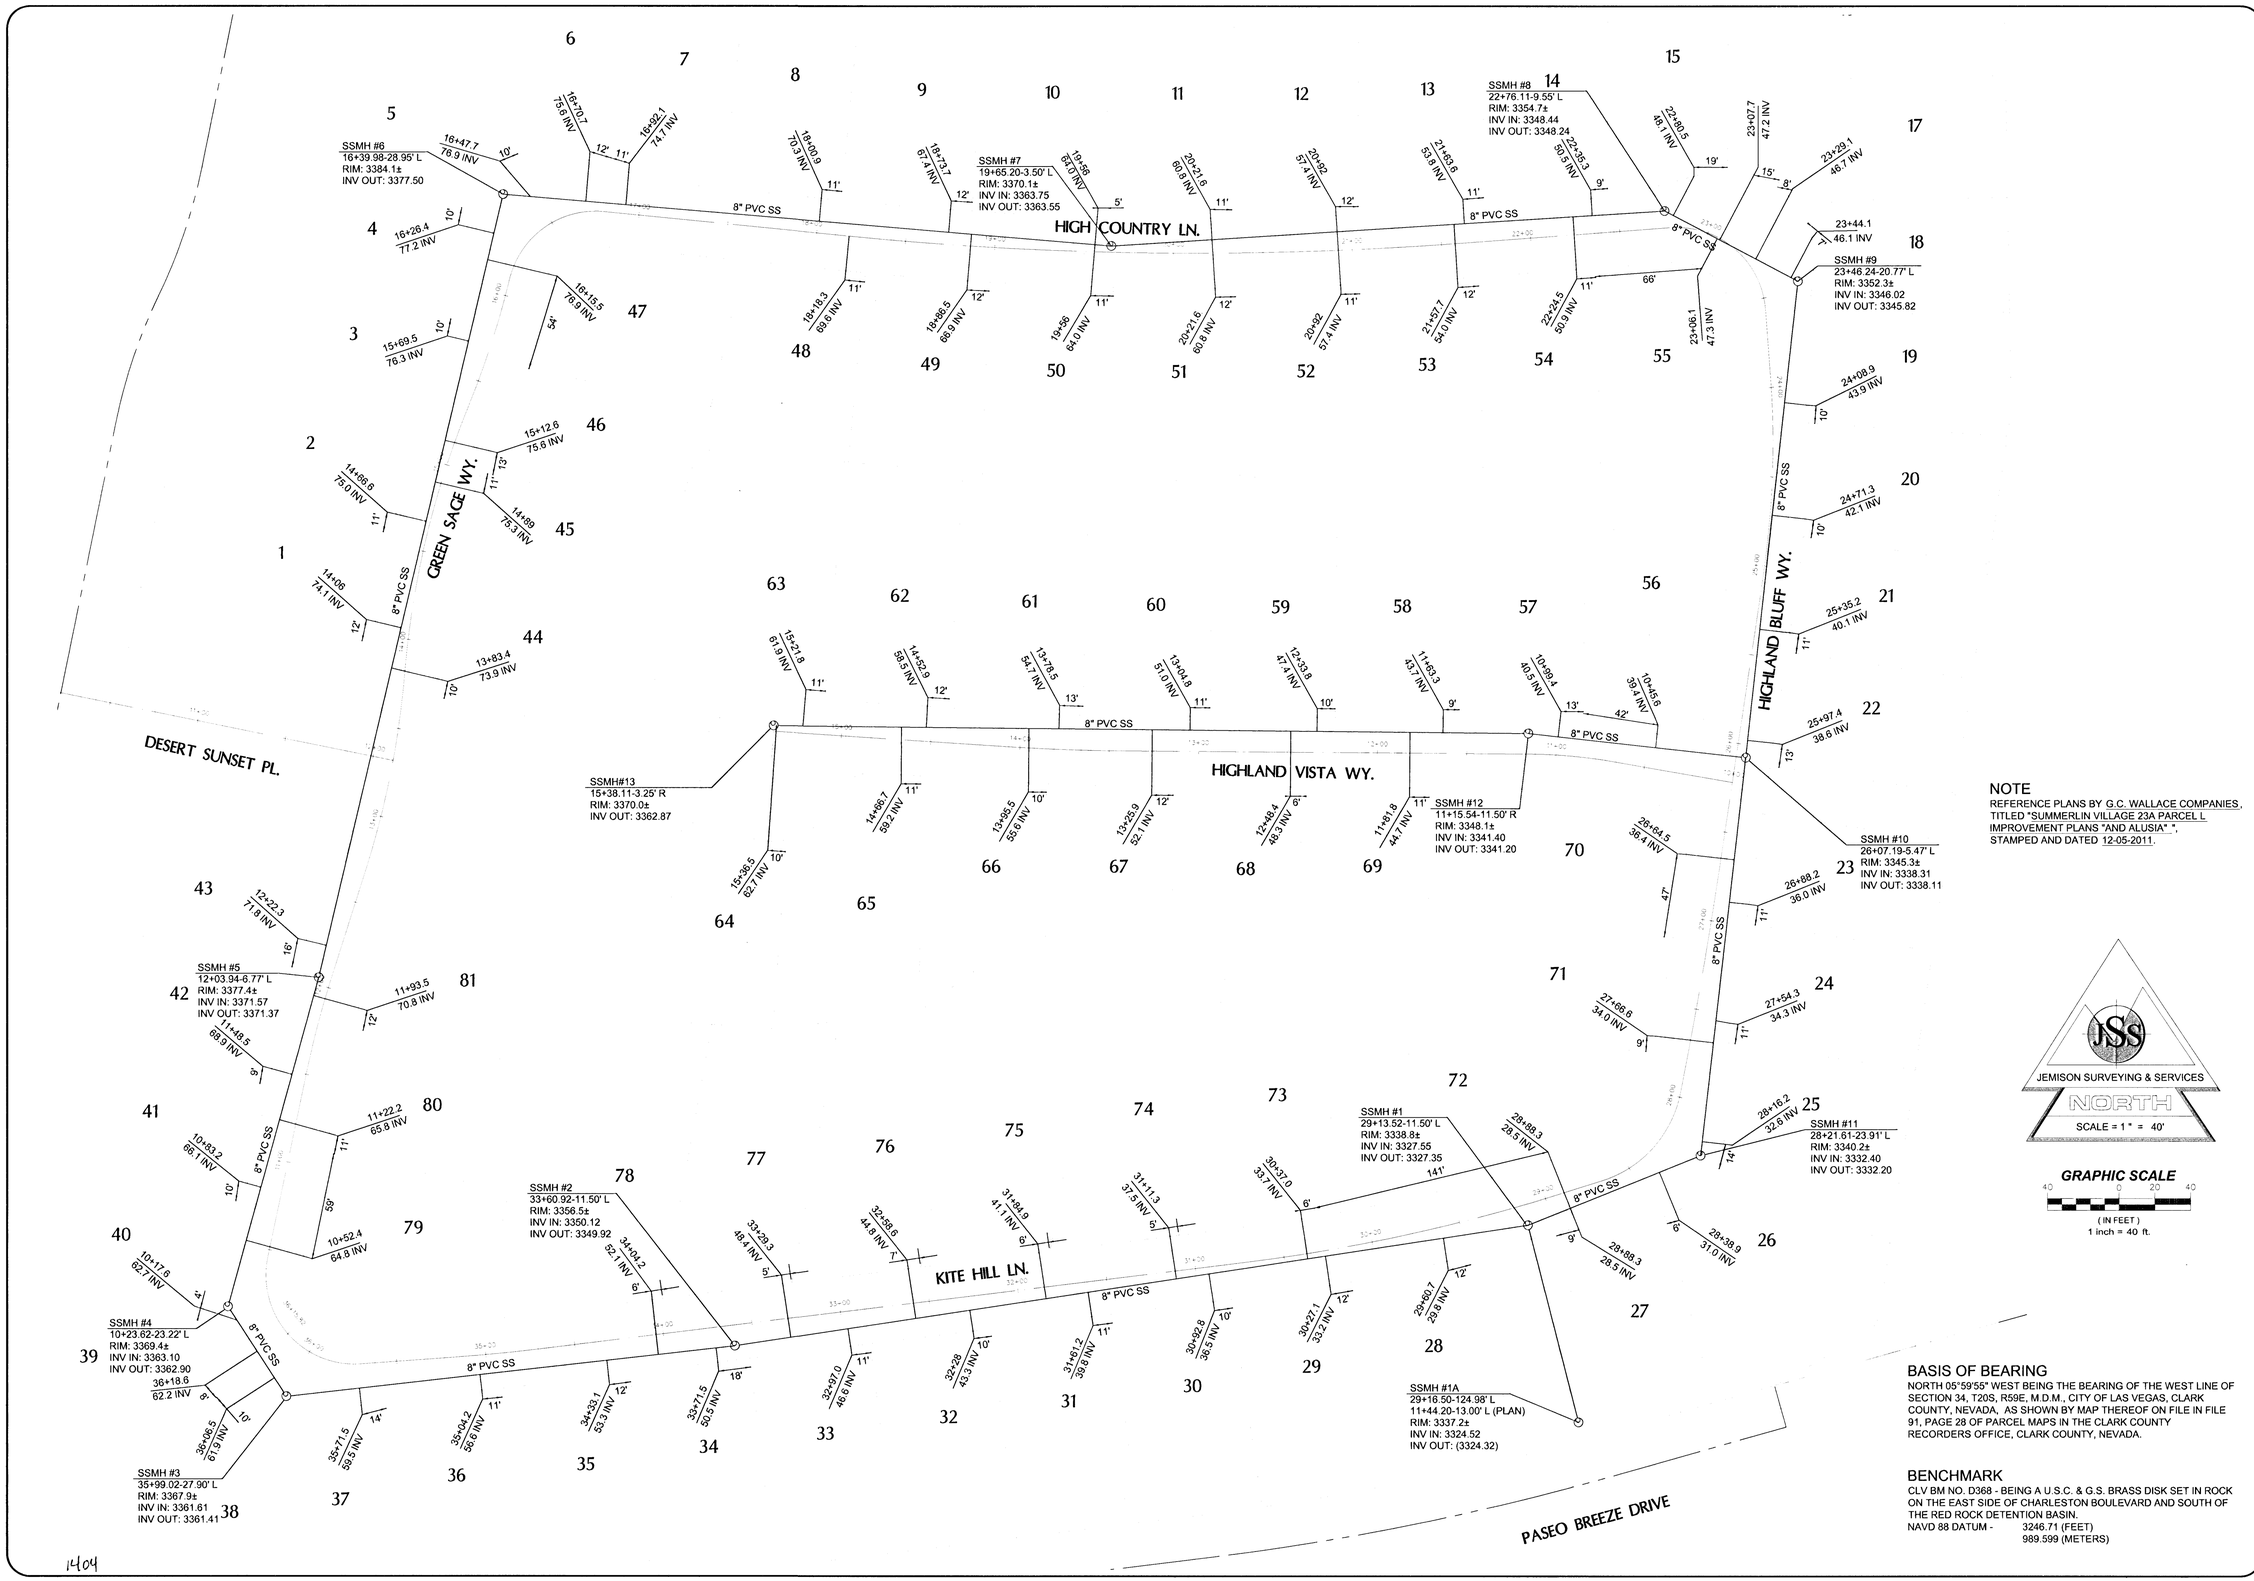

NOTE

REFERENCE PLANS BY G.C. WALLACE COMPANIES, TITLED "SUMMERLIN VILLAGE 23A PARCEL L IMPROVEMENT PLANS "AND ALUSIA" ", STAMPED AND DATED 12-05-2011.

BASIS OF BEARING

NORTH 05°59'55" WEST BEING THE BEARING OF THE WEST LINE OF SECTION 34, T20S, R59E, M.D.M., CITY OF LAS VEGAS, CLARK COUNTY, NEVADA, AS SHOWN BY MAP THEREOF ON FILE IN FILE 91, PAGE 28 OF PARCEL MAPS IN THE CLARK COUNTY RECORDERS OFFICE, CLARK COUNTY, NEVADA.

BENCHMARK

CLV BM NO. D368 - BEING A U.S.C. & G.S. BRASS DISK SET IN ROCK ON THE EAST SIDE OF CHARLESTON BOULEVARD AND SOUTH OF THE RED ROCK DETENTION BASIN.
NAVD 88 DATUM - 3246.71 (FEET)
989.599 (METERS)

NO.	REVISIONS	DATE

SCALE (H): 1" = 40'
SCALE (V):
DRAWN BY: RPS
CHECKED BY:
SEC. 34 , T. 20 S., R. 59 E.

PROFESSIONAL SURVEYOR
RAYMOND R. JEMISON
EXP. 6-30-13
No. 10598
STATE OF NEVADA
DATE: 05-31-2012

JEMISON SURVEYING & SERVICES
2690 CRIMSON CANYON DRIVE
LAS VEGAS, NEVADA, 89128
702-360-4838 f. 702-360-4839
JEMISON SURVEYING & SERVICES

JOB TITLE
VILLAGE 23A - PARCEL "L"
UTILITY EXHIBIT
CLARK COUNTY NEVADA

DATE 05-31-2012
JOB NO. 07Y4975
SHEET 1 OF 2

1404

AS-BUILTS