

Call before you Dig

AVOID CUTTING UNDERGROUND UTILITY LINES. IT'S COSTLY
1-800-227-2600
UNDERGROUND SERVICE (USA)

FUTURE IMPROVEMENTS BY OTHERS




*FUTURE IMPROVEMENTS BY OTHERS

LONE MOUNTAIN ROAD

UTILITY NOTE

UTILITY LOCATIONS SHOWN HEREON ARE APPROXIMATE ONLY. IT SHALL BE THE CONTRACTOR'S RESPONSIBILITY TO DETERMINE THE EXACT VERTICAL AND HORIZONTAL LOCATION OF ALL EXISTING UNDERGROUND UTILITIES PRIOR TO COMMENCING CONSTRUCTION. NO REPRESENTATION IS MADE THAT ALL EXISTING UTILITIES ARE SHOWN HEREON. THE ENGINEER ASSUMES NO RESPONSIBILITY FOR UTILITIES NOT SHOWN OR UTILITIES NOT SHOWN IN THEIR PROPER LOCATION.


CALL BEFORE YOU DIG 1-800-227-2600

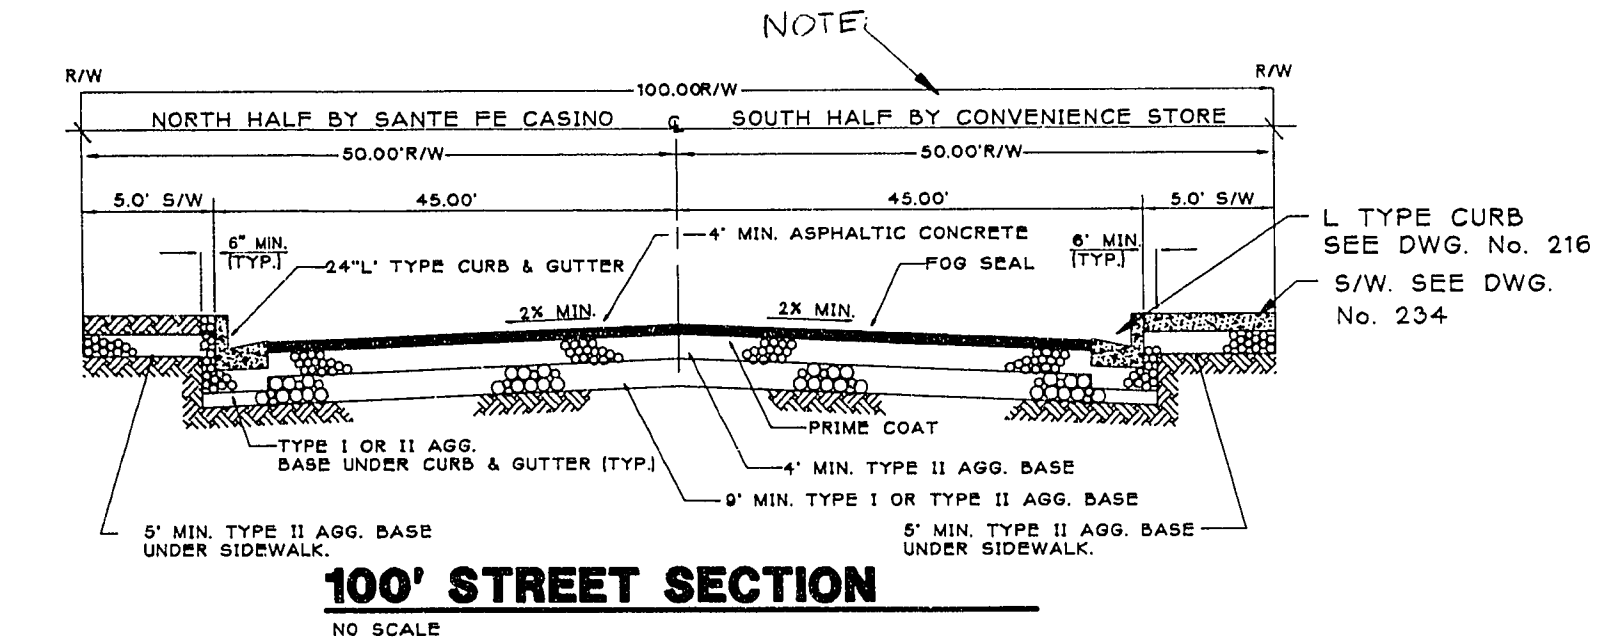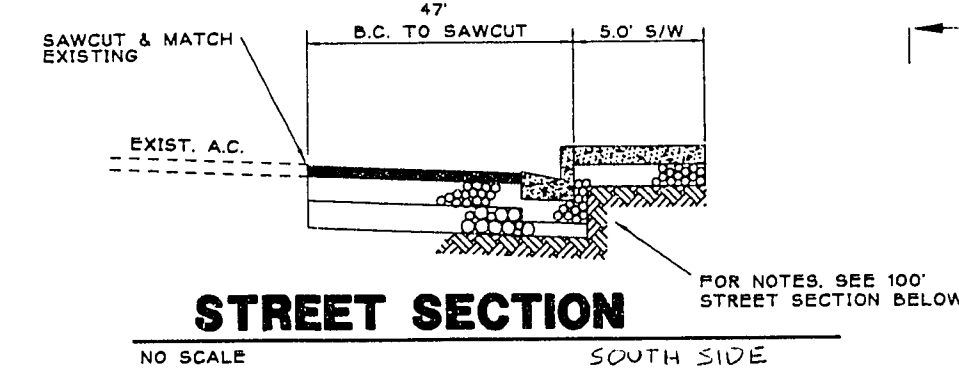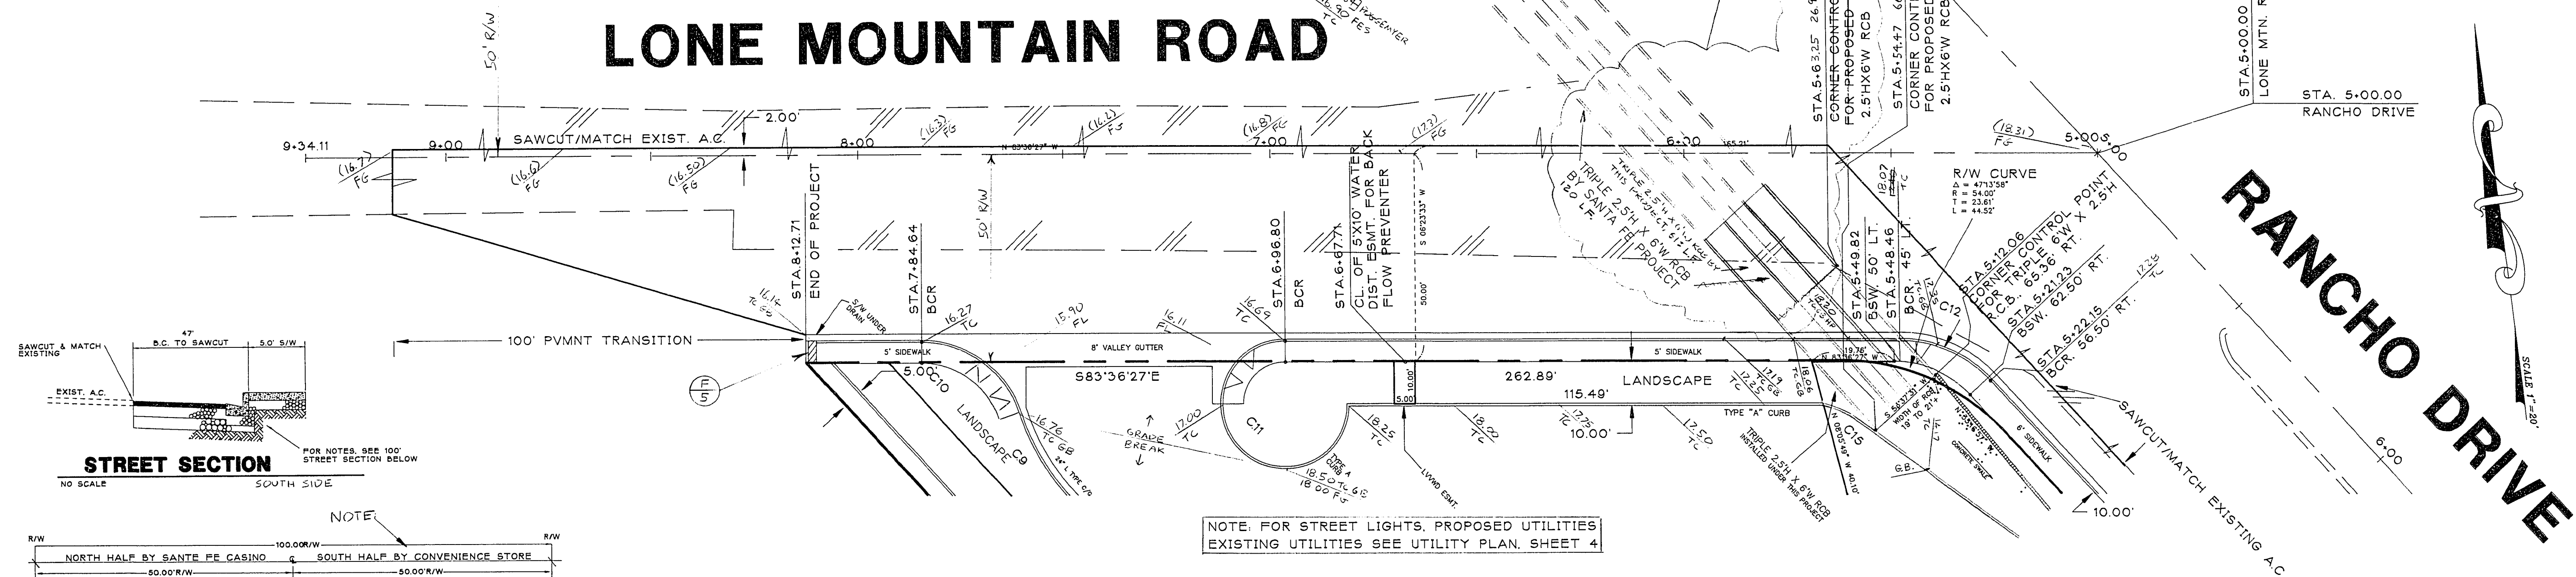

NOTE: FOR STREET LIGHTS, PROPOSED UTILITIES EXISTING UTILITIES SEE UTILITY PLAN, SHEET 4

LONE MOUNTAIN ROAD

SCALE: HORIZ. 1"=20'
VERT. 1"=3'

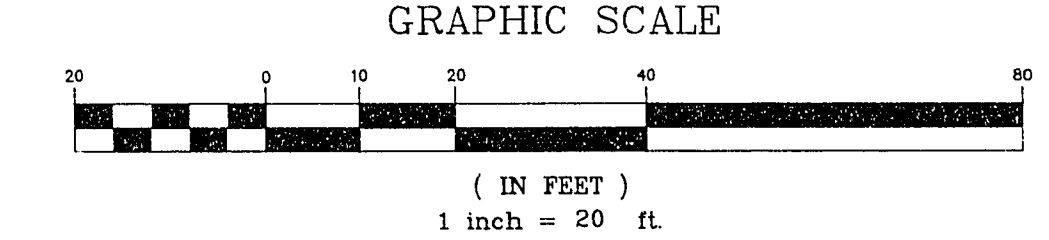


9+00

8+00

7+00

6+00

5+00

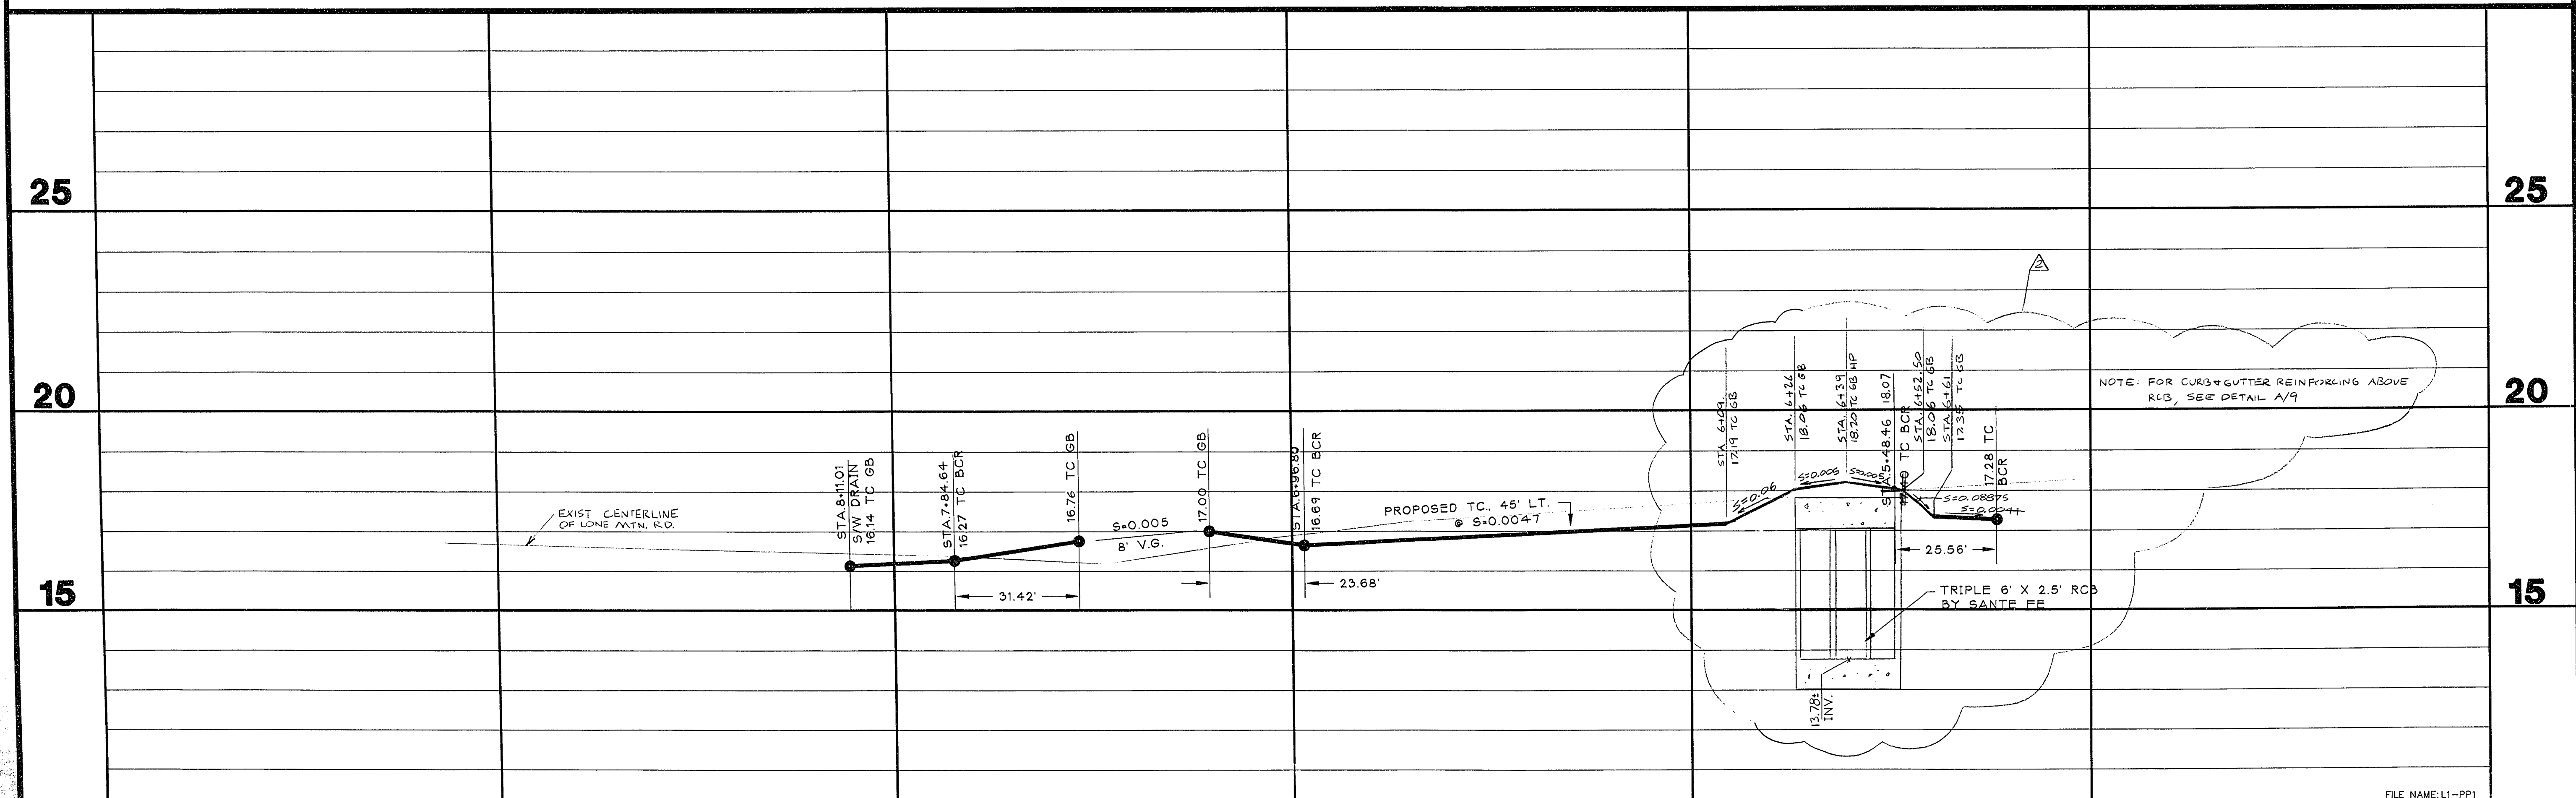

NOTE: FOR CURB & GUTTER REINFORCING ABOVE RCB, SEE DETAIL A/9

TRIPLE 6" X 2.5' RCB BY SANTE FE

FILE NAME: L1-PP1

REVISIONS

No.	Date	Description	By	Approval
1	11/19/12	EXTEND EXISTING 24" L	B.K.B.	11/19/12
2	11/19/12	CHANGE TC 3 AT 50' X 24" CURB & GUTTER	B.K.B.	11/19/12

PREPARED FOR:

KALB

LONE MTN. RD & RANCHO DR. CONVENIENCE STORE

LONE MTN RD. PLAN & PROFILE

SHEET

7

OF

9

107-V2268