



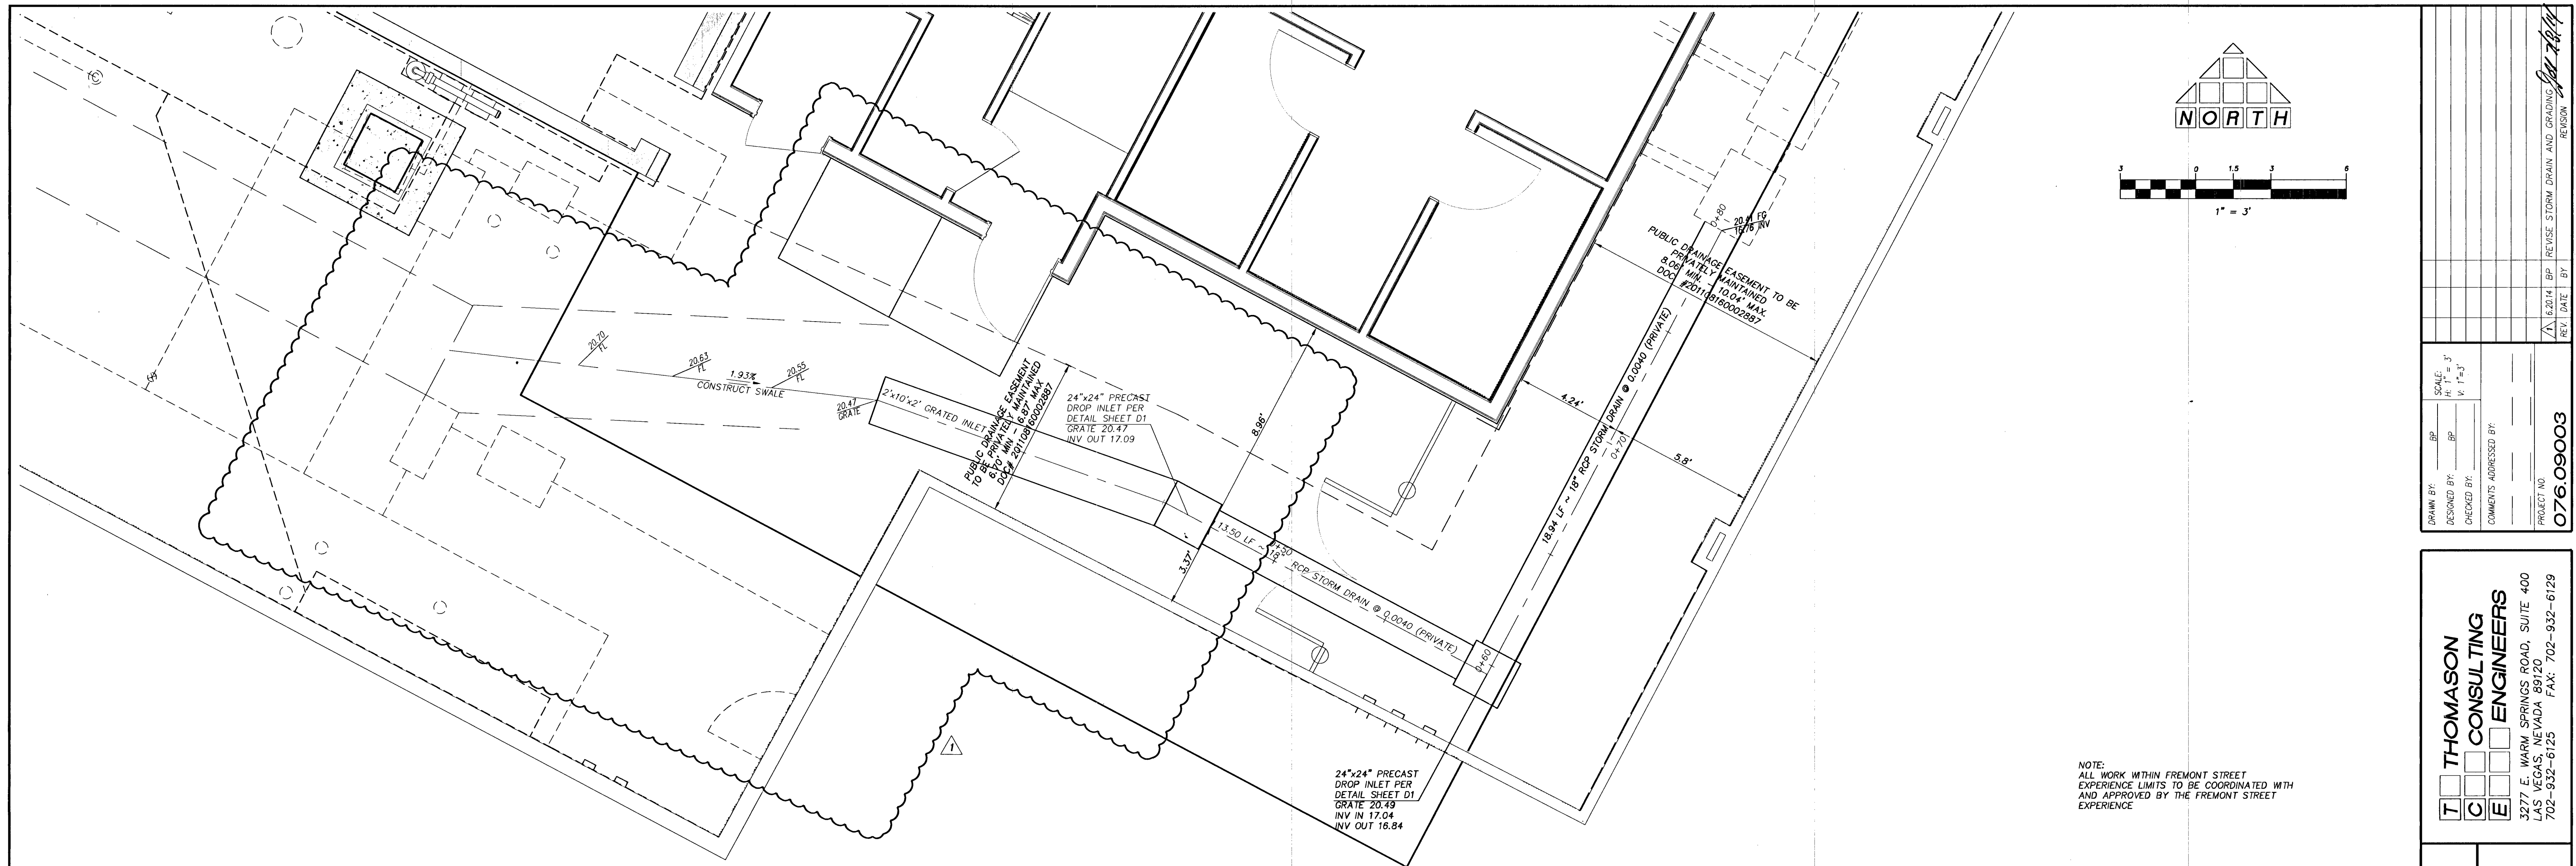

NOTE:
ALL WORK WITHIN FREMONT STREET
EXPERIENCE LIMITS TO BE COORDINATED WITH
AND APPROVED BY THE FREMONT STREET
EXPERIENCE

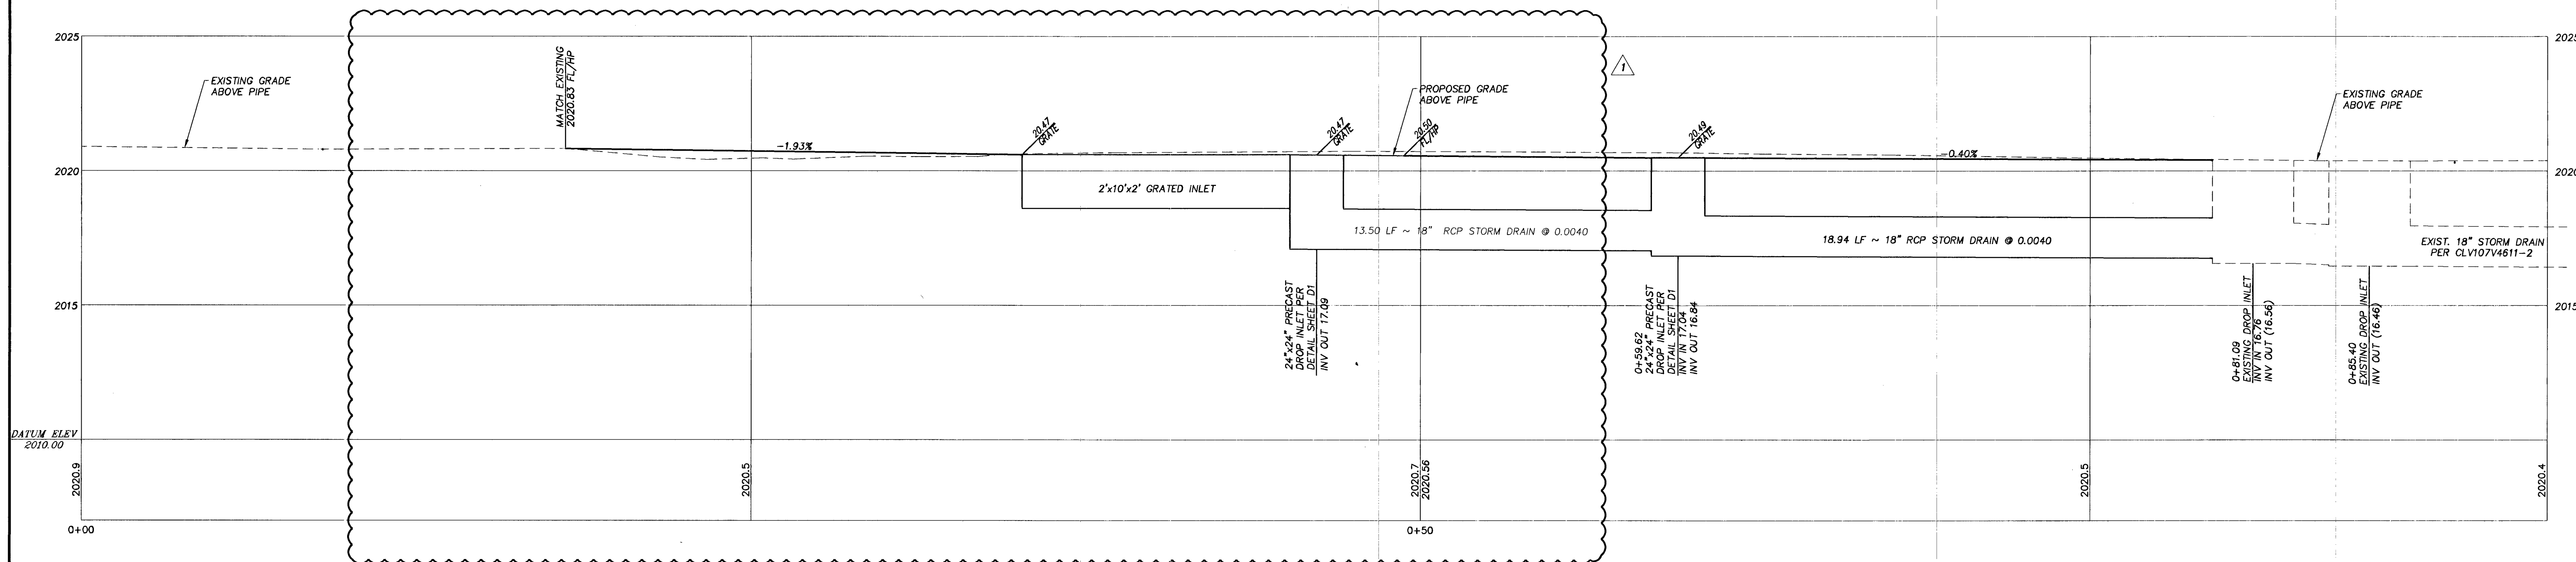

BASIS OF BEARING
SOUTH 27°54'26" WEST, BEING THE BEARING OF THE
CENTERLINE OF MAIN STREET BETWEEN CARSON AVENUE
AND BRIDGER AVENUE AS SHOWN IN FILE 67 OF SURVEYS,
AT PAGE 79, OFFICIAL RECORDS OF CLARK COUNTY,
NEVADA.

BENCHMARK
CITY OF LAS VEGAS BENCHMARK 6C0135SW6 FOUND RIVET
AND SQUARE ALUMINUM PLATE IN TOP OF CURB AT 1605
FREMONT STREET.
ELEVATION = 1929.78 FEET
589.199 METERS
CITY OF LAS VEGAS BENCHMARK BOOK 06/2002
UPDATED 5/24/10


Call before you Dig
Avoid cutting underground
utility lines. It's costly.

Call before you Overhead
Avoid overhead power
line contact.

Call before you UnderGround
Avoid power line contact.

1-800-227-2600
CLARK COUNTY TRAFFIC OPERATIONS
1-702-445-7544

1-702-227-2929
NEVADA POWER ENVIRONMENT
SAFETY SERVICES DEPARTMENT
1-702-437-3300

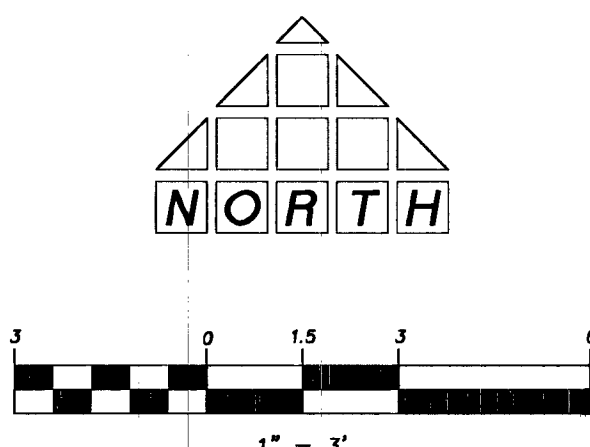

THOMASON CONSULTING ENGINEERS
3277 E. WARM SPRINGS ROAD, SUITE 400
LAS VEGAS, NEVADA 89120
702-932-6125 FAX: 702-932-6129

PROJECT NO. **076.09003**

REVISIONS:
REV. DATE BY
1 6/2014 BP REVISE STORM DRAIN AND GRADING
REVISION

SCHIFF ENTERPRISES
1004 NEW ROAD, NORTHFIELD, NJ 08225
PH: (609) 407-2190 FAX:

**25 FREMONT ADDITION
STORM DRAIN
PLAN AND PROFILE**

REGISTERED PROFESSIONAL ENGINEER-STATE OF NEVADA
JAMES B. McAVOY
Exp. 12/31/15
CIVIL
No. 22439

SHEET **P1**
10 OF 10
DRAWING NO. **107V572.4**
H# 42311