

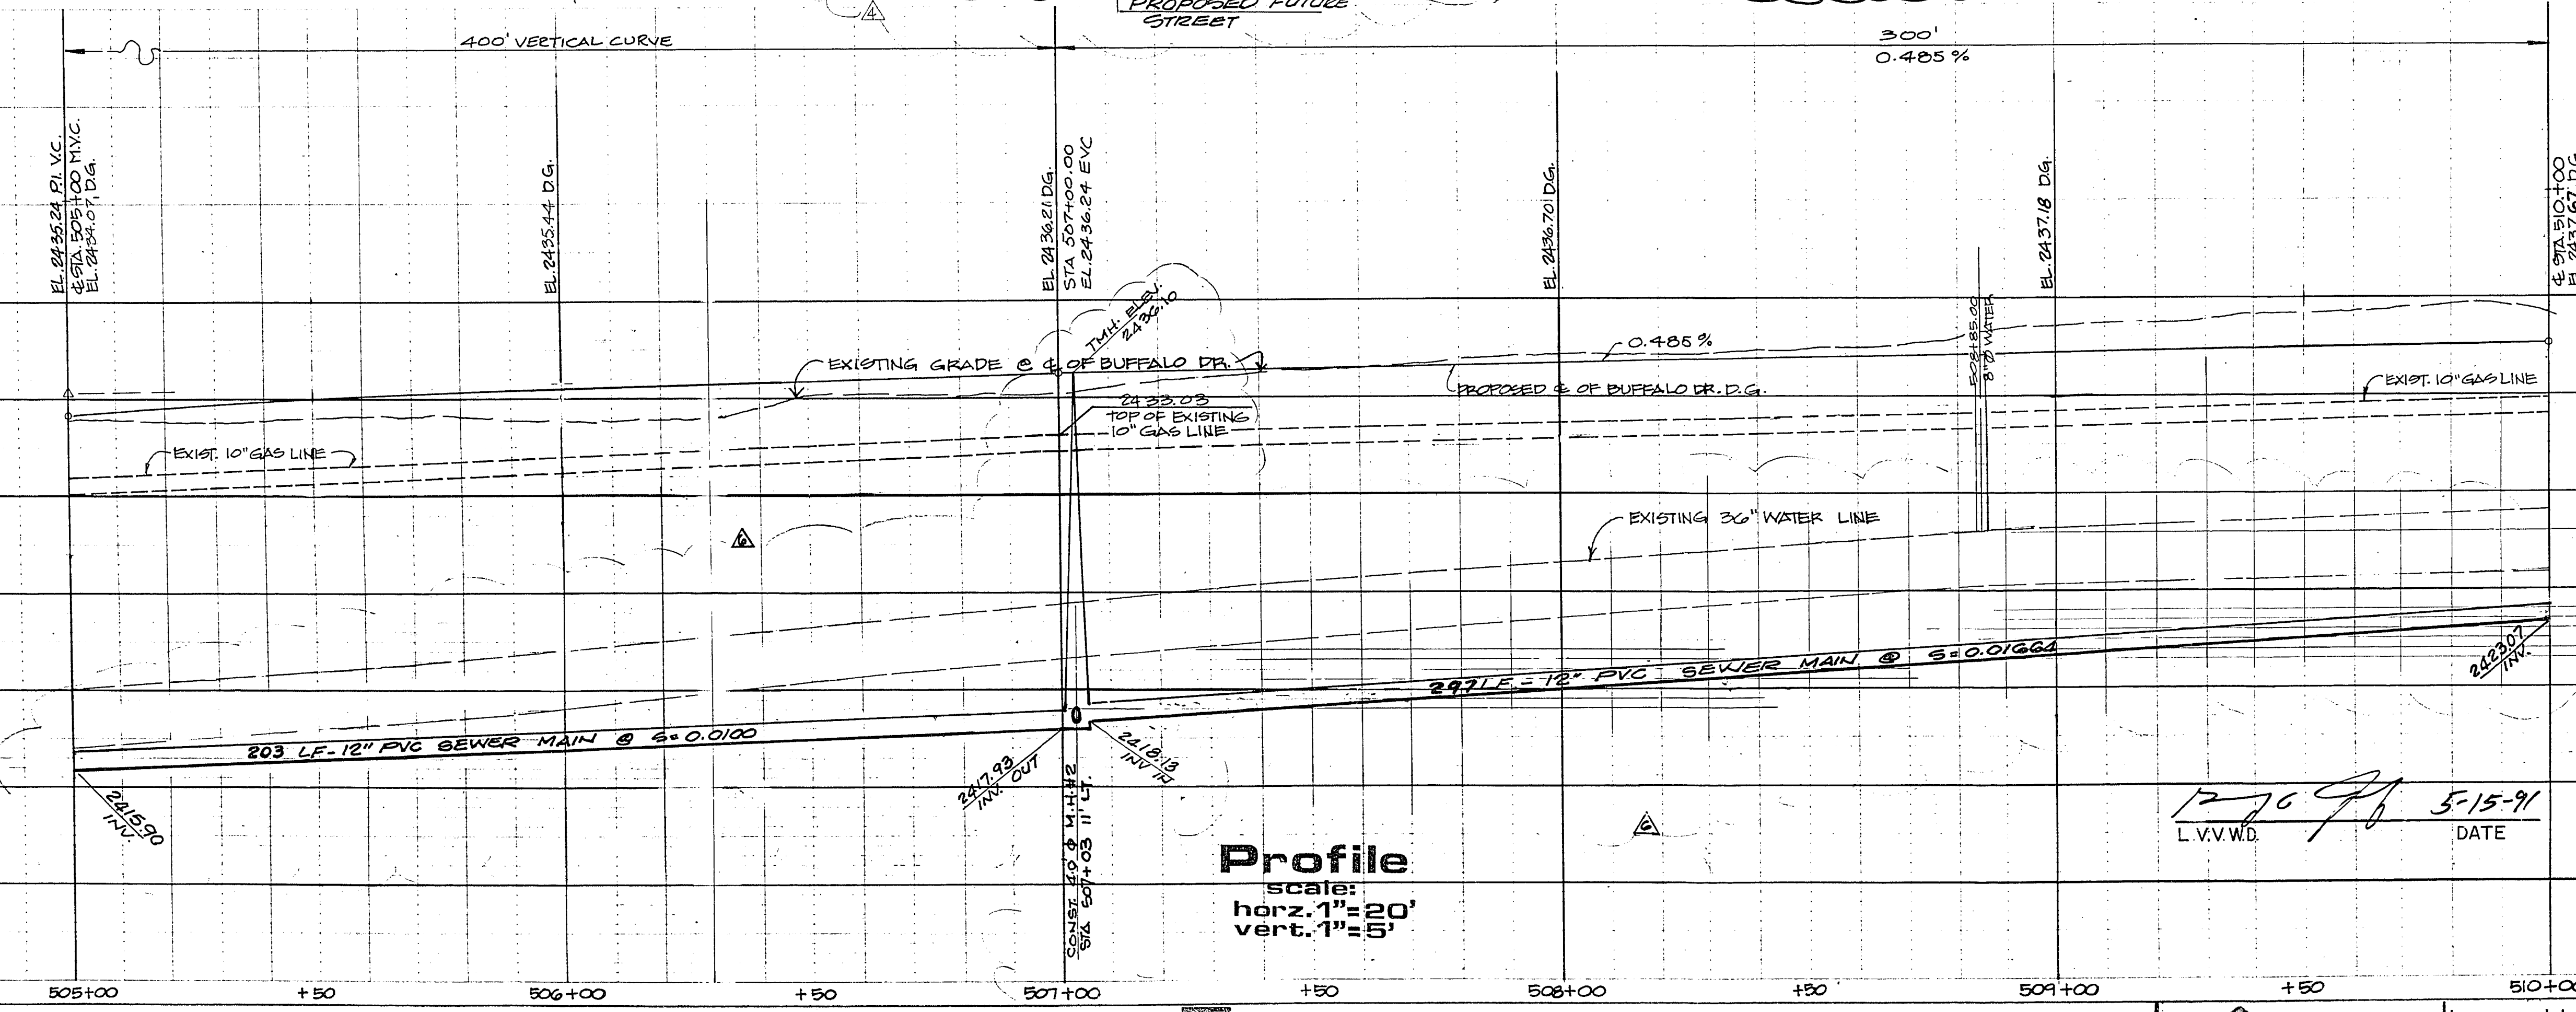
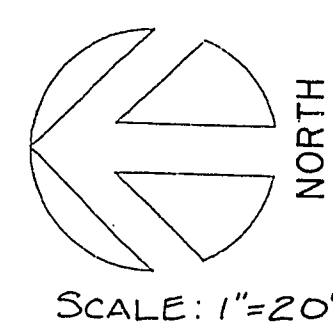


PLAN
NOTES:
1. SEE SHEET 4 FOR MATCH LINE
2. SEE SHEET 6 FOR MATCH LINE


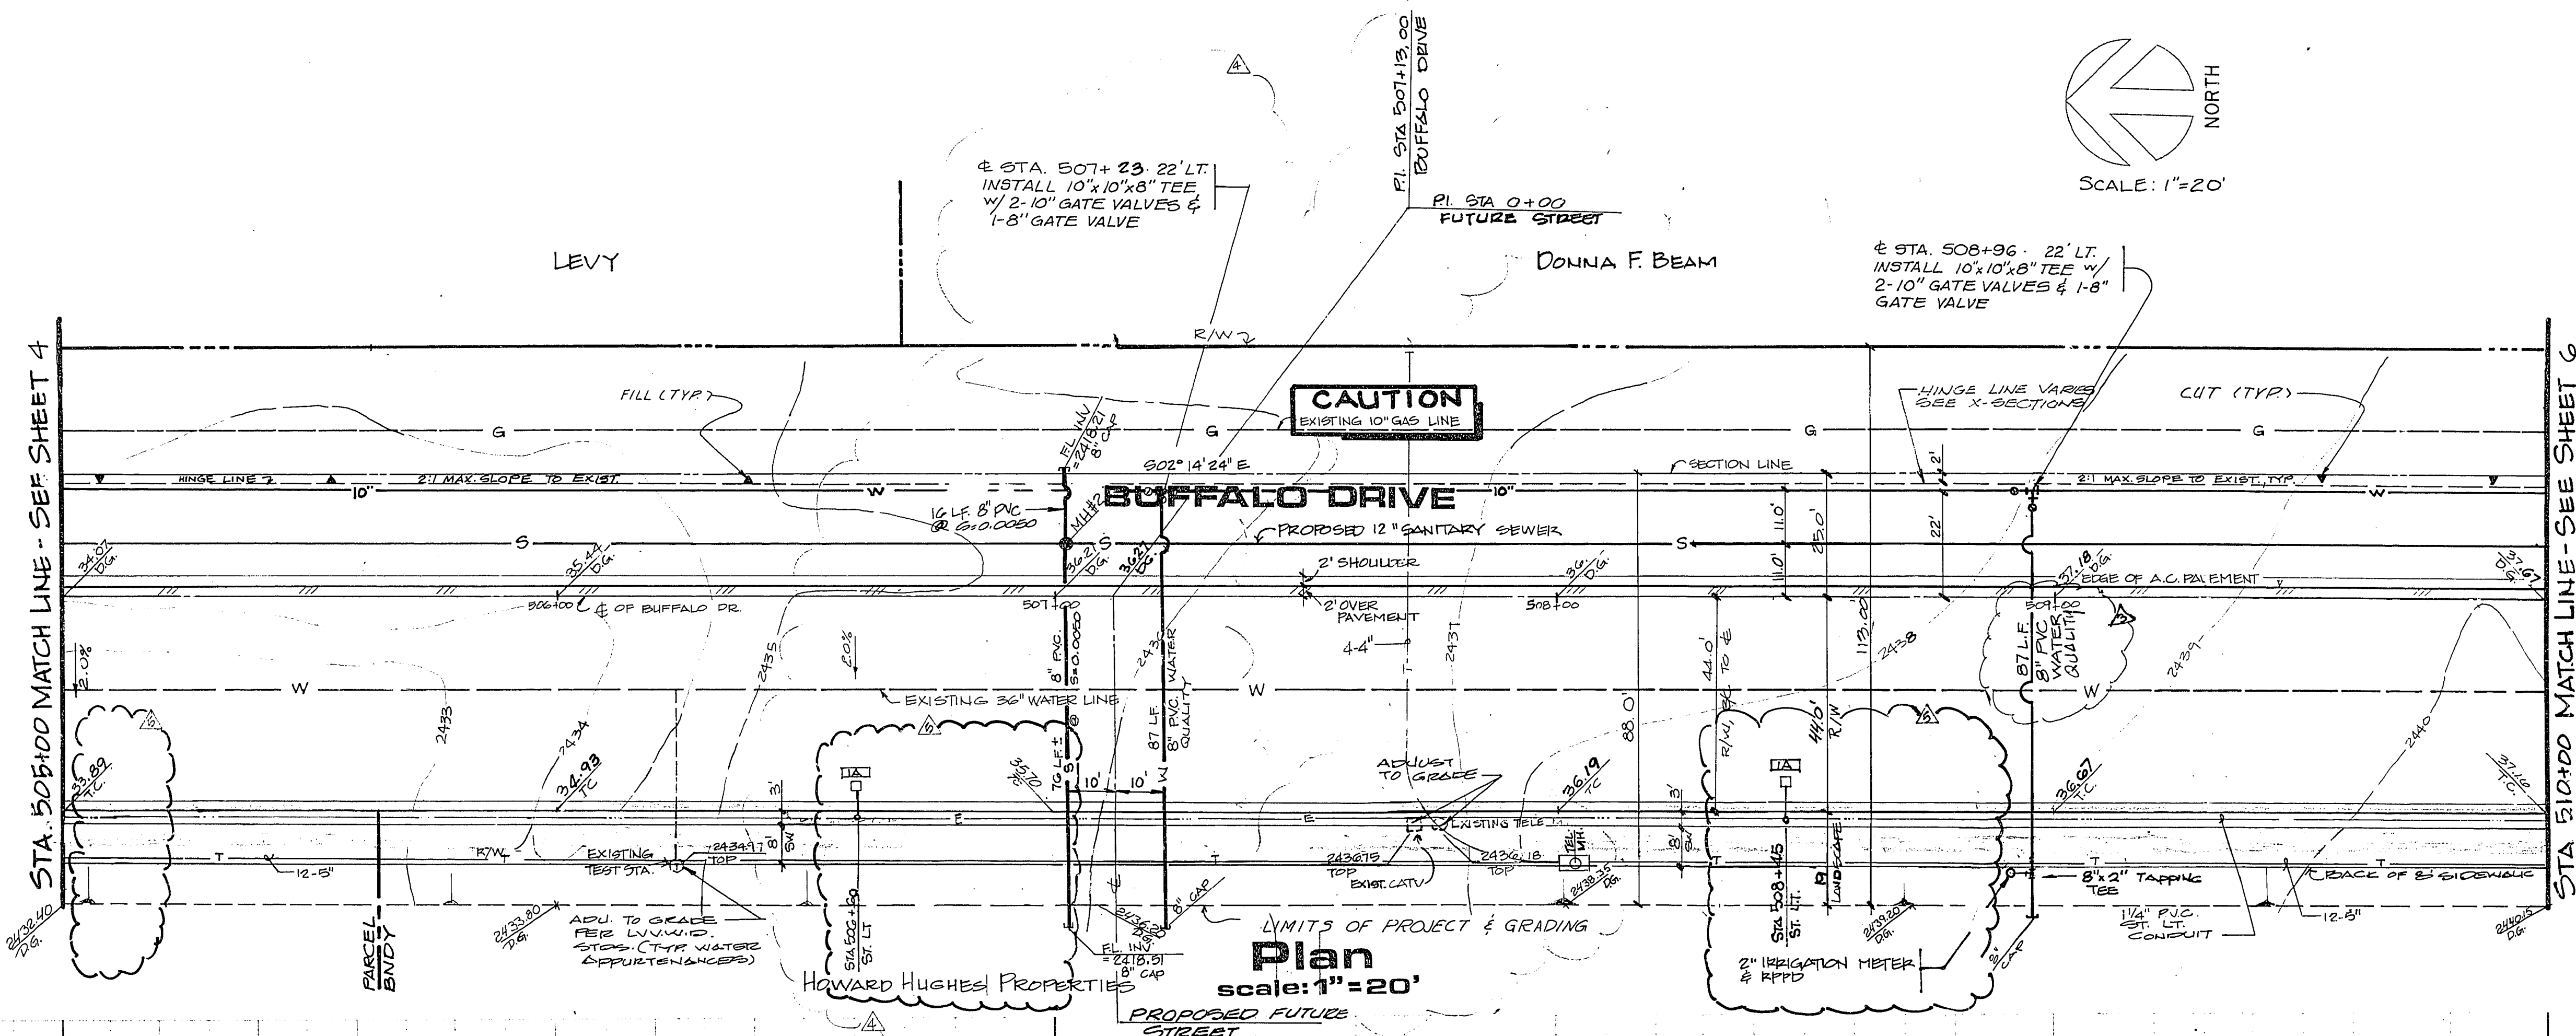

REVISIONS		
NO.	DESCRIPTION	DATE
1	REVISED FOR HHP COMMENTS	3/10/91
2	REV. FOR HHP COMMENTS	4/15/91
3	REV. FOR L.V.V.W.D. COMMENTS	5/1/91
4	REV. FOR HHP COMMENTS	6/1/91
5	REV. FOR HHP COMMENTS	6/15/91
6	REV. FOR HHP COMMENTS	6/24/91

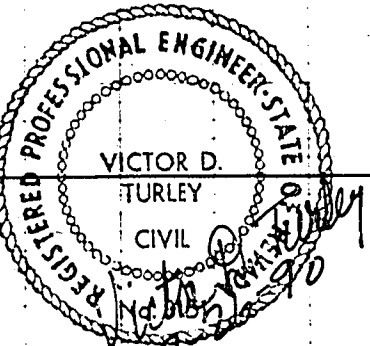

1276 9/8 5-15-91
L.V.V.W.D. DATE



Summerlin - BUFFALO DRIVE