

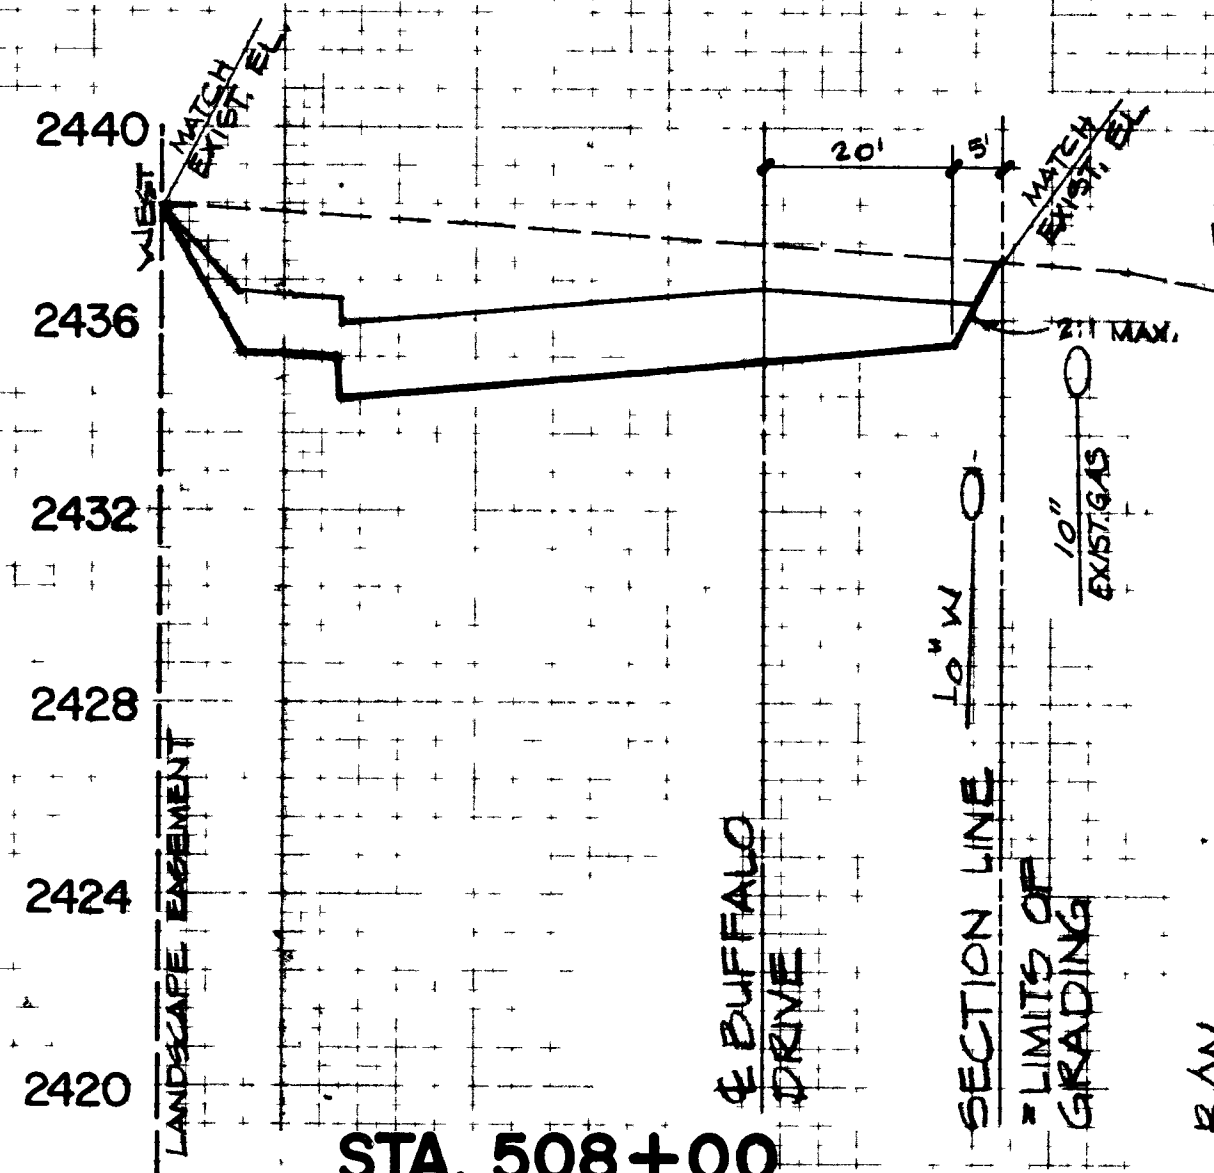
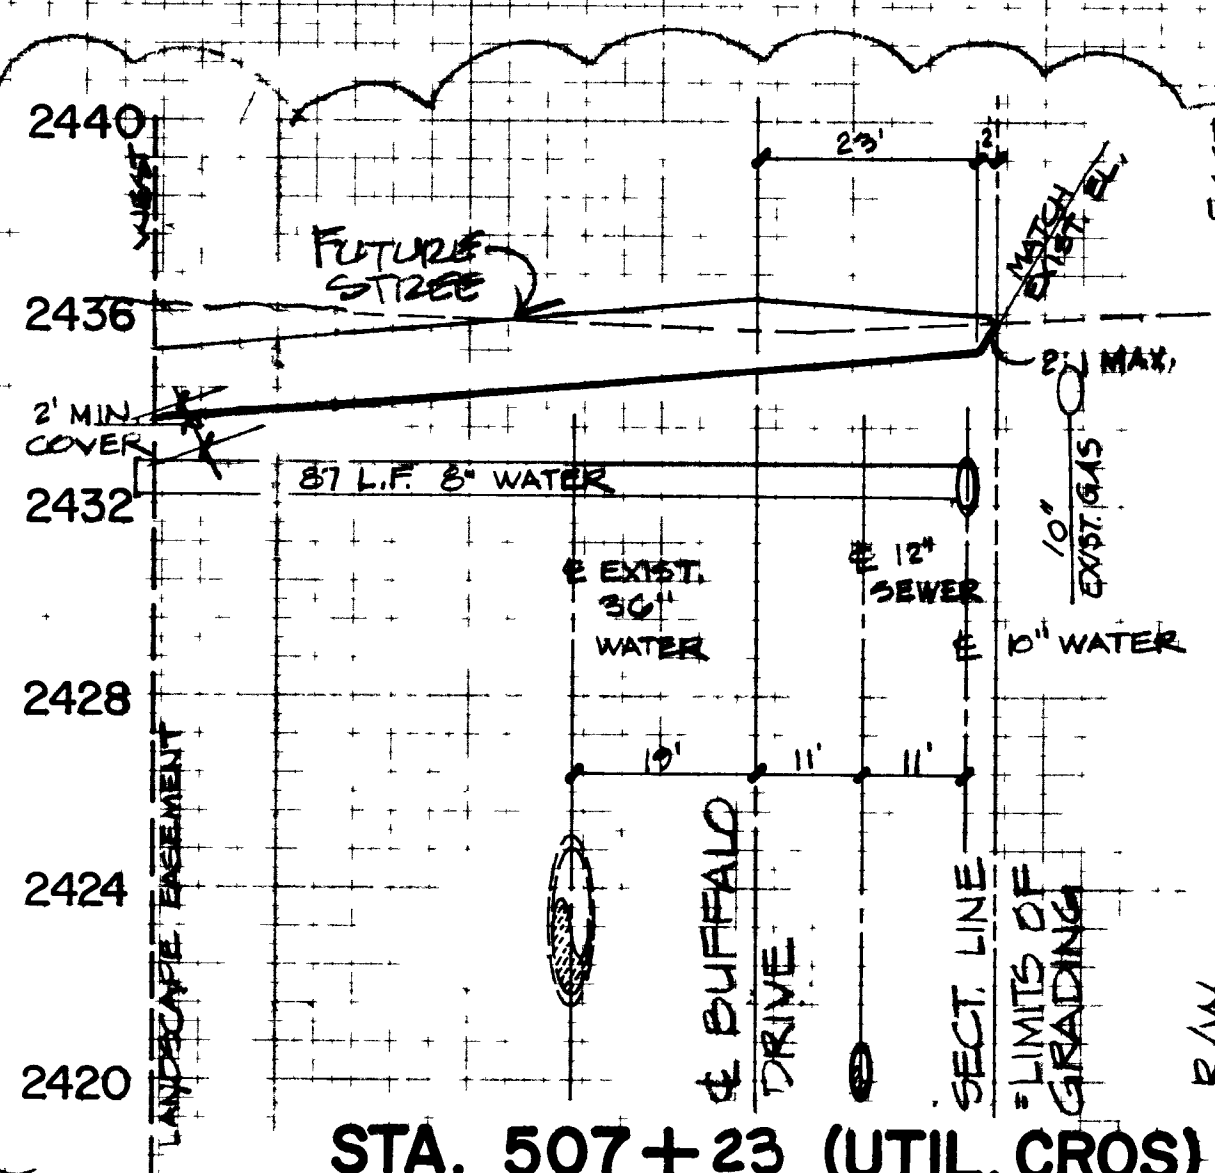
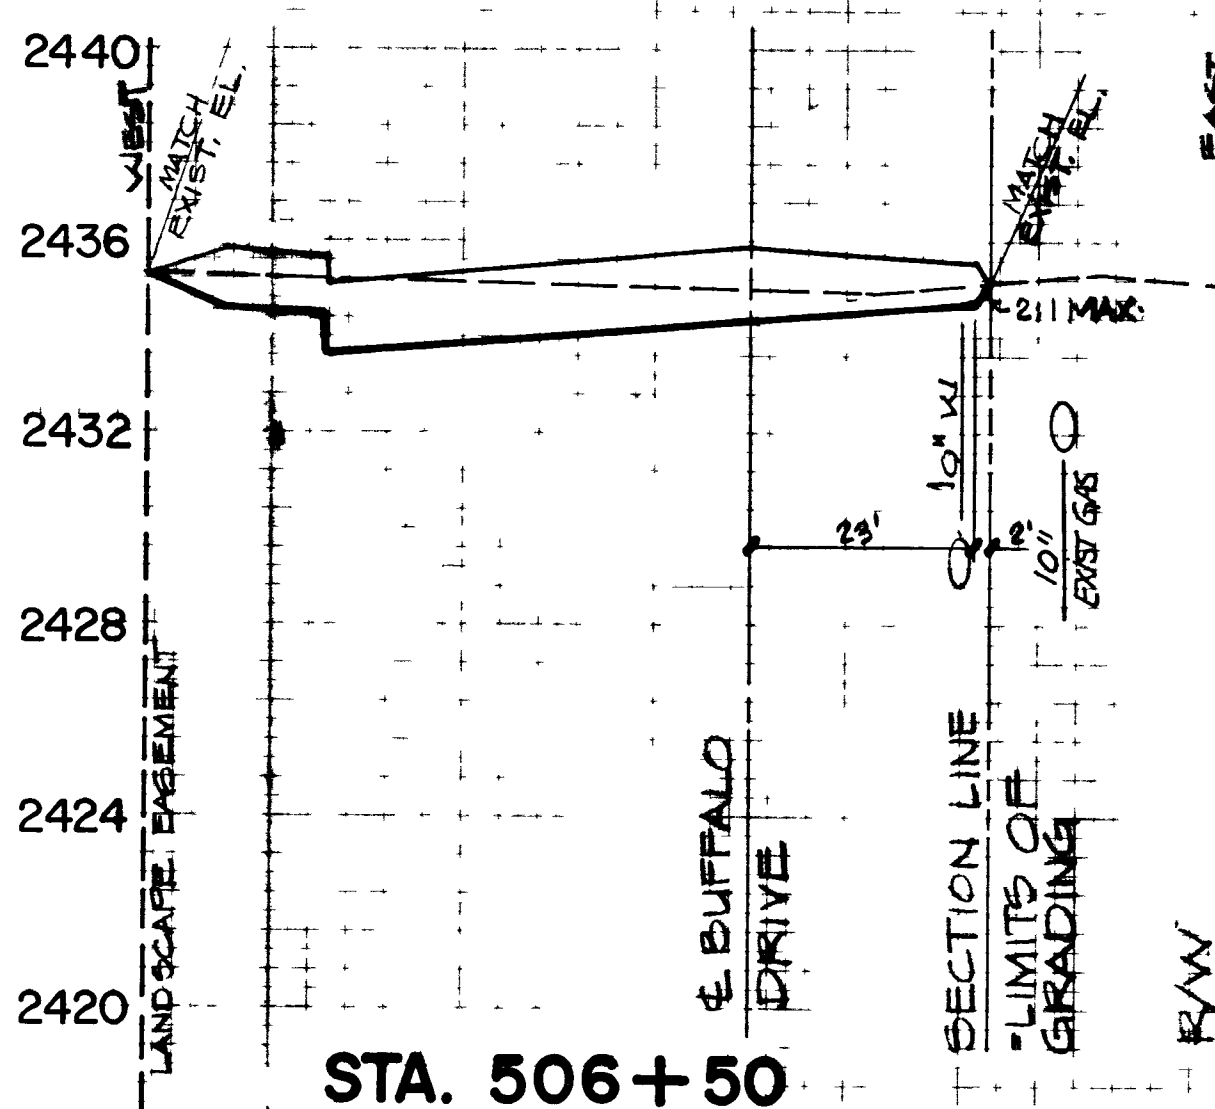
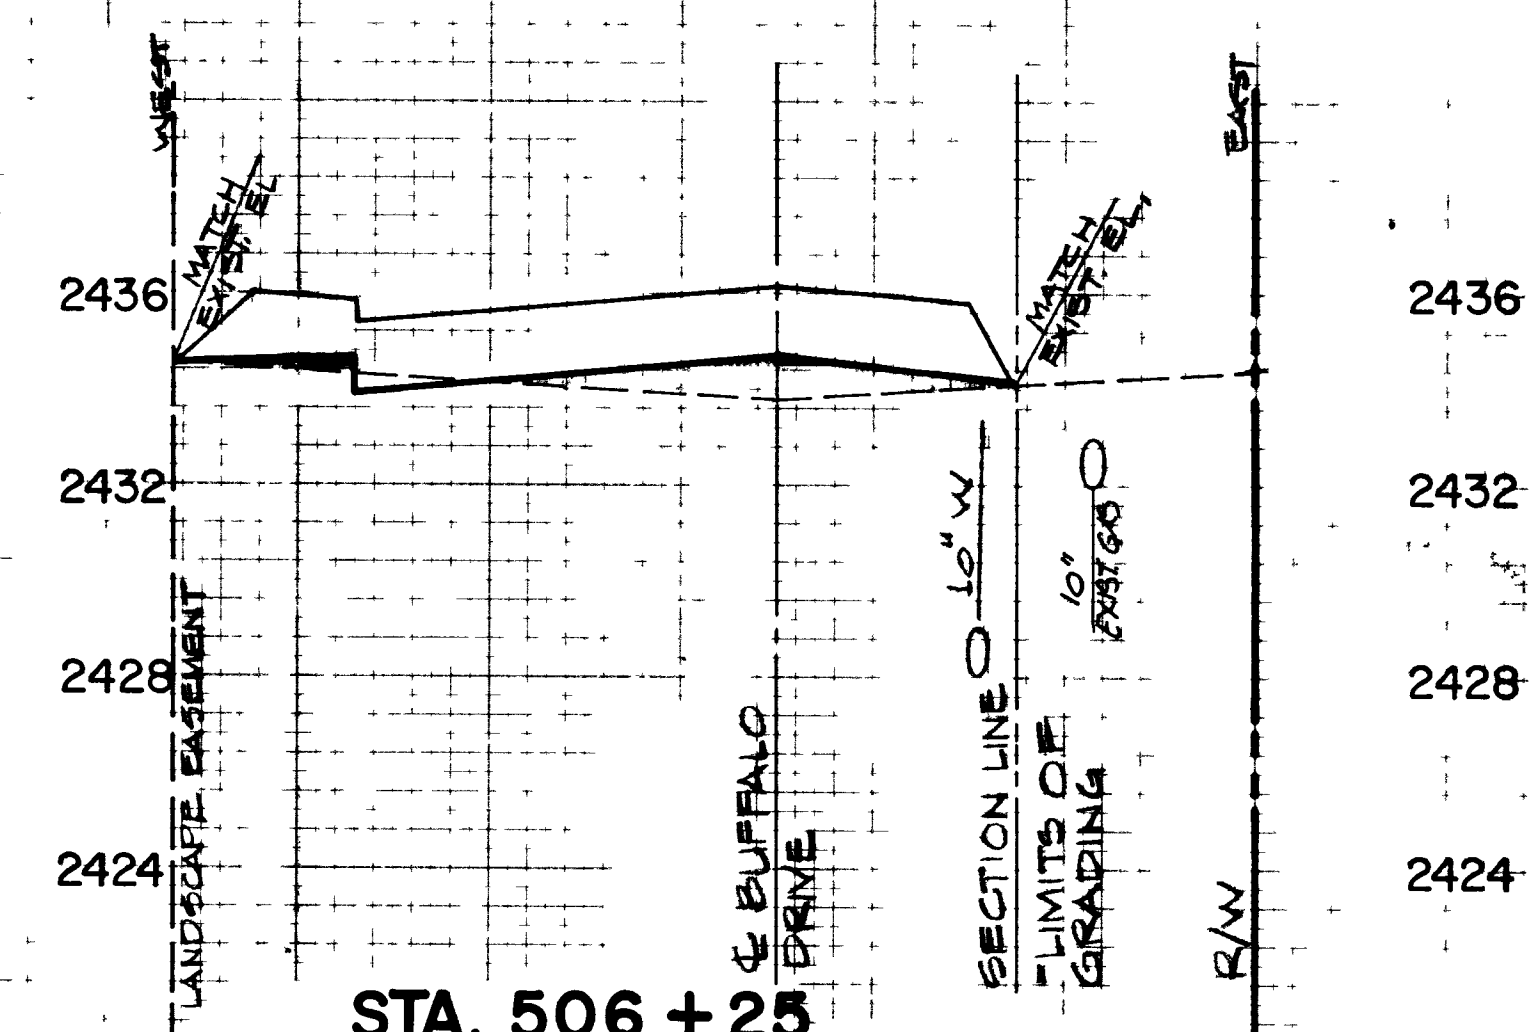
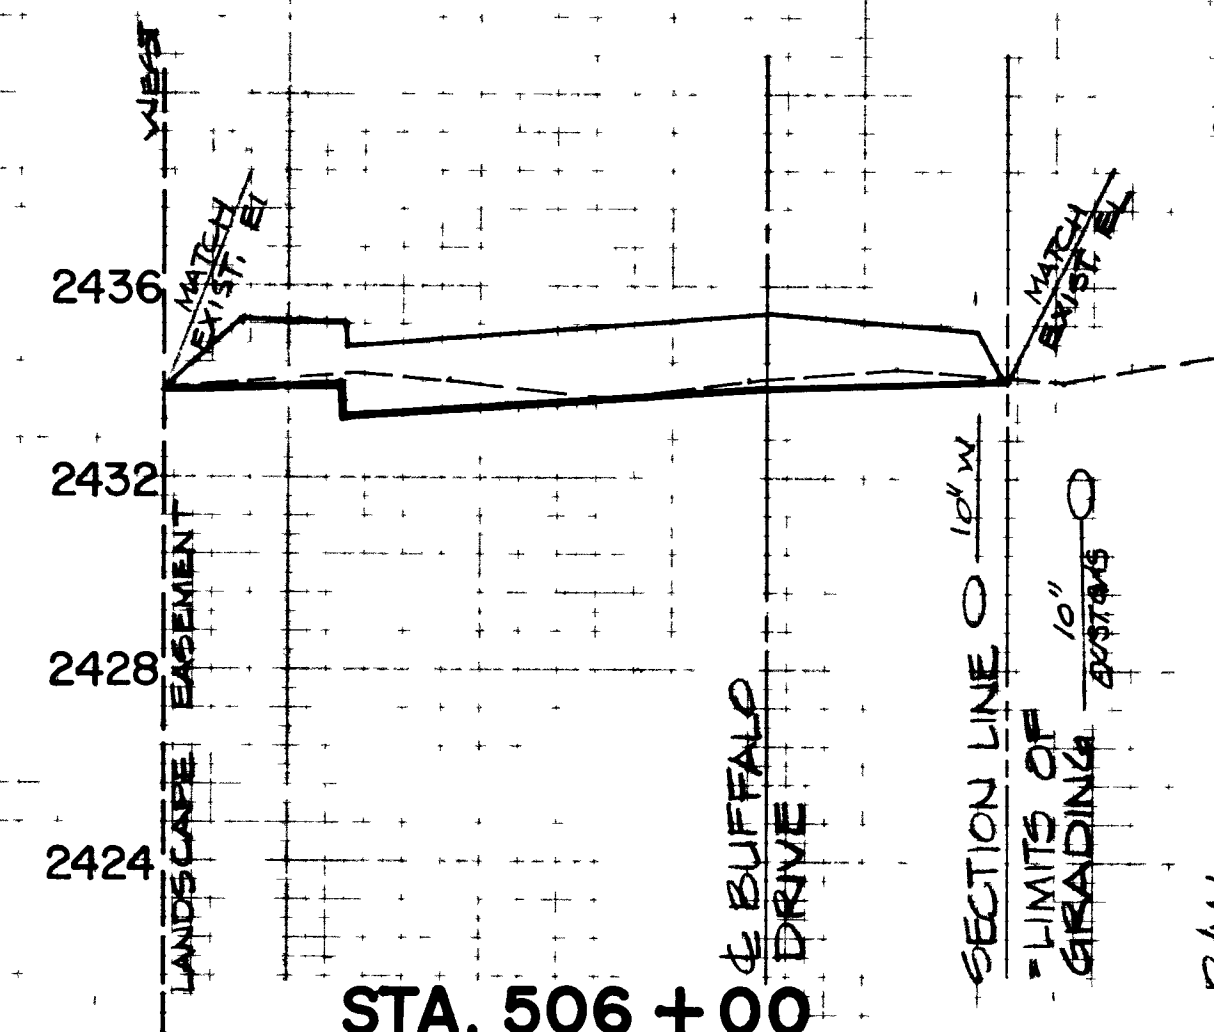
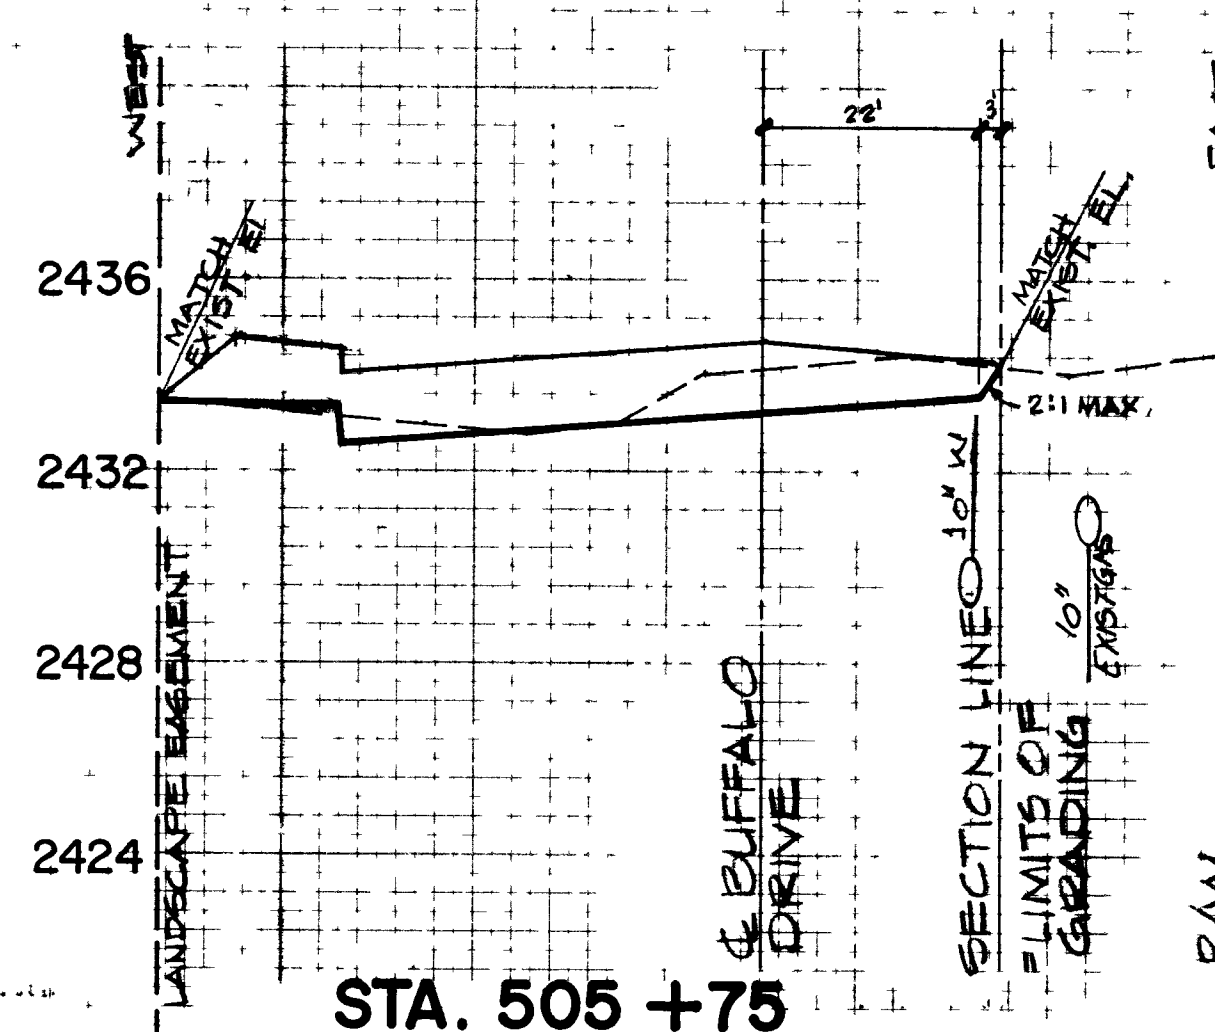
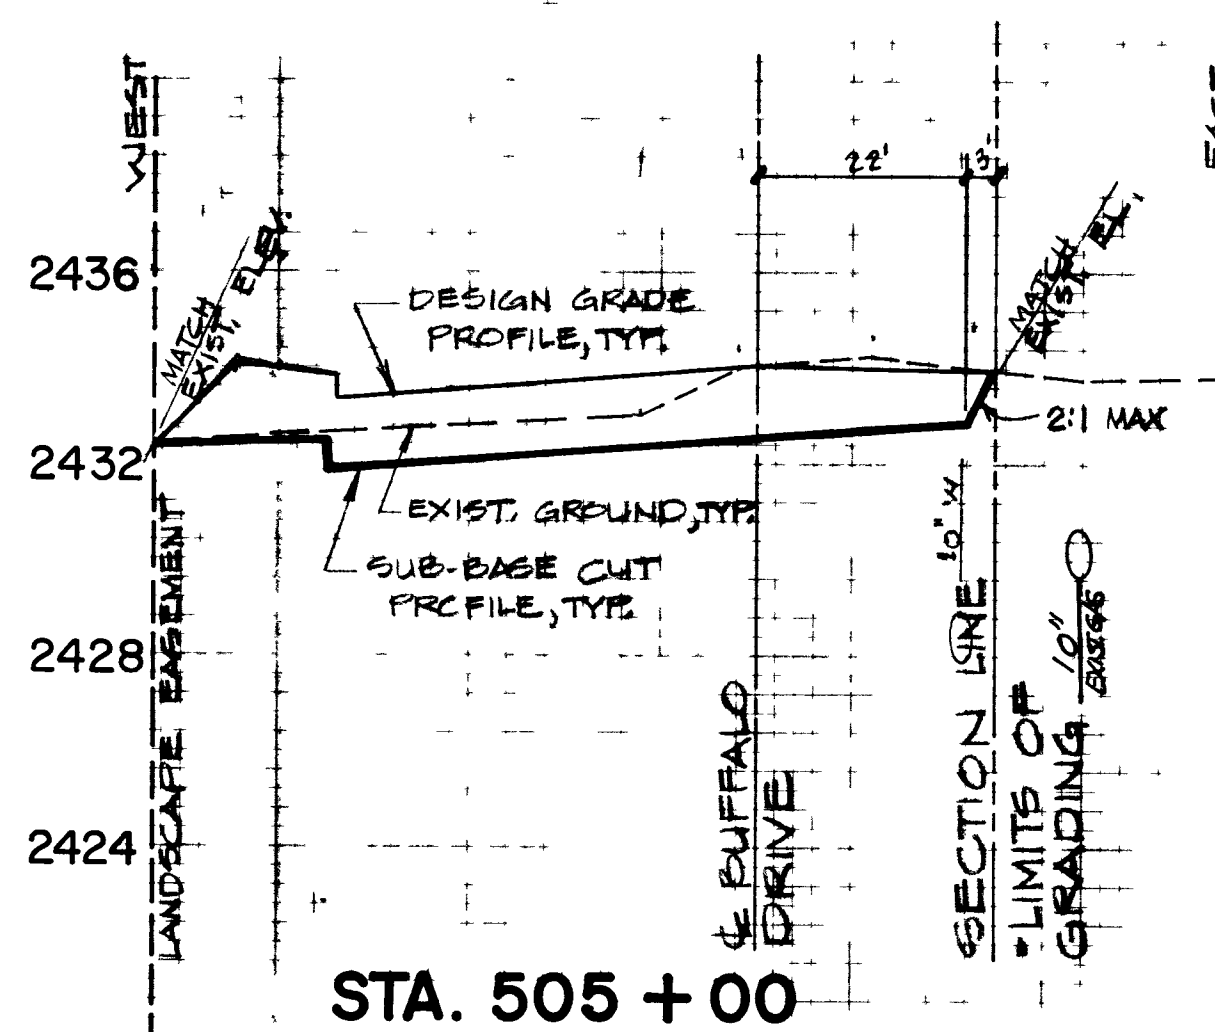
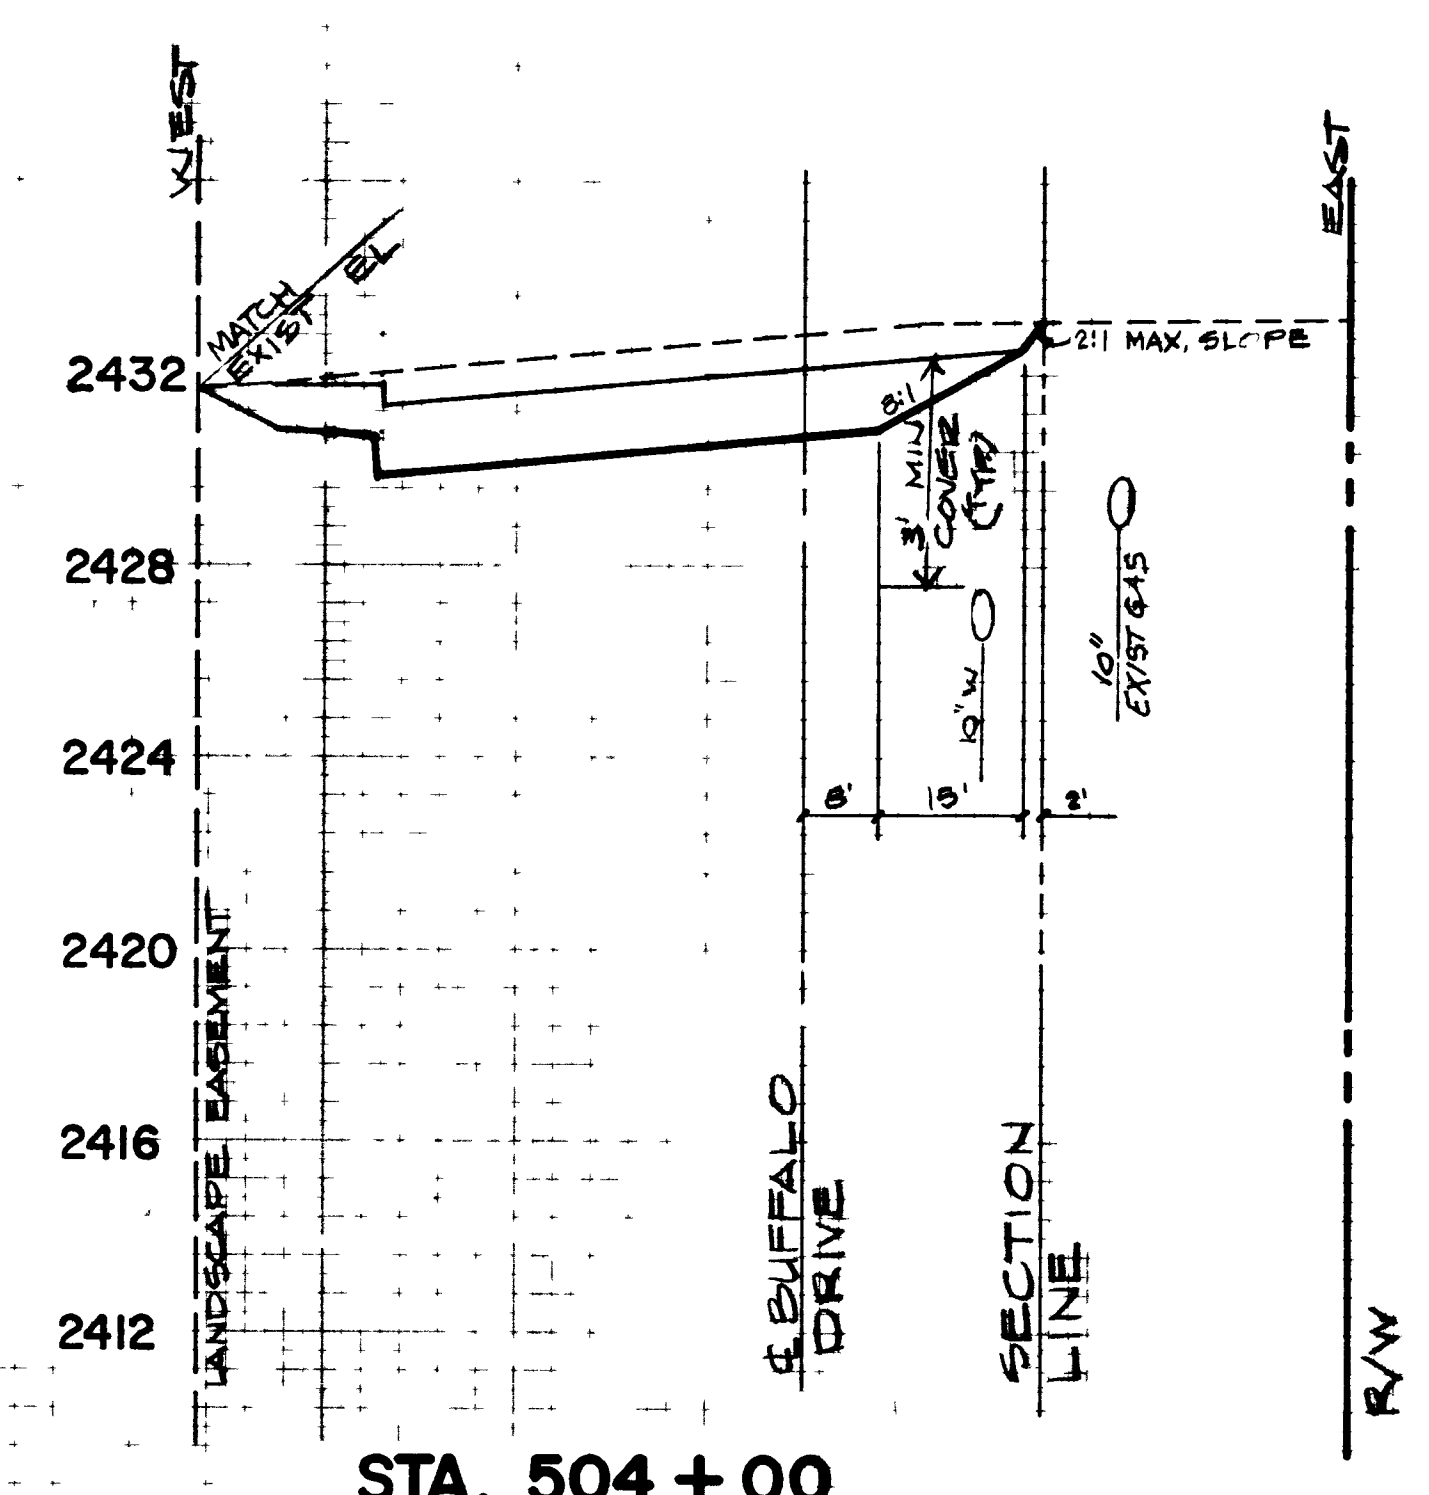
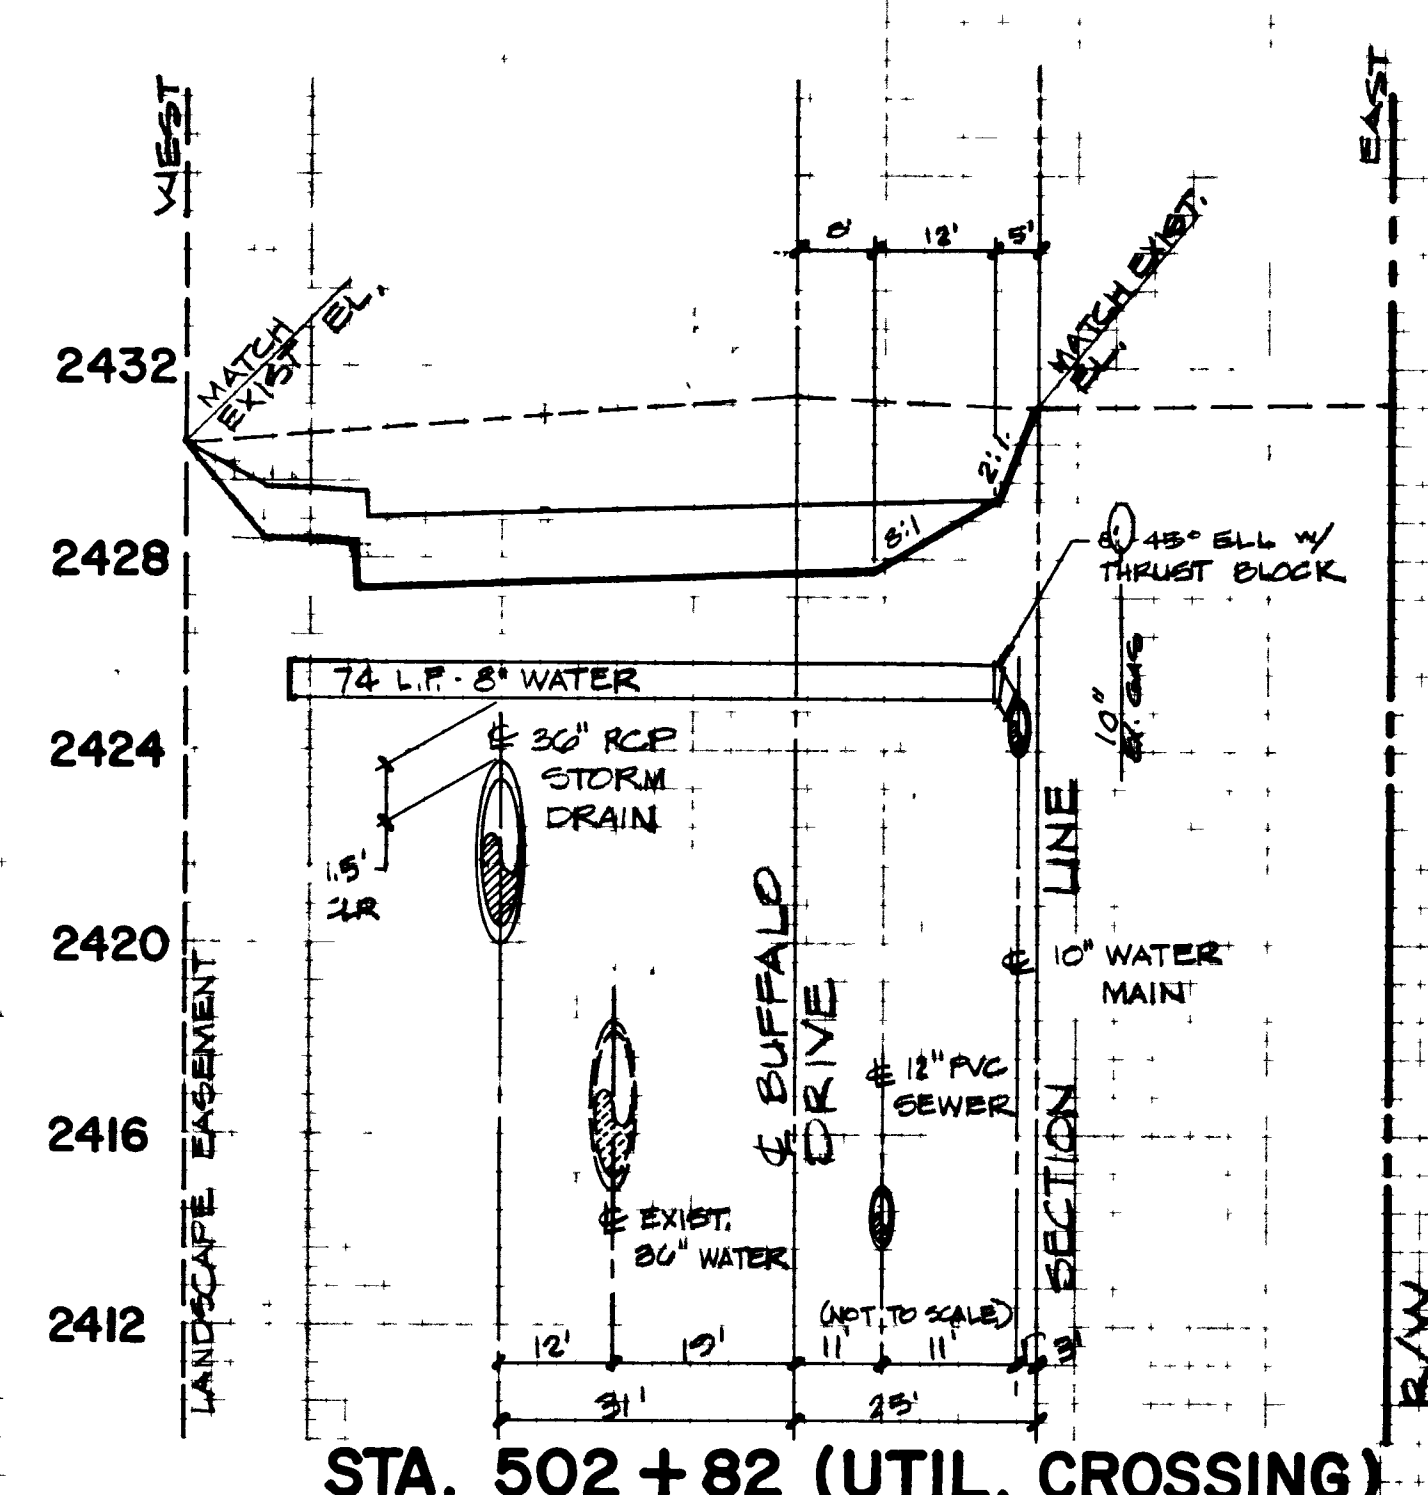


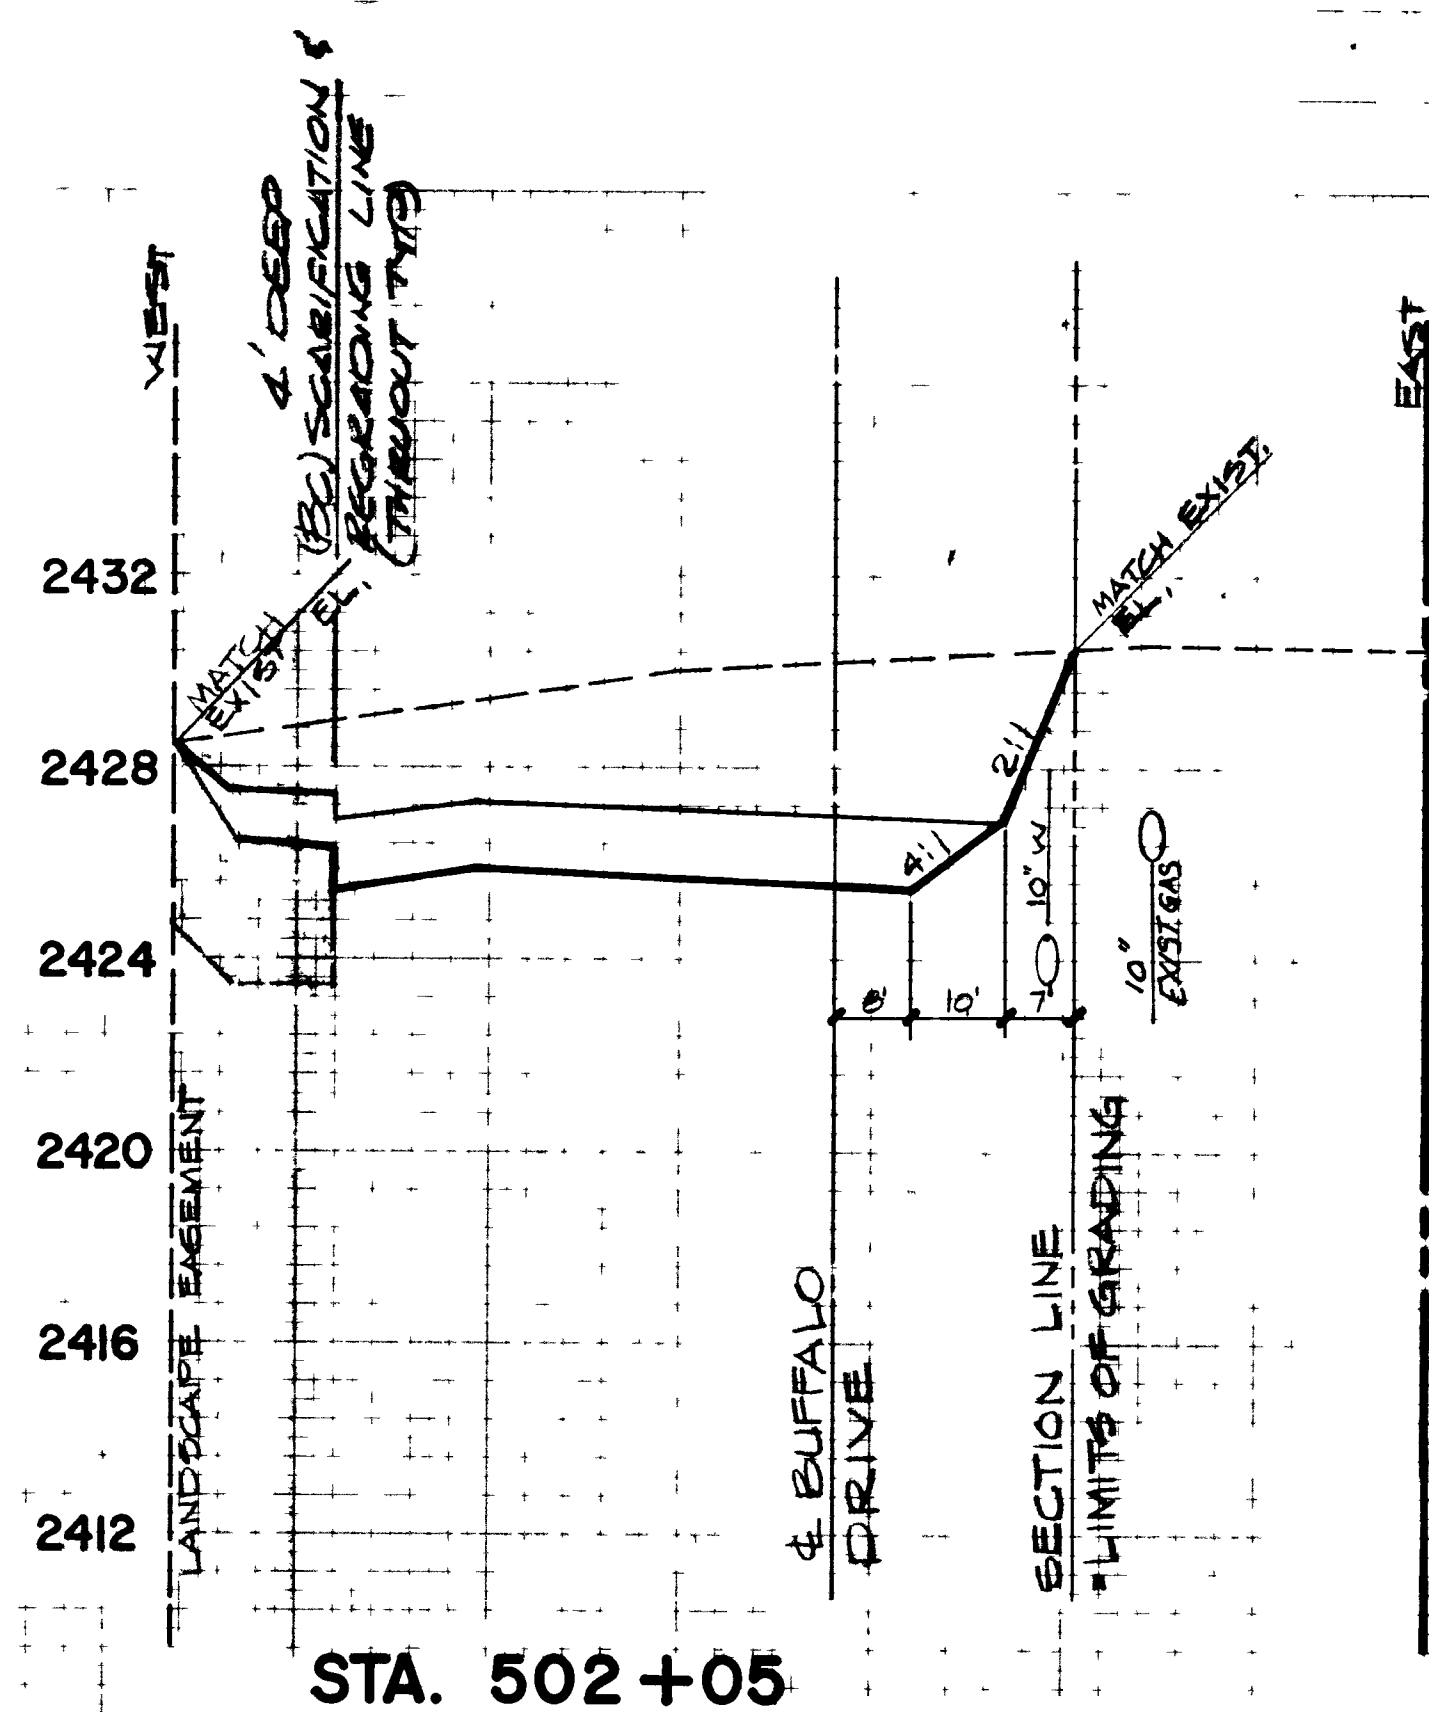

BUFFALO DRIVE STRUCTURAL SECTION
 3" ASPHALTIC CONCRETE PAVING %
 4" TYPE II AGGREGATE %
 9" TYPE I AGGREGATE

EARTHWORK QUANTITIES	
TOTAL CUT	15,445 C.Y.
TOTAL FILL	3,050 C.Y.
LESS SUBSIDENCE (12.5%)	1,930 C.Y.
BALANCE	10,465 C.Y.

BUFFALO DRIVE CROSS-SECTIONS w/ UTILITY CROSSINGS
SCALE: 1"=20' HORIZ. 1"=4' VERT. DWN. M.A.H. DATE 1-21-91

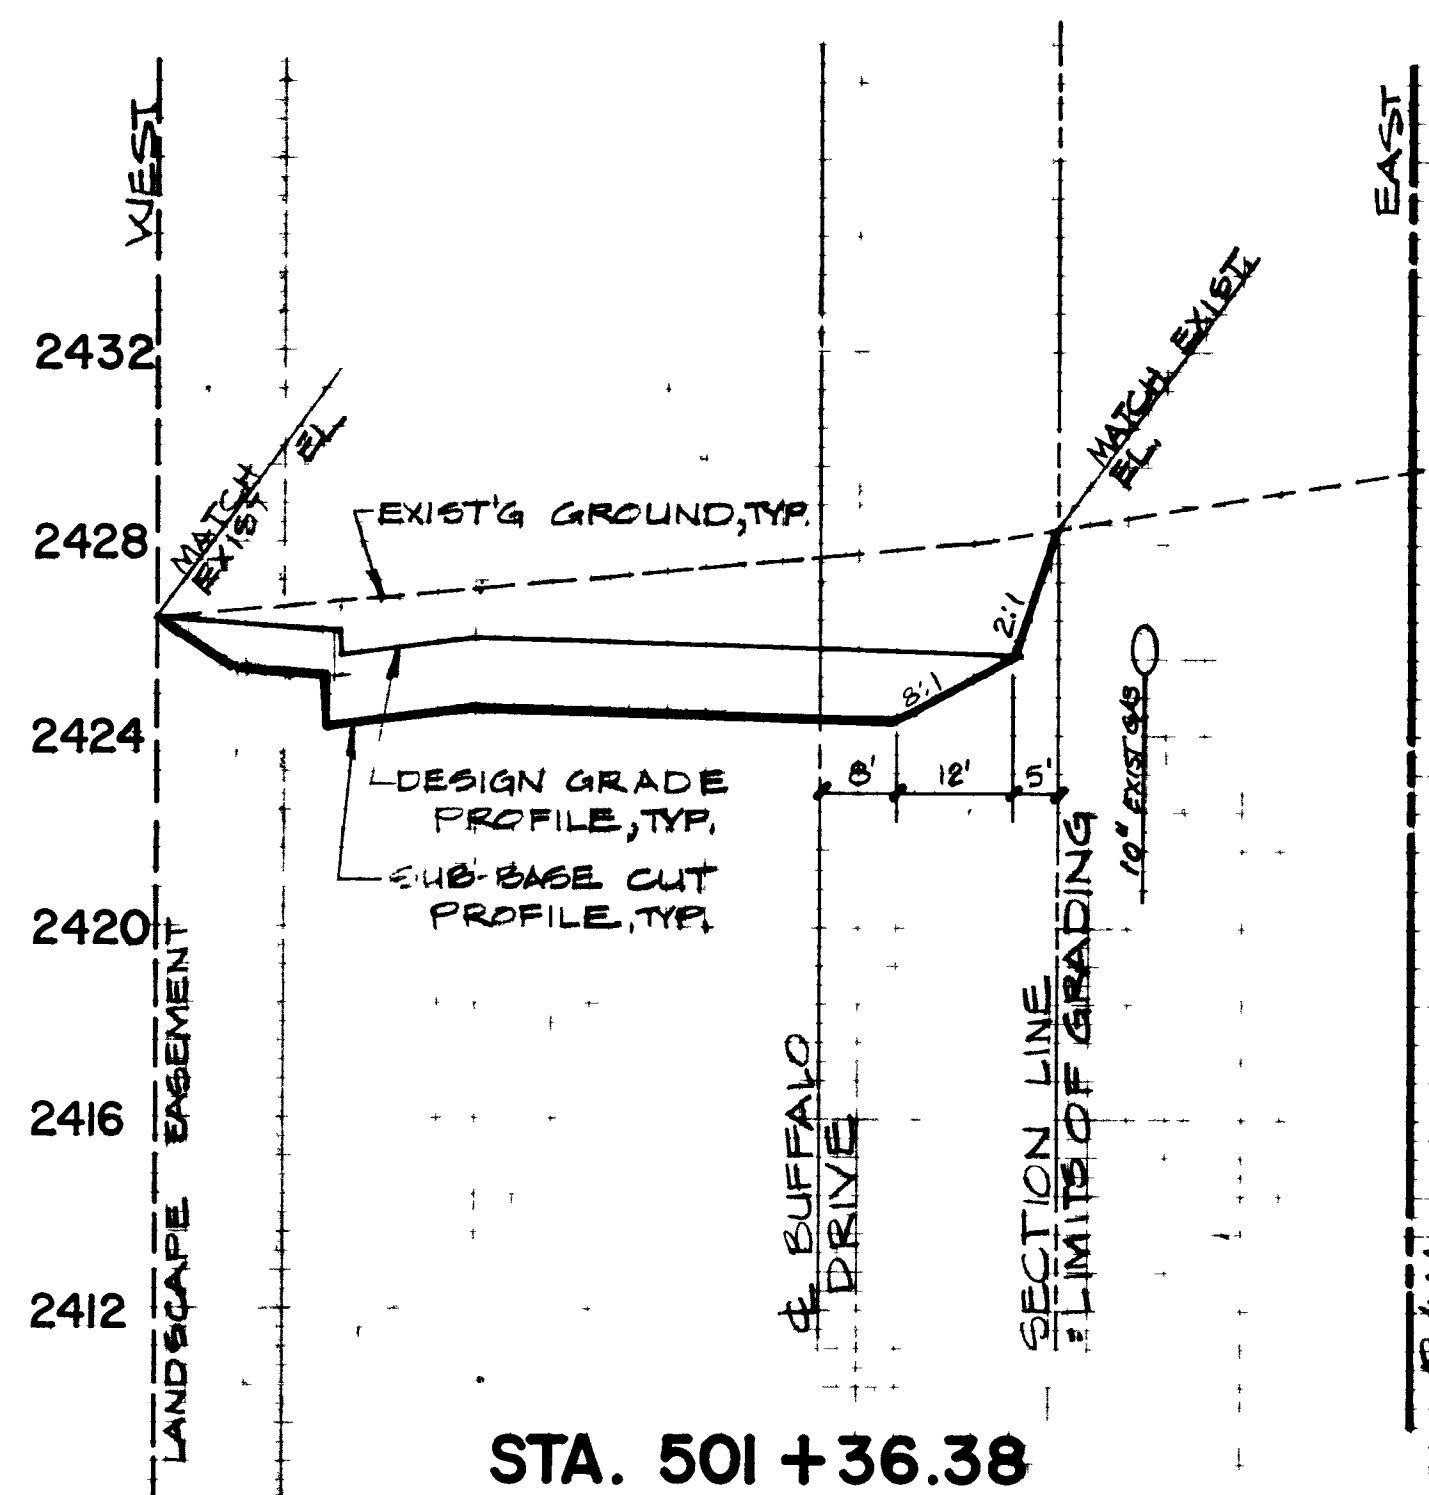