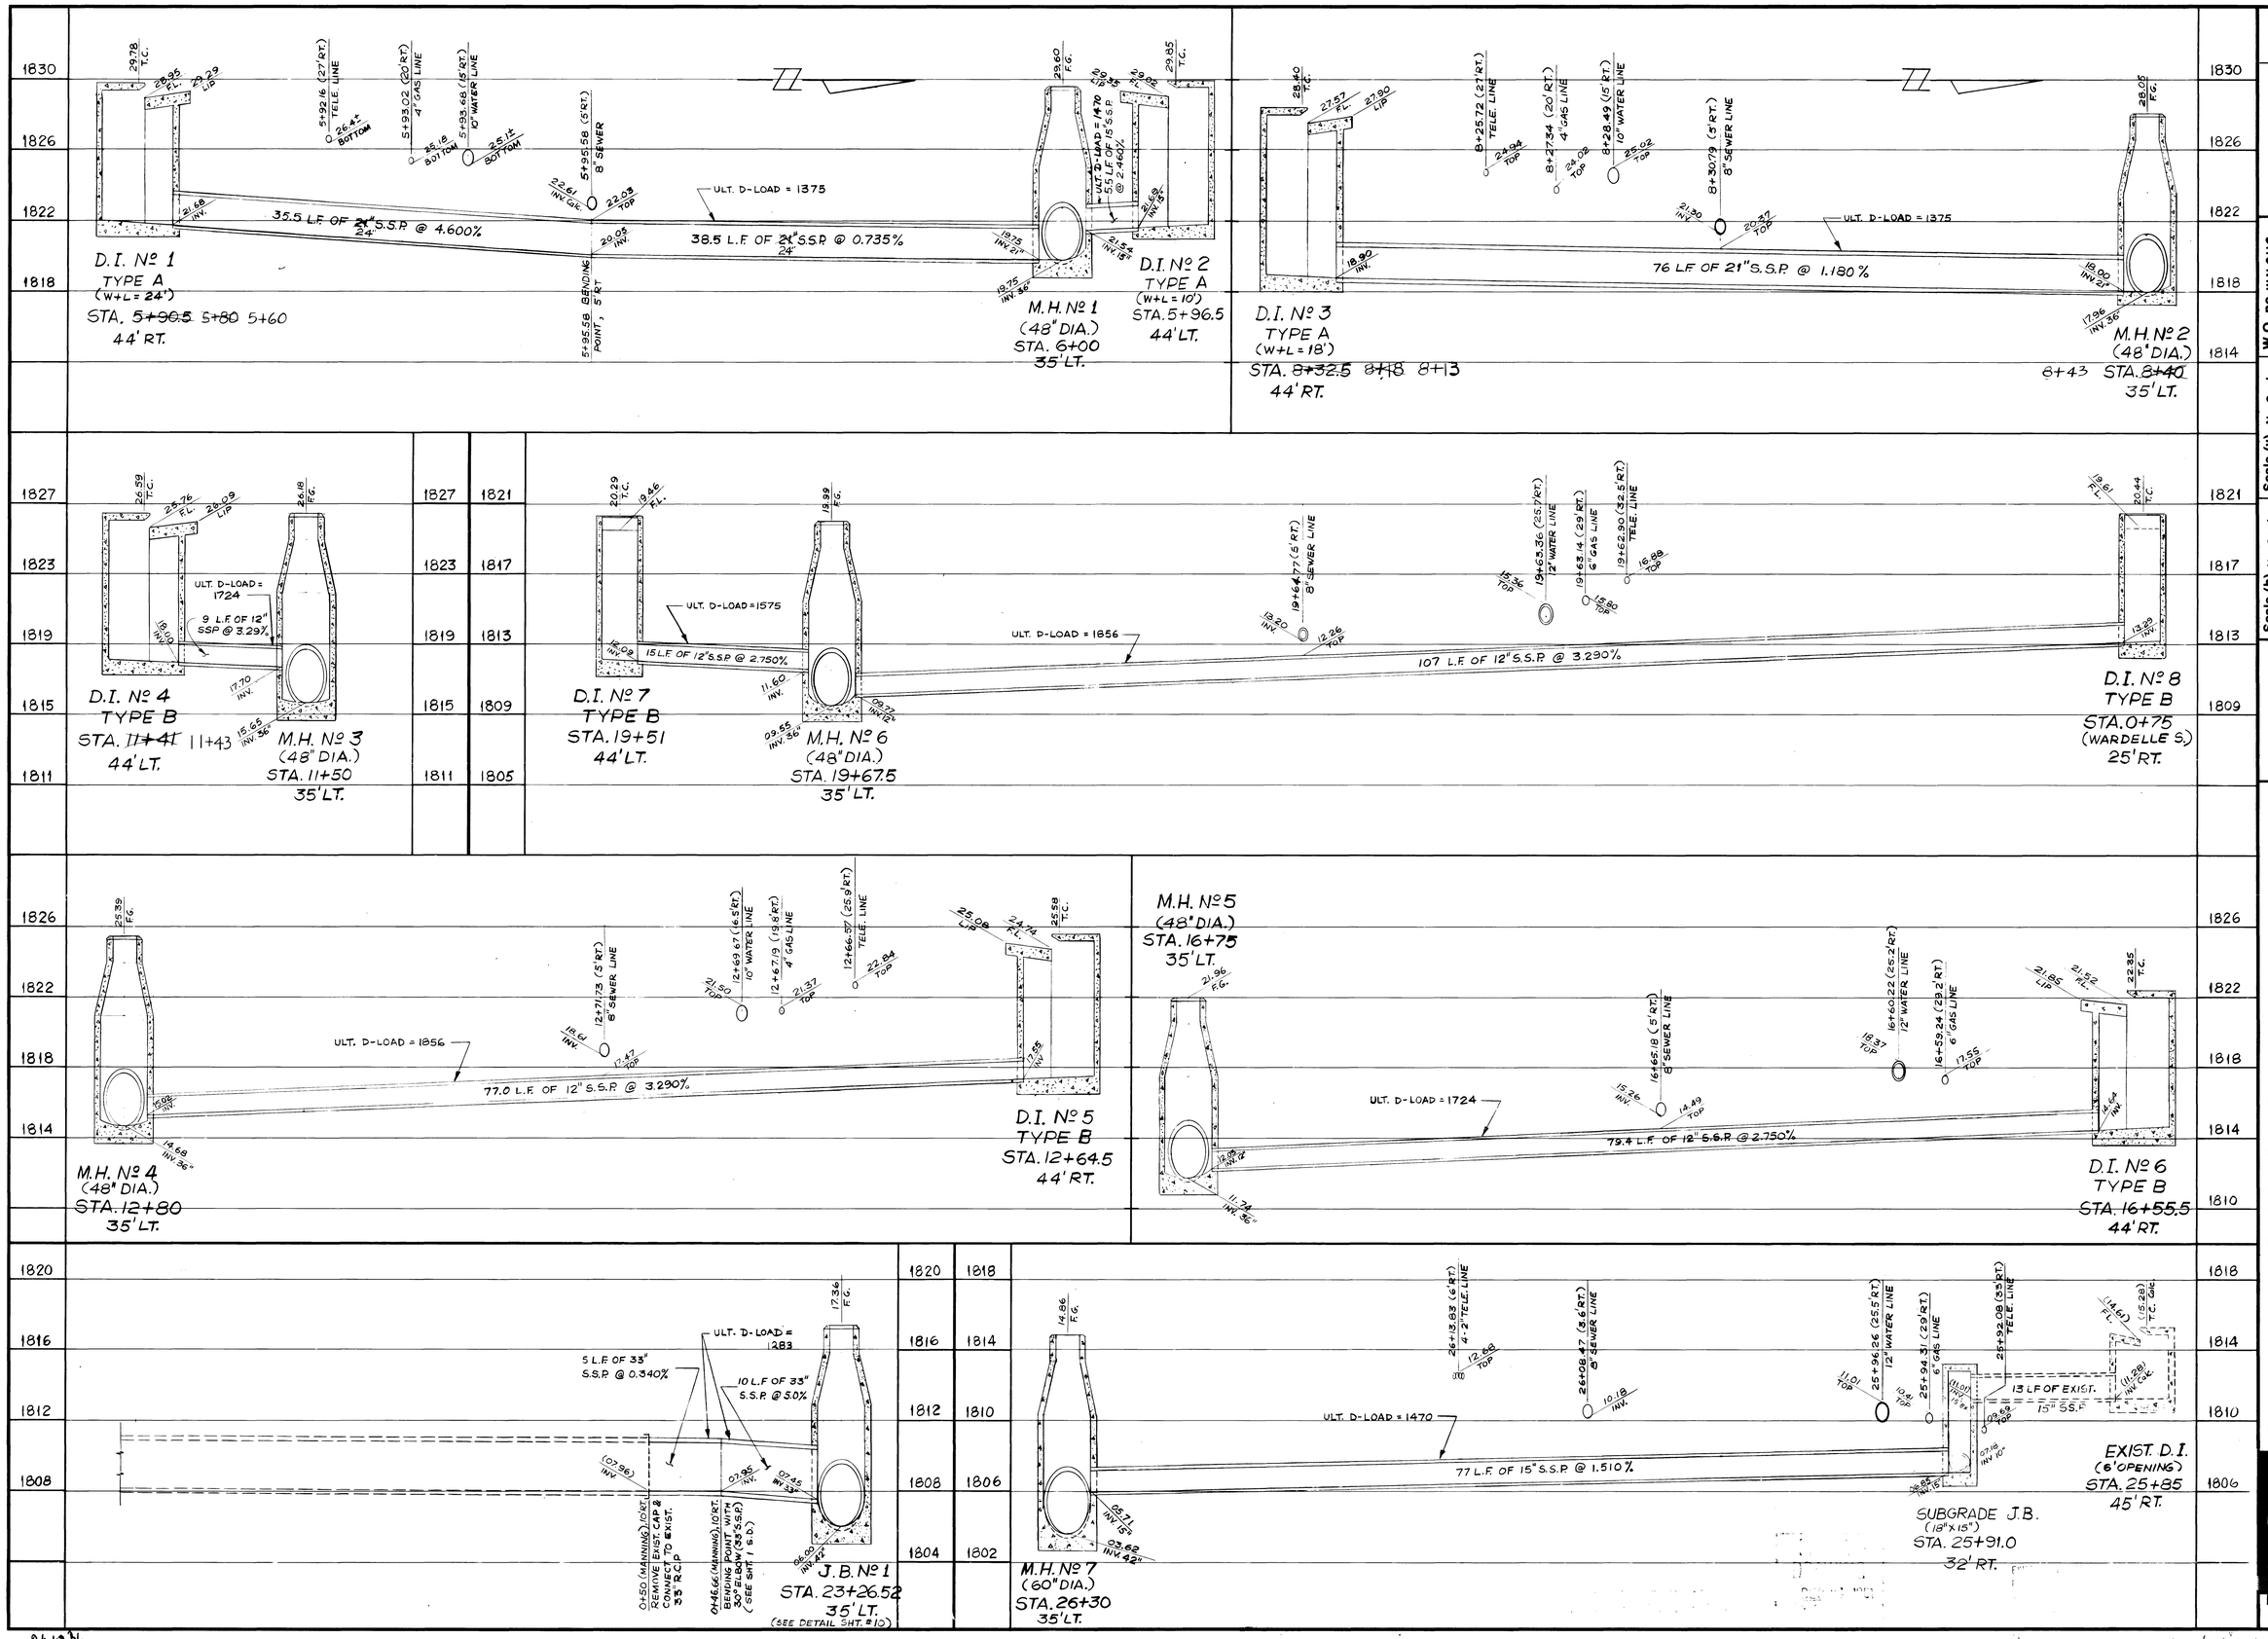

Revisions	Date

W.O. no. W.U 2118

Scale (v) No Scale

Scale (h) No Scale

Fld. bk. no. 81-6X

Date 9-4-81

Drawn by S. S. NORATH

Design by S. JACKSON

Department of Public Services Engineering Design Division

STORM DRAIN
LATERAL DETAILS

BONANZA ROAD
EASTERN AVE. TO PECOS DR.

CITY OF LAS VEGAS CLARK COUNTY NEVADA

Drawing no. 107-V849A 6/13

27 OF 57

18-4-155